
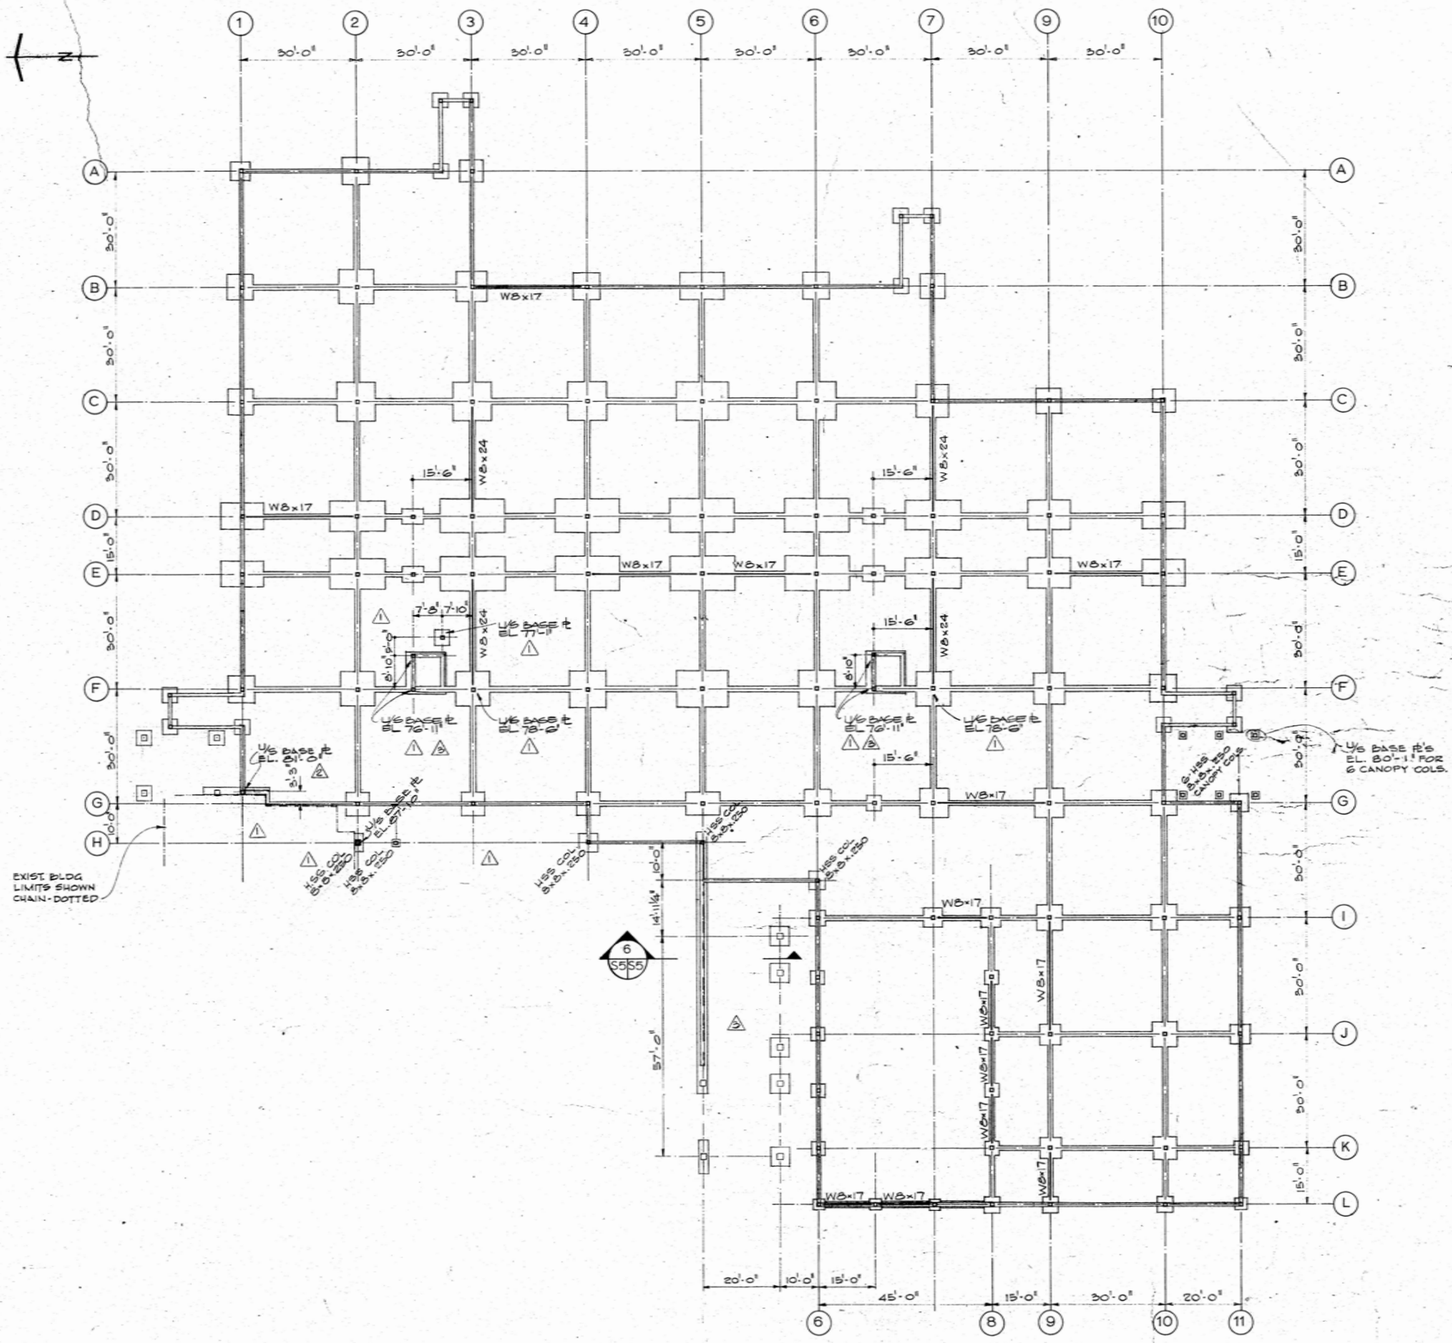


FOUNDATION PLAN

SCALE : 1 INCH = 16 FEET

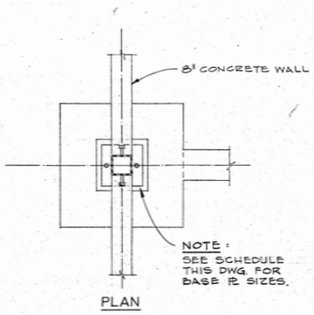

TYPICAL EXTERIOR COLUMN BASE

TYPICAL INTERIOR COLUMN BASE

COLUMN SCHEDULE		
SIZE	LOCATION	NO. REQ'D.
HSS 8x8x.500	B2, C2, C3, C4, C5, C6, D2, D4, D5, D6, E2, E4, E5, E6, F2, F4, F5, F6, F7, G6	TOTAL – 20
HSS 8x8x.375	B3, B4, B5, B6, C7, D2, D7, D9, E2, E7, E9, F2, F9, G7, G9	TOTAL – 15
HSS 8x8x.250	A1, A2, A3, B1, B7, C1, C9, C10, D1, D10, E1, E10, F1, F10, G1, G2, G3, G4, G5, G10, G11, I6, I7, L7, L8, L9, L10, I-11, I-15'-6, J6, J8, J10, J11, J-15'-6, K6, K9, K10, K11, L6, L6-15', L9, L10, L11, G6+14'-6" PLUS 35 WALKWAY AND CANOPY COLUMNS.	TOTAL – 77 ⚠
HSS 6x6x.250	ALL OTHER COLUMNS UNLESS NOTED SPECIFICALLY SHALL BE HSS 6x6.250	TOTAL – 22 ⚠

COLUMN BASE PLATES			
SIZE	LOCATION	NO. REQ'D.	A. BOLTS/PL
16x16x1	ALL EXTERIOR 8x8 COLS. EXCEPT AT C7. ALL INTERIOR 8x8 COLS FROM LINE G TO LINE K INCL. + 5 WALKWAY COLS.	TOTAL – 57	2 EACH. TOTAL 114 ⚠
16x16x1 1/2	EXTERIOR 8x8 COL AT C7. ALL INTERIOR 8x8 COLS FROM LINE B TO LINE F INCL.	TOTAL – 27	2 EACH, TOTAL 54
12x12x3/4	ALL 6x6 COLUMNS	TOTAL – 22	4 EA./PLT - 88 ⚠
16x16x3/4	ALL 8x8 CANOPY COLUMNS	TOTAL - 28	4EA/PLT. 112 ⚠

NOTE:
SEE REFERENCE DRAWING S100 FOR EXTENT OF CONCRETE WORK COVERED IN PHASE I CONTRACT (N.I.C.) AND REPEATED ON THIS DRAWING FOR INFORMATION ONLY.
ALL STRUCTURAL STEEL & STEEL DECKING SHOWN ON DWGS S1 TO S10 (INCLUSIVE) IS INCLUDED IN A PRETENDER DATED NOVEMBER, 1973.

BUSH & BOHLMAN LTD.
consulting engineers
1171 MELVILLE ST. VANCOUVER, B.C. TELEPHONE 688-9881
PROFESSIONAL ENGINEER PROVINCE OF BRITISH COLUMBIA
L.C. BOHLMAN


NO.	DATE	REVISIONS DESCRIPTION
1	14/1/75	GENERAL REVISION. ISSUED TO DOMINION BRIDGE
2	1/8/74	'HOLD' AREA RELEASED WITH MODIFICATION
3	22/3/74	GENERAL REVISION
4	1/4/74	ISSUED FOR PHASE II MAIN CONTRACT
5	19/9/06	Revised to 'As Builts'

PROJECT NO. 89857
DATE Nov. 16/73 SCALE NOTED
DRAWN G.C.P. CHECK H.C.
APPROVED Les


GOVERNMENT OF THE YUKON TERRITORY

DRAWING TITLE
FOUNDATION PLAN

DRAWING NO.

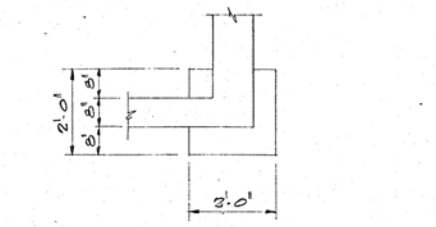


PLAN

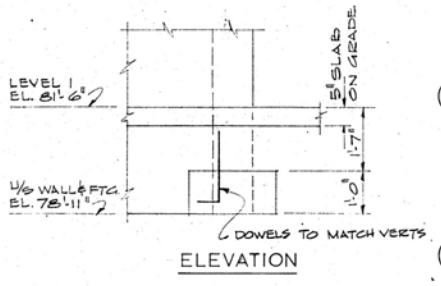


ELEVATION

3 S2|S2 FOOTING 1 DETAIL
1/2"=1'-0"

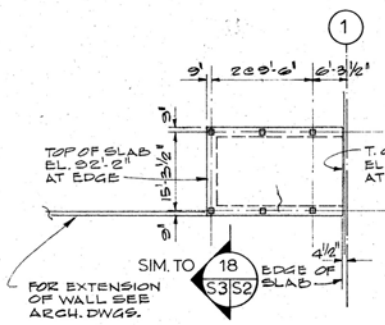

NORTH ENTRANCE
8" RAMP SLAB
SCALE: 1/16"=1'-0"

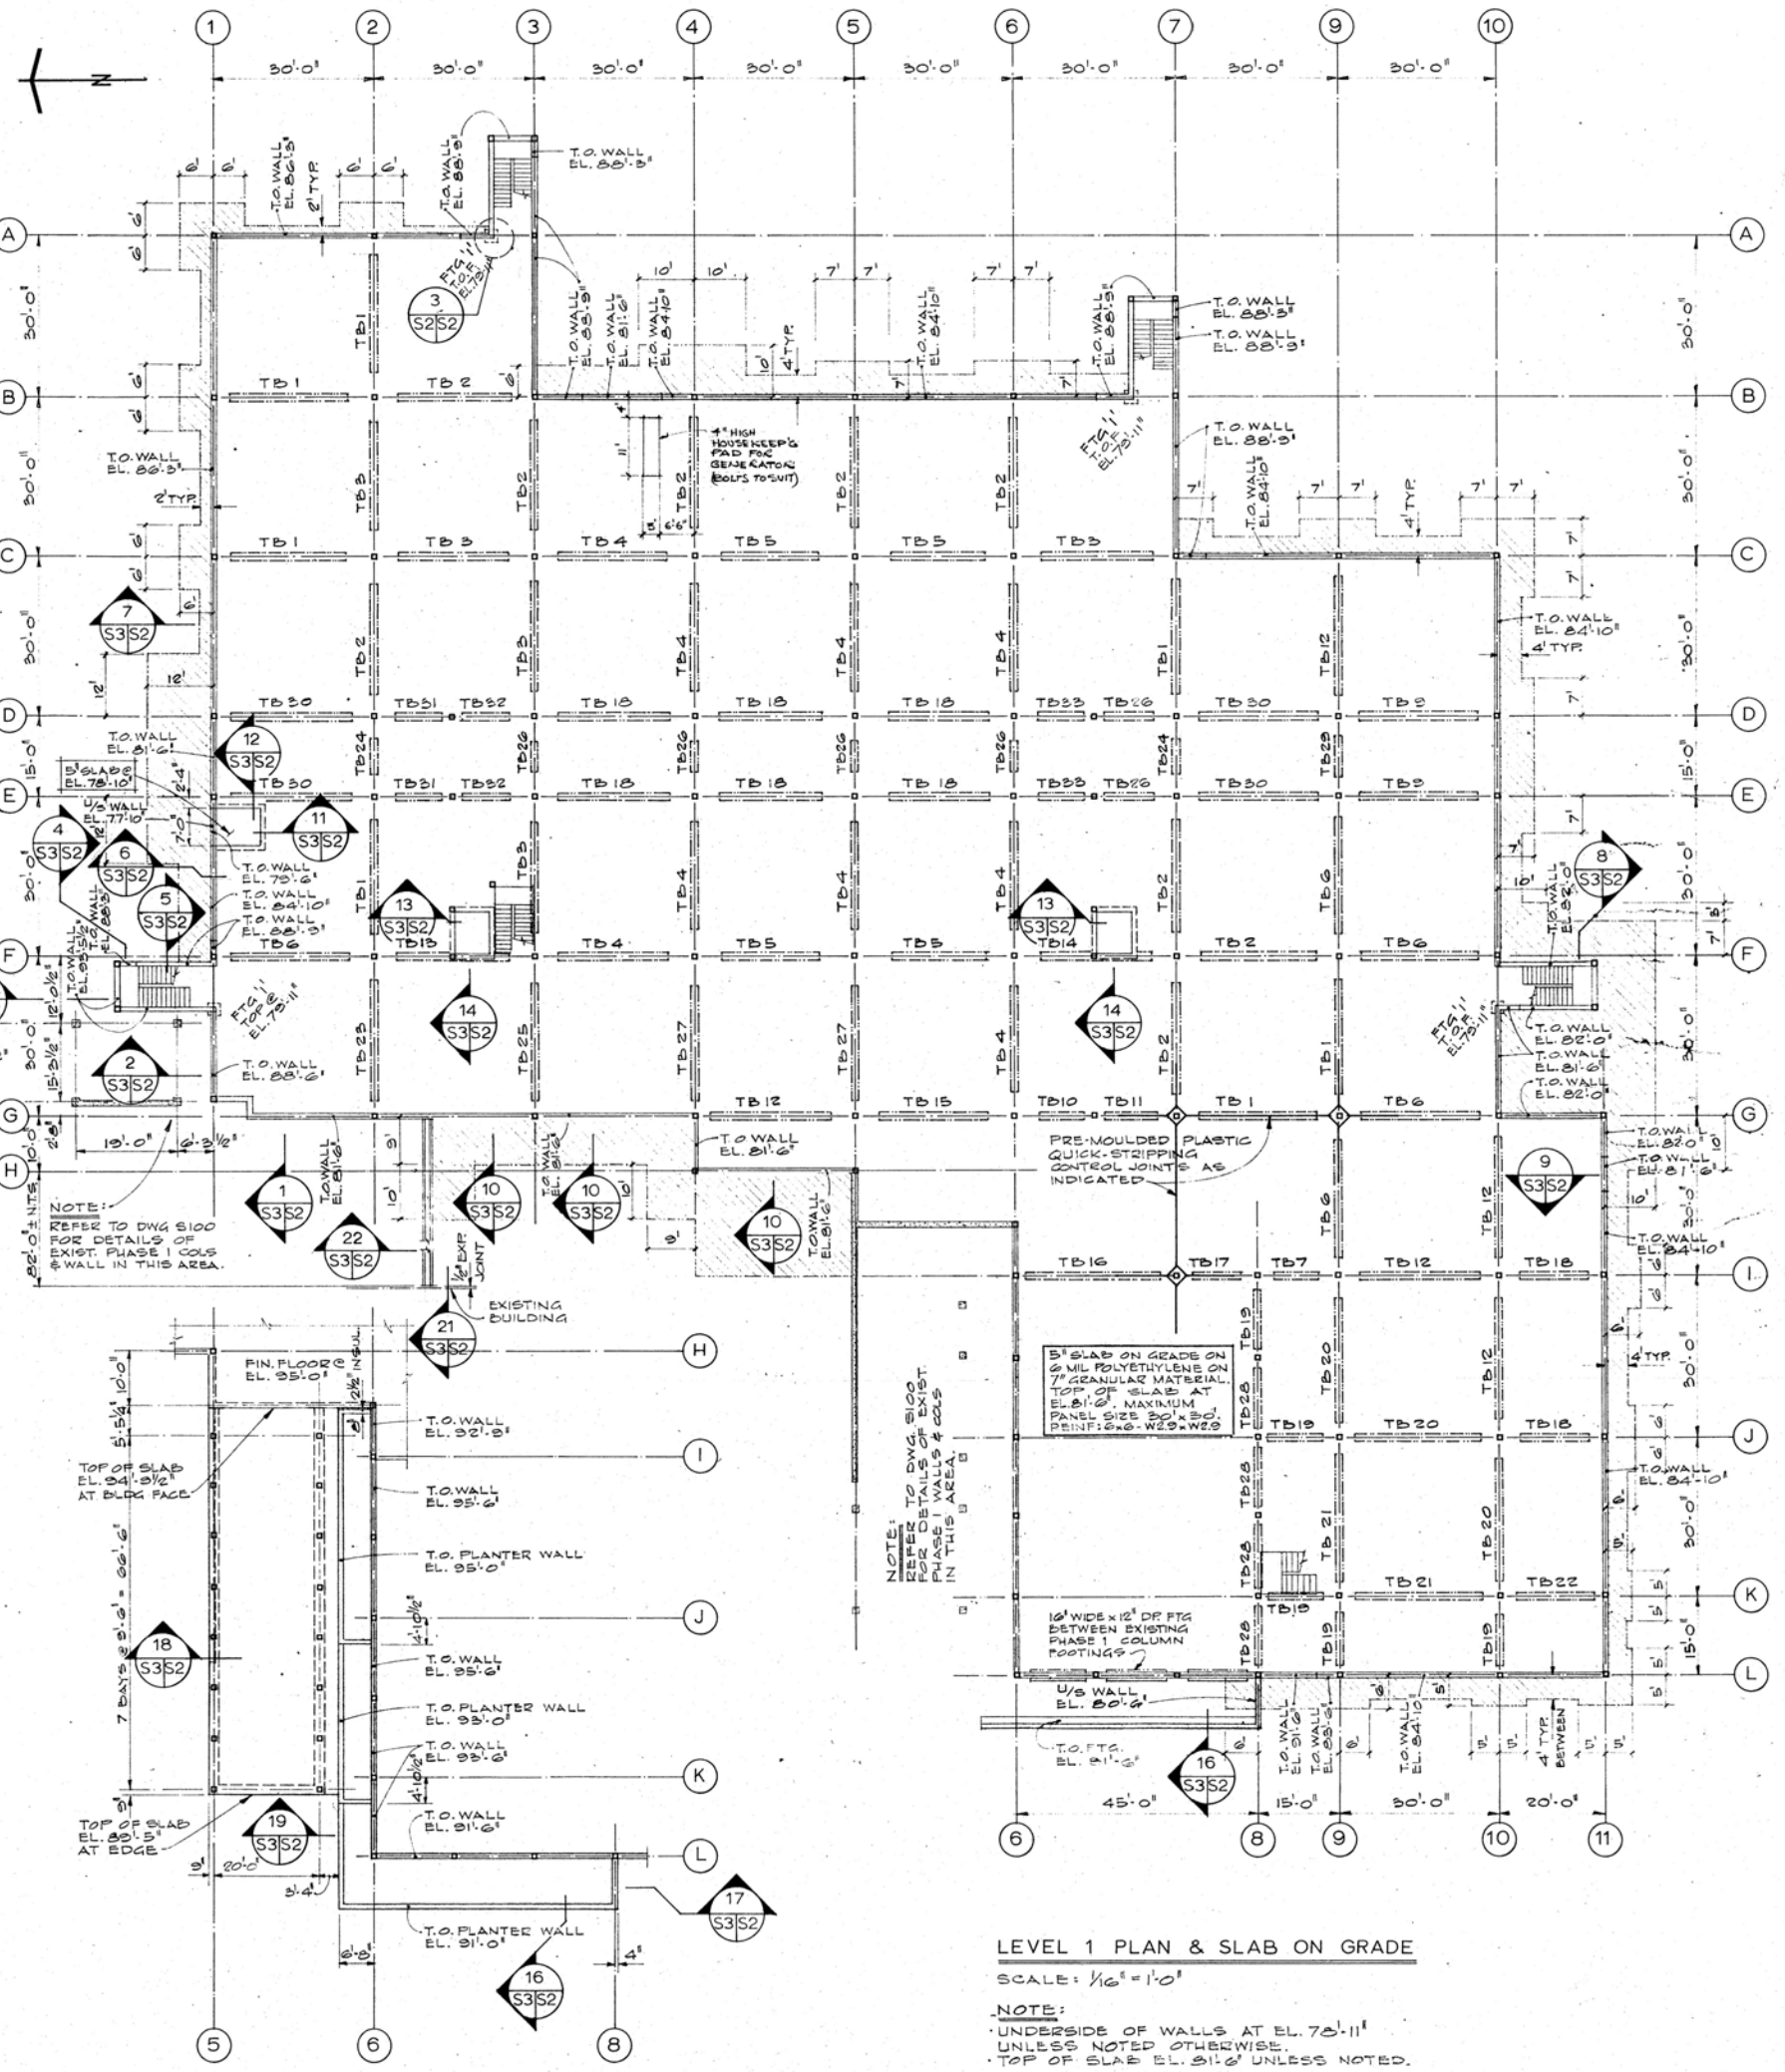


LEVEL 1 PLAN & SLAB ON GRADE
SCALE: 1/16"=1'-0"

NOTE:
- UNDERSIDE OF WALLS AT EL. 78'-11" UNLESS NOTED OTHERWISE.
- TOP OF SLAB EL. 81'-6" UNLESS NOTED.


WEST ENTRANCE
8" RAMP SLAB & PLANTERS
SCALE: 1/16"=1'-0"

TIE-BEAM SCHEDULE


NO.	WIDTH	DEPTH	LENGTH	REINFORCING	STIRRUPS
TB1			21'-6"		
TB2			21'-0"		
TB3			20'-0"		
TB4			20'-0"		
TB5	16"	16"	18'-0"	4-#6 LONGIT.	#3@12"
TB6			22'-0"		
TB7			8'-3"		
TB8			8'-3"		
TB9			19'-0"		
TB10			7'-3"		
TB11			9'-3"		
TB12			22'-6"		
TB13	16"&11"	16"	21'-0"		
TB14	16"&11"	16"	20'-0"		
TB15			20'-3"		
TB16			24'-6"		
TB17			9'-0"		
TB18			13'-3"		
TB19			10'-0"		
TB20			23'-3"		
TB21	16"	16"	24'-0"		
TB22			15'-0"		
TB23			22'-9"		
TB24			6'-6"		
TB25			22'-3"		
TB26			5'-6"		
TB27			21'-9"		
TB28			11'-0"		
TB29			7'-6"		
TB30			17'-6"		
TB31			4'-6"		
TB32			4'-4½"		
TB33			5'-4½"		

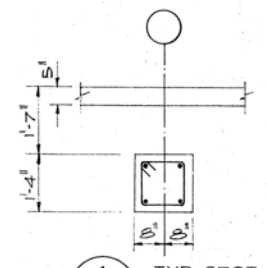


1 S2|S2 TYP. SECT.
1/2"=1'-0"

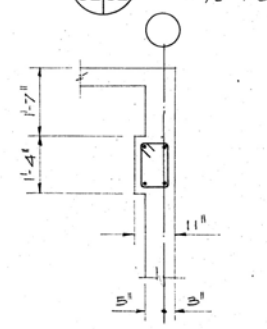

2 S2|S2 AT ELEVATORS
1/2"=1'-0"

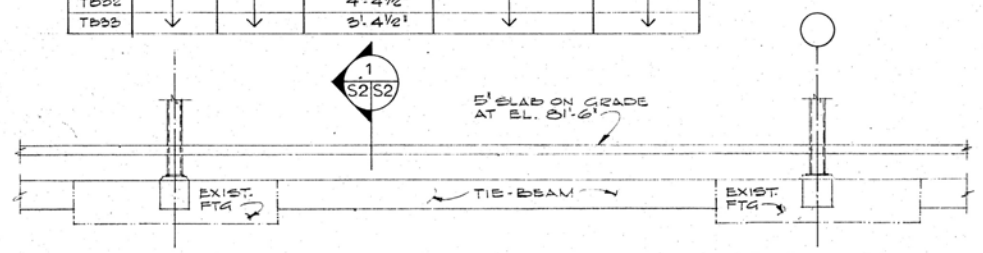

TYPICAL TIE-BEAM ELEVATION

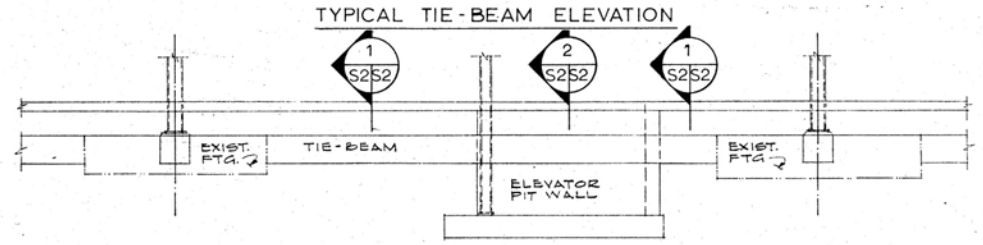

TB13 & TB14 ELEVATION

GENERAL NOTES

1. THIS BUILDING HAS BEEN DESIGNED IN ACCORDANCE WITH THE NATIONAL BUILDING CODE 1970.
2. ALL FOUNDATIONS TO BEAR ON NATIVE MATERIAL HAVING A SAFE BEARING CAPACITY OF 3500 P.S.F.
3. FOR DESIGN LOADS SEE DRAWING S4.
4. CONCRETE TO HAVE A MINIMUM COMPRESSIVE STRENGTH OF 3000 P.S.I. AT 28 DAYS.
5. CONCRETE PROTECTION TO REINFORCING STEEL TO BE AS SPECIFICATIONS.
6. REINFORCING STEEL:
   #3 & #4 BARS ——— GRADE 40
   #5 & LARGER ——— GRADE 60
7. FOR NOTES ON STRUCTURAL STEEL AND METAL DECKING SEE DRAWING S4.
8. REINFORCED MASONRY WALLS IN ACCORDANCE WITH THE NATIONAL BUILDING CODE, SECTION 4.4. CONCRETE FILL SHALL BE 3000 P.S.I. AT 28 DAYS WITH A MAXIMUM AGGREGATE SIZE OF 3/8".
9. READ WITH ARCHITECTUAL, MECHANICAL AND ELECTRICAL DRAWINGS AND STRUCTURAL SPECIFICATIONS.
10. PROVIDE HORIZONTAL CORNER BARS TO MATCH SIZE AND SPACING OF HORIZONTAL REINFORCEMENT AT ALL WALL CORNERS AND INTERSECTION OF WALLS. BARS TO BE 6'-0" LONG.
11. EXTERIOR EXTENSION OF INSULATION SHOWN THUS ▨ ON LEVEL 1 PLAN. FOR INSULATION DETAILS SEE ARCHITECTURAL DRAWINGS AND SPECIFICATIONS.
12. SEE DIVISION 1 SPECIFICATIONS FOR STRUCTURAL STEEL SUBSTRADE CONDITIONS.

BUSH & BOHLMAN LTD.
consulting engineers
1171 MELVILLE ST. VANCOUVER B.C. TELEPHONE 688-9861

REVISIONS		
NO.	DATE	DESCRIPTION
1	1/4/74	ISSUED FOR PHASE II MAIN CONTRACT
2	2/11/00	Revised to 'As Built's'

PROJECT NO. 89857
DATE APR 1/74 | SCALE NOTED
DRAWN RCP | CHECK HC
APPROVED


GOVERNMENT OF THE YUKON TERRITORY

DRAWING TITLE
LEVEL 1 PLAN

PROJECT TITLE
TERRITORIAL ADMINISTRATION BUILDING
WHITEHORSE, Y.T.

DRAWING NO. S3

2002

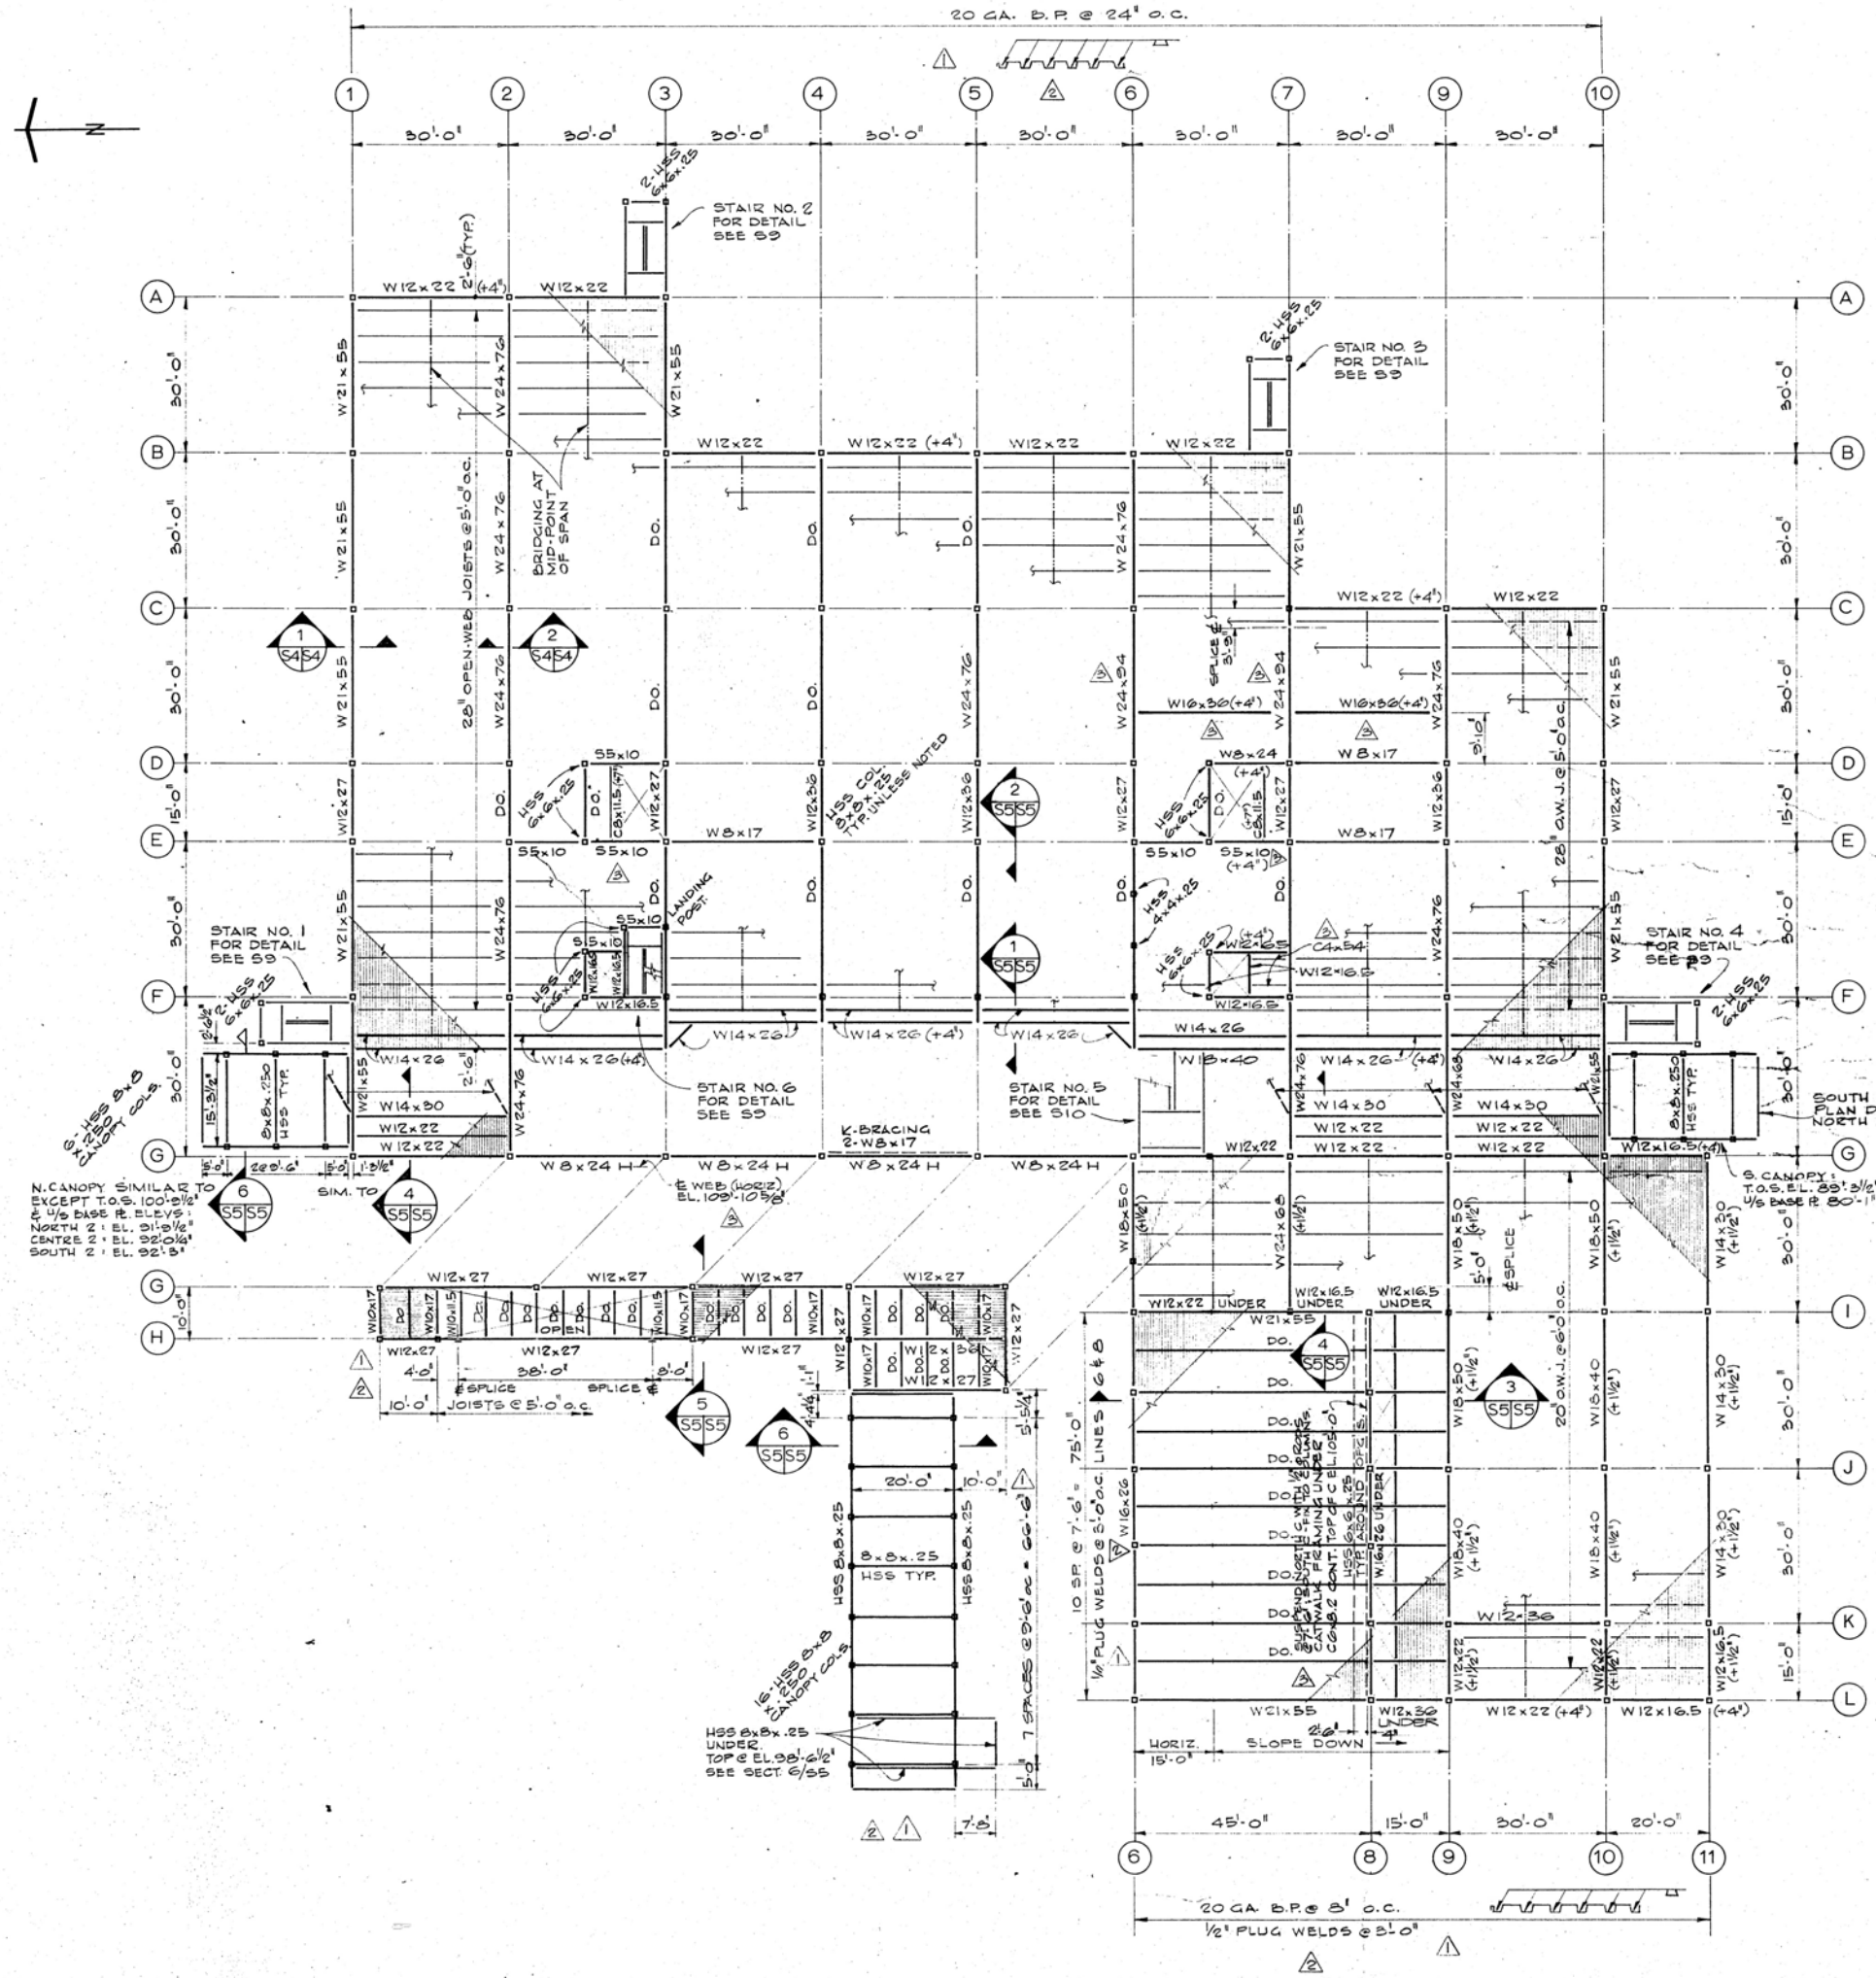

LEVEL 3 FRAMING PLAN


SCALE: 1 INCH = 16 FEET


NOTE:


ALL COLUMNS THIS FLOOR HSS 8x8x.250 UNLESS NOTED OTHERWISE IN PLAN.


BAR JOIST SUPERIMPOSED LOADING.

D.L.	325 P.L.F.	ALL 28' O.W.J.
L.L.	375 P.L.F.	
D.L.	165 P.L.F.	ALL 20' O.W.J.
L.L.	390 P.L.F.	

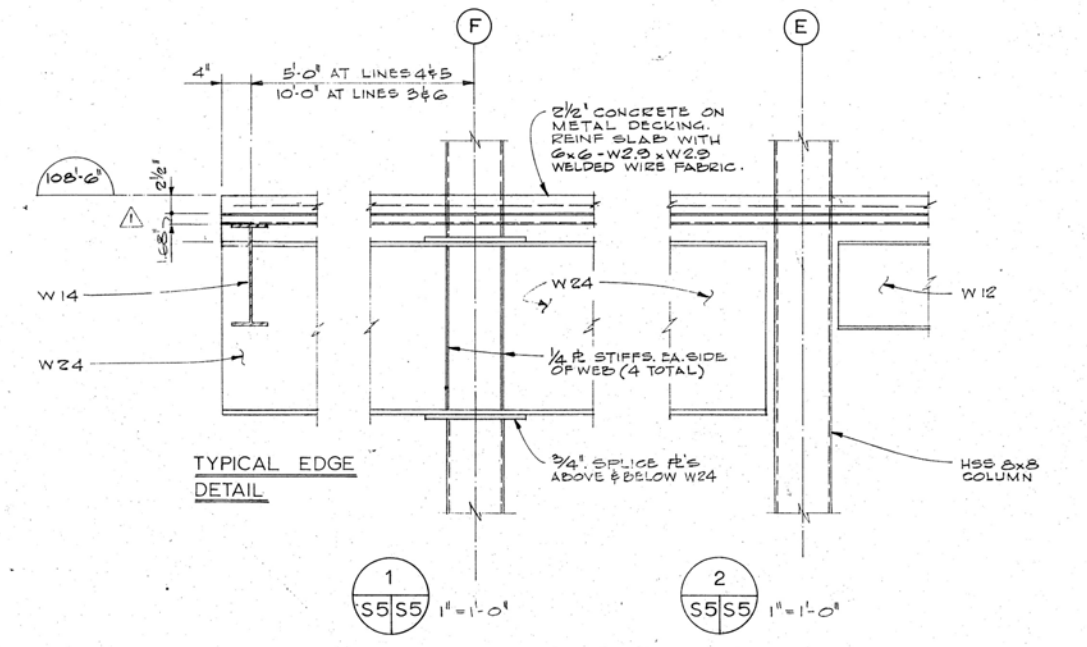

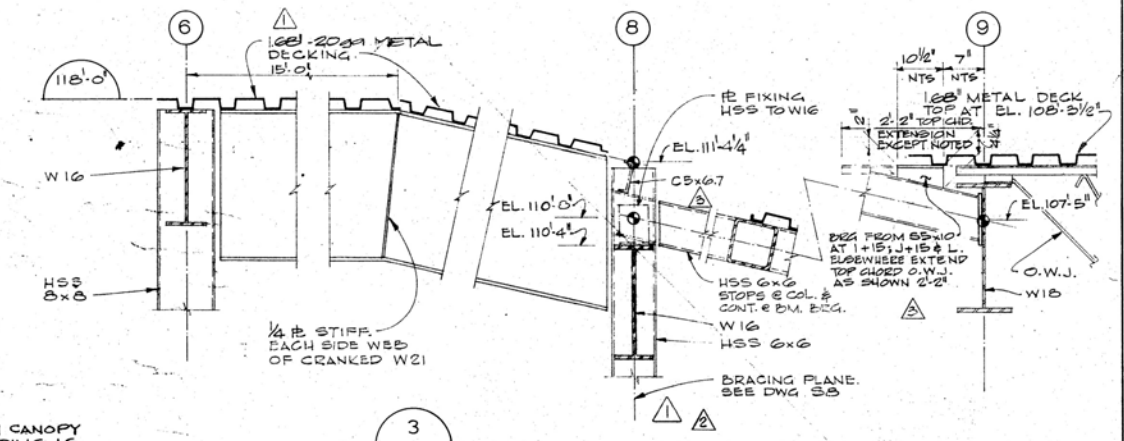

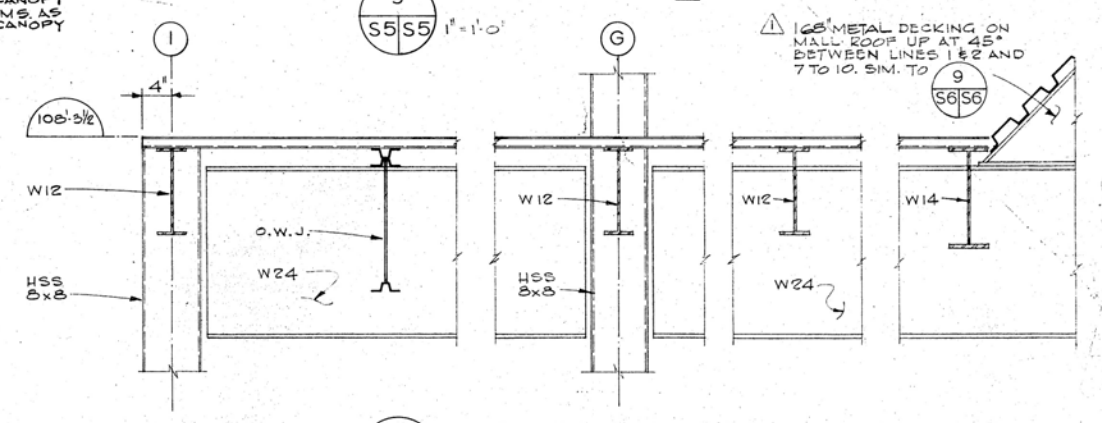

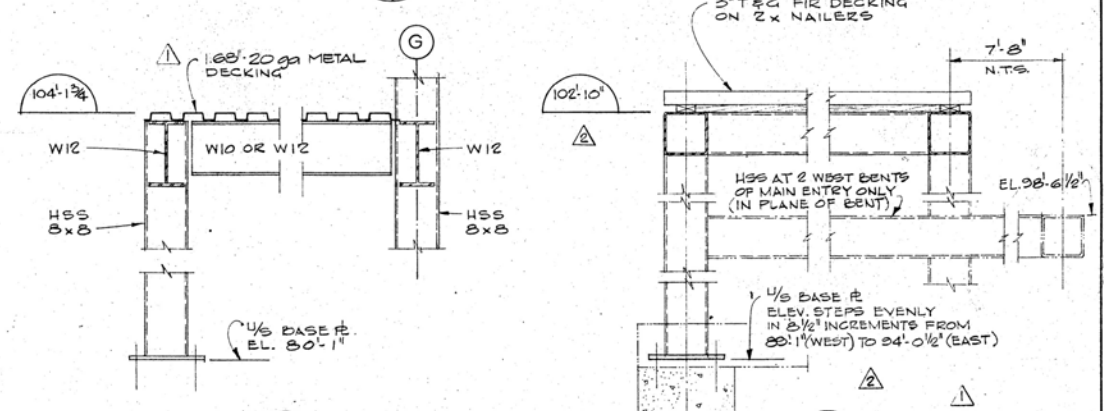

BUSH & BOHLMAN LTD. consulting engineers	REVISIONS	PROJECT NO. 89857
1171 MELVILLE ST. VANCOUVER B.C. TELEPHONE 688-8861	NO. DATE DESCRIPTION	DATE NOV. 16/73 SCALE NOTED
PROFESSIONAL ENGINEER PROVINCE OF BRITISH COLUMBIA L.C. BOHLMAN	1 4/1/74 GENERAL REVISION - ISSUED TO DOMINION BRIDGE	DRAWN GCP CHECK HC
	2 21/1/74 HOLD AREAS RELEASED WITH MODIFICATIONS.	APPROVED L.C.B.
	3 22/3/74 GENERAL REVISION	
	4 25/10/76 Revised to 'As Builts'	


GOVERNMENT OF THE YUKON TERRITORY

DRAWING TITLE: LEVEL 3 FRAMING

PROJECT TITLE: TERRITORIAL ADMINISTRATION BUILDING WHITEHORSE, Y.T.

DRAWING NO. S5

0003

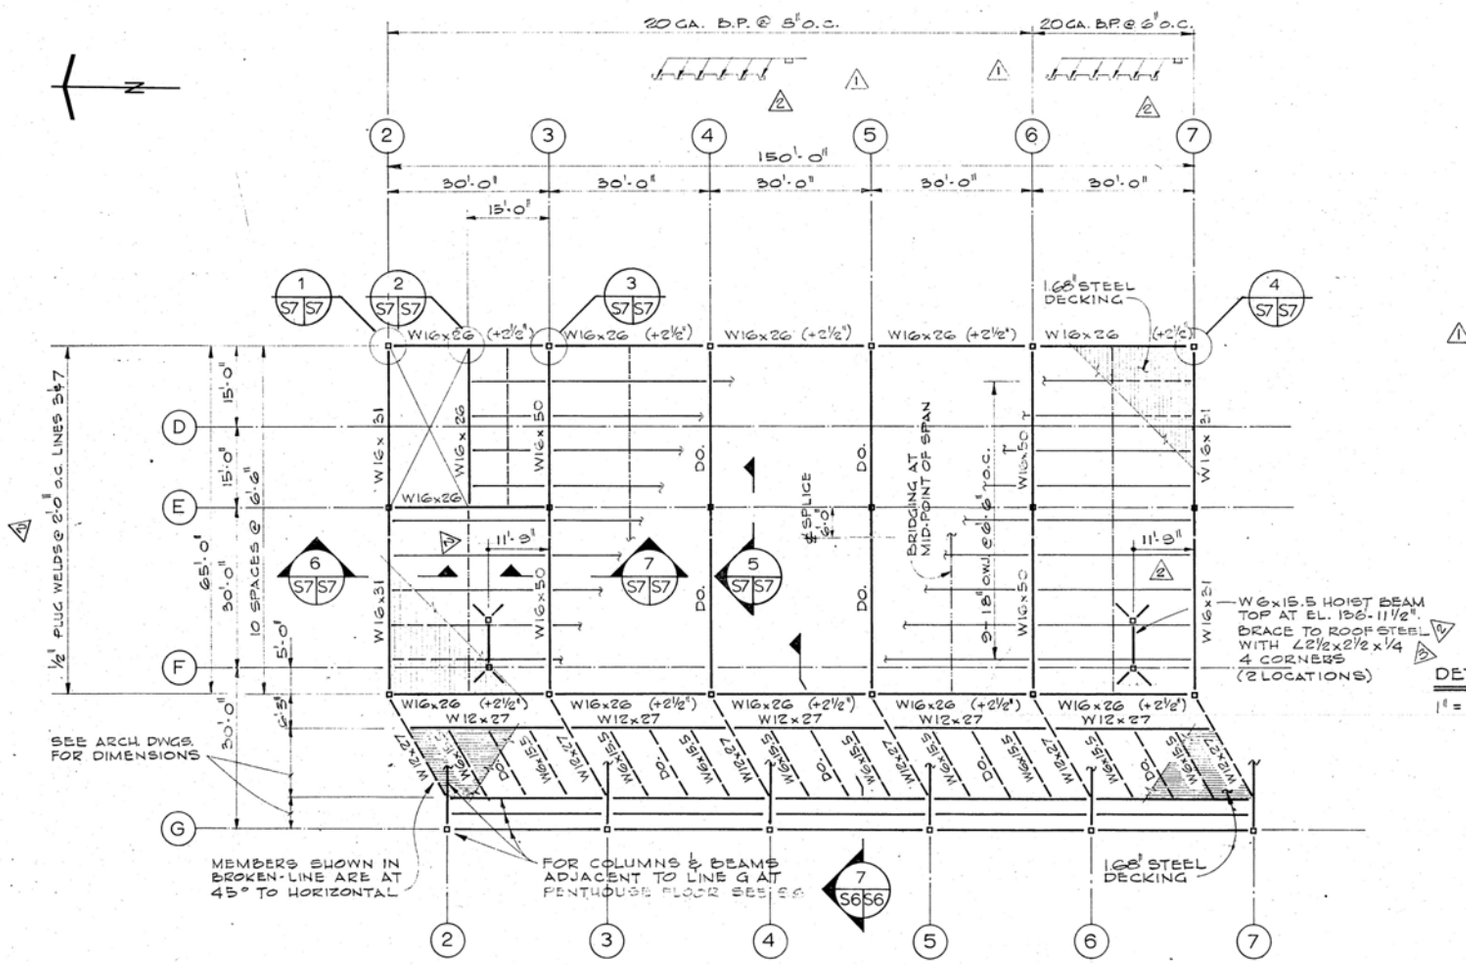


PENTHOUSE ROOF FRAMING PLAN


SCALE: 1 INCH = 16 FEET

BAR JOIST SUPERIMPOSED LOADING:

D.L. 210 P.L.F.
L.L. 175 P.L.F.

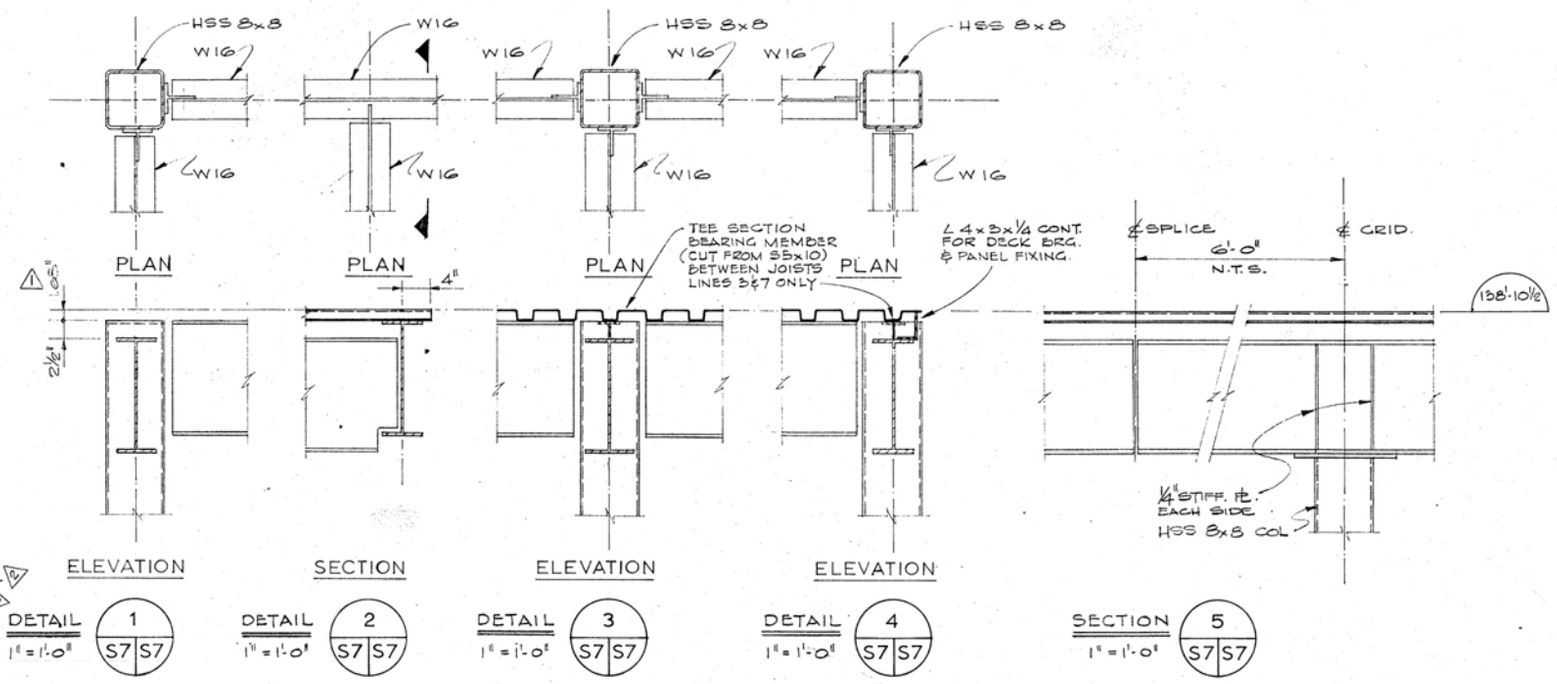

DETAIL 1 S7|S7 — 1" = 1'-0"
DETAIL 2 S7|S7 — 1" = 1'-0"
DETAIL 3 S7|S7 — 1" = 1'-0"
DETAIL 4 S7|S7 — 1" = 1'-0"
SECTION 5 S7|S7 — 1" = 1'-0"

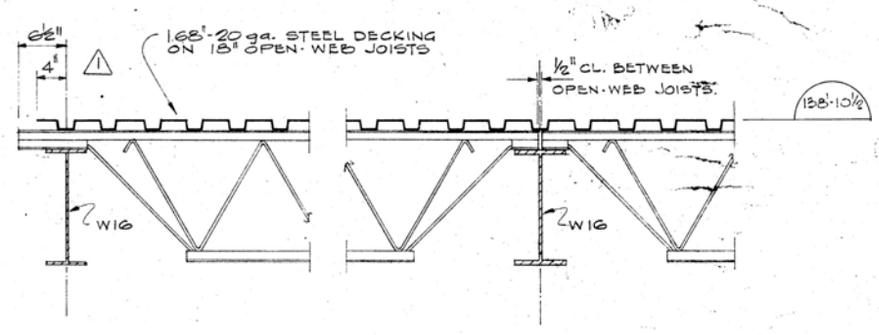

SECTION 6 S7|S7 — 1" = 1'-0"
SECTION 7 S7|S7 — 1" = 1'-0"

BUSH & BOHLMAN LTD.
consulting engineers
1171 MELVILLE ST. VANCOUVER B.C. TELEPHONE 688-9861

PROFESSIONAL ENGINEER — PROVINCE OF BRITISH COLUMBIA — L.C. BOHLMAN

NO.	DATE	REVISIONS DESCRIPTION
1	4/1/74	GENERAL REVISION - ISSUED TO DOMINION BRIDGE
2	1/2/74	HOLD' AREA RELEASED WITH MODIFICATIONS.
3	22/3/74	ELEVATOR HOIST BEAM BRACING REVISED
4	1/4/74	ISSUED FOR PHASE II MAIN CONTRACT
5	78/10/06	Revised to 'As Built'


PROJECT NO. 89857
DATE NOV. 16/73 | SCALE NOTED
DRAWN GCP | CHECK HC
APPROVED

GOVERNMENT OF THE YUKON TERRITORY


DRAWING TITLE
PENTHOUSE ROOF FRAMING

PROJECT TITLE
TERRITORIAL ADMINISTRATION BUILDING
WHITEHORSE, Y.T.


DRAWING NO. 0004
67

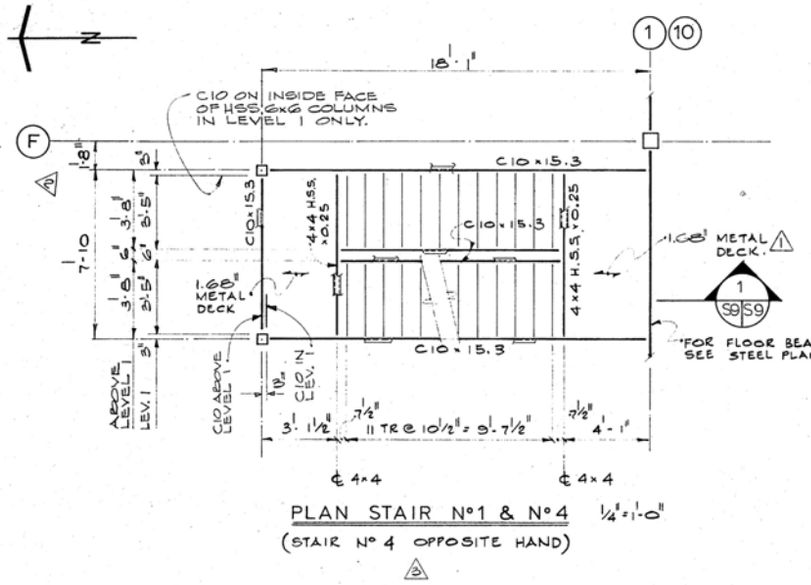


PLAN STAIR N° 1 & N° 4 1/4"=1'-0"
(STAIR N° 4 OPPOSITE HAND)
△2

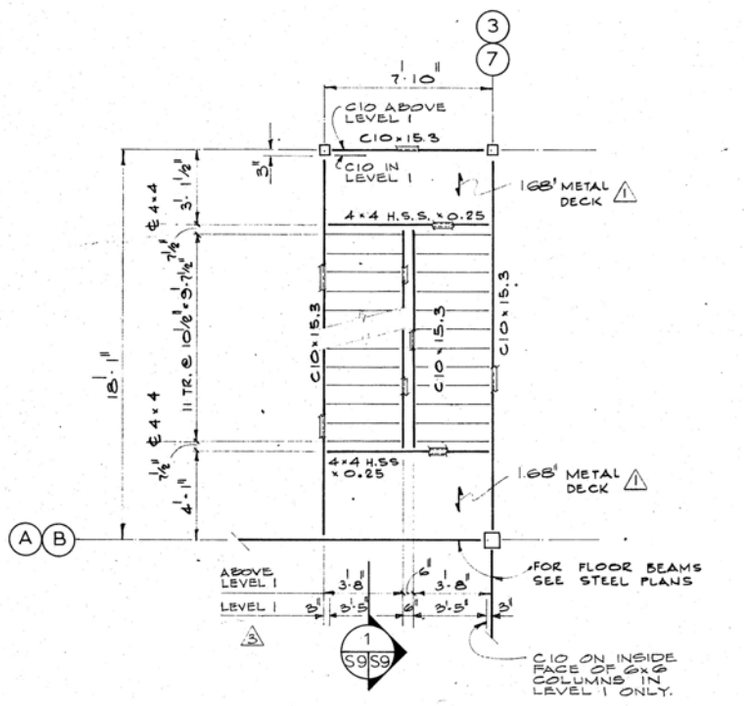


PLAN STAIR N° 2 & N° 3
△2

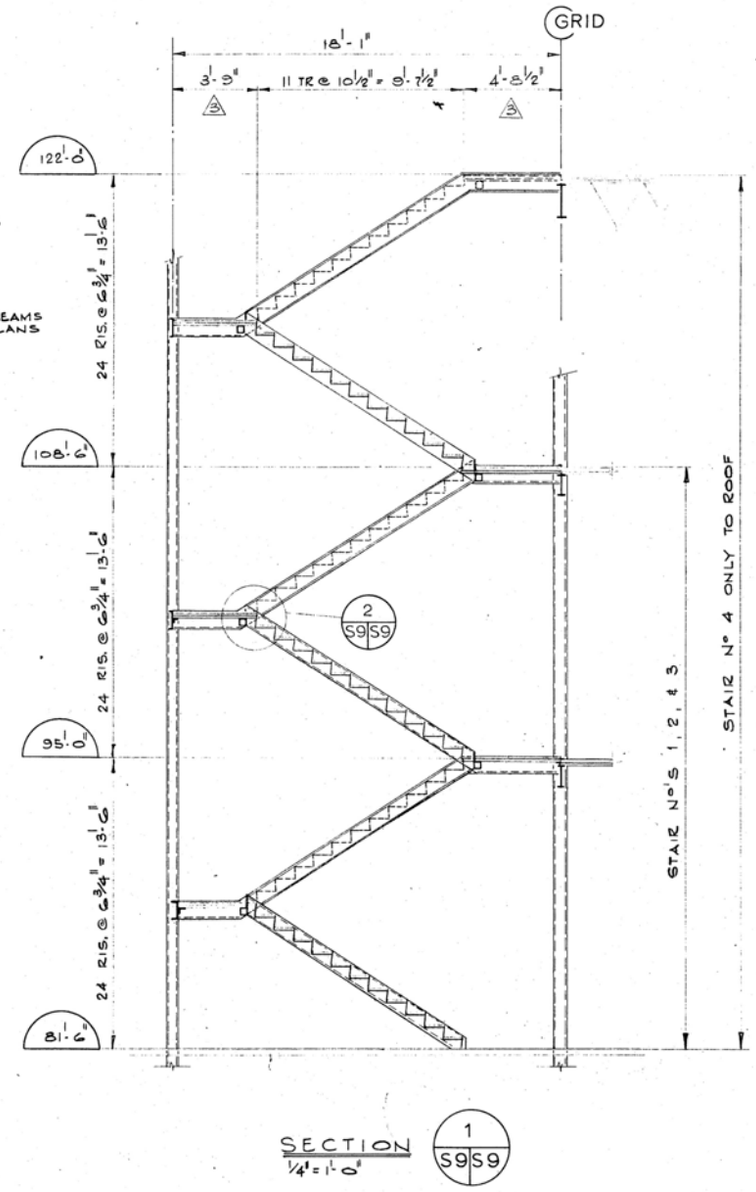


SECTION 1/4"=1'-0" (1 S9|S9)

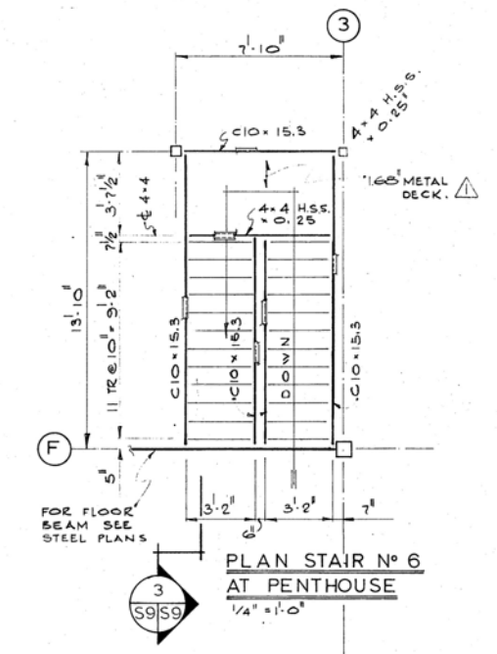


PLAN STAIR N° 6
AT PENTHOUSE
1/4"=1'-0"
(3 S9|S9)

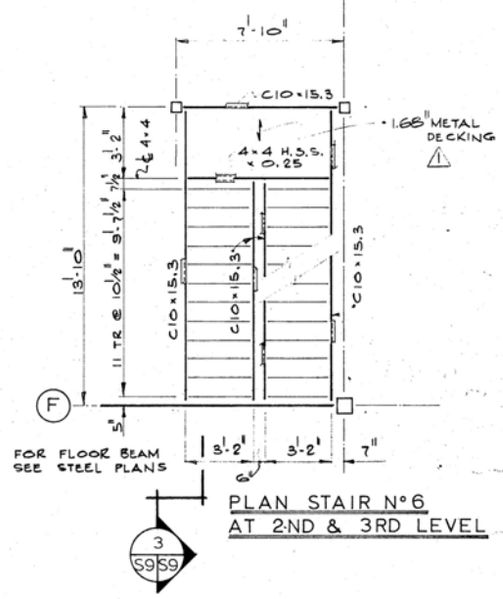


PLAN STAIR N° 6
AT 2ND & 3RD LEVEL
(3 S9|S9)

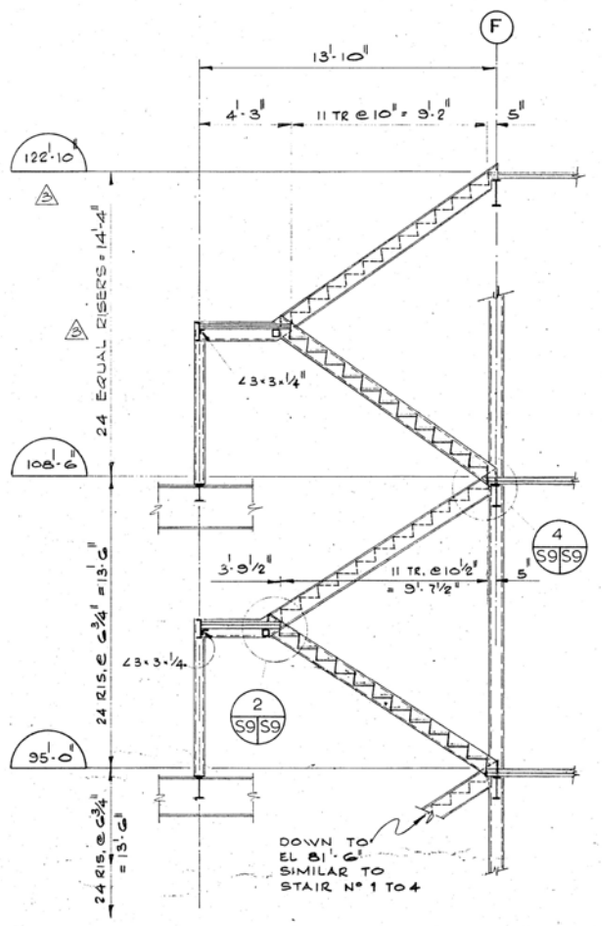


SECTION 1/4"=1'-0" (3 S9|S9)

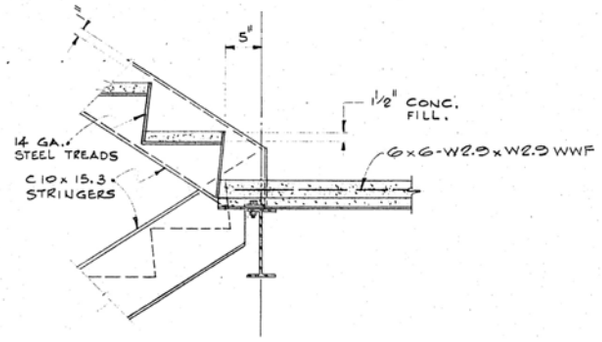

DETAIL 1"=1'-0" (4 S9|S9)

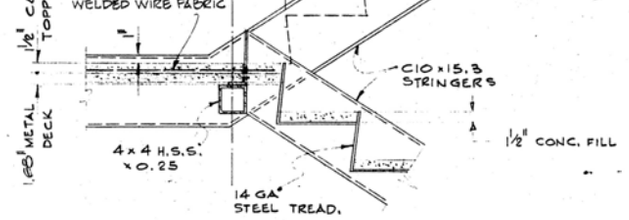

DETAIL 1"=1'-0" (2 S9|S9)

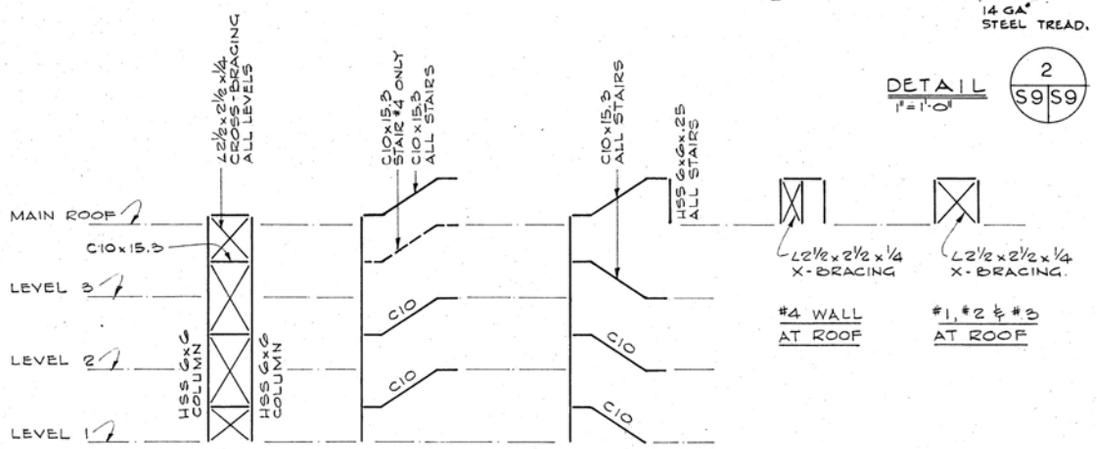

END WALL ALL STAIRS
#1 & #4 - EAST
#2 & #3 - SOUTH
#1 & #4 - WEST
#2 & #3 - NORTH

#4 WALL AT ROOF
#1, #2 & #3 AT ROOF

STAIRS NO. 1, 2, 3 & 4 BRACING
SCALE: 1/16"=1'-0"
NOTE: SEE PLANS FOR DIMENSIONS

BUSH & BOHLMAN LTD.
consulting engineers
1171 MELVILLE ST VANCOUVER B.C. TELEPHONE 688-9861

PROFESSIONAL ENGINEER — PROVINCE OF BRITISH COLUMBIA — L. C. BOHLMAN


NO.	DATE	REVISIONS DESCRIPTION
1	6/1/74	GENERAL REVISION. ISSUED TO DOMINION BRIDGE
2	1/2/74	REVISED LOCATION OF STAIR NO. 1 & NO. 4 RELATIVE TO GRID 'F'
3	22/3/74	LEVEL 1 STRINGERS RELOCATED; STAIR NO. 6 TOP RUN REVISED.
4	1/4/74	ISSUED FOR PHASE II MAIN CONTRACT.
5	28/9/90	Revised to 'As Builts'

PROJECT NO. 89857
DATE NOV. 16/73 | SCALE NOTED
DRAWN GT | CHECK HC
APPROVED

GOVERNMENT OF THE YUKON TERRITORY

DRAWING TITLE
STAIR SHEET No. 1
PROJECT TITLE
TERRITORIAL ADMINISTRATION BUILDING
WHITEHORSE, Y.T.

DRAWING NO. S9

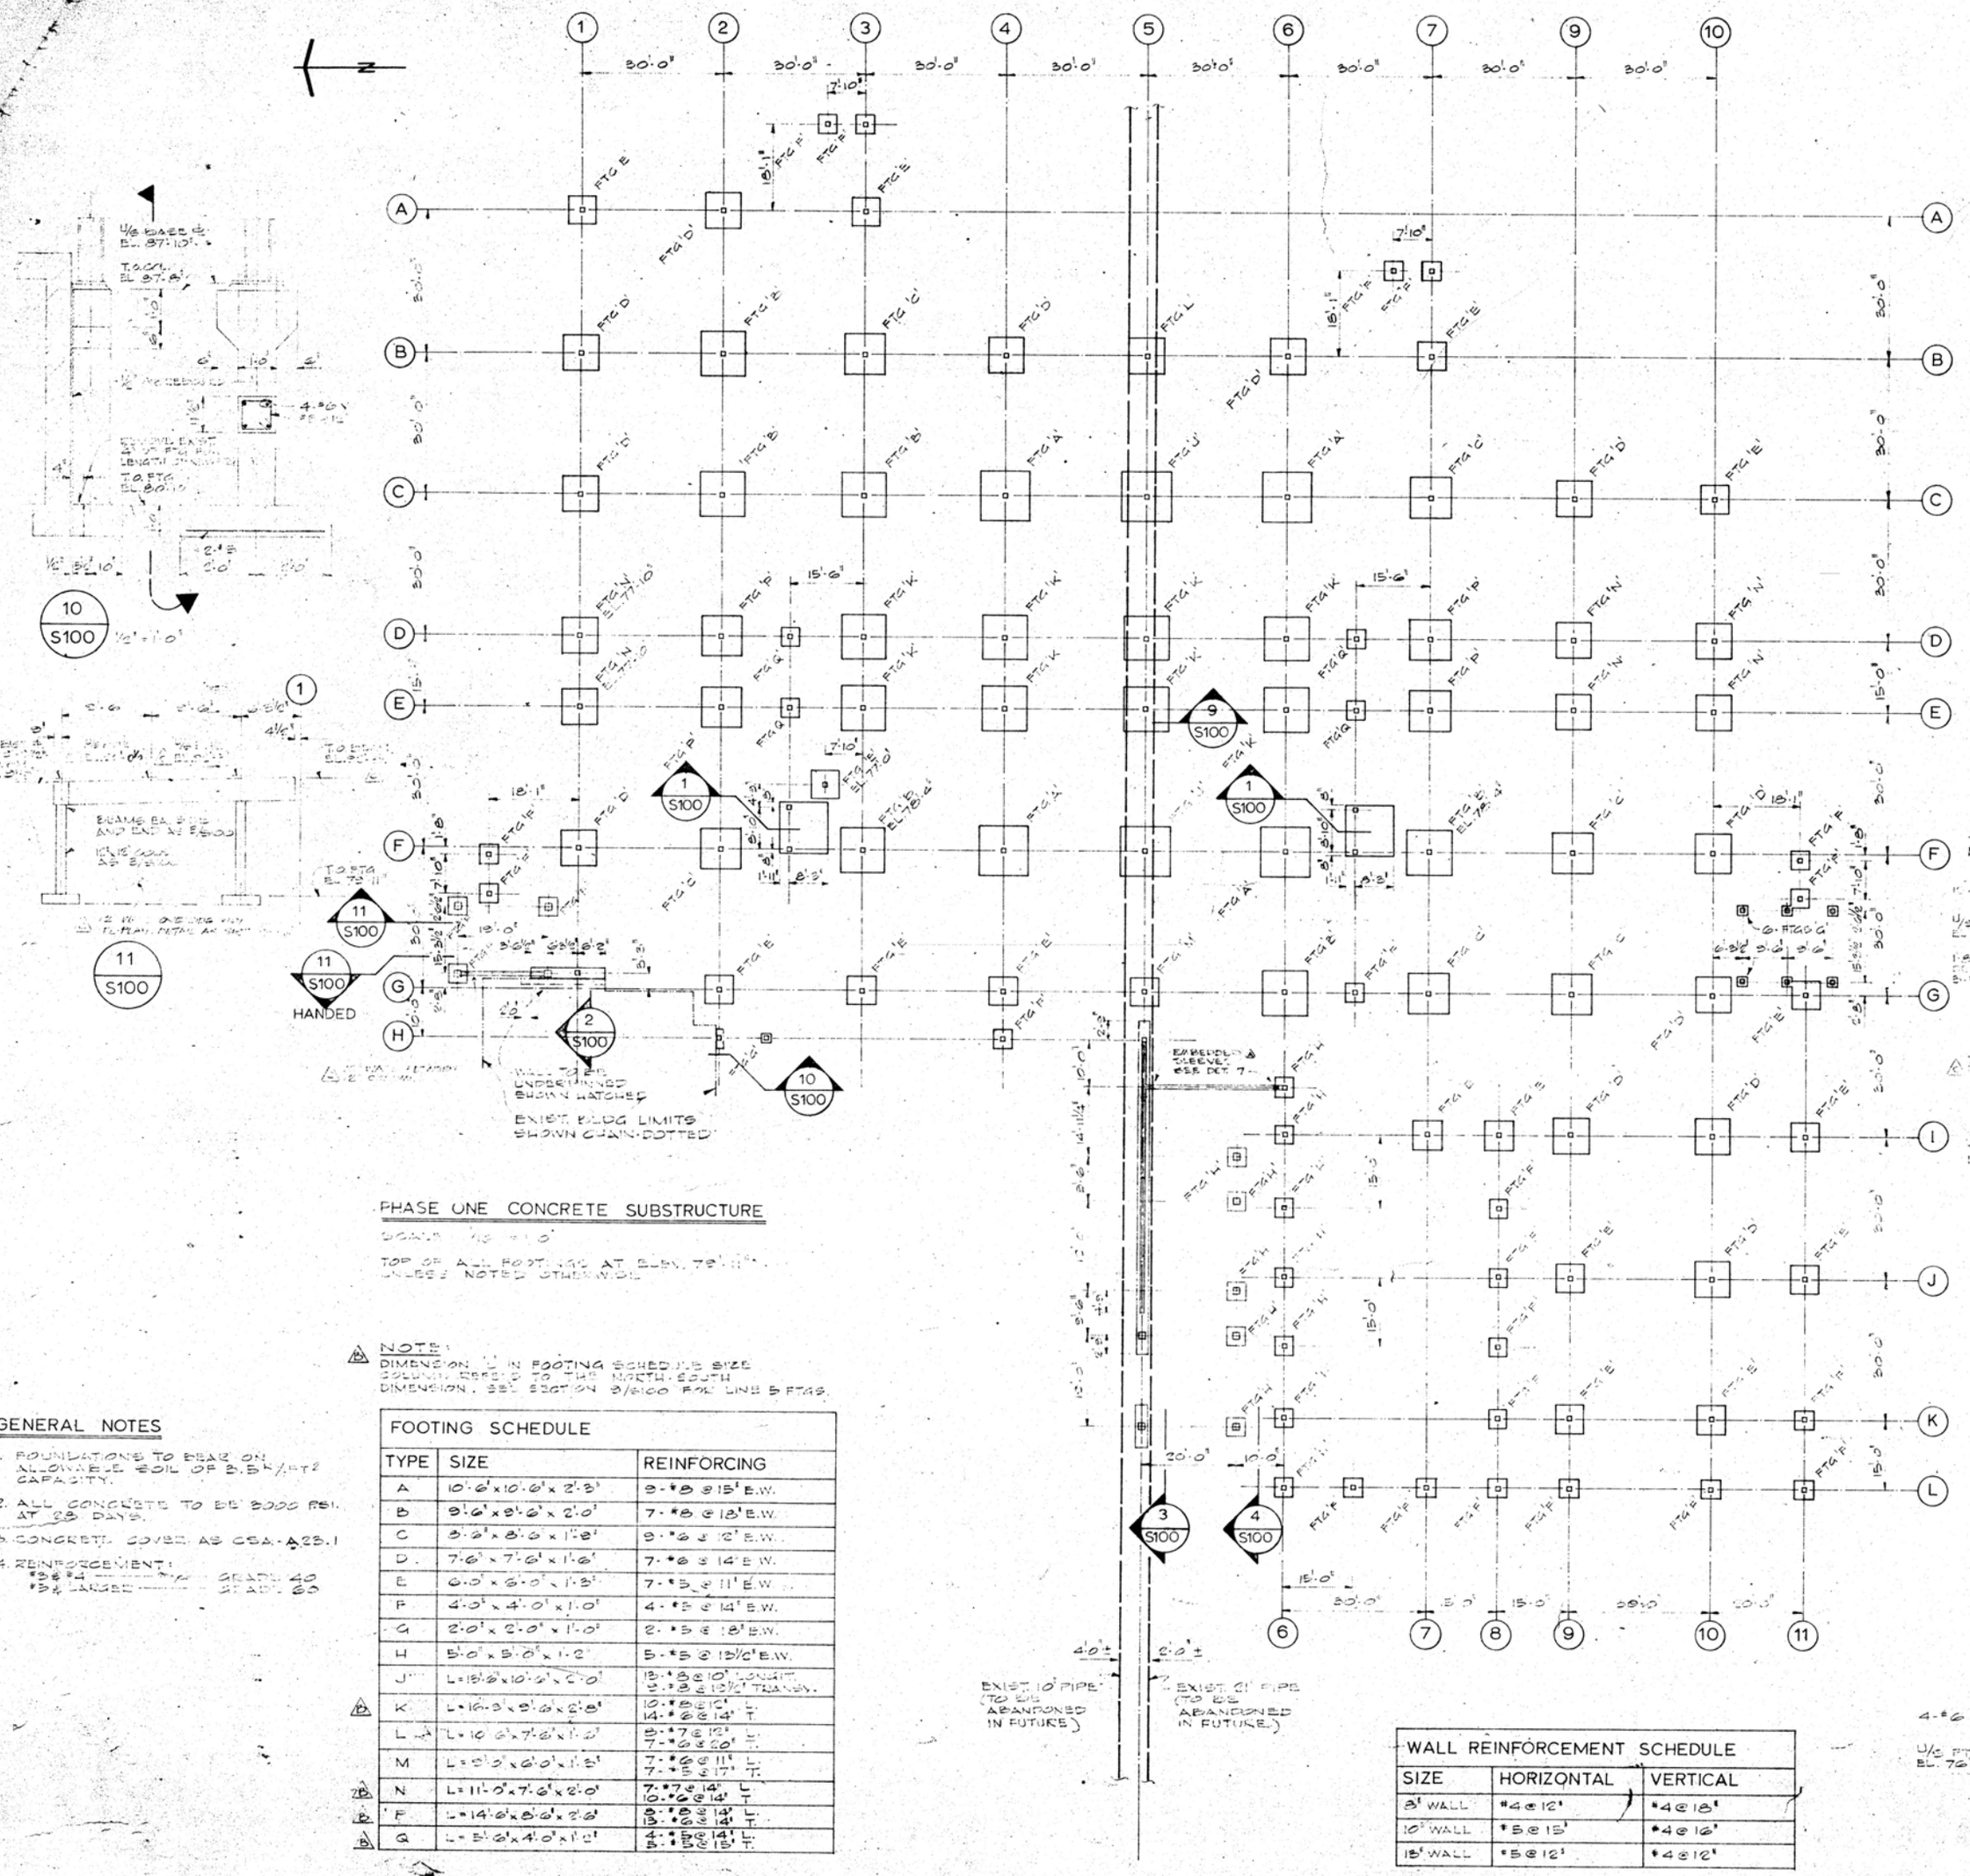

PHASE ONE CONCRETE SUBSTRUCTURE

SCALE: 1/16" = 1'-0"

TOP OF ALL FOOTINGS AT ELEV. 79'-11" UNLESS NOTED OTHERWISE.

⚠ NOTE:
DIMENSION 'L' IN FOOTING SCHEDULE IS SIZE SQUARE PARALLEL TO THE NORTH-SOUTH DIMENSION. SEE SECTION 9/S100 FOR LINE 5 FTGS.

GENERAL NOTES

1. FOUNDATIONS TO REST ON ALLOWABLE SOIL OF 3.5 KSF/FT² CAPACITY.
2. ALL CONCRETE TO BE 3000 PSI. AT 28 DAYS.
3. CONCRETE COVER AS CSA-A23.1
4. REINFORCEMENT:
   - #3 & #4 ——— GRADE 40
   - #5 & LARGER ——— GRADE 60

FOOTING SCHEDULE		
TYPE	SIZE	REINFORCING
A	10'-6"x10'-6"x 2'-3"	9-#5 @ 15" E.W.
B	9'-6"x9'-6"x 2'-0"	7-#5 @ 15" E.W.
C	8'-3"x8'-6"x 1'-8"	8-#5 @ 12" E.W.
D	7'-6"x7'-6"x 1'-6"	7-#5 @ 14" E.W.
E	6'-0"x6'-0"x 1'-3"	7-#5 @ 11" E.W.
F	4'-3"x4'-0"x 1'-0"	4-#5 @ 14" E.W.
G	2'-0"x2'-0"x 1'-0"	2-#5 @ 12" E.W.
H	5'-0"x5'-0"x 1'-2"	5-#5 @ 12½" E.W.
J	L=18'-6"x10'-6"x 2'-0"	18-#5 @ 10" LONGIT. 7-#5 @ 12½" TRANSV.
⚠ K	L=16'-3"x5'-6"x 2'-8"	10-#5 @ 12" L. 14-#5 @ 14" T.
L	L=10'-6"x7'-6"x 1'-2"	5-#7 @ 12" L. 7-#6 @ 20" T.
M	L=6'-0"x6'-0"x 1'-5"	7-#5 @ 11" L. 7-#5 @ 17" T.
⚠ N	L=11'-0"x7'-6"x 2'-0"	7-#7 @ 14" L. 10-#6 @ 14" T.
⚠ F	L=14'-6"x5'-6"x 2'-6"	8-#5 @ 14" L. 8-#5 @ 14" T.
⚠ G	L=5'-6"x4'-0"x 1'-0"	4-#5 @ 14" L. 5-#5 @ 15" T.

WALL REINFORCEMENT SCHEDULE		
SIZE	HORIZONTAL	VERTICAL
8" WALL	#4 @ 12"	#4 @ 18"
10" WALL	#5 @ 15"	#4 @ 16"
18" WALL	#5 @ 12"	#4 @ 12"

NOTE:
366 A. BOLTS TOTAL
REQ'D AS FOLLOWS:
84 COLS - 2 A.B. EA.
50 COLS - 4 A.B. EA.
ALL ANCHOR BOLTS & ANCHOR BOST LAYOUT SUPPLIED BY G.Y.T.

TOP OF FTG EL. 79'-11" (UNLESS NOTED)

FOR FTG DETAILS SEE FTG SCHEDULE THIS DRAWING

#5 @ 1'-0" DOWELS 3'-0" FROM ALIGN. EXTER. WALL LINE

4-#5 @ 1'-0" DOWELS 3'-0" FROM EA. FACE OF NT. FTG. AND INSIDE FACE OF EXT. FTG.

GENERAL EXCAVATION TO EL. 80'-0"

EXTERIOR INTERIOR

3'-0" N.T.S.

TYPICAL FOOTING DETAILS

NO SCALE

#4 @ 18" DOWELS (TYP.)

#5 @ 12" E.W. TOP & BOT.

TOP OF FTG EL. 79'-11"

5'-SOUTH 7'-EAST & WEST EDGES.

REMOVE EXIST. 4' WIDTH OF FTG. FOR UNDERPG. LENGTH

⅛ BASE @ EL. 81'-0"

T.O. FTG. EL. 80'-11"

⅛ EXIST FTG EL. 80'-0"

GROUT

⅛ UNDERPG EL. 77'-8"

1'-11" 8'-8"

1 S100 ½" = 1'-0"

CONTINUOUS UNDERPINNING IN SHORT LENGTHS - SEE SPECIFICATIONS.

1'-0" 2'-6" 4'-7" CONT.


¼" FIBREBOARD

2 S100 ½" = 1'-0"

5 S100 6 S100

7 BAYS @ 5'-0" = 35'-0"

TYPICAL DETAIL FOR FOOTINGS ON LINE 5

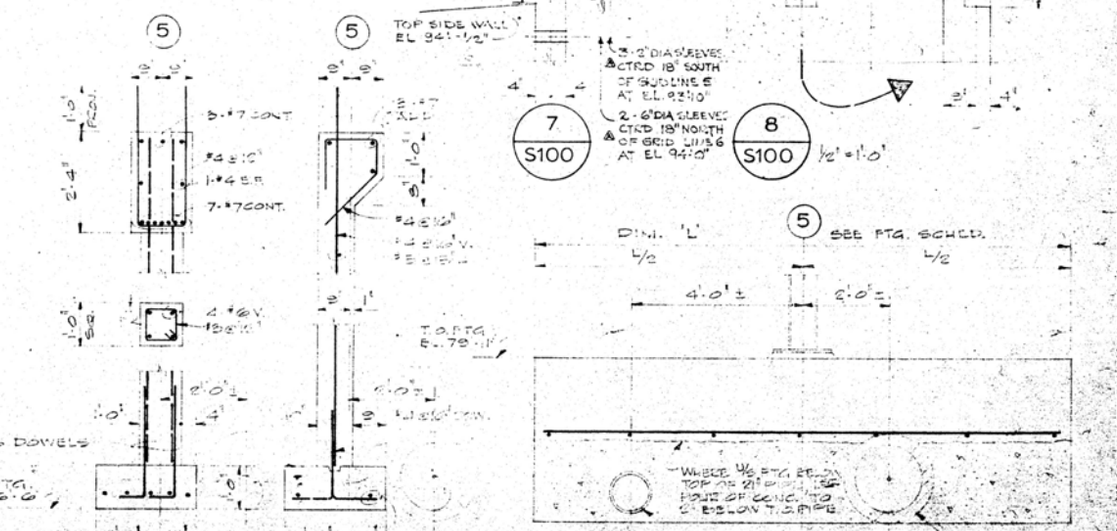

BUSH & BOHLMAN LTD.
consulting engineers
1321 MELVILLE ST. VANCOUVER B.C. TELEPHONE 688-8881

PROFESSIONAL ENGINEER — L.C. BOHLMAN — BRITISH COLUMBIA

REVISIONS		
NO.	DATE	DESCRIPTION
A	11/3/71	ENTRY RAMP ELEVATIONS AS NOTED. DETAILS 1, 2, 4 & 7
B	11/12/71	ADDENDUM FOOTINGS ON GRID LINES D & E. ADDENDA Nº 3
⚠	2/28/72	CHANGE EL. TOP OF FTGS IN ⅛ 100, ⅛ 110, ⅛ 100, ⅛ 100, ⅛ 110 ON GRIDLINES 5 & 7
D	7/10/06	Revised to "As Builts"

PROJECT 8888

GOVERNMENT OF THE YUKON TERRITORY

CANADA

ALUMINIUM CAP SURVEY MONUMENT
L 361/L 601
G 804 (1972)

72°-16'-25"

N

30'-0" 30'-0" 30'-0" 30'-0" 30'-0" 30'-0" 30'-0" 30'-0" 30'-0"

B.M. 'T' CONCRETE NAIL
EL=2273.32
(From Datum Plane of Grid)
of Fire Hall
ORIGINAL DESTROYED 6/24/77

64°-55'-40"

149.99'

THIS FTG ONLY
2'-0" EXTRA CONCRETE
EACH SIDE BASE FTG
AS PER 9/S100

174°-35'-10"

28'-08'-45"

8'-2.3"

IRON PIN SURVEY MARKER

REF B.S. HUB
LINE B'
(Nail in top of 4"x4"
cemented into Ground)

ALUMINIUM CAP SURVEY MONUMENT
RR/L 601
G 804 (1972)

Survey Tie Traverse

B.M. 'T' CONCRETE NAIL
EL=2279.95'

(3'-0"x3'-0"x3'-0" STEP
REQUIRED DOWELED TO TOP
OF FOOTINGS
EL. TO PED. 79'-11")

EL 77'-0"
EL 77'-10"
EL 77'-0"
EL 78'-2"

9/S100
THICK FTGS
2'-0" EXTRA CONCRETE
EACH SIDE BASE FTG
AS PER 9/S100

EL 76'-10"

(10"x12"x10'-0"
DOWEL TO EQUIP
CONNECTED TO FTG)

Survey Tie Traverse

Survey Tie Traverse

10/S100

EXIST BLDG LIMITS
SHOWN CHAIN-DOTTED

POURED
UNDER BUILDING
SHOWN HATCHED

12" WALL BETWEEN
12" COLUMNS

STRIP FTGS.
CHANGED AS
SHOWN 3/S100

2'-0" EXTRA
CONCRETE FINISHED
AT SIDE OF 21"
PIPE

B.M. TOP
CENTER BRASS
STUNG PIPE
EL=2248.95'

EXIST 10" PIPE
(APP. LOCATION)

EXIST 21" PIPE
(APP. LOCATION)

PHASE ONE CONCRETE SUBSTRUCTURE
AS BUILT DRAWING & SURVEY PLAN
SCALE 1/16" = 1'-0"

REF B.S. LINE "2"
(Proj. Line on 2'-0"
Offset to B.S. Line)

FOOTING SCHEDULE	
TYPE	SIZE
'A'	10'-6"x10'-6"x 2'-3"
'B'	9'-6"x 9'-6"x 2'-0"
'C'	8'-6"x 8'-0"x 1'-9"
'D'	7'-6" x 7'-0" x 1'-6"
'E'	6'-0"x 6'-0" x 1'-3"
'F'	4'-0"x 4'-0"x 1'-0"
'G'	2'-0"x 2'-0"x 1'-0"
'H'	5'-0"x 5'-0"x 1'-2"
'J'	L=18'-6"x10'-6"x 2'-0"
'K'	L=16'-9"x 9'-6"x 2'-3"
'L'	L=10'-6"x7'-6"x 1'-6"
'M'	L=9'-0"x 8'-0"x 1'-3"
'N'	L=11'-0"x7'-5"x 2'-0"
'P'	L=14'-6"x 8'-0"x 2'-3"
'Q'	L=5'-6"x 4'-0"x1'-2"

10/S100 1/2"=1'-0"

EL 87'-8"
2'-0"
CONCRETE COLUMN POURED 2'-0" WIDE FOR FULL HEIGHT
2'-0"
2'-0" 2'-0"

12" WALL WEST SIDE COLS. COLUMN REBAR CAST IN WALL

11/S100

11/S100

TOP BEAM EL 91'-5"

9'-6" 9'-6" 4'-6"

TOP BEAM EL 92'-5"

3

4

TOP OF WALL EL. 94'-1"

SLIP DOWELS

6" TYP. JT.

1/8" B. WALL EL 79'-11"

TOP OF FTGS EL. 79'-11"

TOP OF BM EL. 88'-11"

TOP OF FTGS EL. 79'-11"

WALL STRIP FTG CHANGED AS SHOWN
BASE FTGS POURED TO B. OF PIPE & 2'0" M. OF PIPE

3/S100 1/8"=1'-0"

WALL & EXPAN. BOTH SIDES POURED 3/8" LOW FOR FULL LENGTH

TOP OF BEAM EL. 94'-2.96"

TOP OF BM EL. 88'-11"

TOP OF FTGS EL. 79'-11"

1/2" EXP JT.

1/2"x12" CONC. COLS (TYP.) DETAILS AS SECTION 11/S100

1/8" EXP JT.

4/S100 1/8"=1'-0"

5 SEE FTG. SCHED.

4'-0" 2'-0" 4'-0"

10" ø PIPE EXIST.

21" ø PIPE EXIST.

9/S100 1/2"=1'-0"


TYPICAL DETAIL FOR FOOTINGS ON LINE 5

KLONDIKE ENTERPRISES LTD. WHITEHORSE, Y.T.	DRAWING TITLE: PHASE ONE CONCRETE SUBSTRUCTURS AS BUILT DRAWING & SURVEY PLAN	DRAWING NO. S100
DATE - JULY 17, 1978 SCALE - AS NOTED DRAWN BY - P.W.P. APPROVED - P.W.Pond	PROJECT TITLE: TERRITORIAL ADMINISTRATION BUILDING WHITEHORSE, Y.T.	

cut here
couper ici


international A2 420 x 594 mm

inches 0 1 2 3 4 5 6 7 8 pouces

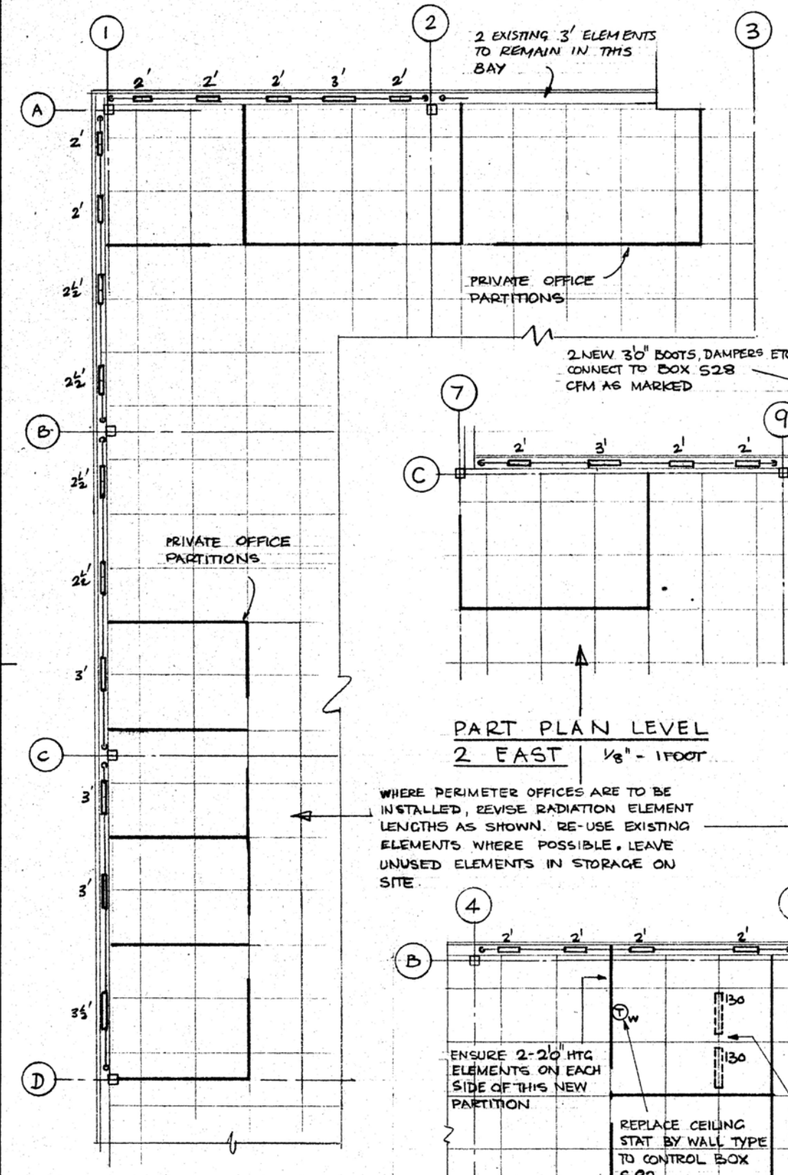



PART PLAN LEVEL
2 EAST 1/8" = 1FOOT

PART PLAN LEVEL
2 EAST 1/8" = 1FOOT

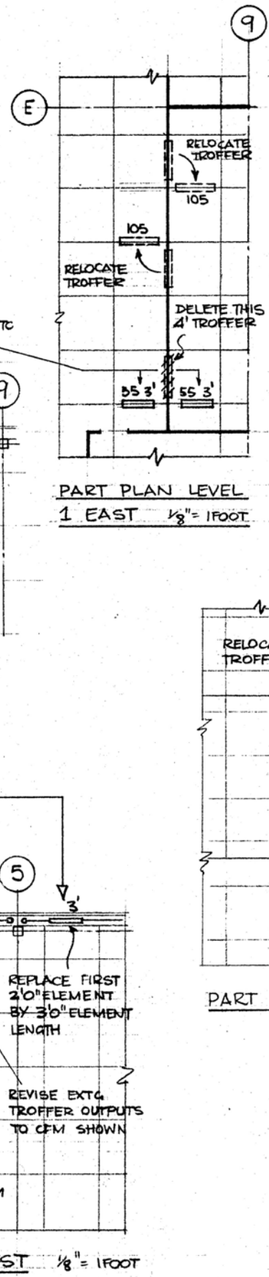


PART PLAN LEVEL
1 EAST 1/8"= 1FOOT

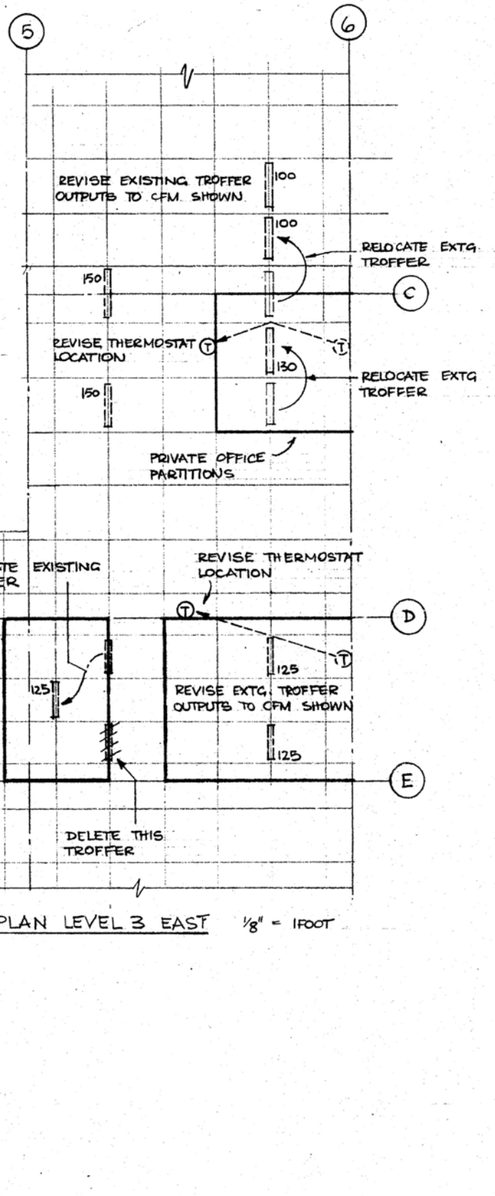

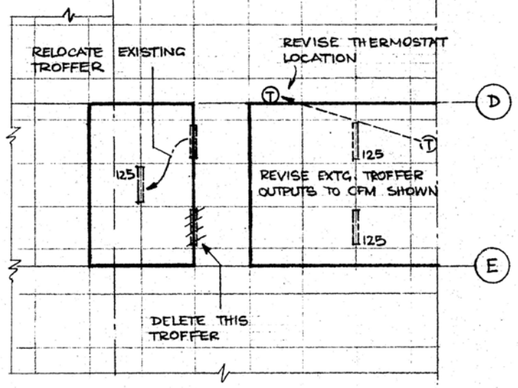

PART PLAN LEVEL 3 EAST 1/8" = 1FOOT

WHERE PERIMETER OFFICES ARE TO BE INSTALLED, REVISE RADIATION ELEMENT LENGTHS AS SHOWN. RE-USE EXISTING ELEMENTS WHERE POSSIBLE. LEAVE UNUSED ELEMENTS IN STORAGE ON SITE.

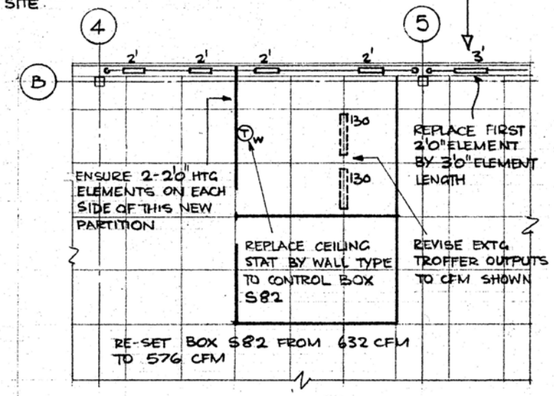

PART PLAN LEVEL 2 EAST 1/8"= 1FOOT

DPW A2

centimetres 0 2 4 6 8 10 12 14 16 18 20 centimètres

Public Works Canada / Travaux publics Canada

office
bureau

consultant
expert-conseil

seal
sceau

designed by
conçu par

drawn by
dessiné par

approved by
approuvé par

date

scale
échelle 1/8" = 1FOOT

A detail no. no. du détail
B sheet no. – where detail required no. de la feuille – où détail exigé
C sheet no. – where detailed no. de la feuille – où détaillé

revisions
révisions

HEATING, AIR CONDITIONING REVISIONS TO CO-ORDINATE SYSTEMS WITH FINISHING CONTRACT PARTITION LAYOUT

project
projet

TERRITORIAL ADMINISTRATION BUILDING. WHITEHORSE Y.T

drawing
dessin

LEVELS 1, 2 & 3 EAST

project No. du projet	sheet No. de la feuille
89857	M5/M7/M9 – R1

cut here
couper ici

international A2 420 x 594 mm

inches 0 1 2 3 4 5 6 7 8 pouces

C

4 5 6 7 8 9

B

C

TYPICAL

5' 160 S9

LENGTH OF DIFFUSER = 5'
SUPPLIES 160 CFM
CONNECTED TO VARIABLE VOLUME BOX S9

TYPICAL

W T S14 S16

THERMOSTAT CONTROLS VARIABLE VOLUME BOXES S14 & S16
WALL MOUNTED

DELETE T16 DOOR GRILLES

3/4"ϕ RETURN TO HIGH LEVEL MAIN

DELETE R20 AND SUBSTITUTE R2 FULL LENGTH OF WALL

REVISE SPRINKLER HEAD LOCATIONS TO SUIT NEW PARTITION LAYOUT

1"ϕ SUPPLY DROP (3/4"ϕ TO EACH RUN OF RADIATION)

THE AIR OUTLETS NOT SHOWN ARE TO REMAIN AS THE ORIGINAL M-5 DRAWING.

RELOCATED R32 (SEE DRAWING M10)

RELOCATED R17

1/2" SUPPLY & RETURN TO RADIATORS IN WALL THICKNESS

NEW RADIATION IDENTICAL TO R17

NOTES

1. HIGH VELOCITY DUCTWORK, RETANGULAR LOW VELOCITY DUCTWORK AND VARIABLE VOLUME BOXES TO REMAIN (IF POSSIBLE) IN THEIR PRESENTLY INSTALLED POSITIONS.
2. RESET THE VARIABLE VOLUME BOXES TO THE FOLLOWING CFM SCHEDULE:-

NO.	OLD MAX. VOLUME	NEW MAX. VOLUME
S9	242 CFM	342 CFM
S10	473 "	425 CFM
S11	636 "	650 "
S12	484 "	300 "
S13	720 "	805 "

MINIMUM CFM TO BE SET TO 25% OF MAX. VOLUME.

NO.	OLD MAX. VOLUME	NEW MAX. VOLUME
S14	240 CFM	252 CFM
S15	443 "	483 "
S16	360 "	378 "
S17	555 "	544 "
S18	500 "	473 "
S26	640 "	690 "
S31	334 "	300 "

centimetres 0 2 4 6 8 10 12 14 16 18 20 centimetres

DPW A2

Public Works Canada / Travaux publics Canada

office
bureau

consultant
expert-conseil

seal
sceau

designed by conçu par	L. FARRANT	
drawn by dessiné par	B SANDHU	JUNE 1975
approved by approuvé par		date

scale
échelle 1/8" = 1'- 0"

A detail no. no. du détail
B sheet no. – where detail required no. de la feuille – où détail exigé
C sheet no. – where detailed no. de la feuille – où détaillé

revisions
révisions

REVISIONS TO LAYOUT DUE TO PARTITION CHANGES


project
projet

TERRITORIAL ADMINISTRATION BUILDING
WHITEHORSE, Y. T.

drawing
dessin

LEVEL 1 - EAST HEATING

project No. du projet	sheet No. de la feuille
89857	M-5 R1

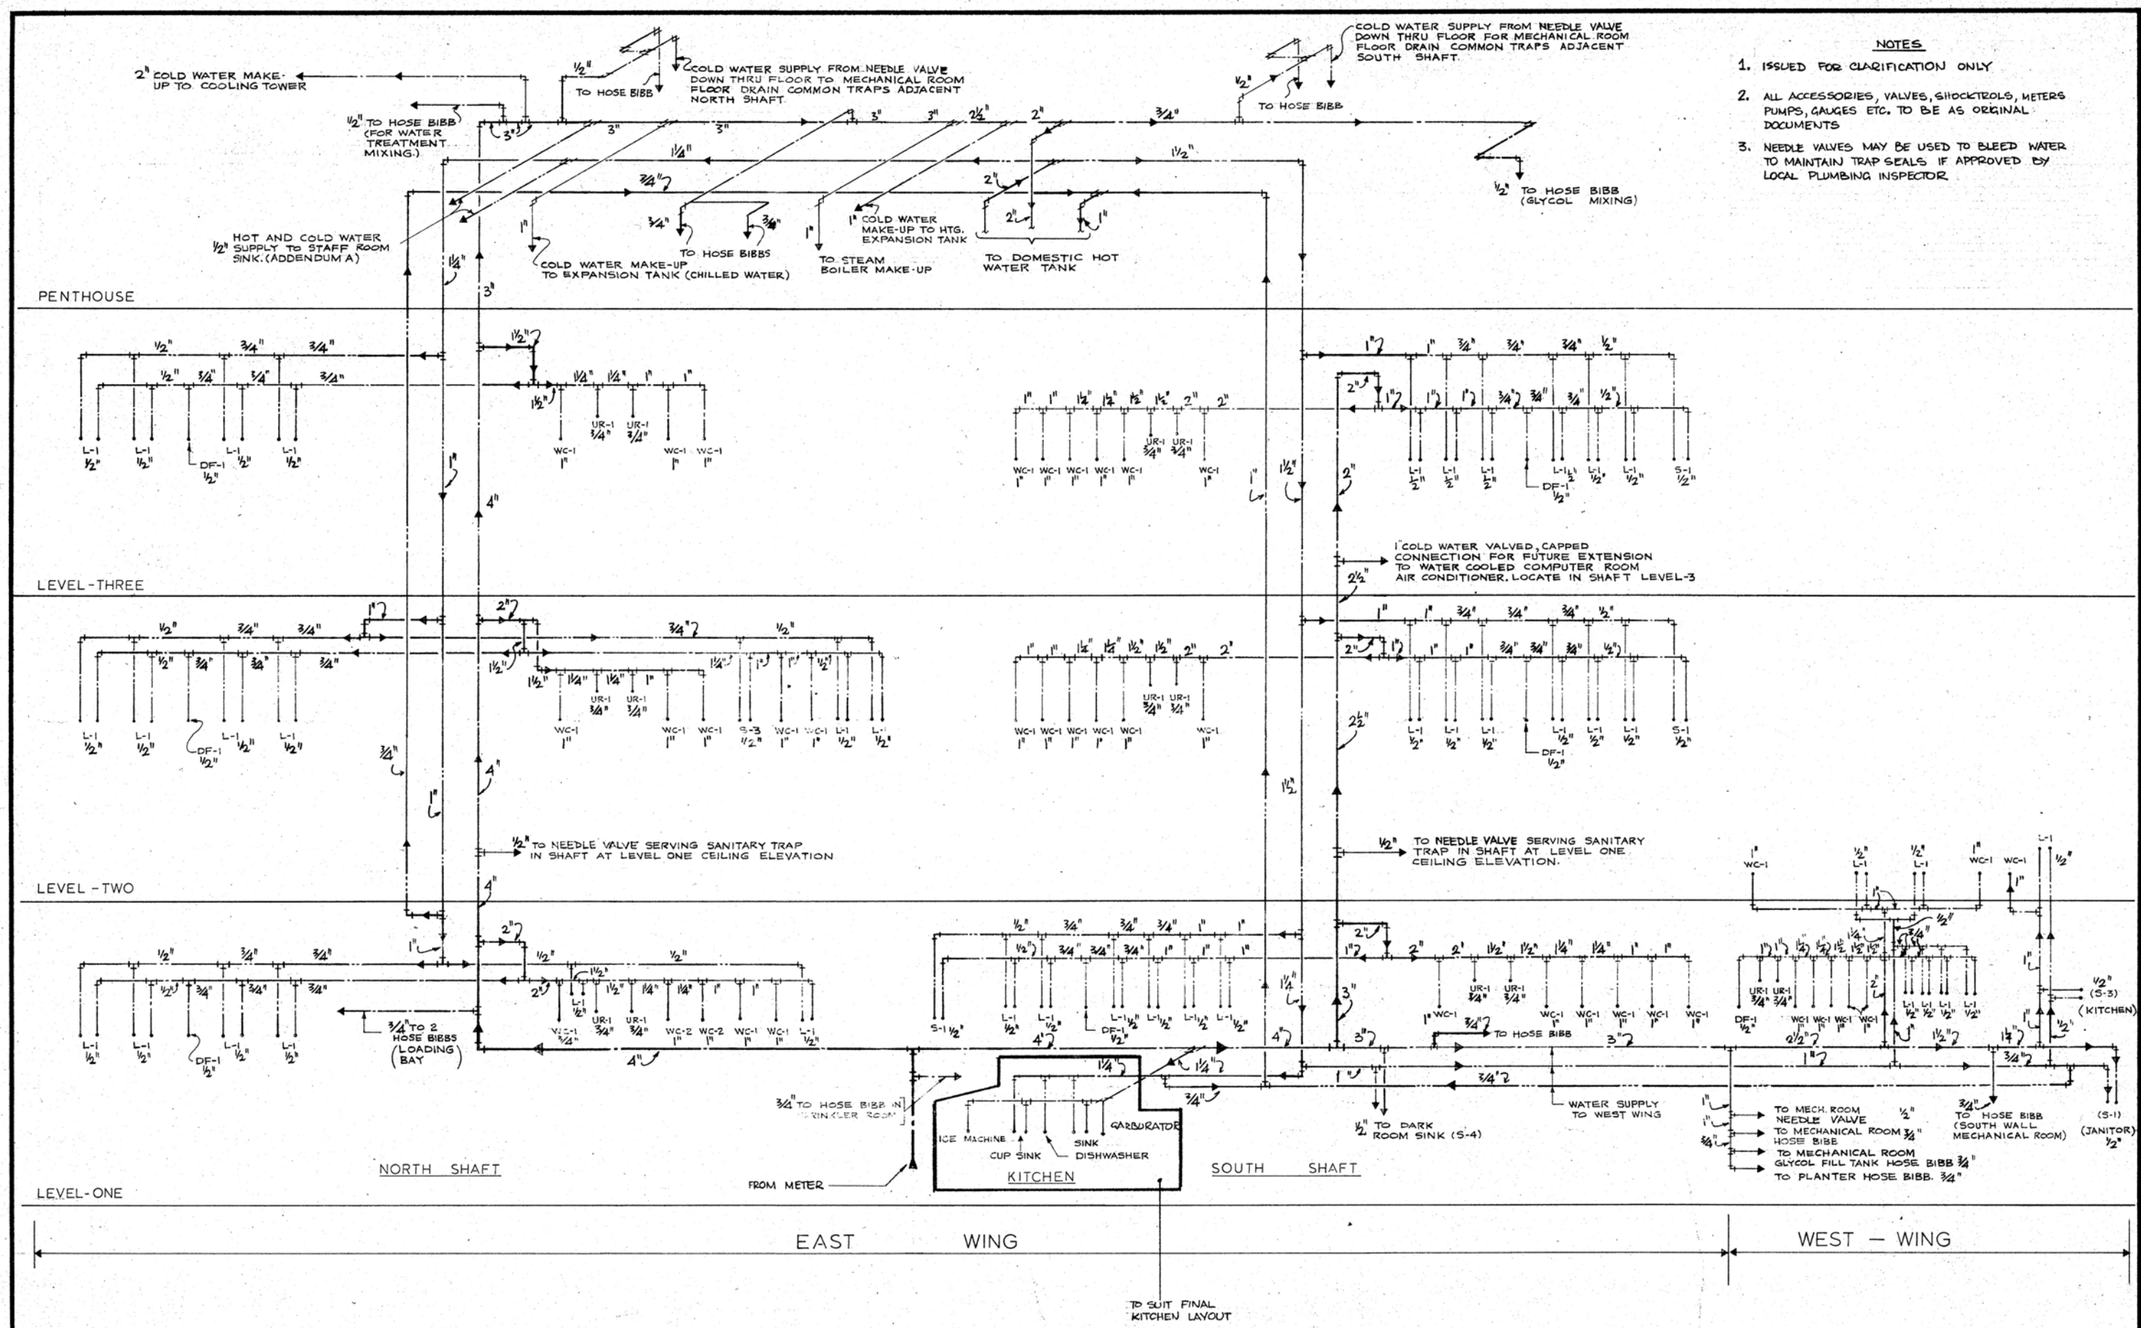

HOT & COLD WATER SCHEMATIC

NOTES

1. ISSUED FOR CLARIFICATION ONLY
2. ALL ACCESSORIES, VALVES, SHOCKTROLS, METERS PUMPS, GAUGES ETC. TO BE AS ORIGINAL DOCUMENTS
3. NEEDLE VALVES MAY BE USED TO BLEED WATER TO MAINTAIN TRAP SEALS IF APPROVED BY LOCAL PLUMBING INSPECTOR

GOVERNMENT OF THE YUKON TERRITORY

[redacted]

A detail no. / détail no.
B location drawing no. / sur dessin no.
C drawing no. / dessin no.
revisions / date

project title / titre du projet
TERRITORIAL ADMINISTRATION BUILDING
WHITEHORSE Y.T


drawing title / titre du dessin
HOT & COLD WATER SUPPLY PIPING CLARIFICATION

designed by / conçu par
date 21 NOV 74
drawn by / dessiné par
date 21 NOV 74
reviewed by / examiné par
date
approved by / approuvé par
date
Tender / Soumission
Project Manager / Administrateur de projets M.T.P.
project number / no. du projet
89857
drawing no. / dessin no.
PLUMBING - CL-1


DPW 700D

FOR APPROVAL

APPROVED BY _____ DATE _____
SIGNATURE

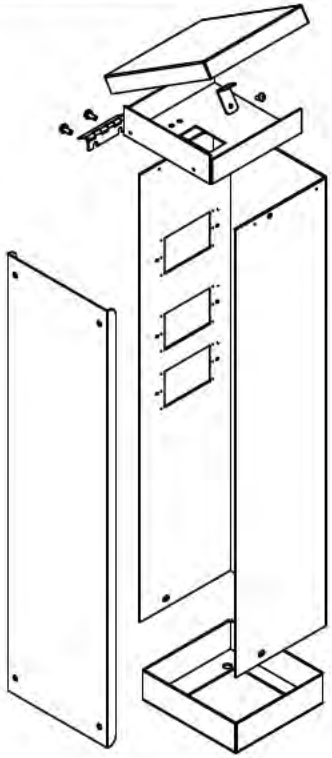

ISOMETRIC VIEW

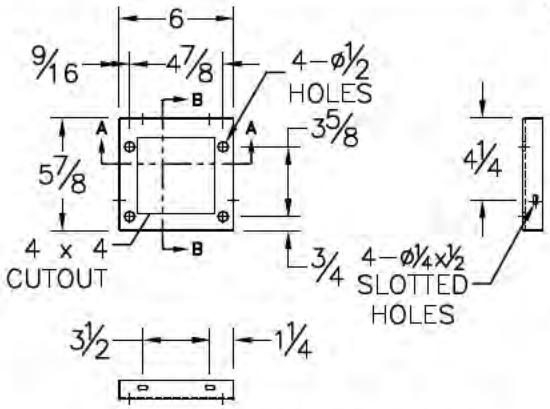


NOTE: BASEPLATE IS 10GA. THK WIPE COAT STEEL


BASEPLATE DETAIL

NOTES:


1) 14 GA. GALVANNEALED STEEL CONSTRUCTION UNLESS NOTED.
2) A1101 (ASA–61) GREY POWDER COAT FINISH
3) 1x 15A M210TN–15 RECEPTACLE
4) LEVITON IUM1H–GY WHILE IN USE COVER
5) 2x 15A SINGLE POLE BREAKERS
6) 2x 15A DEAD FRONT GFCI'S (WIRED TO IPLC)
6) 3x CUSTOM TERMINAL BLOCKS C/W 1x #14–#2 LUG & 2x #14–1/0 LUGS
7) HIDDEN BASEPLATE C/W TEMPLATE & ANCHOR BOLTS

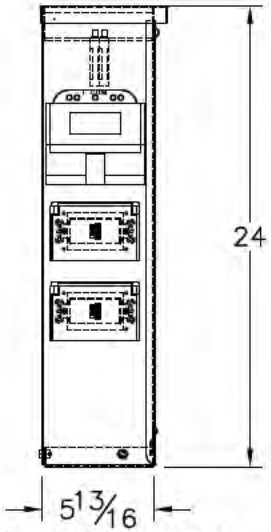


LT SIDE VIEW

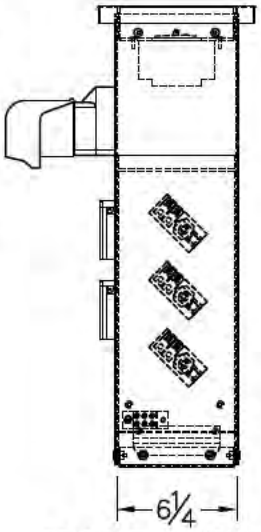

FRONT VIEW

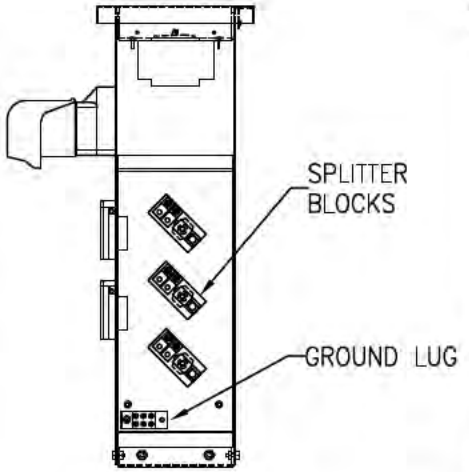

FRONT VIEW (COVER REMOVED)

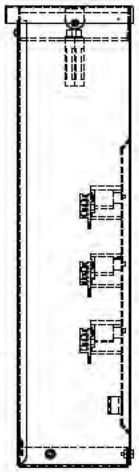

RT SIDE VIEW

DESIGN:			DRWN.: LS	CHK'D.:	07-15-22
REV	BY	APD	REVISION		DATE

THIS DRAWING CONTAINS INFORMATION WHICH IS PROPRIETARY TO ACE MANUFACTURING METALS LTD. NO REPRODUCTION OR PUBLICATION OF THIS DOCUMENT IN WHOLE OR IN PART SHALL BE MADE WITHOUT WRITTEN AUTHORIZATION FROM ACE

ACE MANUFACTURING METALS LTD.
BOX 500 BITTERN LAKE, AB, CANADA T0C 0L0

CUSTOMER: EECOL (ED N.)
QUOTE No.: P22L649A
PROJECT: MAIN ADMIN BUILDING

DESCRIPTION:
SELMB-AP2GS-WIC,IPLC
CUSTOM SELECT SERIES POWER PEDESTAL

DWG. No.: **M10029-0722** REV. A1
CAD FILE: SELMB
SCALE: N.T.S. SHEET: 1 OF 1


UNLESS OTHERWISE SPECIFIED DIMENSIONS & TOLERANCES ARE N INCHES

DECIMAL	FRACTIONAL	ANGULAR
X ± 0.06	±	± 1/2°
XX ± 0.01		
XXX ± 0.0100		


0011

FOR APPROVAL

APPROVED BY _____ DATE _____
SIGNATURE

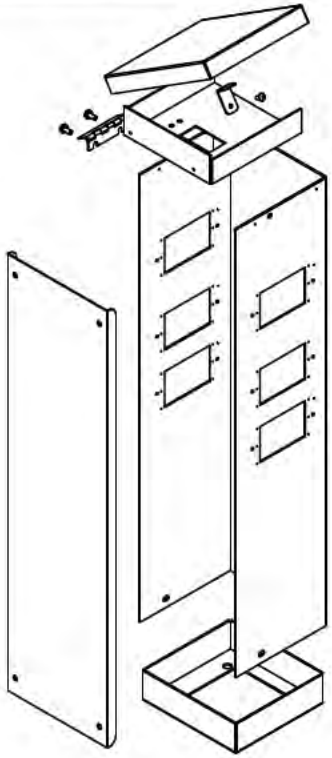

ISOMETRIC VIEW

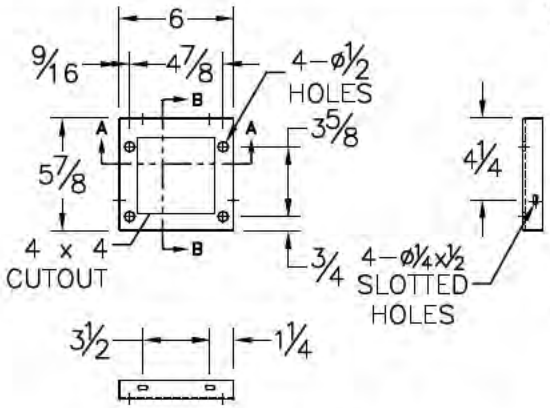


NOTE: BASEPLATE IS 10GA. THK WIPE COAT STEEL


BASEPLATE DETAIL

NOTES:


1) 14 GA. GALVANNEALED STEEL CONSTRUCTION UNLESS NOTED.
2) A1101 (ASA–61) GREY POWDER COAT FINISH
3) 2x 15A M210TN–15 RECEPTACLE
4) LEVITON IUM1H–GY WHILE IN USE COVERS
5) 4x 15A SINGLE POLE BREAKERS
6) 4x 15A DEAD FRONT GFCI'S (WIRED TO IPLC)
6) 3x CUSTOM TERMINAL BLOCKS C/W 2x #14–#2 LUG & 2x #14–1/0 LUGS
7) HIDDEN BASEPLATE C/W TEMPLATE & ANCHOR BOLTS

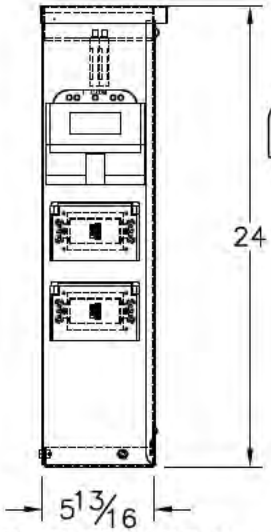

LT SIDE VIEW

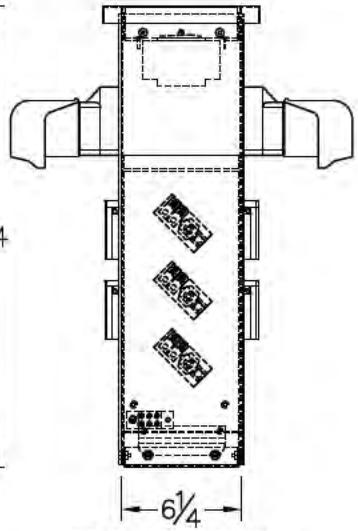

FRONT VIEW

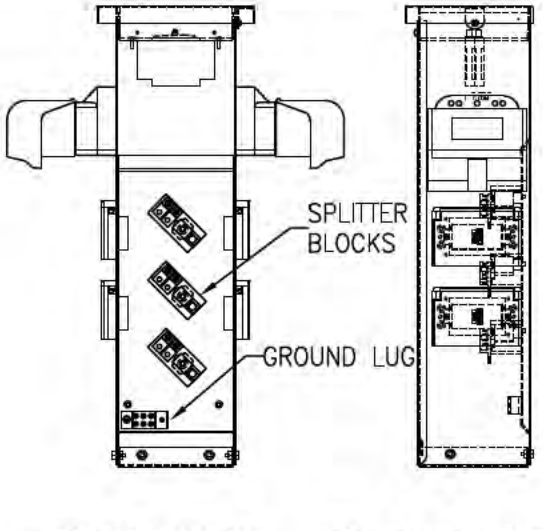

FRONT VIEW (COVER REMOVED)

RT SIDE VIEW

DESIGN:			DRWN.: LS	CHK'D.:	07-15-22
REV	BY	APD	REVISION		DATE

THIS DRAWING CONTAINS INFORMATION WHICH IS PROPRIETARY TO ACE MANUFACTURING METALS LTD. NO REPRODUCTION OR PUBLICATION OF THIS DOCUMENT IN WHOLE OR IN PART SHALL BE MADE WITHOUT WRITTEN AUTHORIZATION FROM ACE

ACE MANUFACTURING METALS LTD.
BOX 500 BITTERN LAKE, AB, CANADA T0C 0L0

CUSTOMER: EECOL (ED N.)
QUOTE No.: P22L649A
PROJECT: MAIN ADMIN BUILDING


DESCRIPTION:
SELMB-AP1GS-WIC,IPLC
CUSTOM SELECT SERIES POWER PEDESTAL

DWG. No.: **M10028-0722** REV. A1
CAD FILE: SELMB
SCALE: N.T.S. SHEET: 1 OF 1


UNLESS OTHERWISE SPECIFIED DIMENSIONS & TOLERANCES ARE N INCHES

DECIMAL	FRACTIONAL	ANGULAR
X ± 0.06	±	± 1/2°
XX ± 0.01		
XXX ± 0.0100		


0012

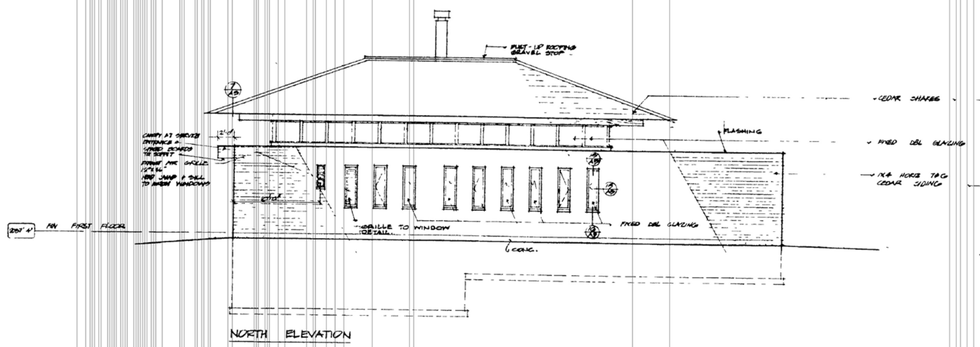


NORTH ELEVATION

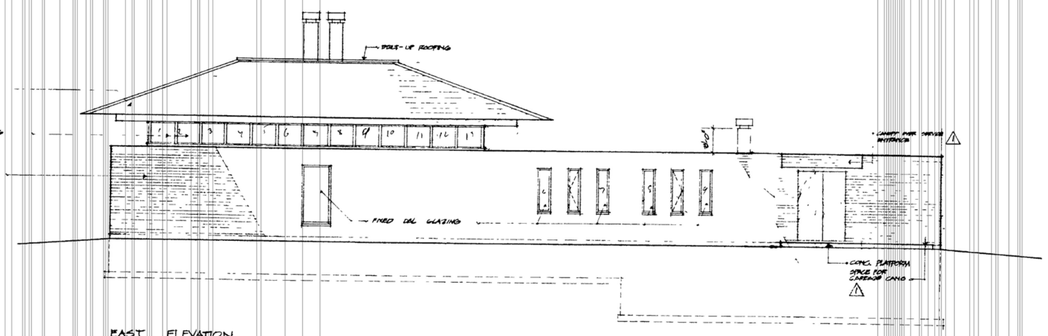


EAST ELEVATION

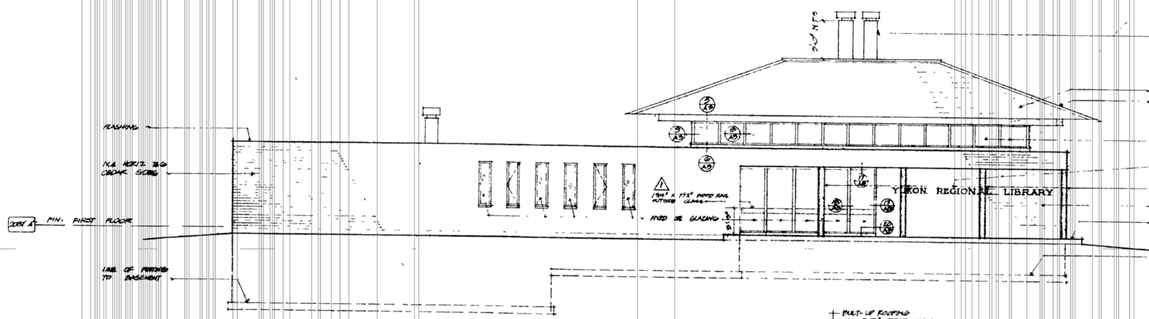

SOUTH ELEVATION

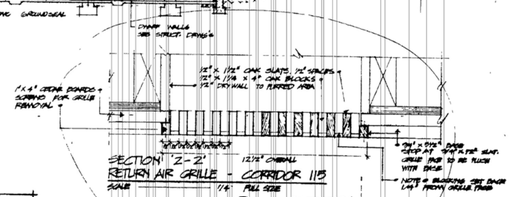


SECTION '2-2'
RETURN AIR GRILLE - CORRIDOR 113
SCALE — 1/4" FULL SIZE

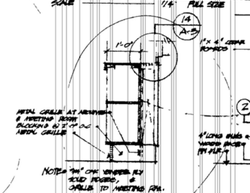


SECTION '1-1'

(D A1) ELEVATION - RETURN AIR GRILLE
SCALE — 1/4" = 1'-0"

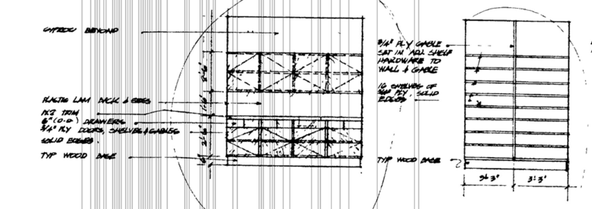


(A A1) WORKROOM
STAFF ROOM SAME EXCEPT CUT HAND

(B A1) STATIONERY

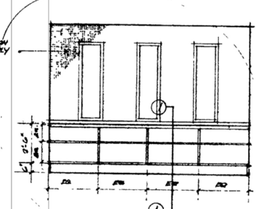


(C A1) LIBRARIAN'S ROOM


INTERIOR ELEVATIONS

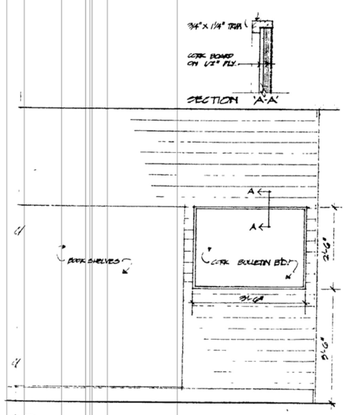


(E A1) ELEVATION - BULLETIN BD AT ENTRANCE
SCALE — 1/2" = 1'-0"

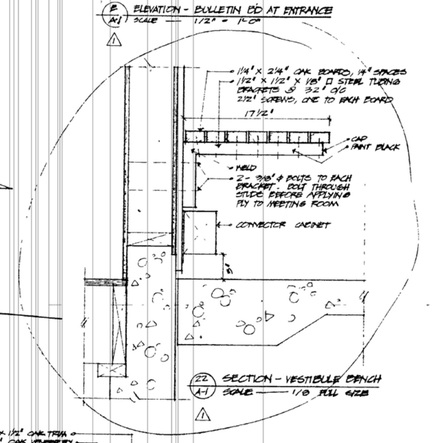



(22 A1) SECTION - VESTIBULE BENCH
SCALE — 1/8" FULL SIZE

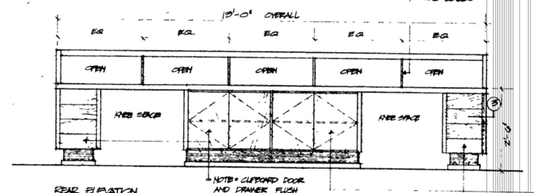

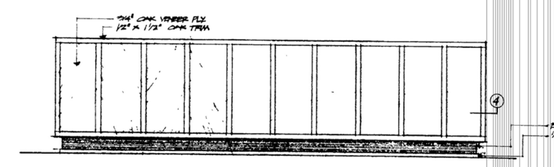

(4 A2) CHARGE DESK DETAILS
SCALE — 1/2" = 1'-0"

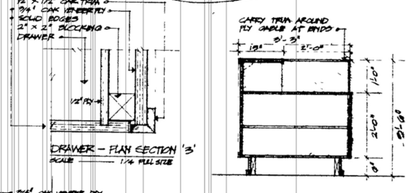

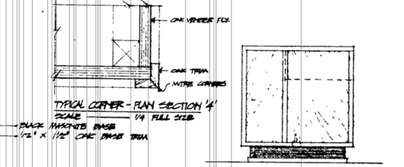

NO	DATE	REVISIONS
1	JUNE/64	DOOR OPENS, BULLETIN BD., CANOPY AT SERVICE ENT., SLIDING DOOR, LIBRARY SIGN.


ELEVATIONS & SECTIONS, INTERIOR DETAILS

YUKON REGIONAL LIBRARY FOR THE GOVERNMENT OF THE YUKON TERRITORY. WHITEHORSE, Y.T.

McCARTER, NAIRNE & PARTNERS
ARCHITECTS AND CONSULTING ENGINEERS
MARINE BUILDING VANCOUVER 1, B.C.

DRAWN: PAUL HOSKER
CHECKED
DATE: JUNE 1 1964
JOB No. 1804
SHEET No. A-2

Association of Professional Engineers of the Province of Yukon
J. R. SWERDFEGER
CIVIL ENGINEER

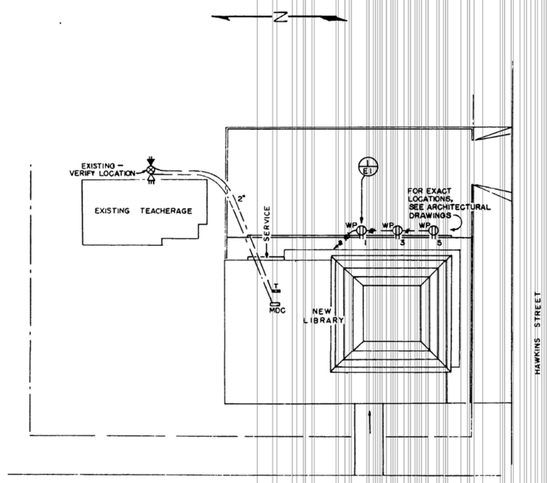

SITE PLAN
SCALE 1" = 30'

EQUIPMENT SCHEDULE

	DESCRIPTION	VA OR H.P.	VOLTS	PH	NO	MOTOR STARTER SIZE	MOTOR STARTER MCC	DISCONNECT SIZE	DISCONNECT MCC	CONTROL MCC	CONTROL TYPE	SEC. VOLTS	SEC. MCC	SEC. NO.	SEC. TYPE	REMARKS
H1	Coil heater	1/3	115	1	2											
P1	Fan No. 1	1/6	"	1	2						MAN.					
P2	" " 2	1/6	"	1	2						"					
P3	" " 3	1/6	"	1	2						"					
P4	" " 4	1/10	"	1	2						"					
U1	Unit heater No. 1	1/30	"	1	2						"					
U	" " 2	1/30	"	1	2						"					
Z1	Exhaust fan No. 1	1/4	"	1	2						"					2
M1	Modulating Valves	5.0 VA	"	1	2											C
H1	Roof Drain Heaters	420 W	"	1	2											D

ITEMS CHECKED (✓) ARE TO BE INCLUDED IN ELECTRICAL CONTRACT

NOTES
1 built-in motor protection.
2 Pilot Light required on starter.

CONTROL TYPES
A Standard rail burner control package. Prewired.
B Line volts thermostat. For exact location see Mechanical drawings.
C Modulating thermostat. Connection to transformer required only
D Thermostat - G E HSC-5 To control one G E HCUF-60 Heating Cable Unit installed on each roof drain Note that thermostats, heating cables, and labour to install are included in the electrical contract

ALL BREAKERS SINGLE POLE, 15A UNLESS OTHERWISE INDICATED

PANEL A


BUILDING TYPE MAB — SURFACE MOUNTED — 225 A. MAINS

	DESCRIPTION			DESCRIPTION
110, 111 Fluorescents		1	2	110, 114
" " "		3	4	" CONTROL PANEL
" " "		5	6	" 112
" " "		7	8	" 111
" Davall, Air		9	10	" 110
" " "		11	12	" "
" " "		13	14	" "
" " "		15	16	" "
" " "		17	18	" "
" Low Level		19	20	" "
" " "		21	22	" 107, 108, 107, CONTROL CH.
" 104		23	24	" 106, 109
" "		25	26	" 101, 102, 103
" "		27	28	" 01, 02
SPARE		29	30	" 03, 04
"		31	32	SPACE
"		33	34	"
"		35	36	"

PANEL B

BUILDING TYPE MAB — SURFACE MOUNTED — 225 A. MAINS


	DESCRIPTION			DESCRIPTION
RECEPTACLES, CLES, Block Heaters		1	2	RECEPTACLES 113
" " "		3	4	" 110, 111, 112, 113
" " "		5	6	" 104, 110, 111
SPARE		7	8	" 105, 106, 107, 108, 109
RECEPTACLES 103		9	10	" 111, 112, 104
" " "		11	12	" 02, 03, 04
" " "		13	14	UNIT H1, H1
" " "		15	16	SPARE
SPACE		17	18	SPACE
CKT #1, 11, P4, P3		19	20	"
" #1, #2		21	22	UNIT M1, M1, ELE. TRANSFORMER
		23	24	" U2, Z1

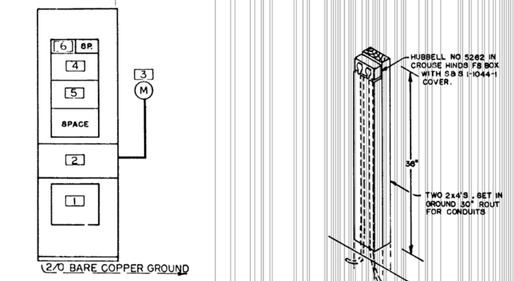

ONE LINE DIAGRAM

MAIN DISTRIBUTION CENTER
SCALE 1/2"=1'-0"

DETAIL (1 / E1)
NOT TO SCALE

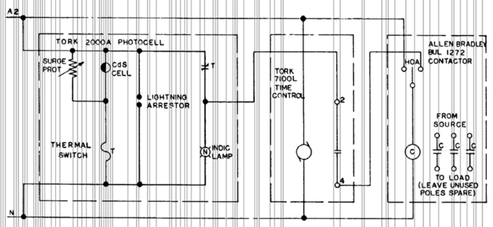


OUTDOOR LIGHTING CONTROL
SCHEMATIC DIAGRAM

LEGEND

MDC	MAIN DISTRIBUTION CENTER
A	PANEL "A"
B	HOME RUN TO PANEL B
	CONDUIT, CONCEALED IN CEILING OR WALL SLASHES INDICATE NUMBER OF WIRES
	CONDUIT, EXPOSED
	CONDUIT, CONCEALED IN FLOOR OR UNDERGROUND
2"	EMPTY CONDUIT, 2" TRADE SIZE
	CONDUIT, UP TO FLOOR ABOVE
	CONDUIT, DOWN TO FLOOR BELOW
	CONDUIT, CHANGES ELEVATION AT POINT INDICATED
	CONDUIT, CAPPED
K	CONDUIT, CONTINUED ON OTHER PLAN OF SAME AREA
	PORTION OF CONDUIT NOT SHOWN ON DRAWING
	LOW VOLTAGE WIRING
	PLUG-IN DUCT RUN
	END CLOSER
H b/7	RECTANGULAR LIGHTING FIXTURE
H b/7	ROUND LIGHTING FIXTURE
	LETTER IN CENTER OF FIXTURE SYMBOL INDICATES TYPE (SEE FIXTURE SCHEDULE) LETTER AT TOP RIGHT IDENTIFIES CONTROLLING SWITCH NUMBER AT LOWER RIGHT IDENTIFIES CIRCUIT WHERE FIXTURES ARE ARRANGED IN ROWS, ONLY ONE FIXTURE IS SHOWN FULLY ALL FIXTURES WITHIN SUCH ROWS ARE IDENTICALLY WIRED
H	FLOOD OR SPOTLIGHT ARROW SHOWS DIRECTION OF AIMING
XI	EXIT LIGHT SEE FIXTURE SCHEDULE
$K	SWITCH, CONTROLLING OUTLETS MARKED "K"
$2	TWO POLE SWITCH
$3	THREE WAY SWITCH
$M	MANUAL MOTOR STARTER
$MP	MANUAL MOTOR STARTER WITH PILOT LIGHT
5	DUPLEX RECEPTACLE ON CIRCUIT 5
+6	DUPLEX RECEPTACLE, MOUNTED 6" ABOVE ADJACENT COUNTER OR SIMILAR SURFACE
36	DUPLEX RECEPTACLE, MOUNTED 36" ABOVE FINISHED FLOOR
5,7	SPLIT RECEPTACLE HALF ON CIR 5, HALF ON CIR 7
WP	WEATHERPROOF DUPLEX RECEPTACLE
	TELEPHONE WEATHERHEAD
T	TELEPHONE CABINET "T"
W	WALL TELEPHONE OUTLET
	TELEPHONE CORD OUTLET
EFI	MOTOR-DRIVEN EQUIPMENT, WITH DISCONNECT WHERE REQUIRED BY CODE "EFI" REFERS TO EQUIPMENT SCHEDULE
HTZ	MOTORLESS EQUIPMENT "HTZ" REFERS TO EQUIPMENT SCHEDULE
PE	PHOTOELECTRIC CELL (ON ROOF)
TC	TIMECLOCK
	CONTACTOR
	POLE
12	ROOM OR AREA NO 12
	PUSHBUTTON
	BELL
	BELL RINGING TRANSFORMER
	BUILT-IN CLOCK
	FIRE ALARM PANEL
	FIRE ALARM BELL
	SMOKE DETECTOR

FIXTURE ILLUSTRATIONS

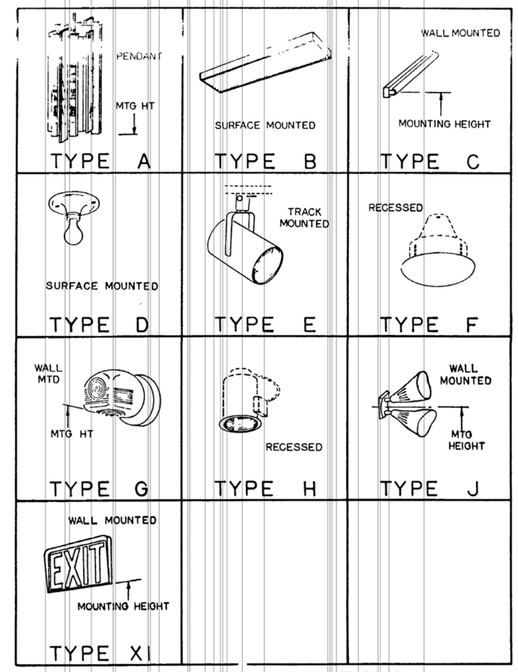

FIXTURE SCHEDULE

TY	MANUFACTURER	CAT NO	FINISH	LAMPS	M H	REMARKS
A	Holde - Snowglobe	G100	Oak	2-100A, 1-200	10'-0"	
				1-200A, 2/PL		
-	Holophane	12306	White	2-F.CWX	--	Recessed mounting, 1/8" holes every 1/6" on sides, two holes in each end.
C	Holophane	K-201-48	White	1-200CW	9'6"	See Arch. drwgs. for valance details
E	G.E.	47 2-7	Porcelain	1-150A/2	----	
A	Lightolier - Lytespot	7521	Satin Alum	1-150 PAR/SP	----	With recessed track
J	Electrolier	P-412	Gold	1-150A/2	----	
W	Type	577	Chrome	1-60A	6'-0	
F	Lightolier	7760	Black	1-150PAR/FL	----	
J	Kyle	S 1020	Alum	1-150PAR/FL	13'-6"	
XI	Kyle	126	Alum	- "	9'-6"	

NOTES

- REFER TO THE SPECIFICATIONS FOR ADDITIONAL INFORMATION
- NUMBERS SHOWN THUS [3] RELATE DEVICES SHOWN ON THE ONE LINE DIAGRAM TO THE SAME DEVICES ON THE ELEVATION OF THE MAIN DISTRIBUTION CENTER
- ALL DEVICES SHOWN ON THE ONE LINE DIAGRAM HAVE THE SAME PHASE AND VOLTAGE RATING AS THE SERVICE CONNECTION, UNLESS NOTED OTHERWISE
- WHEN TYPING PANEL DIRECTORIES, USE ROOM NAMES TAKEN FROM THE ARCHITECTURAL DRAWINGS


ELECTRICAL DIAGRAMS

YUKON REGIONAL LIBRARY FOR THE GOVERNMENT OF THE YUKON TERRITORY
WHITEHORSE, Y.T.


McCARTER, NAIRNE & PARTNERS
ARCHITECTS AND CONSULTING ENGINEERS
400 MARINE BUILDING VANCOUVER 1 B.C.

DRAWN V.G.
CHECKED
DATE JUN 30 65
JOB No 1604
SHEET No E1


PROFESSIONAL ENGINEER TERRITORY OF THE YUKON W.T. HAGGERT
Telephone 604-681-4895

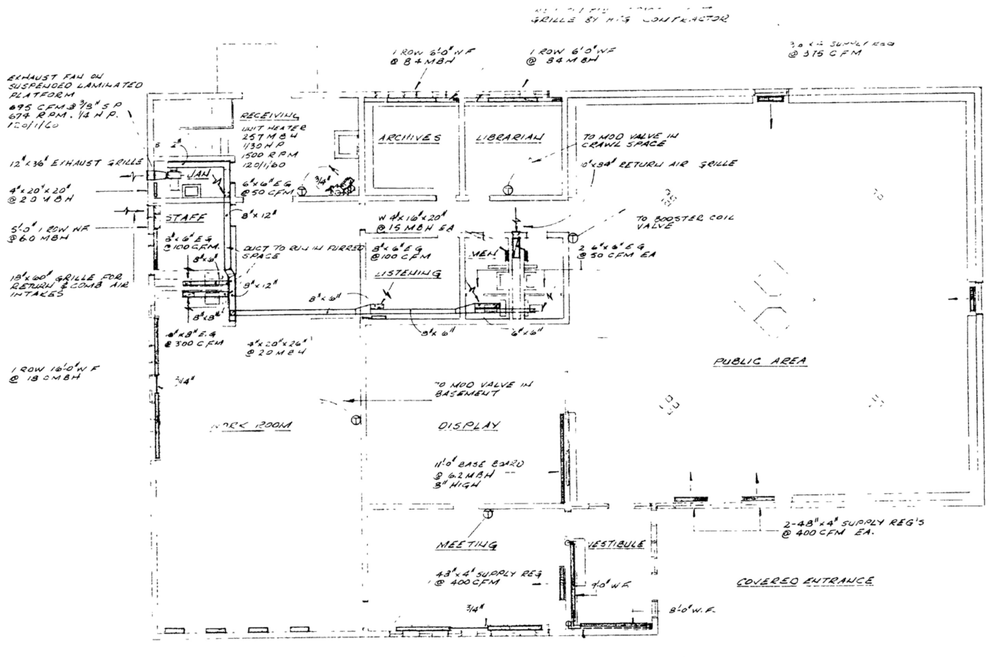


GROUND FLOOR PLAN 1/8" = 1'-0"

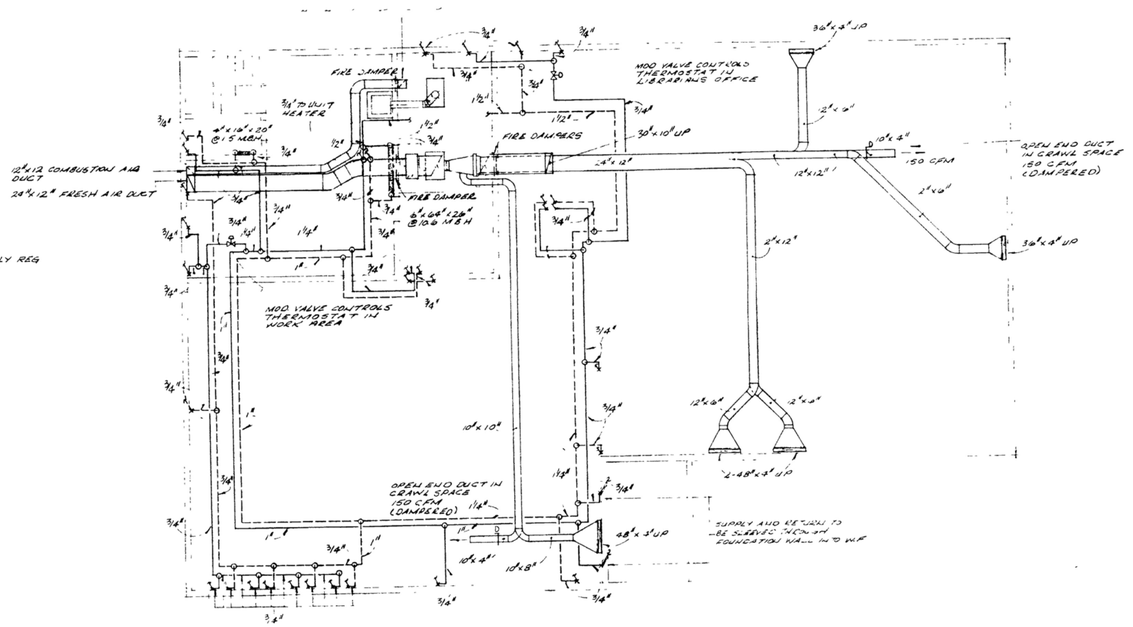

BASEMENT & CRAWL SPACE PLAN 1/8" = 1'-0"

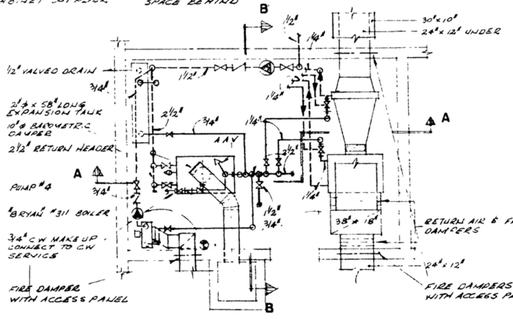


BOILER ROOM PLAN 1/4" = 1'-0"

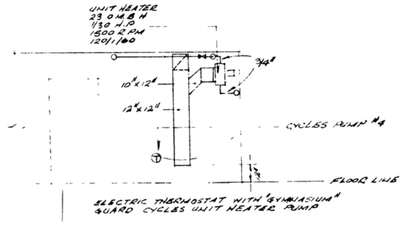


ELEV. SHOWING COMB. AIR HEATING 1/4" = 1'-0"


NOTE
FIRE DAMPERS TO BE UNDERWRITERS LABORATORY APPROVED TYPE, FUSIBLE LINK FIRE DAMPERS FOR 300° F MELTING POINT
ACCESS DOORS TO BE PROVIDED FOR EACH DAMPER

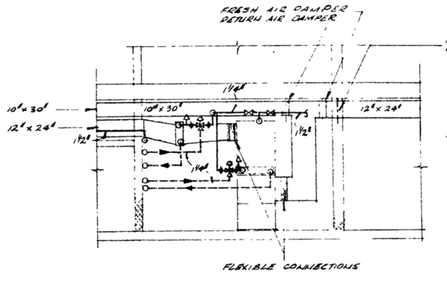

SECTION B-B

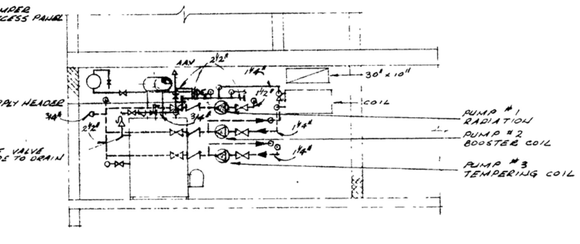

SECTION A-A

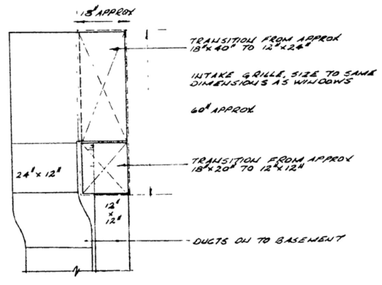

COMB. & R/A GRILLE DETAIL 1/2" = 1'-0"

D. W. THOMSON & COMPANY LTD. CONSULTING ENGINEERS 1690 WEST BROADWAY VANCOUVER 9, B.C.	FLOOR PLANS & SECTIONS YUKON REGIONAL LIBRARY FOR THE GOVERNMENT OF THE YUKON TERRITORY WHITEHORSE Y. T. ARCHITECT McCARTER NAIRNE & PARTNERS	DRAWN D.T.P. CHECKED R.T. DATE MAY 15,'65 JOB NO 1904 SHEET M-1 OF 1

STAIR #2

METAL CLAD SLOPING ROOF

WINDOWS BELOW

CHANGE ORDER 30
SUPPLY AND INSTALL ONE ONLY ADDITIONAL ROOF DRAIN TO PREVENT EXCESSIVE PONDING

STAIR #3

METAL CLAD SLOPING ROOF

TYPICAL ALUM R.D.

MECH LOUVER

DUCT TO ALUM CLADDING BAKED ENAMEL FINISH TO MATCH LOUVRE

1½" RIGID INSUL.

STAIR #1

STAIR #2

STAIR #3

STAIR #4

STAIR #6

ELEVATOR MACHINE RM. #1

ELEVATOR MACHINE RM. #2

CORRIDOR

STAFF RM.

MECHANICAL ROOM

COOLING TOWER

CORRIDOR

CHANGE ORDER 4
SUPPLY AND PLACE 2'X2' CONCRETE SLABS IN COOLING TOWER AREA

CHANGE ORDER 4
SUPPLY AND PLACE 2'X2' CONCRETE SLABS IN FRONT LOUVRE OPENINGS

CHANGE ORDER 4
SUPPLY AND INSTALL FLASHING AROUND COOLING TOWER CURBS COMPLETE WITH CONCRETE SLEEVES

CHANGE ORDER 16
INSTALL EXTRA WINDOW VENTHOLE NORTH WALL

CHANGE ORDER 6
SUPPLY AND INSTALL CONCRETE WALL BETWEEN CORRIDOR DC.4 AND STAIR 6

CHANGE ORDER 26
EXTRA PAINT ON CONCRETE FLOORS MECHANICAL ROOM IN COUNCIL BLOCK AND PENTHOUSE, EQUIPMENT RM STATIONARY AND STORAGE ROOM SEE DWG A5

CHANGE ORDER 6
INSTALL STEEL RACK FOR MAN CONTROL PANEL

CHANGE ORDER 7
SUPPLY AND INSTALL 30" CONCRETE CURBING

CHANGE ORDER 4
DELETE 2'X2' CONCRETE SLABS BETWEEN GRID LINE 7-10 AND E AND F REPLACED BY DOUR IN PLACE CONCRETE

CHANGE ORDER 8
CONCRETE ON ROOF CONCRETE BEAMS AND REBAR, RE DRAWING S.K. 101

CHANGE ORDER 19
SUPPLY FOR ADDITIONAL SIDE WALK CONNECTING STAIR 4 TO PENTHOUSE RAMP

NOTE: LOCATION OF DUCT, LOUVER, FIRE DAMPER, AND DUCT LOCATION SHALL DEPEND ON MECH. EQUIPT SELECTED

FOR INSULATION DETAILS IN PENTHOUSE SEE MECH DWG M.13

LOUVRE OPENING SEE MECH. FOR DETAIL (WIDTH TO BE MULTIPLE OF 5'-0" CLADDING MB)

EXTEND RIGID INSUL. IN WALL

SCREEN TO EXTERIOR GRILLE

LOUVRE OPENING SEE MECH FOR DETAIL

EL. TOP FLOATING SLAB 123'-3"

EL. TOP FLOATING SLAB 123'-4"

EL. TOP OF CURB 123'-0"

EL. TOP SLAB 122'-10"

EL. TOP SLAB 122'-0"

EL. TOP SLAB 122'-0"

EL. TOP S. DECK 108'-8½"

EL. TOP S. DECK 108'-8½"

EL. TOP OF FLAT ROOF 121'-7"

METAL CLAD SLOPING ROOF

FLAT ROOF

SKYLIGHT OVER UPPER PART OF MALL

OPEN BEAM BELOW

SCUPPER

CANT + FLASHING

EXP. JOINT

PAVING TILE (TO CORRIDOR) TYP.

METAL HANDRAIL

RAILING

SKYLIGHT

METAL CLAD SLOPING ROOF

FLAT ROOF

NOTE: REFER TO DWG A-4 FOR LEGEND

PENTHOUSE ROOF PLAN

PENTHOUSE FLOOR PLAN

KEY PLAN

Public Works Canada / Travaux publics Canada
Pacific Region

NO.	DATE	REVISIONS DESCRIPTION
A	SEPT 10 74	REVISION CLOUDED AT GRID LINE 7 TO GRID LINE 8 & F TO G AND 7 TO 10 AND F TO G. SKYLIGHTS DELETED ON STAIRWELL #2, #3 & #4, ROOF DRAINS ADDED IN LIEU. (SEE ARCHITECTURAL & MECHANICAL DRAWINGS)
B	21 OCT 74	DETAILS OF COOLING TOWER WALLS & EXTERIOR SOIL ON GRIDLINE "E" ADDED.
C	MAY 7 75	REVISED TO "AS BUILTS"


PROJECT NO. 20457
DATE APR 1 74
SCALE 1/8" = 1'-0"
DRAWN
CHECK
APPROVED

GOVERNMENT OF THE YUKON TERRITORY


DRAWING TITLE
MECHANICAL PENTHOUSE FLOOR & ROOF PLANS

PROJECT TITLE
TERRITORIAL ADMINISTRATION BUILDING
WHITEHORSE, Y.T.


DRAWING NO.
A10
B

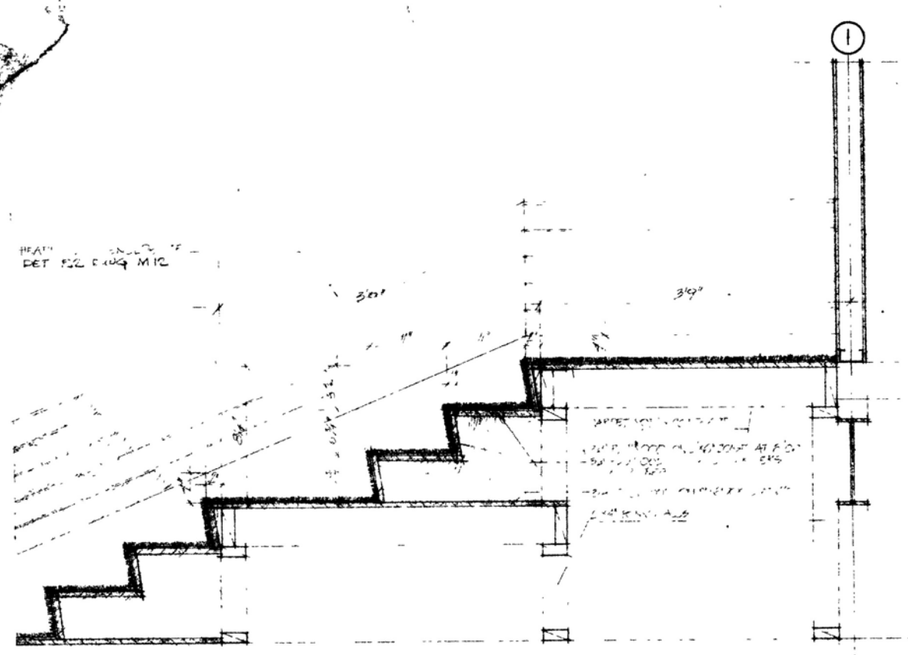

1 / A22 GALLERY STEPS

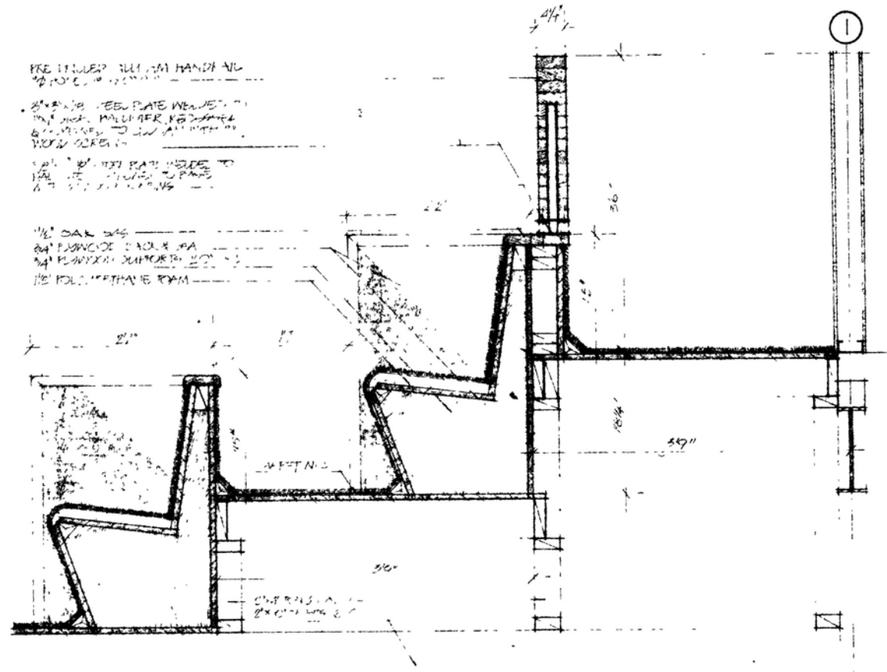


5 / A22 GALLERY SEATS · UPPER ENTRANCE RAILING

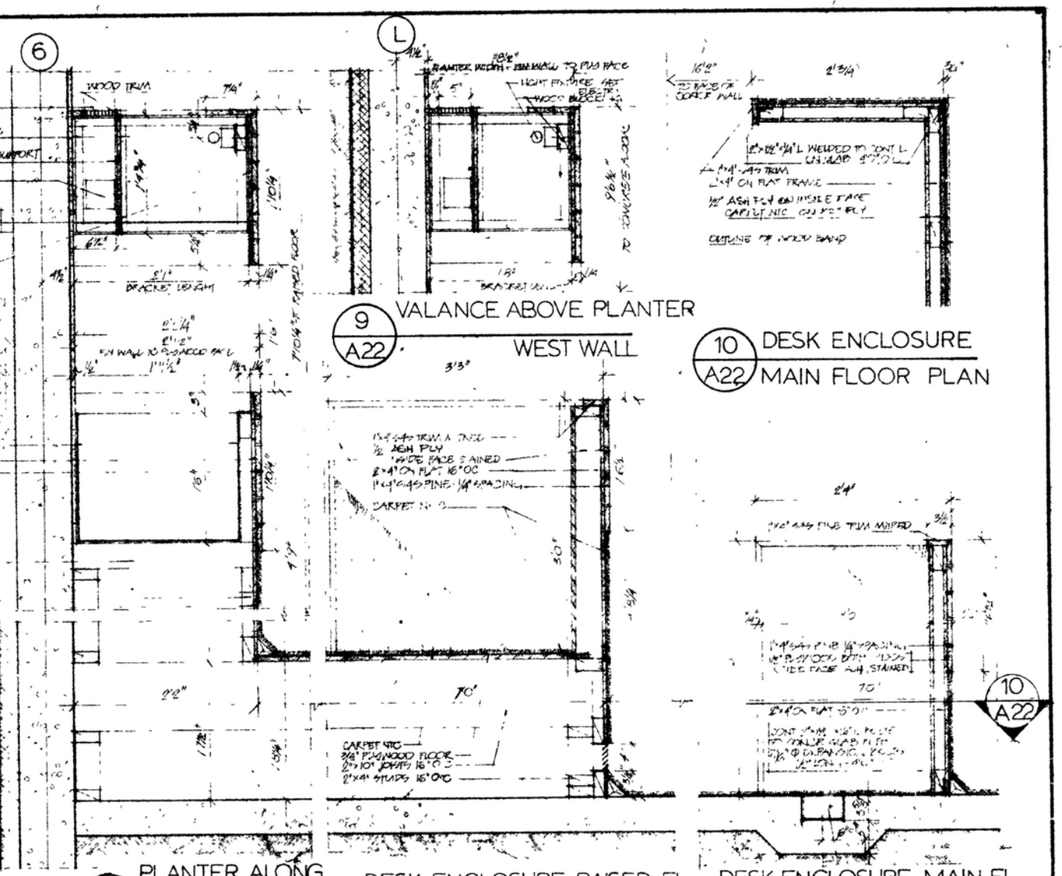


9 / A22 VALANCE ABOVE PLANTER WEST WALL


10 / A22 DESK ENCLOSURE MAIN FLOOR PLAN

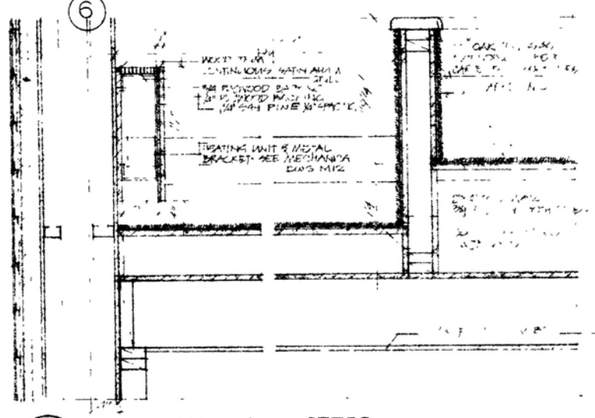

2 / A22 GALLERY STEPS

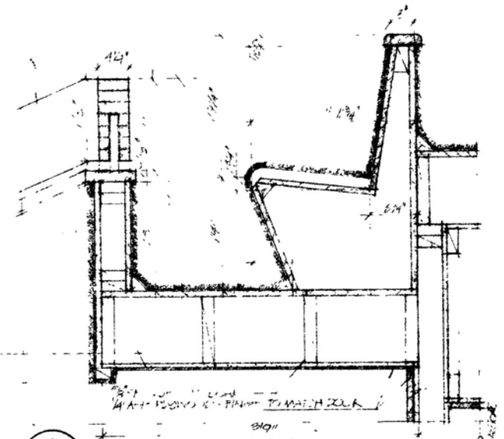


4 / A22 GALLERY RAILING OVER MAIN ENTRANCE

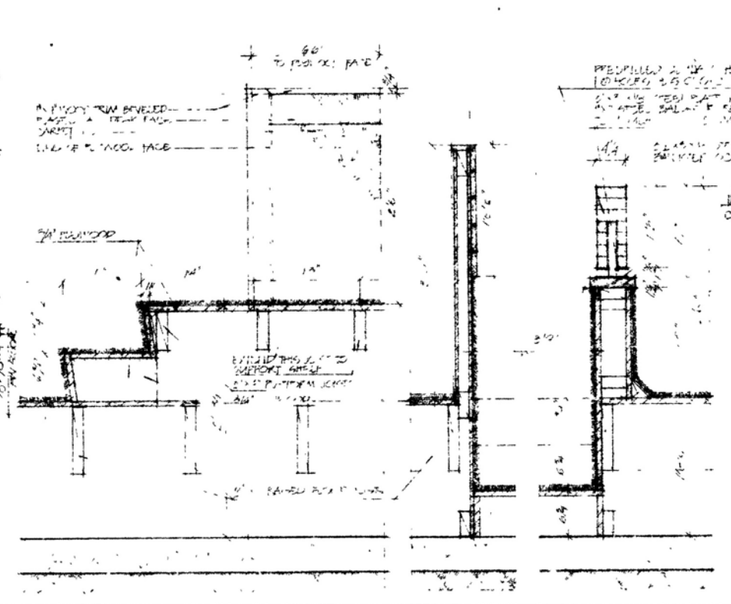


6 / A22 SPEAKER'S PLATFORM

8 / A22 STEPS BETWEEN DESK & GALLERY

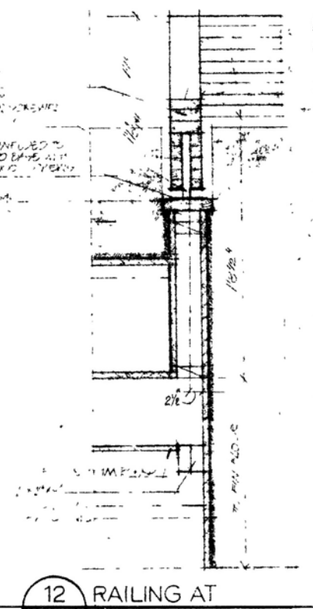


12 / A22 RAILING AT GALLERY

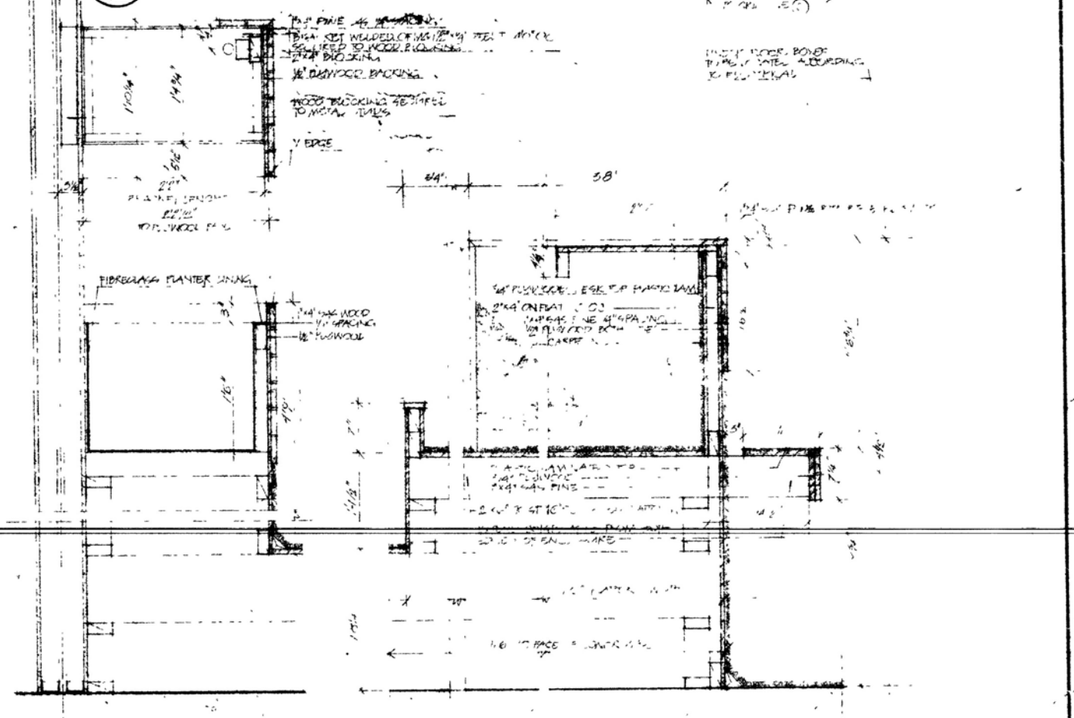


11 / A22 PLANTER ALONG NORTH WALL

DESK ENCLOSURE, RAISED FL.

DESK ENCLOSURE, MAIN FL.

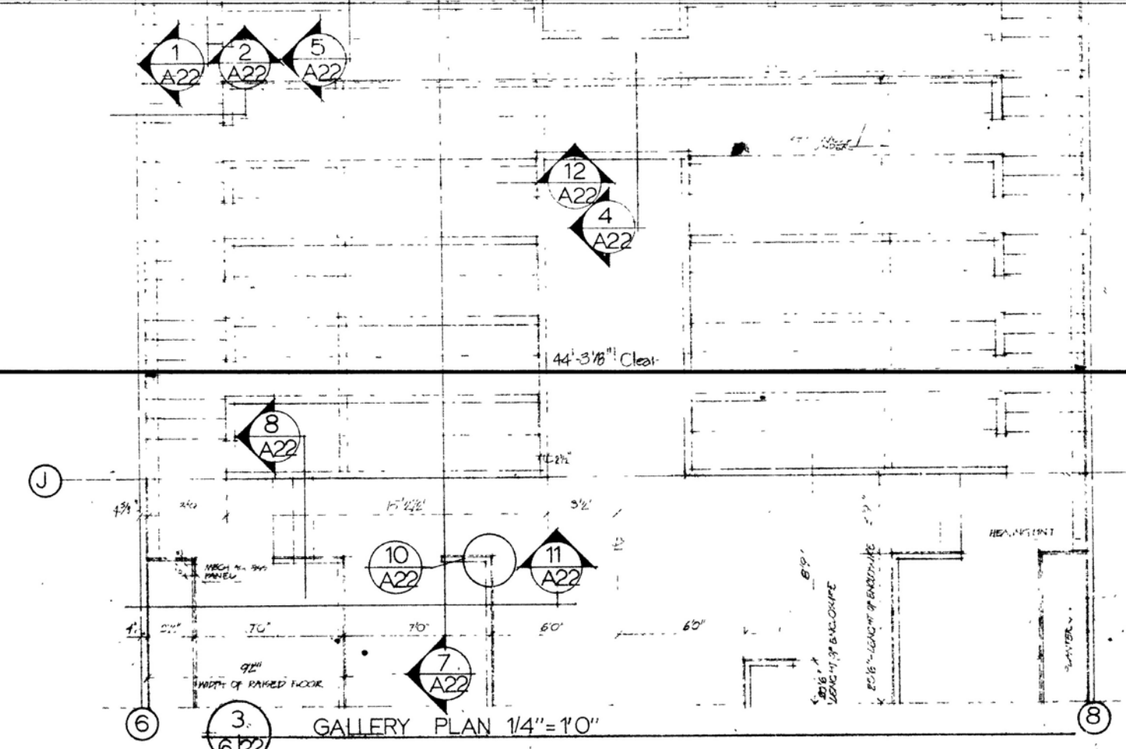


3 / A22 GALLERY PLAN 1/4" = 1'0"

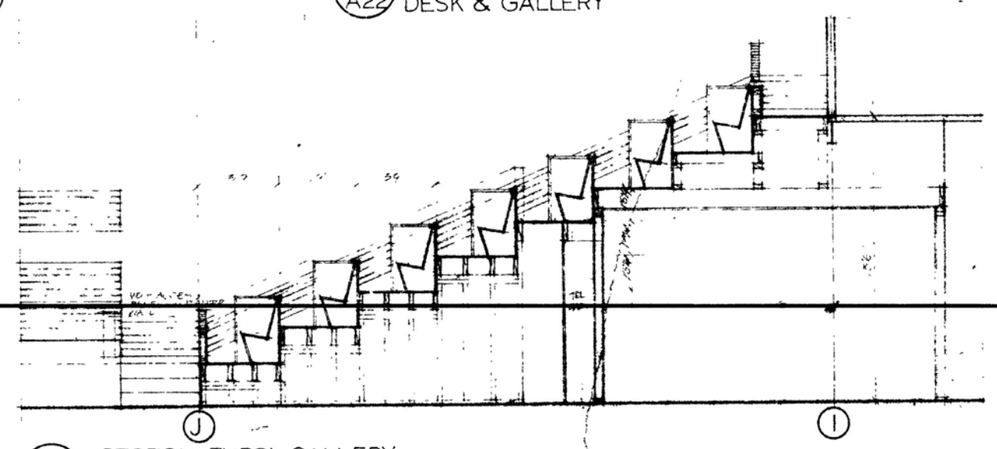

7 / A22 SECTION THRU' GALLERY 1/4" = 1'0"

NOTE - ALL DETAILS 1"=1'0" EXCEPT AS NOTED

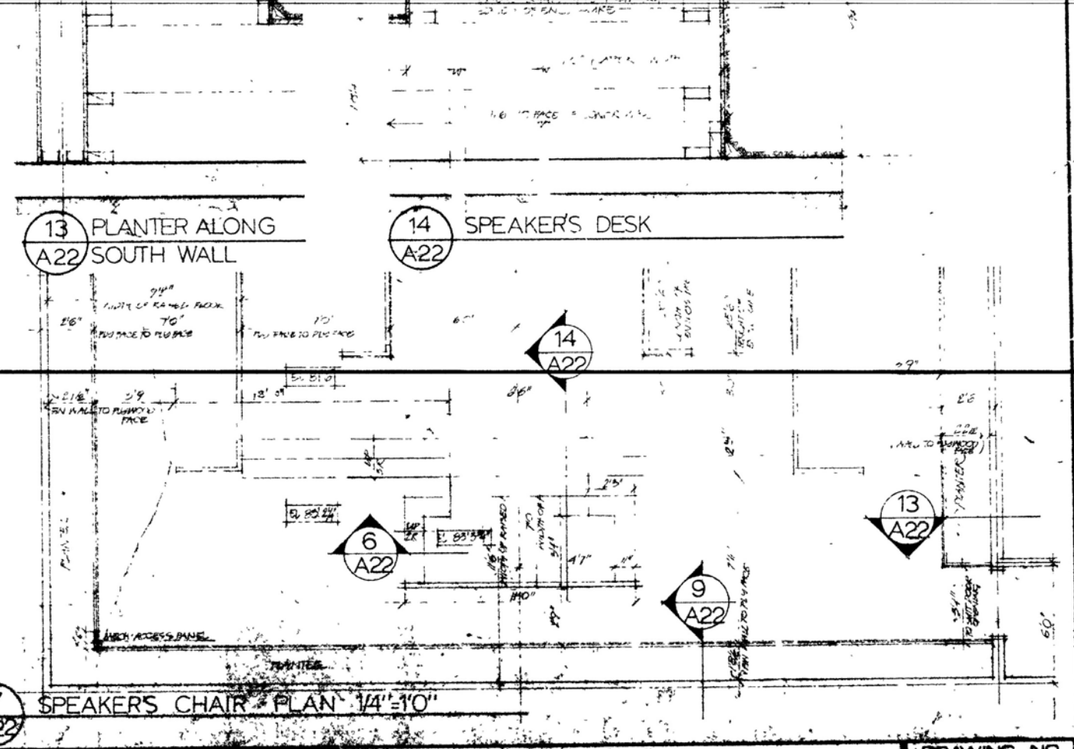

13 / A22 PLANTER ALONG SOUTH WALL

14 / A22 SPEAKER'S DESK

17 / A22 SPEAKER'S CHAIR - PLAN 1/4" = 1'0"

Public Works Travaux publics Canada Canada Pacific Region

REVISIONS		
NO.	DATE	DESCRIPTION
1	79/07/31	Revised to As Built

PROJECT NO. 80187
DATE
SCALE
DRAWN
APPROVED


GOVERNMENT OF THE YUKON TERRITORY

DRAWING TITLE: DRAWING, SECTIONS, ELEVATIONS AND DETAILS

DRAWING NO. A 22

Le 0017

0018

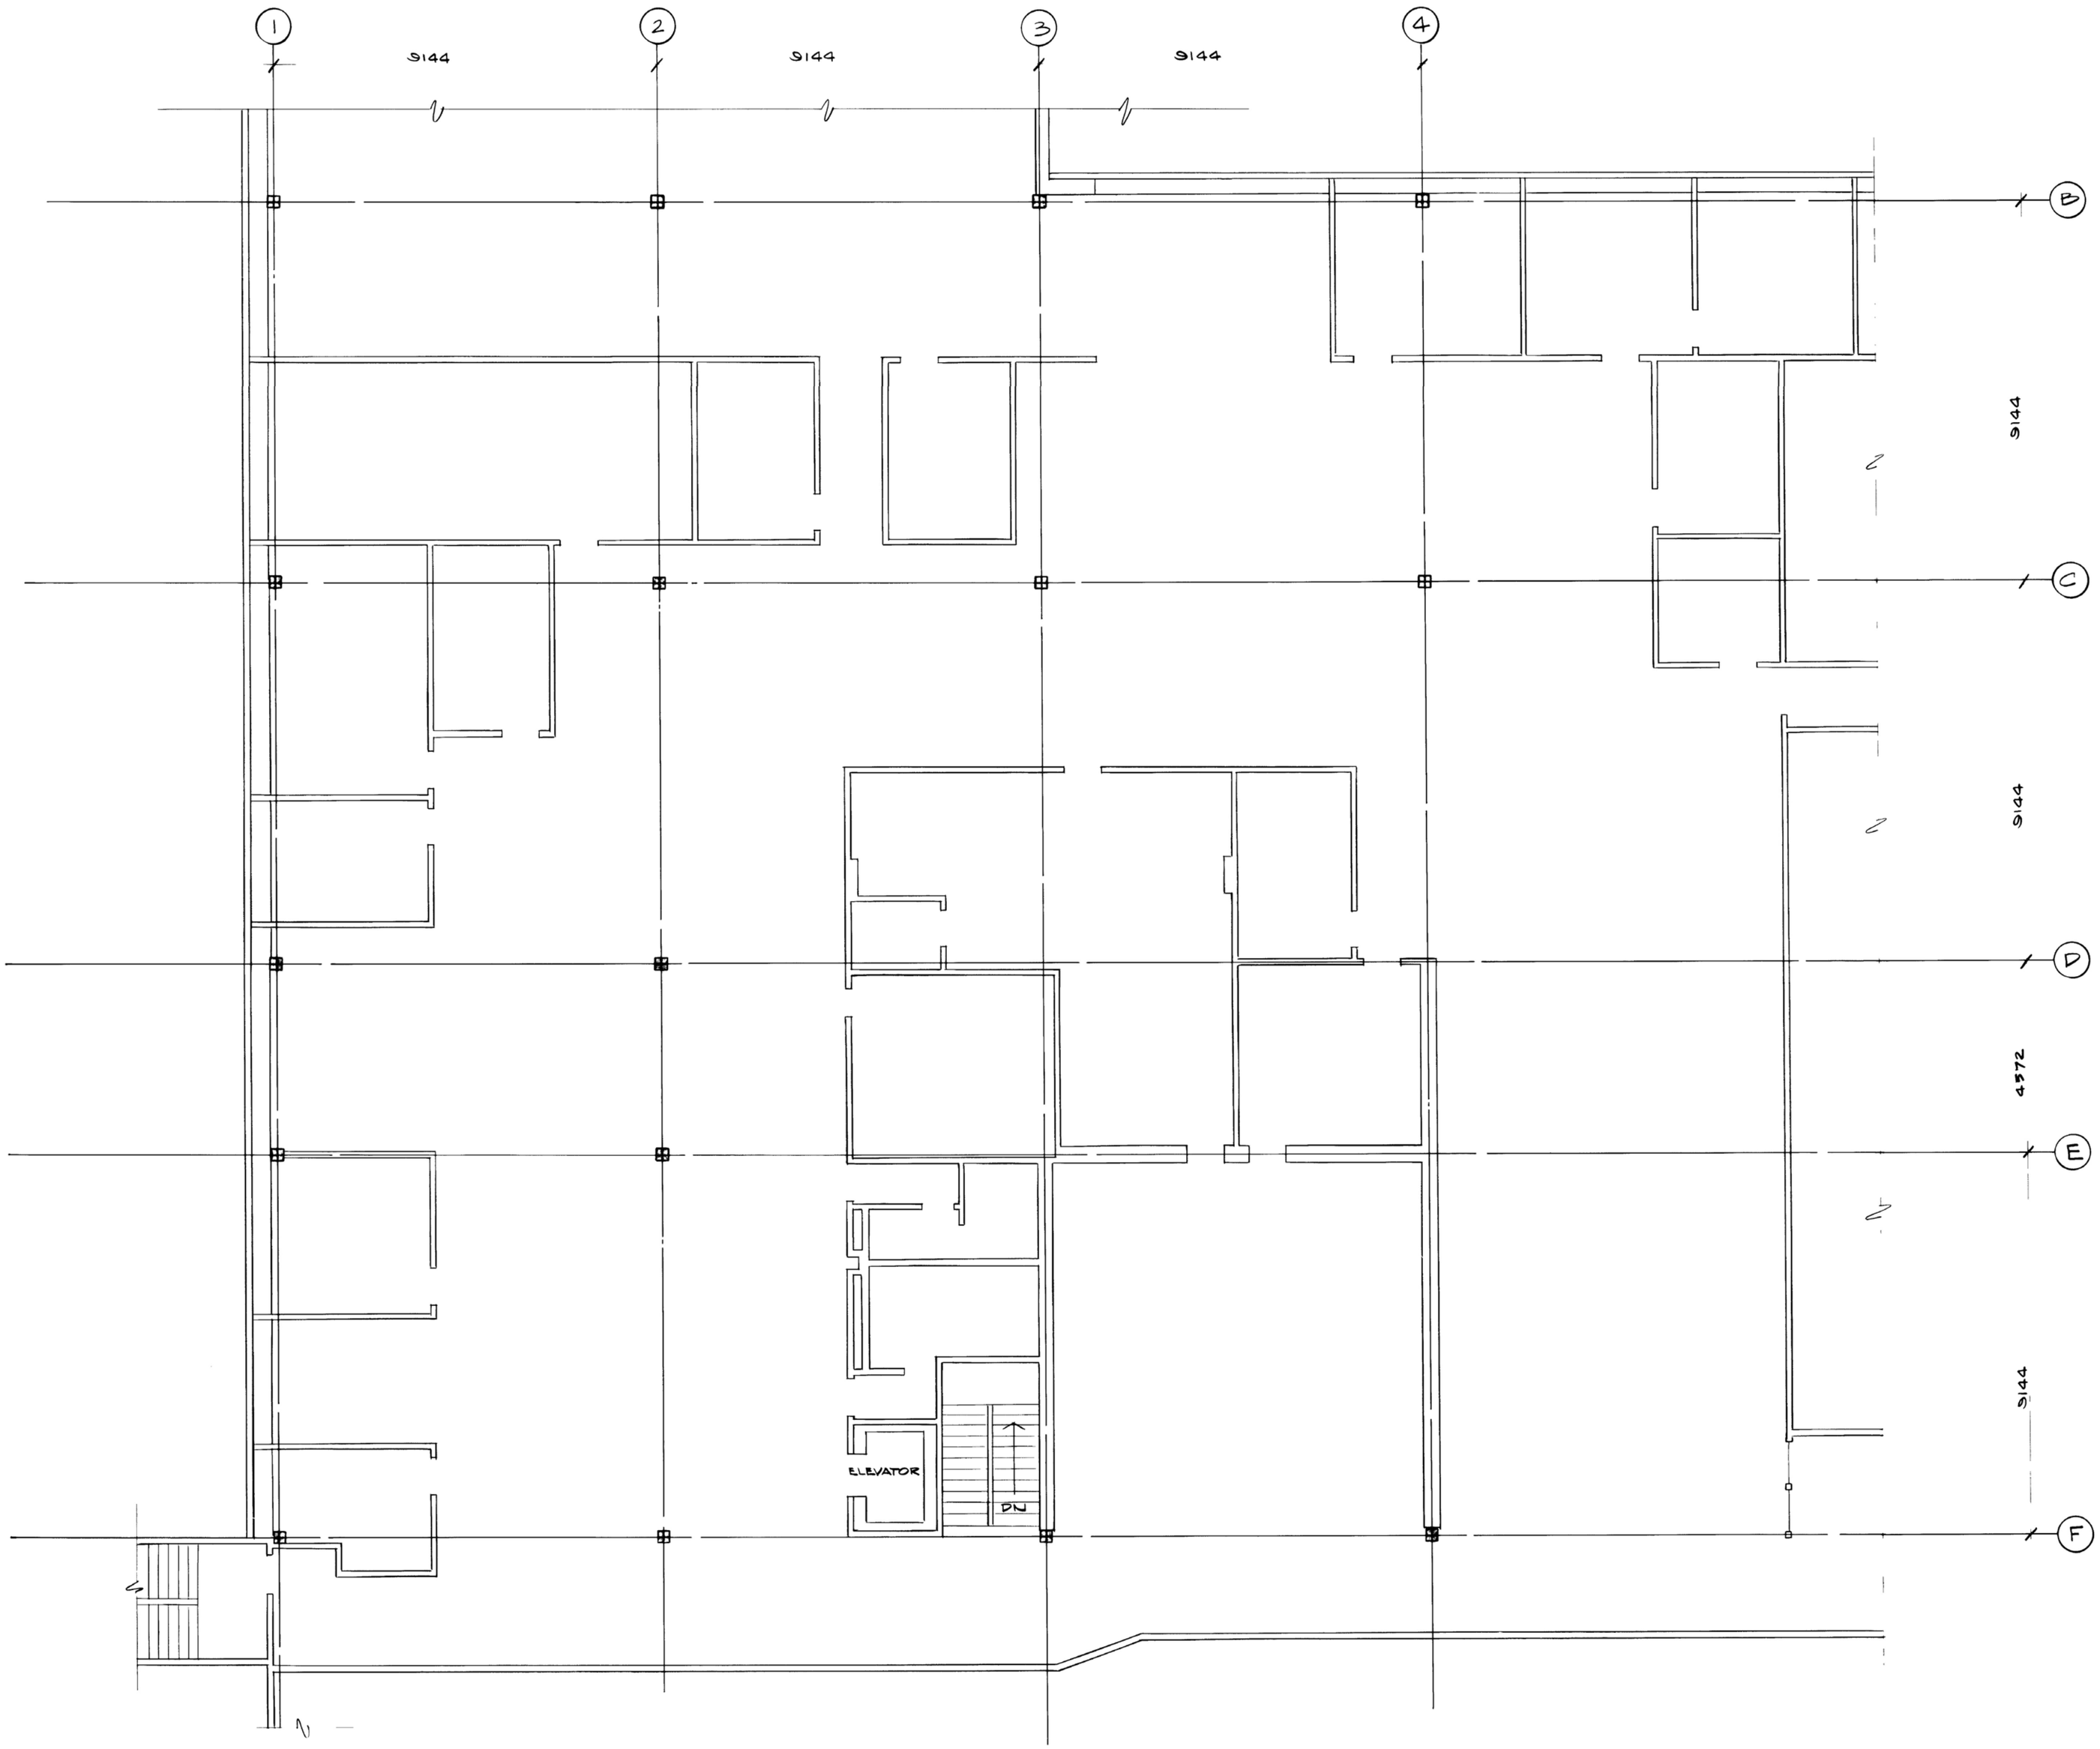

NOTES

Yukon
Government Services
Public Works

REVISIONS

NO	DATE	ENG	SUBJECT

PROJECT
YTG ADMINISTRATION BUILDING
WHITEHORSE YT

DRAWING TITLE
LEVEL 3 PARTIAL FLOOR PLAN

SCALE	1 75
DATE	JULY /86
DESIGN	
DRAWN	W K G
CHECKED	
APPROVED	

DRAWING NUMBER	SHEET

VANCAL 1979

PHASE ONE CONCRETE SUBSTRUCTURE

GENERAL NOTES

FOOTING SCHEDULE		
TYPE	SIZE	REINFORCING
A		
B		
C		
D		
E		
F		
G		
H		
J		
K		
L		
M		
N		
P		
Q		

WALL REINFORCEMENT SCHEDULE		
SIZE	HORIZONTAL	VERTICAL
8' WALL		
10' WALL		
15' WALL		

NOTE
360 ø BOLTS TOTAL REQD AS FOLLOWS
84 COLS - 4 ø EA
50 COLS - 4 ø EA
4 - ANCHOR BOLTS & ANCHOR BOLT ADJUST SUPPLIED BY GYT

EXTERIOR — INTERIOR

TYPICAL FOOTING DETAILS
NO SCALE


TYPICAL DETAIL FOR FOOTINGS ON LINER

BUSH & BOHLMAN LTD.
consulting engineers
1121 MELVILLE ST VANCOUVER B C TELEPHONE 688-6841

REVISIONS
NO. DATE DESCRIPTION

PROJECT 8855

GOVERNMENT OF THE YUKON TERRITORY

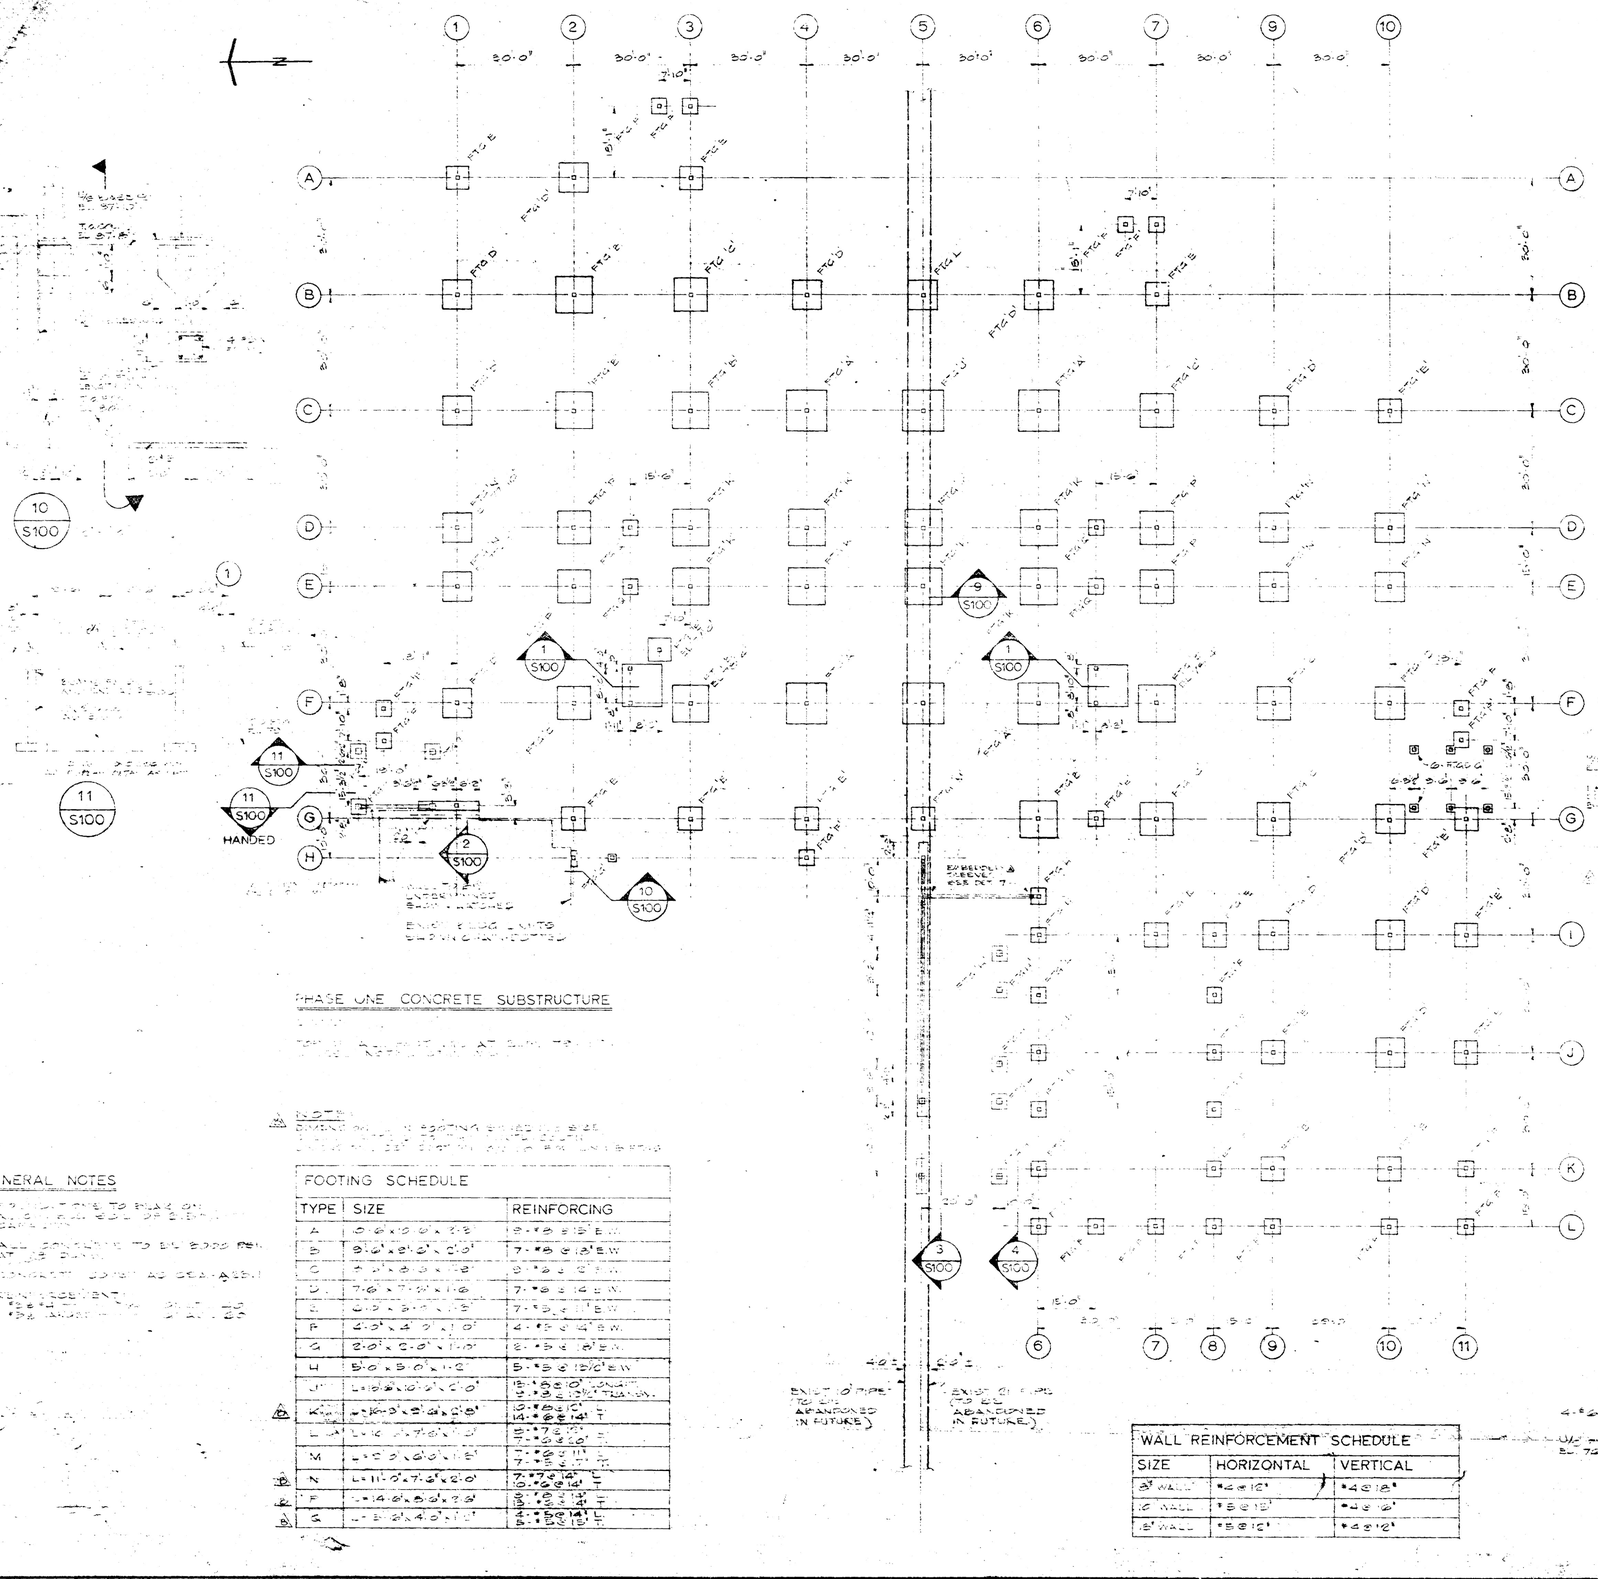

PHASE ONE CONCRETE SUBSTRUCTURE

GENERAL NOTES

1. [illegible]
2. ALL CONCRETE TO BE [illegible] AT 28 DAYS.
3. CONSTRUCTION JOINTS AS SHOWN ON [illegible]
4. REINFORCEMENT [illegible]

FOOTING SCHEDULE		
TYPE	SIZE	REINFORCING
A	10'-6" x 10'-0" x 2'-0"	9-#5 @ 1'-0" E.W.
B	8'-0" x 8'-0" x 1'-10"	7-#5 @ 1'-3" E.W.
C	7'-0" x 7'-0" x 1'-8"	6-#5 @ 1'-4" E.W.
D	7'-6" x 7'-0" x 1'-6"	7-#5 @ 1'-0" E.W.
E	6'-0" x 5'-0" x 1'-3"	7-#5 @ 1'-0" E.W.
F	4'-0" x 4'-0" x 1'-0"	4-#5 @ 1'-0" E.W.
G	2'-0" x 2'-0" x 1'-0"	2-#5 @ 1'-0" E.W.
H	5'-0" x 5'-0" x 1'-2"	5-#5 @ 12"/C E.W.
J	L=18'-0" x 2'-0" x 1'-0"	13-#5 @ 12" CONT. 2-#5 CONT. TOP & BOT.
K	L=14'-0" x 2'-0" x 1'-0"	10-#5 @ 12" T 10-#5 @ 12" T
L	L=14'-0" x 7'-0" x 1'-0"	11-#5 @ 12" T 7-#5 @ 12" T
M	L=10'-0" x 6'-0" x 1'-6"	7-#5 @ 12" T 7-#5 @ 12" T
N	L=11'-0" x 7'-6" x 2'-0"	7-#5 @ 12" T 10-#5 @ 12" T
P	L=14'-6" x 6'-0" x 2'-0"	9-#5 @ 12" T 4-#5 @ 12" T
Q	L=15'-6" x 4'-0" x 1'-6"	4-#5 @ 12" T 5-#5 @ 12" T

WALL REINFORCEMENT SCHEDULE		
SIZE	HORIZONTAL	VERTICAL
8" WALL	#4 @ 12"	#4 @ 18"
10" WALL	#5 @ 12"	#4 @ 16"
12" WALL	#5 @ 12"	#4 @ 12"

NOTE: [illegible]

NOTE: [illegible]

TYPICAL FOOTING DETAILS

EXTERIOR

INTERIOR

NO SCALE

GENERAL EXCAVATION TO EL. 80.0'

#4 @ 8' DOWELS (TYP.)

6'-0" N.T.S.

REMOVE EXIST. 6" WIDE CONC. PIER AND UNDERPIG LEVEL W/ BASE OF EL. 81.21' TOP OF EL. 80.11'

CONTINUOUS [illegible]

SIMILAR

TYPICAL DETAIL FOR FOOTINGS ON LINE B

BUSH & BOHLMAN LTD.
consulting engineers
1111 MELVILLE ST. VANCOUVER B.C. TELEPHONE 688-9241


REVISIONS

NO.	DATE	DESCRIPTION
A	11/3/71	ENTRY RAMP ELEVATIONS AS NOTED, DETAILS 11, 3, 4, 7
B	11/4/71	FOOTINGS "H" & "J" CHANGED TO 5'-0" & 4'-0" SQUARES
C	26/4/71	CHANGE EL. HOOKBARS IN #300, 1 Row, 7mm, #300, 1 Row, #300 & 1 Row #300
D	31/8/71	Revised to "As Built"

PROJECT NO. 68872
DATE
SCALE
DRAWN
CHKD
APPROVED

GOVERNMENT OF THE YUKON TERRITORY


DRAWING TITLE

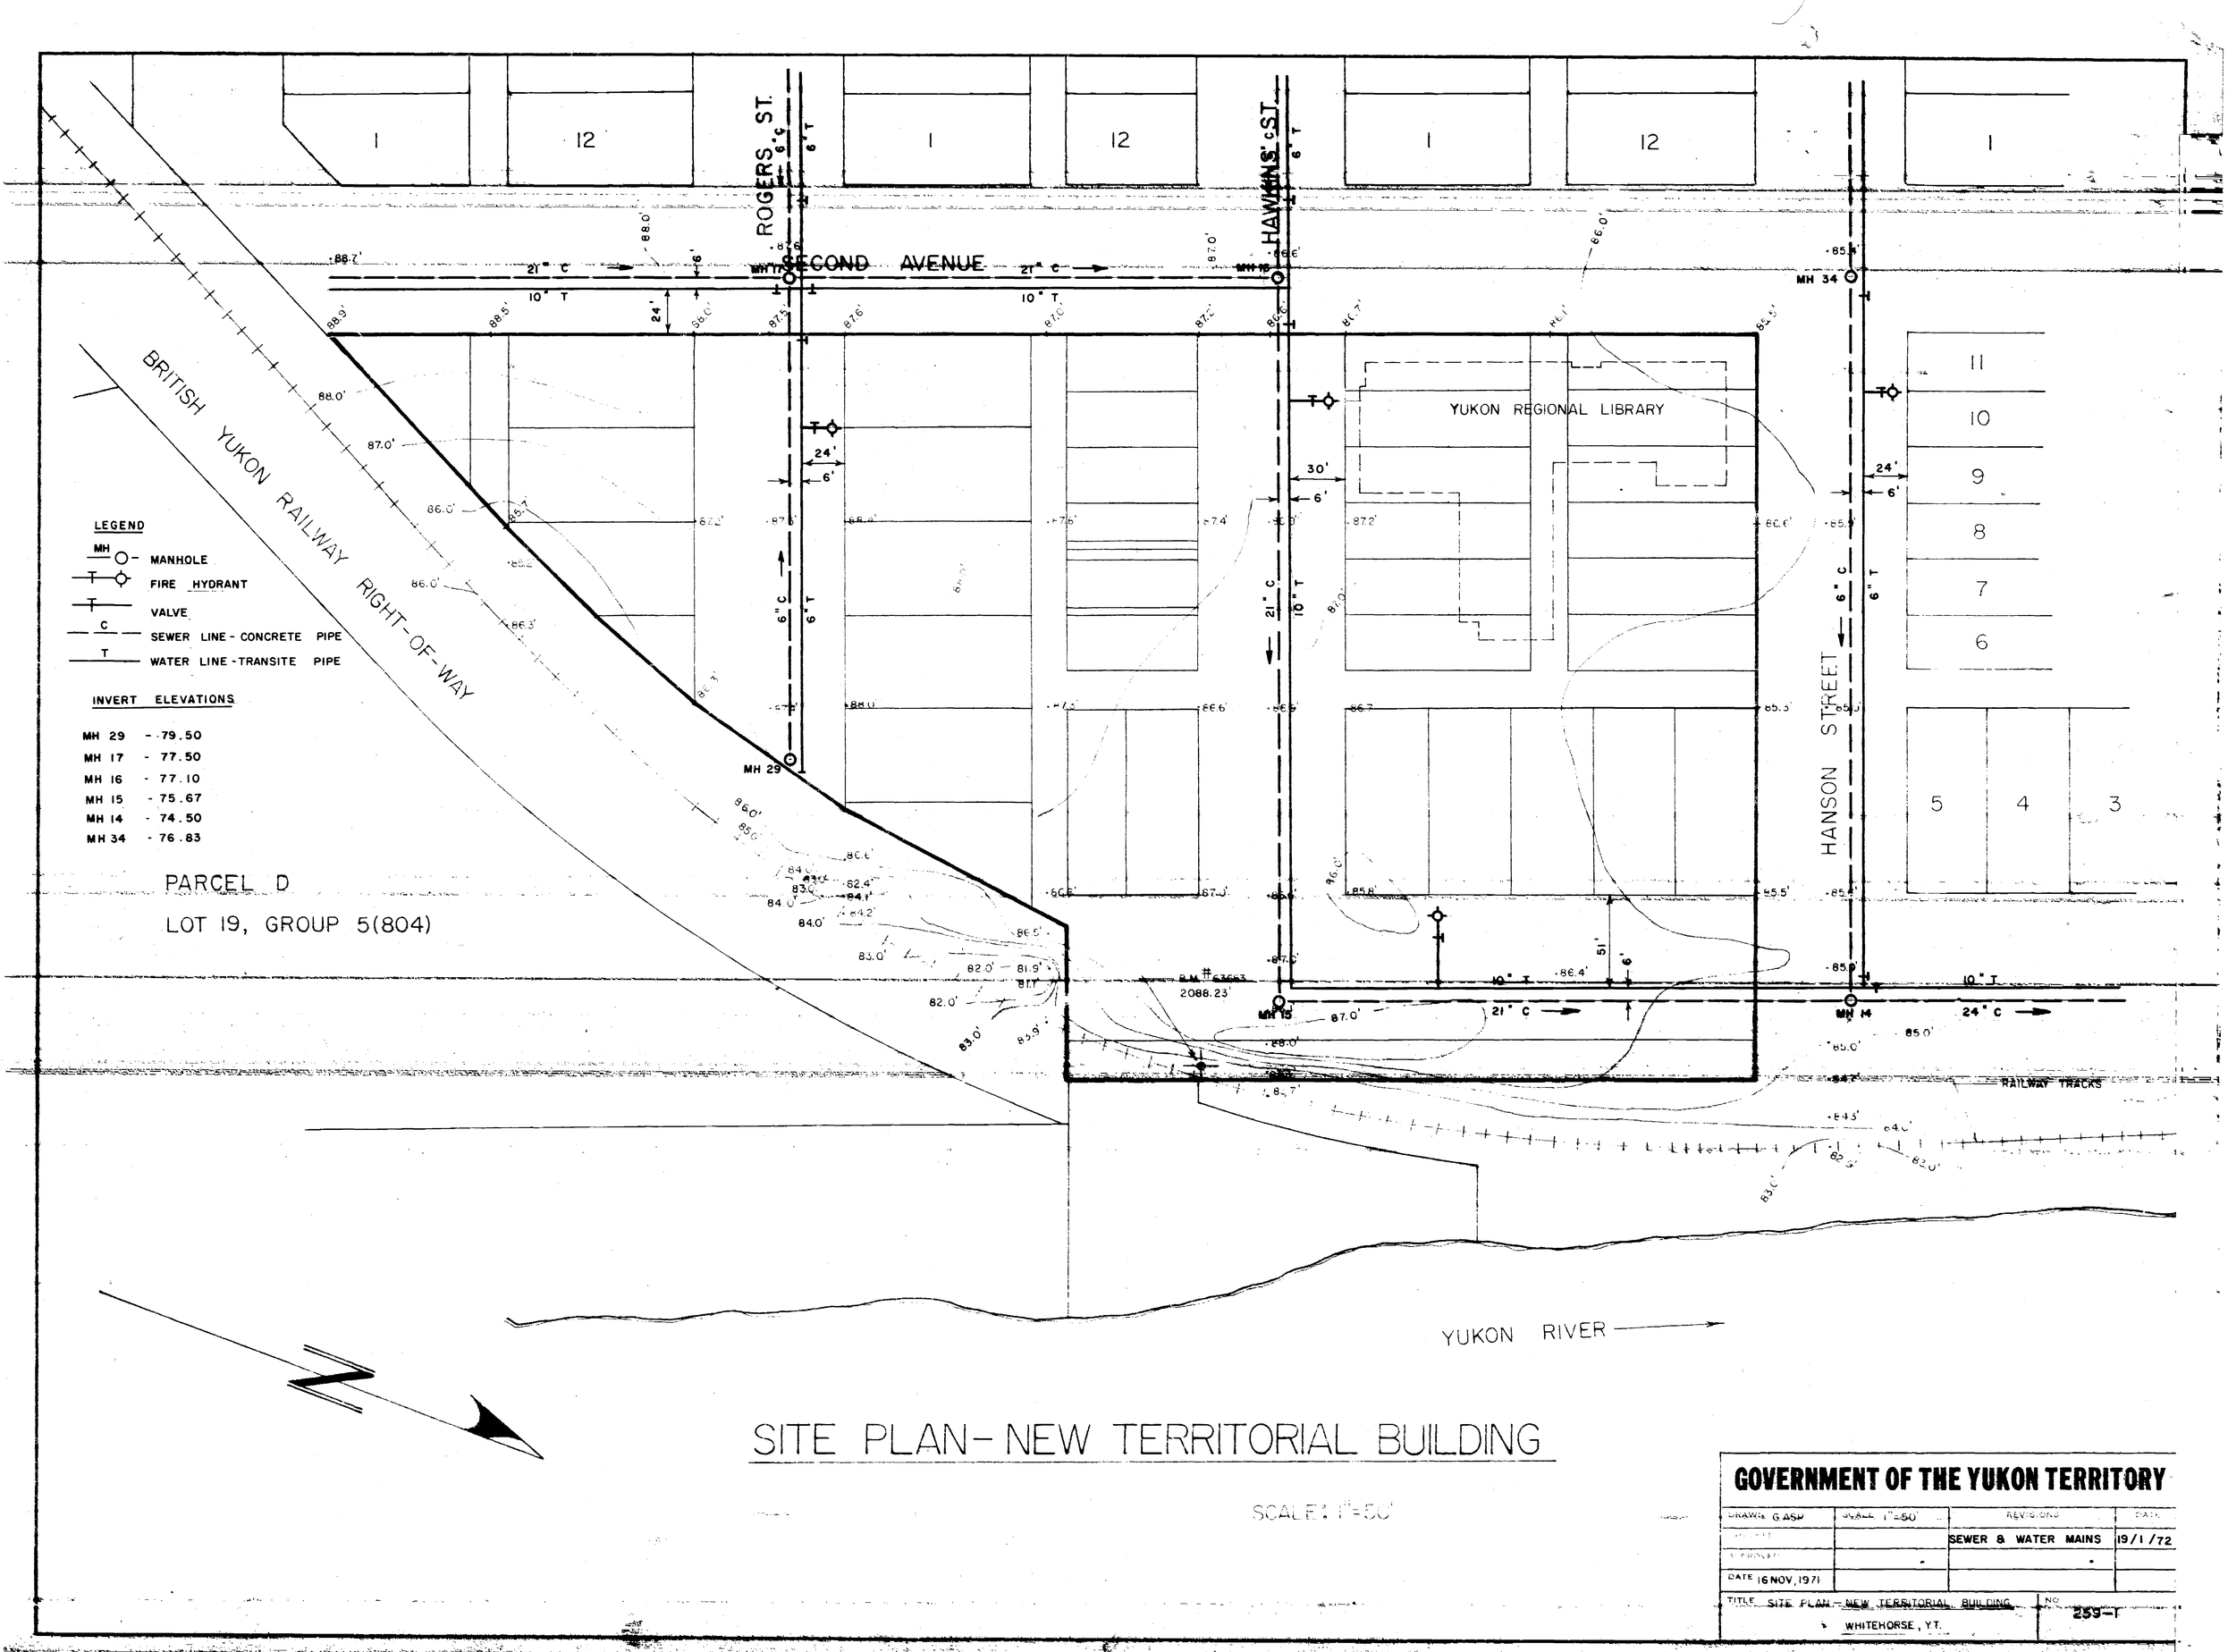

SITE PLAN - NEW TERRITORIAL BUILDING


SCALE: 1"=50'

GOVERNMENT OF THE YUKON TERRITORY			
DRAWN G.ASP	SCALE 1"=50'	REVISIONS	DATE
		SEWER & WATER MAINS	19/1/72
DATE 16 NOV, 1971			
TITLE SITE PLAN - NEW TERRITORIAL BUILDING		NO.	
WHITEHORSE, Y.T.		259-1	

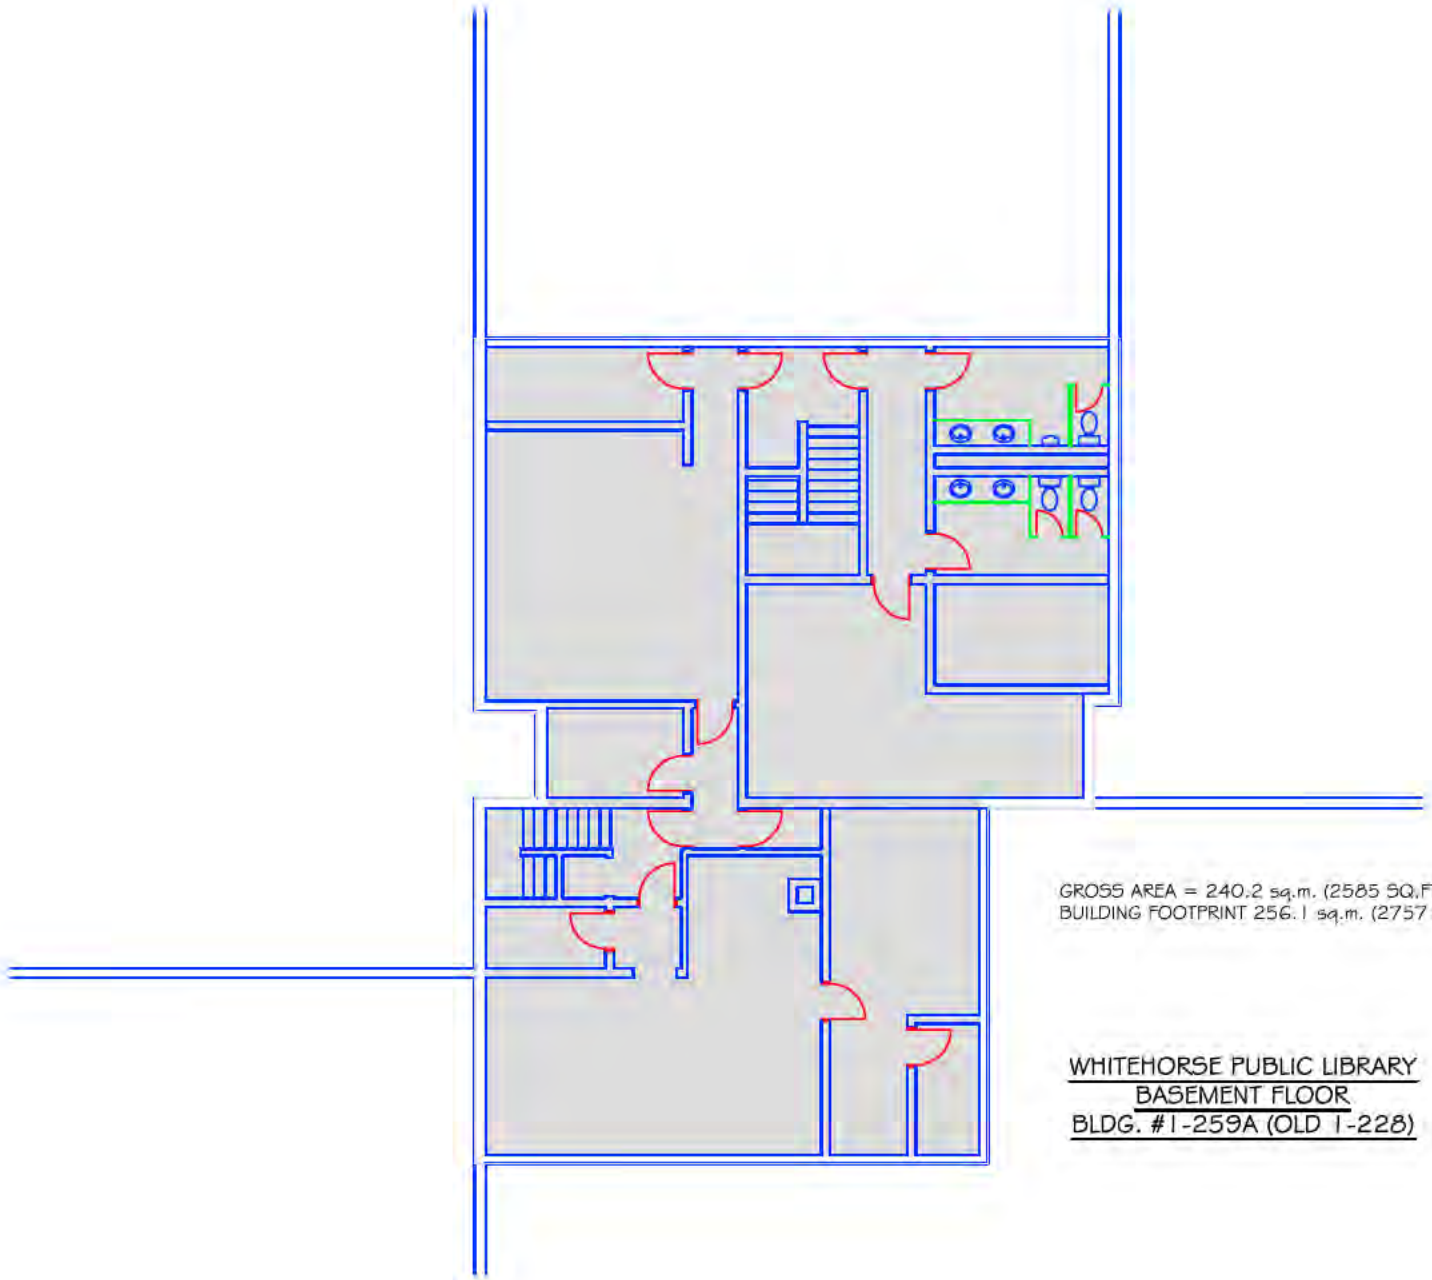

GROSS AREA = 240.2 sq.m. (2585 SQ.FT.)
BUILDING FOOTPRINT 256.1 sq.m. (2757 SQ.FT.)

WHITEHORSE PUBLIC LIBRARY
BASEMENT FLOOR
BLDG. #1-259A (OLD 1-228)

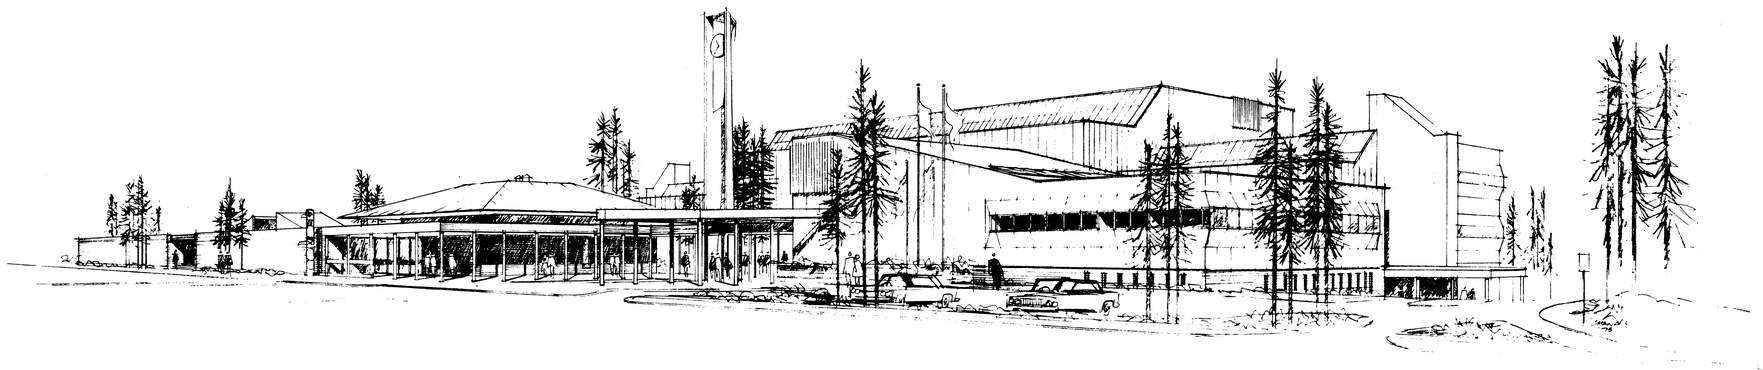

GOVERNMENT OF THE YUKON TERRITORY

TERRITORIAL ADMINISTRATION BUILDING

WHITEHORSE, Y. T. PROJECT 89857 APRIL 1974

ARCHITECTURAL, MECHANICAL
& ELECTRICAL CONSULTANTS

PUBLIC WORKS CANADA PACIFIC REGION
1444 ALBERNI STREET
VANCOUVER 5, B.C.
(604) 666-6440

STRUCTURAL CONSULTANT


BUSH & BOHLMAN LTD
1171 MELVILLE STREET
VANCOUVER 5, B.C.
(604) 688-9861

TECHNICAL ADVISORS

BARRON & STRACHAN
CONSULTING ACOUSTICAL ENGINEERS
3284 HEATHER STREET
VANCOUVER 9, B. C.
(604) 872-2508

N. M. LOPIANOWSKI & ASSOCIATES
CONSULTING TELECOMMUNICATION ENGINEERS
2182 W. 12TH AVENUE
VANCOUVER, B. C.
(604) 738-5330

PHASE 2: MAIN CONTRACT

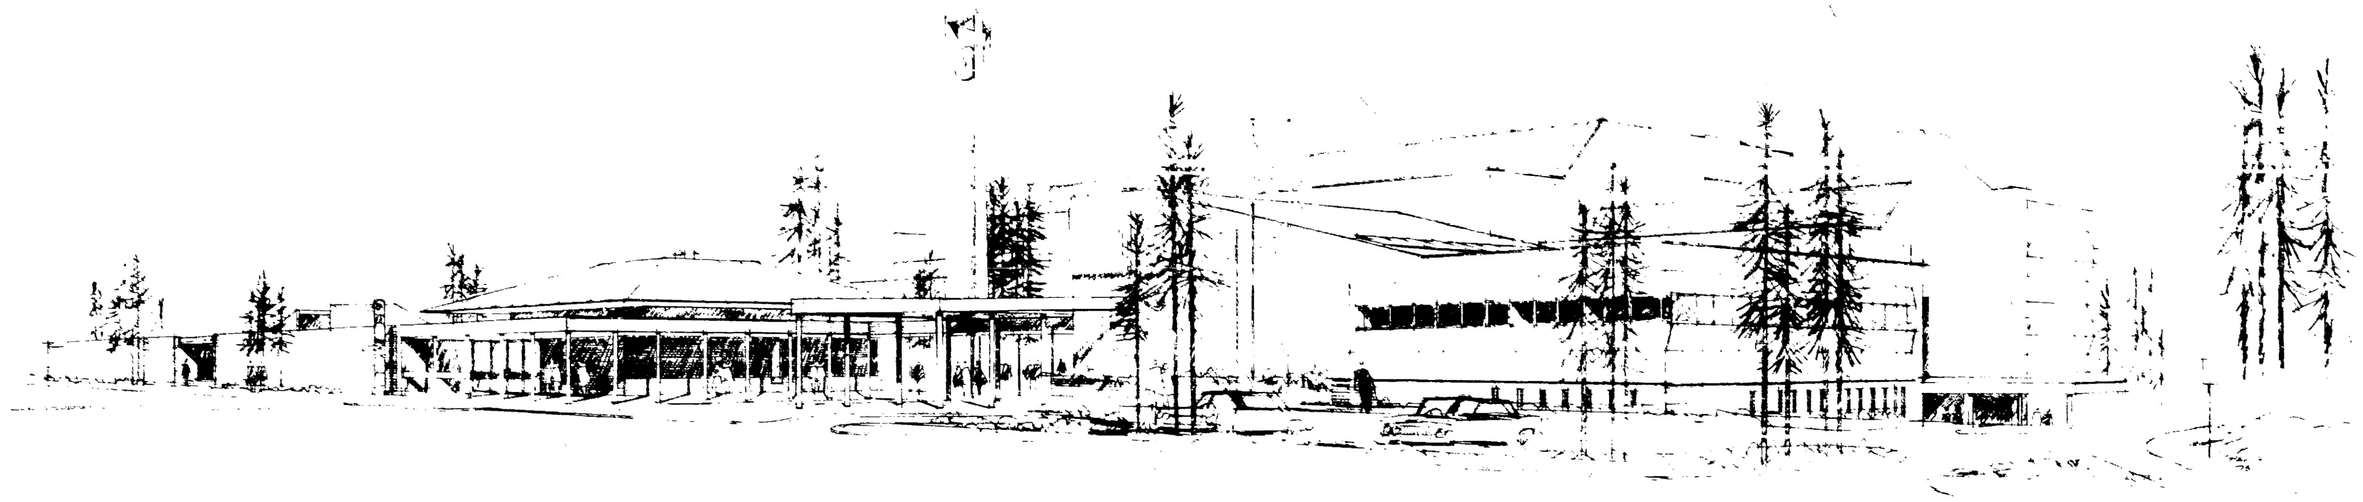

GOVERNMENT OF THE YUKON TERRITORY

TERRITORIAL ADMINISTRATION BUILDING

WHITEHORSE, Y. T. PROJECT 89857 APRIL 1974

ARCHITECTURAL, MECHANICAL
& ELECTRICAL CONSULTANTS

PUBLIC WORKS CANADA PACIFIC REGION
1444 ALBERNI STREET
VANCOUVER 5, B.C.
(604) 666-6440

STRUCTURAL CONSULTANT


BUSH & BOHLMAN LTD
1171 MELVILLE STREET
VANCOUVER 5, B.C.
(604) 688-9861

TECHNICAL ADVISORS

BARRON & STRACHAN
CONSULTING ACOUSTICAL ENGINEERS
3284 HEATHER STREET
VANCOUVER 9, B C
(604) 872-2508

N. M. LOPIANOWSKI & ASSOCIATES
CONSULTING TELECOMMUNICATION ENGINEERS
2182 W. 12TH AVENUE
VANCOUVER, B. C.
(604) 738-5330

PHASE 2: MAIN CONTRACT

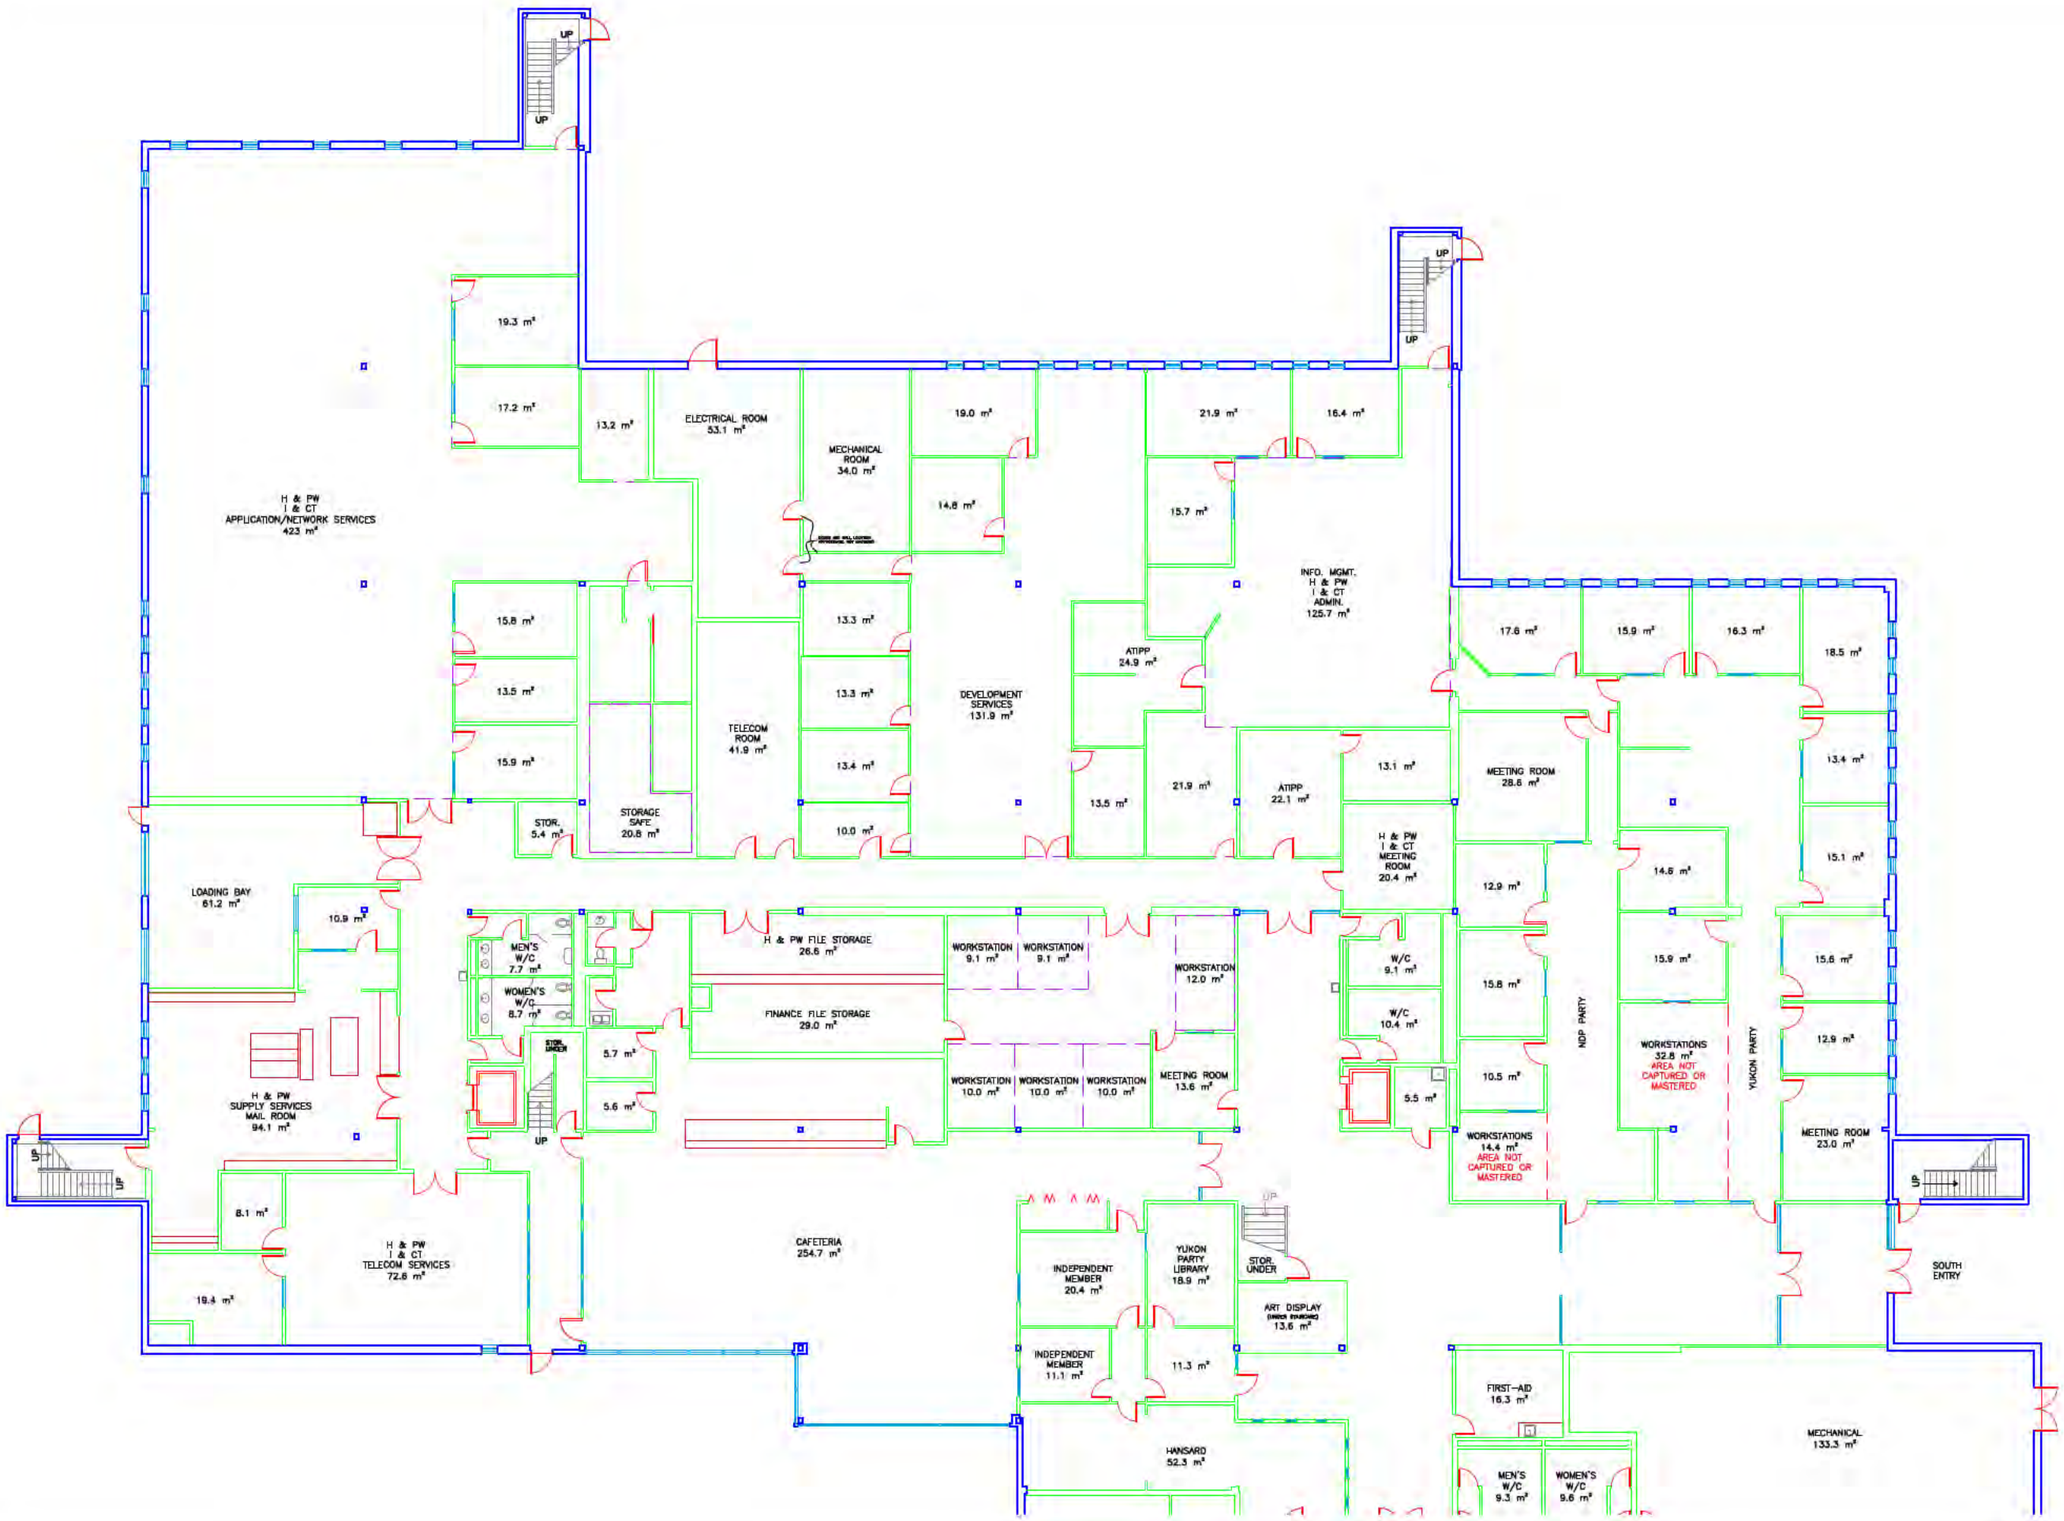

NOTES/REFERENCE DRAWINGS

LEGEND

- EXISTING INTERIOR WALL
- EXISTING EXTERIOR WALL
- GLAZING
- WORKSTATION
- BULKHEAD
- ACOUSTIC INSULATION
- EXISTING DOOR
- EXISTING CONNECTION (INCLUDES ELECTRICAL AND/OR VOICE-DATA) — V/D
- DEDICATED LIGHT SWITCH — $

ALL UNITS ARE IN MILLIMETERS UNLESS SPECIFIED

REVISIONS & ISSUES

NO	dd/mm/yy	DESCRIPTION	BY
–	–	–	–
–	–	–	–
00	12/12/12	REVISED (NOT MASTERED)	–

DRAWN: ME
CHK'D: –
SCALE: NTS

Yukon
Highways and Public Works
Property Management Division

BLDG # 1259
MAIN ADMINISTRATION BUILDING


2071 SECOND AVENUE
WHITEHORSE, YT

1st (BASEMENT) FLOOR
PLAN EAST SIDE:

MASTER

Sheet 1 OF 1

REV 00

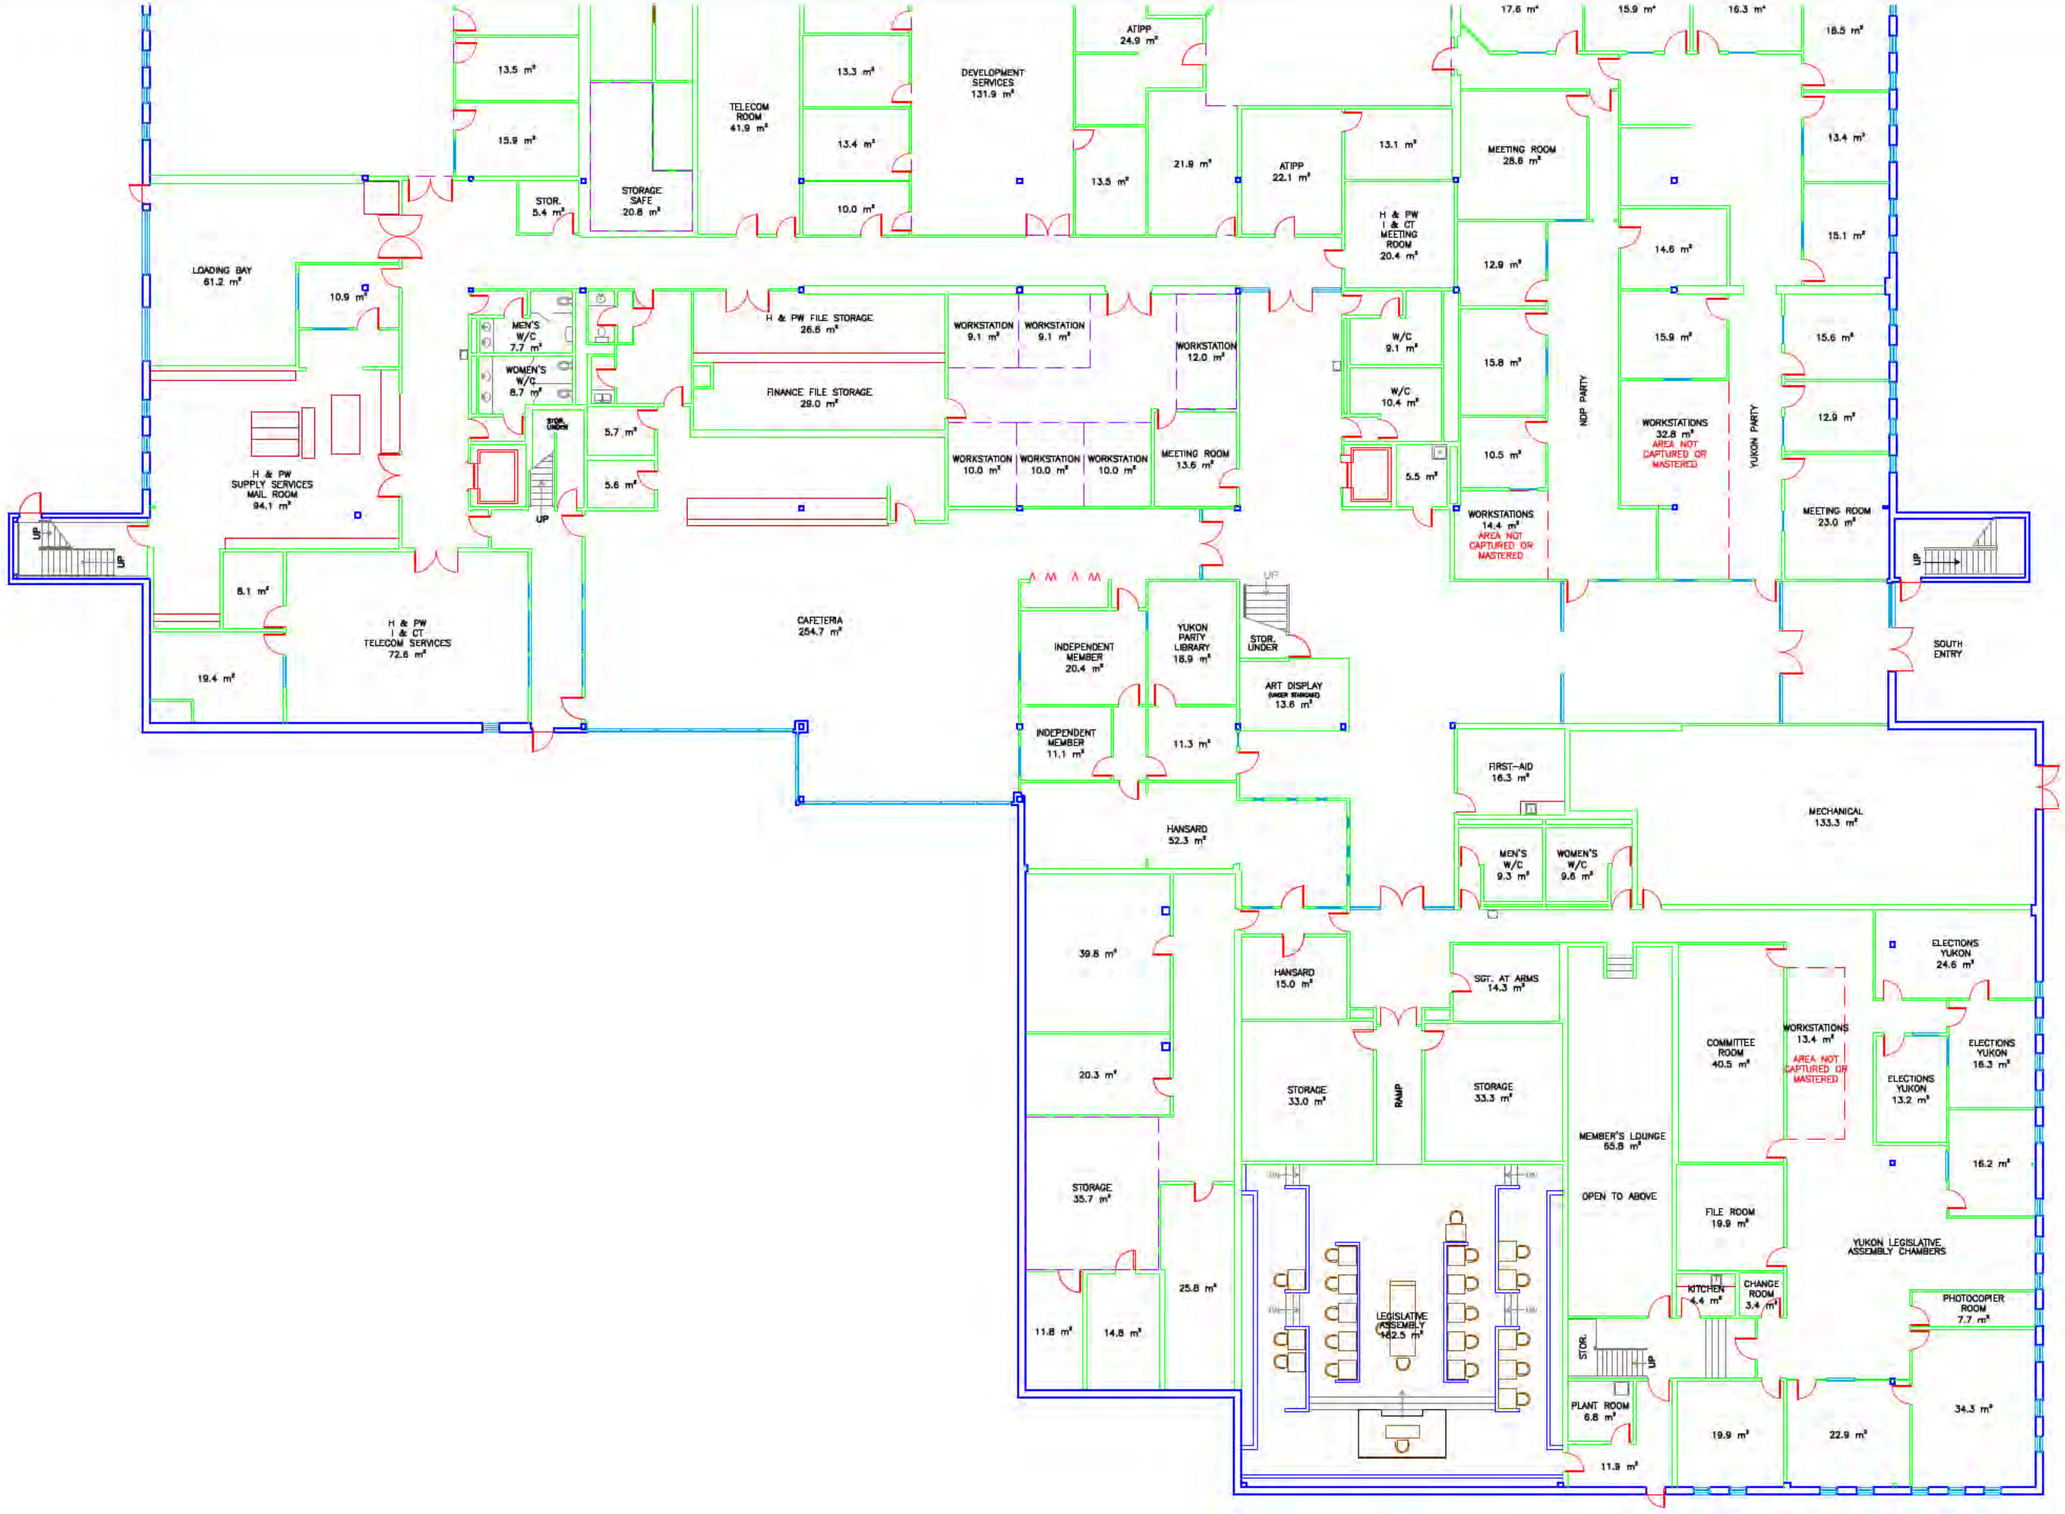

NOTES/REFERENCE DRAWINGS

LEGEND

- EXISTING INTERIOR WALL
- EXISTING EXTERIOR WALL
- GLAZING
- WORKSTATION
- BULKHEAD
- ACOUSTIC INSULATION
- EXISTING DOOR
- EXISTING CONNECTION (INCLUDES ELECTRICAL AND/OR VOICE-DATA) V/D
- DEDICATED LIGHT SWITCH

ALL UNITS ARE IN MILLIMETERS UNLESS SPECIFIED

REVISIONS & ISSUES

NO	dd/mm/yy	DESCRIPTION	BY
–	–	–	–
–	–	–	–
00	12/12/12	REVISED (NOT MASTERED)	–

DRAWN ME | SCALE NTS

CHK'D –

Yukon

Highways and Public Works
Property Management Division

BLDG # 1259
MAIN ADMINISTRATION BUILDING

2071 SECOND AVENUE
WHITEHORSE, YT

1st (BASEMENT) FLOOR PLAN WEST SIDE:

MASTER

Sheet 1 OF 1

REV. 00

WOMEN'S WASHROOM

WOMEN'S WASHROOM

UP

TEMPORARY TAXATION SPACE

WASHROOM

WASHROOM

CAFETERIA
174.5 m²

COFFEE PREP SPACE
17.8 m²

TELEVISION

TABLE 3' x 6'

PROPOSED BOARDROOM AREA
65.5 m²

TELEVISION

INDEPENDENT MEMBER

YUKON PARTY LIBRARY

ART DISPLAY
(UNDER STAIRCASE)

INDEPENDENT MEMBER

HANSARD

BRING THE CONNECTION POINT FOR BOTH TELEVISIONS BACK TO THIS CORNER, TO BE OPERATED FROM A SINGLE COMPUTER

ADDITIONAL NOTES:

- DOORS TO MATCH EXISTING AT A MIN 914 [3'-0"] WIDE, FULL LIGHT C/W GLAZING, LOCKING CLASSROOM HARDWARE, FLOOR SWEEP AND SOUND DAMPENING GASKETS ON DOOR JAMBS.
- INTERIOR WINDOWS (MIN 1067 [3'-6"] X 1829 [6'-0"]) TO BE INSTALLED CENTERED AND EVENLY SPACED ON WALL WITH HEIGHT OF WINDOW MATCHING HEIGHT OF DOOR.
- ALL NEW WALLS TO BE 38 x 89 (2"x4") FRAMED WITH DRYWALL FROM TOP OF FLOOR THROUGH T-BAR CEILING TO STRUCTURE ABOVE AND ACOUSTICALLY INSULATED.
- TO SUPPORT TWO WALL MOUNTED TELEVISIONS: MOUNT 19MM [0'-3/4"] BIRCH PLYWOOD BACKER-BOARD 400 [1'-33/4"] X 800 [2'-71/2"], LOCATED 1524 [5'-0"] ON CENTER FROM FLOOR, PAINT BOARD TO MATCH EXISTING WALL COLOR, INSTALL A DUPLEX RECEPTACLE AND HDMI RECEPTACLE CENTER OF WALL. CONNECTION POINT FOR BOTH TELEVISION BACK TO ONE CORNER.
- BLINDS TO BE PROVIDED FOR ALL EXTERIOR WINDOWS, LIGHT GREY TOP DOWN/BOTTOM UP WINDOW BLINDS.
- ENSURE ROOM HAS CAPACITY FOR 16 DUPLEX RECEPTACLES, 16 VOICE AND 16 DATA PORTS EQUALLY SPACED AROUND THE BOARDROOM ROOM. CONFIGURE ALL VOICE/DATA RECEPTACLES WHERE VOICE PORT IS LOCATED BELOW DATA PORT.
- ACCENT WALLS TO BE DETERMINED ON-SITE.

NOTES/REFERENCE DRAWINGS

LEGEND

- EXISTING INTERIOR WALL
- EXISTING EXTERIOR WALL
- GLAZING
- WORKSTATION
- EXISTING DOOR
- PROPOSED CONNECTION (INCLUDES ELECTRICAL AND/OR VOICE-DATA) V/D
- DEDICATED LIGHT SWITCH $
- PROPOSED DEMOLITION
- PROPOSED CONSTRUCTION
- PROPOSED DOOR

ALL UNITS ARE IN MILLIMETERS UNLESS SPECIFIED

REVISIONS & ISSUES

NO.	yy/mm/dd	DESCRIPTION	BY
–	–	–	–
–	–	–	–
00	18/08/09	FOR APPROVAL	ME

DRAWN: ME
CHK'D: –
SCALE: NTS

Yukon
Highways and Public Works
Property Management Division


BLDG # 1259
MAIN ADMINISTRATION BUILDING

2071 SECOND AVENUE
WHITEHORSE, YT

1st (BASEMENT) FLOOR PLAN:
BOARDROOM PROPOSAL 1

Sheet 1 OF 1

REV 00

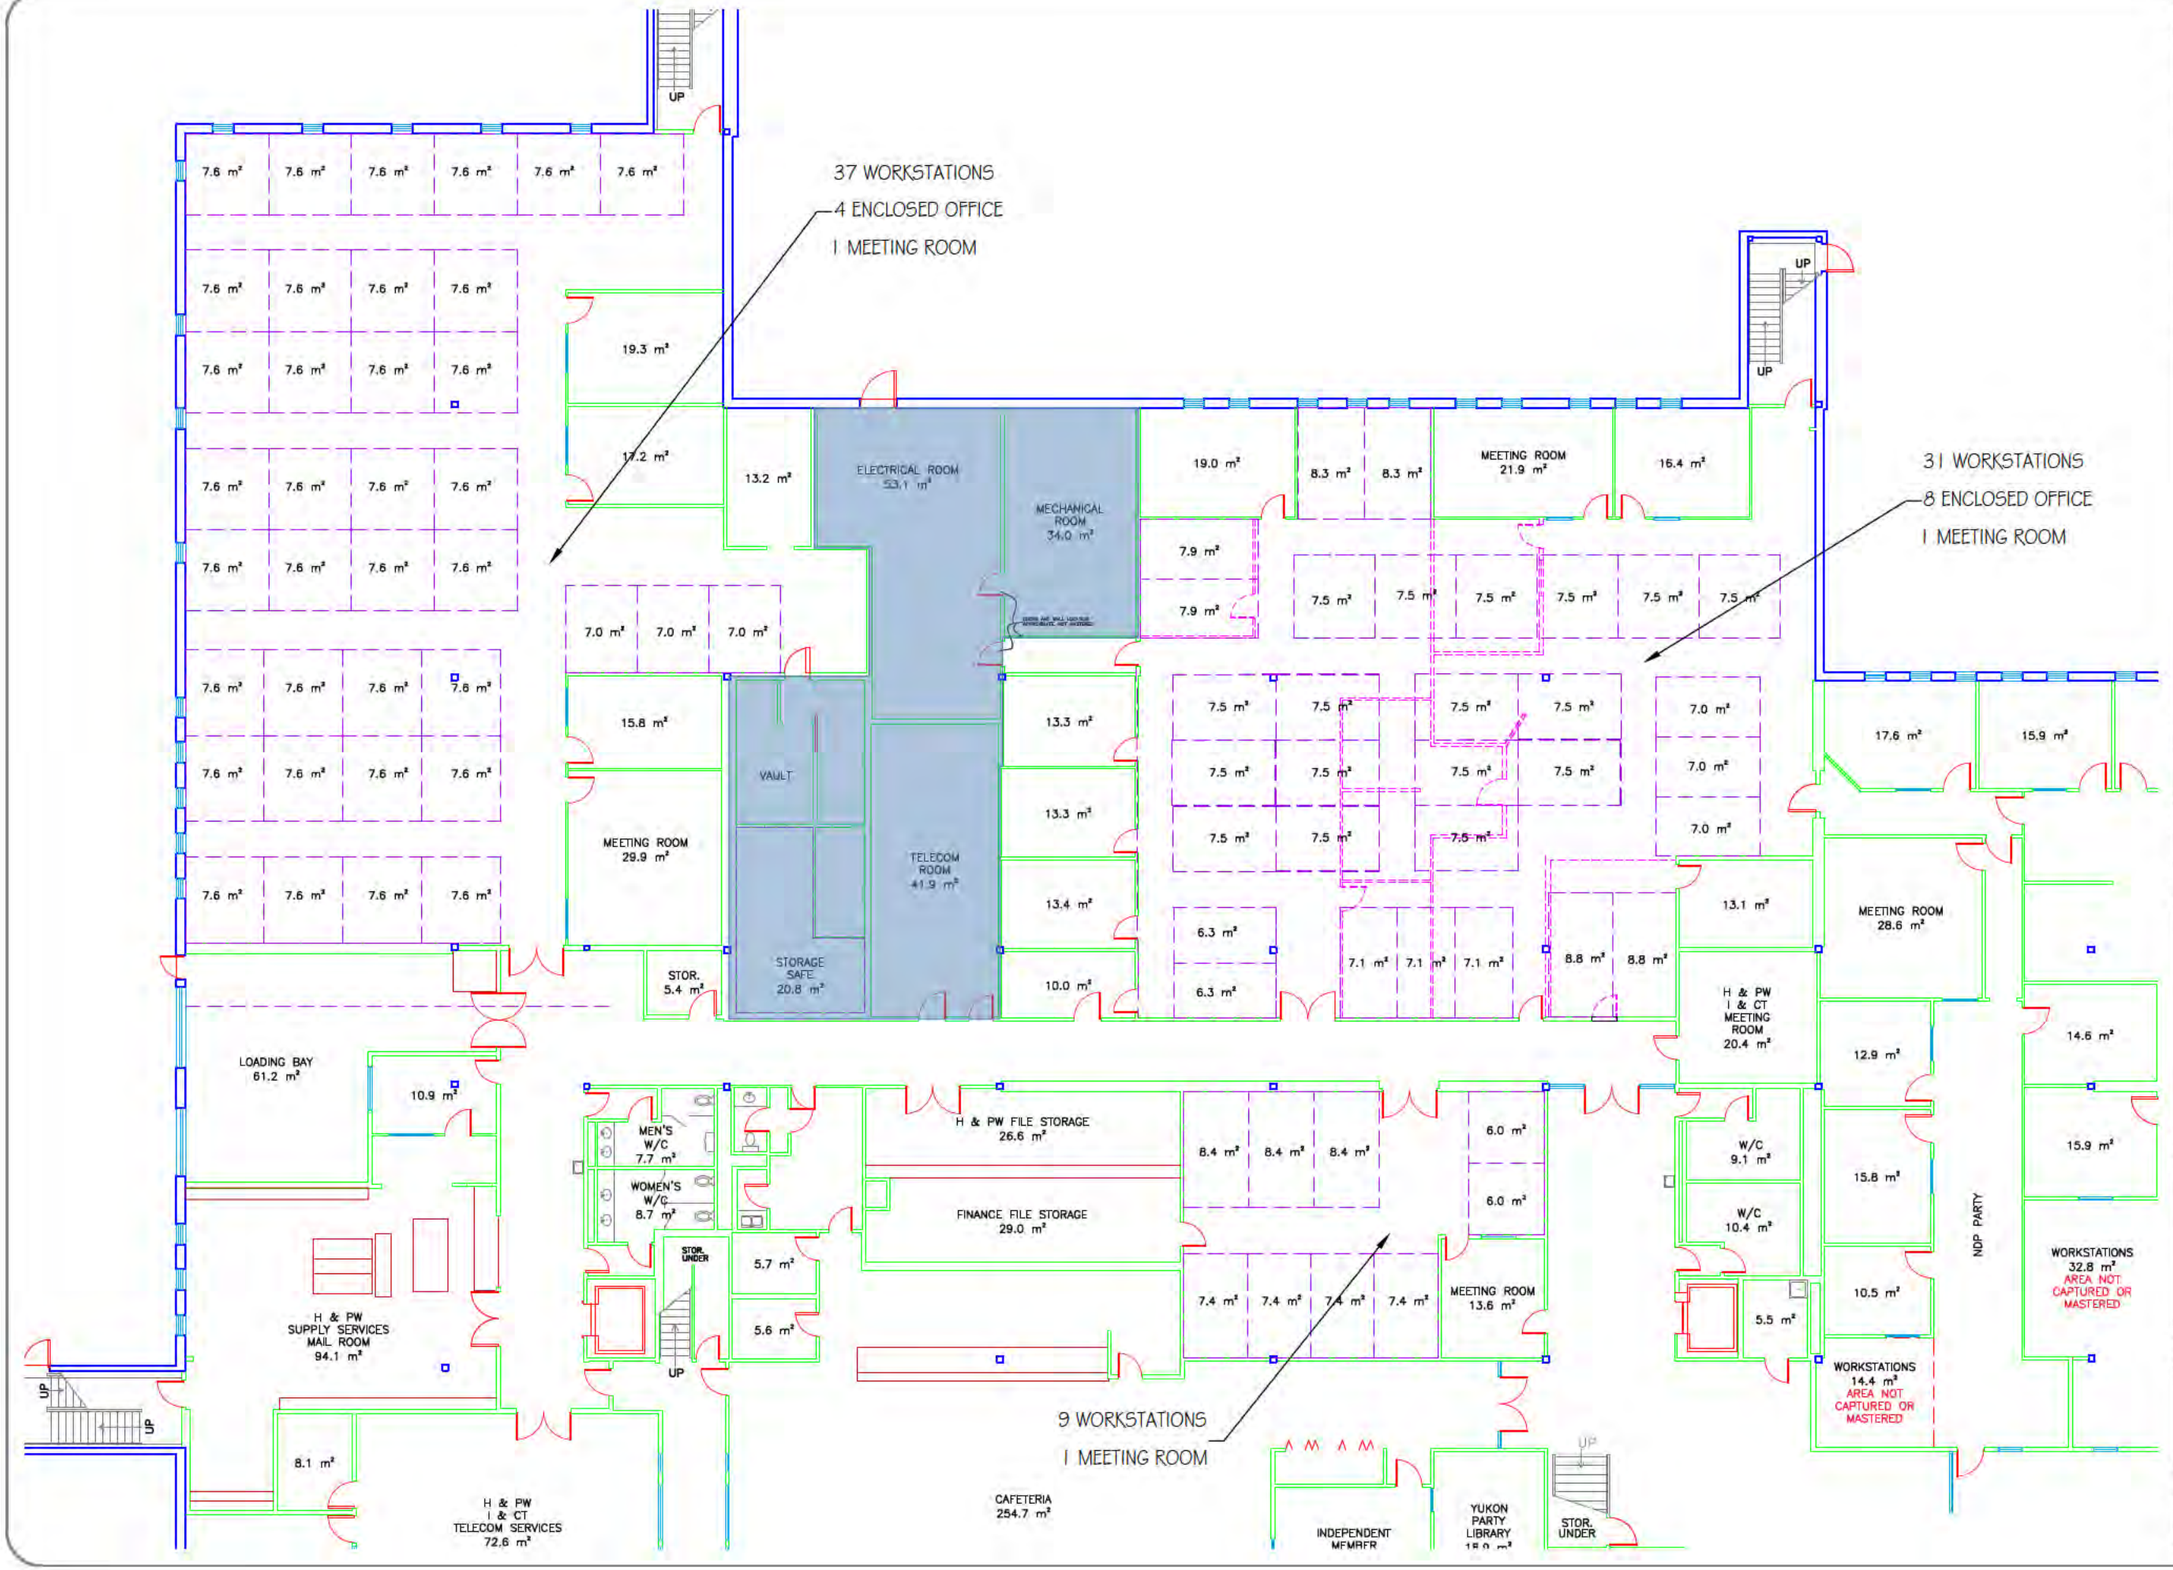

NOTES/REFERENCE DRAWINGS

LEGEND

- EXISTING INTERIOR WALL
- EXISTING EXTERIOR WALL
- GLAZING
- WORKSTATION
- BULKHEAD
- ACOUSTIC INSULATION
- EXISTING DOOR
- EXISTING CONNECTION (INCLUDES ELECTRICAL AND/OR VOICE-DATA) — V/D
- DEDICATED LIGHT SWITCH — $

ALL UNITS ARE IN MILLIMETERS UNLESS SPECIFIED

REVISIONS & ISSUES

NO.	dd/mm/yy	DESCRIPTION	BY
–	–	–	–
–	–	–	–
–	–	–	–
00	19/11/20	FOR COMMENT	–

DRAWN ME | SCALE NTS
CHK'D –

Yukon
Highways and Public Works
Property Management Division

BLDG # 1259
MAIN ADMINISTRATION BUILDING

2071 SECOND AVENUE
WHITEHORSE, YT

1st (BASEMENT) FLOOR
SPACE PANNING

Sheet 1 OF 1 | REV: 00

LEGAL

LOTS 1785 + LANE, BLK A, PLAN 19005
LOTS 1,2 + 6 TO 17 + LANES, BLK 1, PLANS 19005 & 3807
LOTS 1 TO 11 + LANES, BLK 2, PLAN 3807
PORTIONS OF HAWKINS & ROGERS ST, FIRST AVENUE AND C OF T 127 B ALL IN GROUP 804
WHITEHORSE, YUKON TERRITORY

REFERENCE

EXPROPRIATION ORDINANCE PLAN OF YUKON TERRITORY (CHAPTER 6) ~ UNDERHILL & UNDERHILL	21-9-71
SITE PLAN NEW TERRITORIAL BUILDING GOVERNMENT OF THE YUKON TERRITORY	19-1-72
Y.T.G. CAPITAL SITE EXISTING SERVICES BY CITY OF WHITEHORSE, ENGINEERING DEPT.	4-4-73
YUKON REGIONAL LIBRARY CONSTRUCTION DWGS BY JACARTER HAINNE & PARTNERS ARCHITECTS	1-6-65
YUKON REGIONAL LIBRARY & ARCHIVES ADDITION BY JACARTER HAINNE & PARTNERS ARCHITECTS	30-4-71

LEGEND

- UNFINISHED GROUND GRADED TO LEVELS SHOWN
- ASPHALT PAVING ON 4" COMPACTED GRANULAR BASE COURSE
- CONCRETE BARRIER FINISHED ON ANGLES IN ALT. PAVERS JOINED AT APPROX. 10'-0" O.C., AS PER PLANS (SEE DRAWINGS A4.1 & A5.1). ALL WALLS SHALL BE 4" CONC. ON 4" COMPACTED GRAVEL BASE REINF. WITH 6X6 W3.1 X W3.1 MESH.
- QUARRY TILE SET ON 4" REINF. CONC. SLAB (AS NOTED ABOVE).
- CONCRETE CURBS
- ORIGINAL SITE CONTOURS ~ SEE PHASE I DRAWING A100 (CONTOURS WILL BE ALTERED BY PHASE I CONTRACT WORK)
- DIRECTION OF FALL (LINE INDICATES LOWEST LEVEL)
- FINISH ELEVATION = 2084.50 FT. OR 2084'-6"
- CAR PARKING STALLS INDICATED BY LINES SHALL BE 9'-0" WIDE. LINES SHALL BE PAINTED 3" WIDE X 15'-0" LONG EA. (SEE SPEC)
- ARROWS 8'x3' PAINTED YELLOW
- EXISTING TO REMAIN. CONTRACTOR SHALL MAKE GOOD ALL DAMAGES & ALTER AS NECESSARY WHERE DETAILED.
- PROPERTY LINE. THIS CONTRACT SHALL INCLUDE CURBS, SIDEWALKS, ROADWAYS & GRADING, WHERE SHOWN, TO CONNECT WITH CITY STREETS.
- SERVICE EASEMENT - SETBACK LINE, PROPOSED

NOTES

LEVEL 1 FINISH TOP CONC. SLAB					EL 81'-6"
LEVEL 2	✓	✓	✓	✓	EL 95'-0"
LEVEL 3	✓	✓	✓	✓	EL 108'-6"
PENTHSE	✓	✓	✓	✓	EL 123'-11 5/8"

GROSS NEW BUILDING ®	131,460
EXISTING LIBRARY ®	18,790
TOTAL	150,240 S.F.
NEW BUILDING COVERAGE	47,050
EXISTING LIBRARY	16,300
TOTAL	63,350 S.F.
SITE AREA (APPROX.)	213,870 S.F.

® INCLUDES UNFINISHED STORAGE & MECHANICAL AREAS

THE CONTRACTOR SHALL BE RESPONSIBLE FOR VERIFYING ALL EXISTING DIMENSIONS & ELEVATIONS ON SITE.
REFER ALSO TO DWG M1.4 & E1 FOR MECHANICAL & ELECTRICAL SITE WORK.

FOR INFORMATION ONLY
ISSUED FOR EXTERIOR LANDSCAPING APRIL 1974.

Public Works Canada / Travaux publics Canada
Pacific Region

REVISIONS NO.	DATE	DESCRIPTION
A	24-5-74	REVISE ALL GRADING; DELETE CATCH BASINS & WEEPING TILE; ADD SAN. PIT & CURB DET.
B	28-5-76	AS BUILT
C	9/03/05	REVISION N-E WALKWAY (GRADES)

PROJECT NO. 8982.7
DATE 1 APR '74 | SCALE 1"=20'
DRAWN | CHECK
APPROVED

GOVERNMENT OF THE YUKON TERRITORY

DRAWING TITLE
SITE PLAN
PROJECT TITLE
TERRITORIAL ADMINISTRATION BUILDING
WHITEHORSE, Y.T.

DRAWING NO. A1
REVISION C

LEGAL

LOTS 1185 + LANE, BLK A, PLAN 19005
LOTS 1,2,4 & 7817 + LANES, BLK 1, PLANS 19005 & 3807
LOTS 1 TO 11 + LANES, BLK 2, PLAN 3807
PORTIONS OF HAWKINS & ROGERS ST, FIRST AVENUE AND C OF T 127 B ALL IN GROUP 804
WHITEHORSE, YUKON TERRITORY

REFERENCE

EXPROPRIATION ORDINANCE PLAN OF YUKON TERRITORY (CHAPTER 6) ~ UNDERHILL & UNDERHILL	21-9-71
SITE PLAN NEW TERRITORIAL BUILDING GOVERNMENT OF THE YUKON TERRITORY	19-1-72
Y.T.G. CAPITAL SITE EXISTING SERVICES BY CITY OF WHITEHORSE, ENGINEERING DEPT.	4-4-73
YUKON REGIONAL LIBRARY CONSTRUCTION DWGS BY MCCARTER NAIRNE & PARTNERS ARCHITECTS	1-6-65
YUKON REGIONAL LIBRARY & ARCHIVES ADDITION BY MCCARTER NAIRNE & PARTNERS ARCHITECTS	30-4-71

LEGEND

- UNFINISHED GROUND GRADED TO LEVELS SHOWN
- ASPHALT PAVING ON 4" COMPACTED GRANULAR BASECOURSE
- CONCRETE BASE FINISHED ON ANGLES IN ALT. PAVERS SCORED AT APPROX 10'-0" O.C., AS PER PLANS DWGS A4 & A5. ALL WALKS SHALL BE 4" CONC. ON 4" COMP. GRAVEL BASE REINF. WITH 6X6 W3.1 X W2.1 MESH.
- QUARRY TILE SET ON 4" MIN. CONC. SLAB (AS NOTED ABOVE).
- CONCRETE CURBS — 8"-HIGH, 12"-W
- ORIGINAL SITE CONTOURS ~ SEE PHASE 1 DRAWING A100 (CONTOURS WILL BE ALTERED BY PHASE 1 CONTRACT WORK)
- DIRECTION OF FALL (LINE INDICATES LOWEST LEVEL)
- 84.50 FINISH ELEVATION = 2084.50 FT. OR 2084'-6"
- CAR PARKING STALLS INDICATED BY LINES SHALL BE 9'-0" WIDE. LINES SHALL BE PAINTED 3" WIDE X 15'-0" LONG EA. (SEE SPEC)
- ARROWS 3'x3' PAINTED YELLOW
- EXISTING TO REMAIN. CONTRACTOR SHALL MAKE GOOD ALL DAMAGES & ALTER AS NECESSARY WHERE DETAILED.
- PROPERTY LINE. THIS CONTRACT SHALL INCLUDE CURBS, SIDEWALKS, ROADWAYS & GRADING WHERE SHOWN, TO CONNECT WITH CITY STREETS.
- SERVICE EASEMENT - SETBACK LINE, PROPOSED

NOTES

LEVEL 1 FINISH TOP CONC. SLAB					EL 81'-6"
LEVEL 2	✓	✓	✓	✓	EL 95'-0"
LEVEL 3	✓	✓	✓	✓	EL 108'-6"
PENTHSE	✓	✓	✓	✓	EL 122'-11 3/8"

GROSS NEW BUILDING ⊕	131,450
EXISTING LIBRARY ⊕	18,790
TOTAL	150,240 S.F.
NEW BUILDING COVERAGE	47,050
EXISTING LIBRARY	16,300
TOTAL	63,320 S.F.
SITE AREA (APPROX.)	213,870 S.F.

⊕ INCLUDES UNFINISHED STORAGE & MECHANICAL AREAS.

THE CONTRACTOR SHALL BE RESPONSIBLE FOR VERIFYING ALL EXISTING DIMENSIONS & ELEVATIONS ON SITE.
REFER ALSO TO DWG M/H & E1 FOR MECHANICAL & ELECTRICAL SITE WORK.

FOR INFORMATION ONLY
ISSUED FOR EXTERIOR LANDSCAPING APRIL 1976.

DRAWING NORTH 20° 39' OFF TRUE NORTH

REVISIONS		
NO.	DATE	DESCRIPTION
A	26-5-76	REVISE ALL GRADES; DELETE CATCH BASINS & WEEPING TILE; ADD SOAK PIT & CURB DET
A	28-5-76	AS BUILT
A	9/10/76	REVISION N-E WALKWAY (GRADES)

Public Works Travaux publics Canada Canada Pacific Region

PROJECT NO. 8983.7
DATE 1 APR '74 | SCALE 1" = 20'
DRAWN | CHECK
APPROVED

GOVERNMENT OF THE YUKON TERRITORY

DRAWING TITLE
SITE PLAN
PROJECT TITLE
TERRITORIAL ADMINISTRATION BUILDING
WHITEHORSE, Y.T.

DRAWING NO. A1
REVISED A

ARCHITECTURAL DRAWINGS:

A01 TITLE SHEET
A02 LIST OF DOCUMENTS
A1 SITE PLAN
A2 EAST AND WEST ELEVATIONS
A3 NORTH & SOUTH ELEVATIONS
A4 LEVEL 1 WEST PLAN
A5 " 1 EAST "
A6 " 2 WEST "
A7 " 2 EAST "
A8 " 3 WEST "
A9 " 3 EAST "
A10 MECHANICAL PENTHOUSE FLOOR & ROOF PLANS
A11 BUILDING SECTIONS
A12 " "
A13 " "
A14 " "
A15 STAIR DETAILS
A16 WALL SECTIONS & DETAILS
A17 " " & "
A18 " " & "
A19 PLAN DETAILS
A20 ELEVATOR SHAFT & MISCELLANEOUS DETAILS
A21 MILLWORKS & MISCELLANEOUS DETAILS
A22 COUNCIL CHAMBER SECTIONS & DETAILS
A23 ROOM PLANS ELEVATIONS DETAILS
A24 SITE DETAILS
A25 REFLECTED CEILING PLAN LEVEL 1 WEST
A26 " " " " 1 EAST
A27 " " " " 2 WEST
A28 " " " " 2 EAST
A29 " " " " 3 WEST
A30 DOOR SCHEDULE & DETAILS
A31 FINISH SCHEDULE
A32 " "
A33 " "

STRUCTURAL DRAWINGS:

S1 FOUNDATION PLAN
S2 FOUNDATION DETAILS
S3 LEVEL 1
S4 LEVEL 2 FRAMING
S5 LEVEL 3 FRAMING
S6 PENTHOUSE FLOOR & MAIN ROOF PLAN
S7 PENTHOUSE ROOF
S8 WALL BRACING
S9 STAIR SHEET 1
S10 " " 2

MECHANICAL DRAWINGS:

M1 PIPING SCHEMATICS
M2 PENTHOUSE MECHANICAL ROOM PLAN & SECTION
M3 " " " SECTIONS
M4 COUNCIL " " PLAN & SECTIONS
M5 LEVEL 1 EAST - HEATING & AIR CONDITIONING
M6 " 1 WEST - " " " "
M7 " 2 EAST - " " " "
M8 " 2 WEST - " " " "
M9 " 3 EAST - " " " "
M10 HEATING & AIR CONDITIONING DETAIL SHEET 1
M11 " & " " " " 2
M12 " & " " " " 3
M13 " & " " " " 4
M14 SITE PLAN & LEGEND - PLUMBING
M15 LEVEL 1 EAST - FOUNDATION PLUMBING
M16 " 1 WEST - " "
M17 " 1 EAST - PLUMBING & SPRINKLERS
M18 " 1 WEST - " & "
M19 " 2 EAST - " & "
M20 " 2 WEST - " & "
M21 " 3 EAST - " & "
M22 PENTHOUSE MECHANICAL ROOM LAYOUT - PLUMBING & SPRINKLERS
M23 SCHEMATICS & DETAILS - PLUMBING
M24 RISER DIAGRAM & DETAILS - PLUMBING

ELECTRICAL DRAWINGS:

E1 ELECTRICAL - SITE PLAN & LEGEND
E2 ELECTRICAL - LEVEL ONE WEST - LIGHTING
E3 ELECTRICAL - LEVEL ONE EAST - LIGHTING
E4 " - " ONE WEST - POWER
E5 " - " ONE EAST - POWER
E6 " - " TWO WEST - LIGHTING
E7 " - " TWO EAST - "
E8 " - " " WEST - POWER
E9 " - " TWO EAST - POWER
E10 " - " THREE - LIGHTING
E11 " - " " - POWER
E12 " - PENTHOUSE LIGHTING & POWER
E13 " - PANEL SCHEDULES
E14 " - " "
E15 " - " " - EXTERIOR
E16 " - SECTIONS
E17 " - SINGLE LINE DIAGRAM PART 1
E18 " - SINGLE LINE DIAGRAM PART 2
E19 " - COMMUNICATIONS RISER DIAGRAMS
E20 " - DISTRIBUTION RISER & MOTOR SCHEDULE
E21 " - OUTDOOR LIGHTING & POWER
E22 " - SIDEWALK HEATING
E23 " - OUTDOOR DETAILS
E24 " - DETAILS


APPENDIX - DRAWINGS FOR INFORMATION ONLY (N.I.C.):

A100 PHASE 1 EXCAVATION
S100 " 1 CONCRETE SUBSTRUCTURE

SPECIFICATIONS)
BIDDING REQUIREMENTS)
CONTRACT FORMS)
GENERAL CONDITIONS) BOUND UNDER SEPARATE COVER
APPENDIX - PHASE 1 EXCAVATION & SUBSTRUCTURE SPECIFICATIONS)
- STRUCTURAL STEEL & STEEL DECKING PRETENDER SPECIFICATIONS)

END

DETAIL SYMBOL

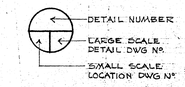

Public Works Canada / Travaux publics Canada
Pacific Region

REVISIONS

NO.	DATE	DESCRIPTION

PROJECT NO. 8985 7
DATE 1 APR '74 | SCALE ~
DRAWN | CHECK
APPROVED

GOVERNMENT OF THE YUKON TERRITORY

DRAWING TITLE
CONTRACT DOCUMENT LIST

PROJECT TITLE
TERRITORIAL ADMINISTRATION BUILDING
WHITEHORSE, Y. T.

DRAWING NO.
A02

ARCHITECTURAL DRAWINGS:

A01 TITLE SHEET
A02 LIST OF DOCUMENTS
A1 SITE PLAN
A2 EAST AND WEST ELEVATIONS
A3 NORTH & SOUTH ELEVATIONS
A4 LEVEL 1 WEST PLAN
A5 " 1 EAST "
A6 " 2 WEST "
A7 " 2 EAST "
A8 " 3 WEST "
A9 " 3 EAST "
A10 MECHANICAL PENTHOUSE FLOOR & ROOF PLANS
A11 BUILDING SECTIONS
A12 " "
A13 " "
A14 " "
A15 STAIR DETAILS
A16 WALL SECTIONS & DETAILS
A17 " " & "
A18 " " & "
A19 PLAN DETAILS
A20 ELEVATOR SHAFT & MISCELLANEOUS DETAILS
A21 MILLWORKS & MISCELLANEOUS DETAILS
A22 COUNCIL CHAMBER SECTIONS & DETAILS
A23 ROOM PLANS ELEVATIONS DETAILS
A24 SITE DETAILS
A25 REFLECTED CEILING PLAN LEVEL 1 WEST
A26 " " " " 1 EAST
A27 " " " " 2 WEST
A28 " " " " 2 EAST
A29 " " " " 3 WEST
A30 DOOR SCHEDULE & DETAILS
A31 FINISH SCHEDULE
A32 " "
A33 " "

STRUCTURAL DRAWINGS:

S1 FOUNDATION PLAN
S2 FOUNDATION DETAILS
S3 LEVEL 1
S4 LEVEL 2 FRAMING
S5 LEVEL 3 FRAMING
S6 PENTHOUSE FLOOR & MAIN ROOF PLAN
S7 PENTHOUSE ROOF
S8 WALL BRACING
S9 STAIR SHEET 1
S10 " " 2

MECHANICAL DRAWINGS:

M1 PIPING SCHEMATICS
M2 PENTHOUSE MECHANICAL ROOM PLAN & SECTION
M3 " " " SECTIONS
M4 COUNCIL " " PLAN & SECTIONS
M5 LEVEL 1 EAST - HEATING & AIR CONDITIONING
M6 " 1 WEST - " " " "
M7 " 2 EAST - " " " "
M8 " 2 WEST - " " " "
M9 " 3 EAST - " " " "
M10 HEATING & AIR CONDITIONING DETAIL SHEET 1
M11 " & " " " " 2
M12 " & " " " " 3
M13 " & " " " " 4
M14 SITE PLAN & LEGEND - PLUMBING
M15 LEVEL 1 EAST - FOUNDATION PLUMBING
M16 " 1 WEST - " "
M17 " 1 EAST - PLUMBING & SPRINKLERS
M18 " 1 WEST - " & "
M19 " 2 EAST - " & "
M20 " 2 WEST - " & "
M21 " 3 EAST - " & "
M22 PENTHOUSE MECHANICAL ROOM LAYOUT - PLUMBING & SPRINKLERS
M23 SCHEMATICS & DETAILS - PLUMBING
M24 RISER DIAGRAM & DETAILS - PLUMBING

ELECTRICAL DRAWINGS:

E1 ELECTRICAL - SITE PLAN & LEGEND
E2 ELECTRICAL - LEVEL ONE WEST - LIGHTING
E3 ELECTRICAL - LEVEL ONE EAST - LIGHTING
E4 " - " ONE WEST - POWER
E5 " - " ONE EAST - POWER
E6 " - " TWO WEST - LIGHTING
E7 " - " TWO EAST - "
E8 " - " " WEST - POWER
E9 " - " TWO EAST - POWER
E10 " - " THREE - LIGHTING
E11 " - " " - POWER
E12 " - PENTHOUSE LIGHTING & POWER
E13 " - PANEL SCHEDULES
E14 " - " "
E15 " - " " - EXTERIOR
E16 " - SECTIONS
E17 " - SINGLE LINE DIAGRAM PART 1
E18 " - SINGLE LINE DIAGRAM PART 2
E19 " - COMMUNICATIONS RISER DIAGRAMS
E20 " - DISTRIBUTION RISER & MOTOR SCHEDULE
E21 " - OUTDOOR LIGHTING & POWER
E22 " - SIDEWALK HEATING
E23 " - OUTDOOR DETAILS
E24 " - DETAILS


APPENDIX - DRAWINGS FOR INFORMATION ONLY (N.I.C.):

A100 PHASE 1 EXCAVATION
S100 " 1 CONCRETE SUBSTRUCTURE

SPECIFICATIONS)
BIDDING REQUIREMENTS)
CONTRACT FORMS)
GENERAL CONDITIONS) BOUND UNDER SEPARATE COVER
APPENDIX - PHASE 1 EXCAVATION & SUBSTRUCTURE SPECIFICATIONS)
- STRUCTURAL STEEL & STEEL DECKING PRETENDER SPECIFICATIONS)

END

DETAIL SYMBOL

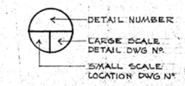

Public Works Canada Travaux publics Canada
Pacific Region

REVISIONS

NO.	DATE	DESCRIPTION


PROJECT NO. 89857
DATE 1 APR '74
SCALE ~
DRAWN
CHECK
APPROVED

GOVERNMENT OF THE YUKON TERRITORY

DRAWING TITLE
CONTRACT DOCUMENT LIST

PROJECT TITLE
TERRITORIAL ADMINISTRATION BUILDING
WHITEHORSE, Y. T.

DRAWING NO.
A02

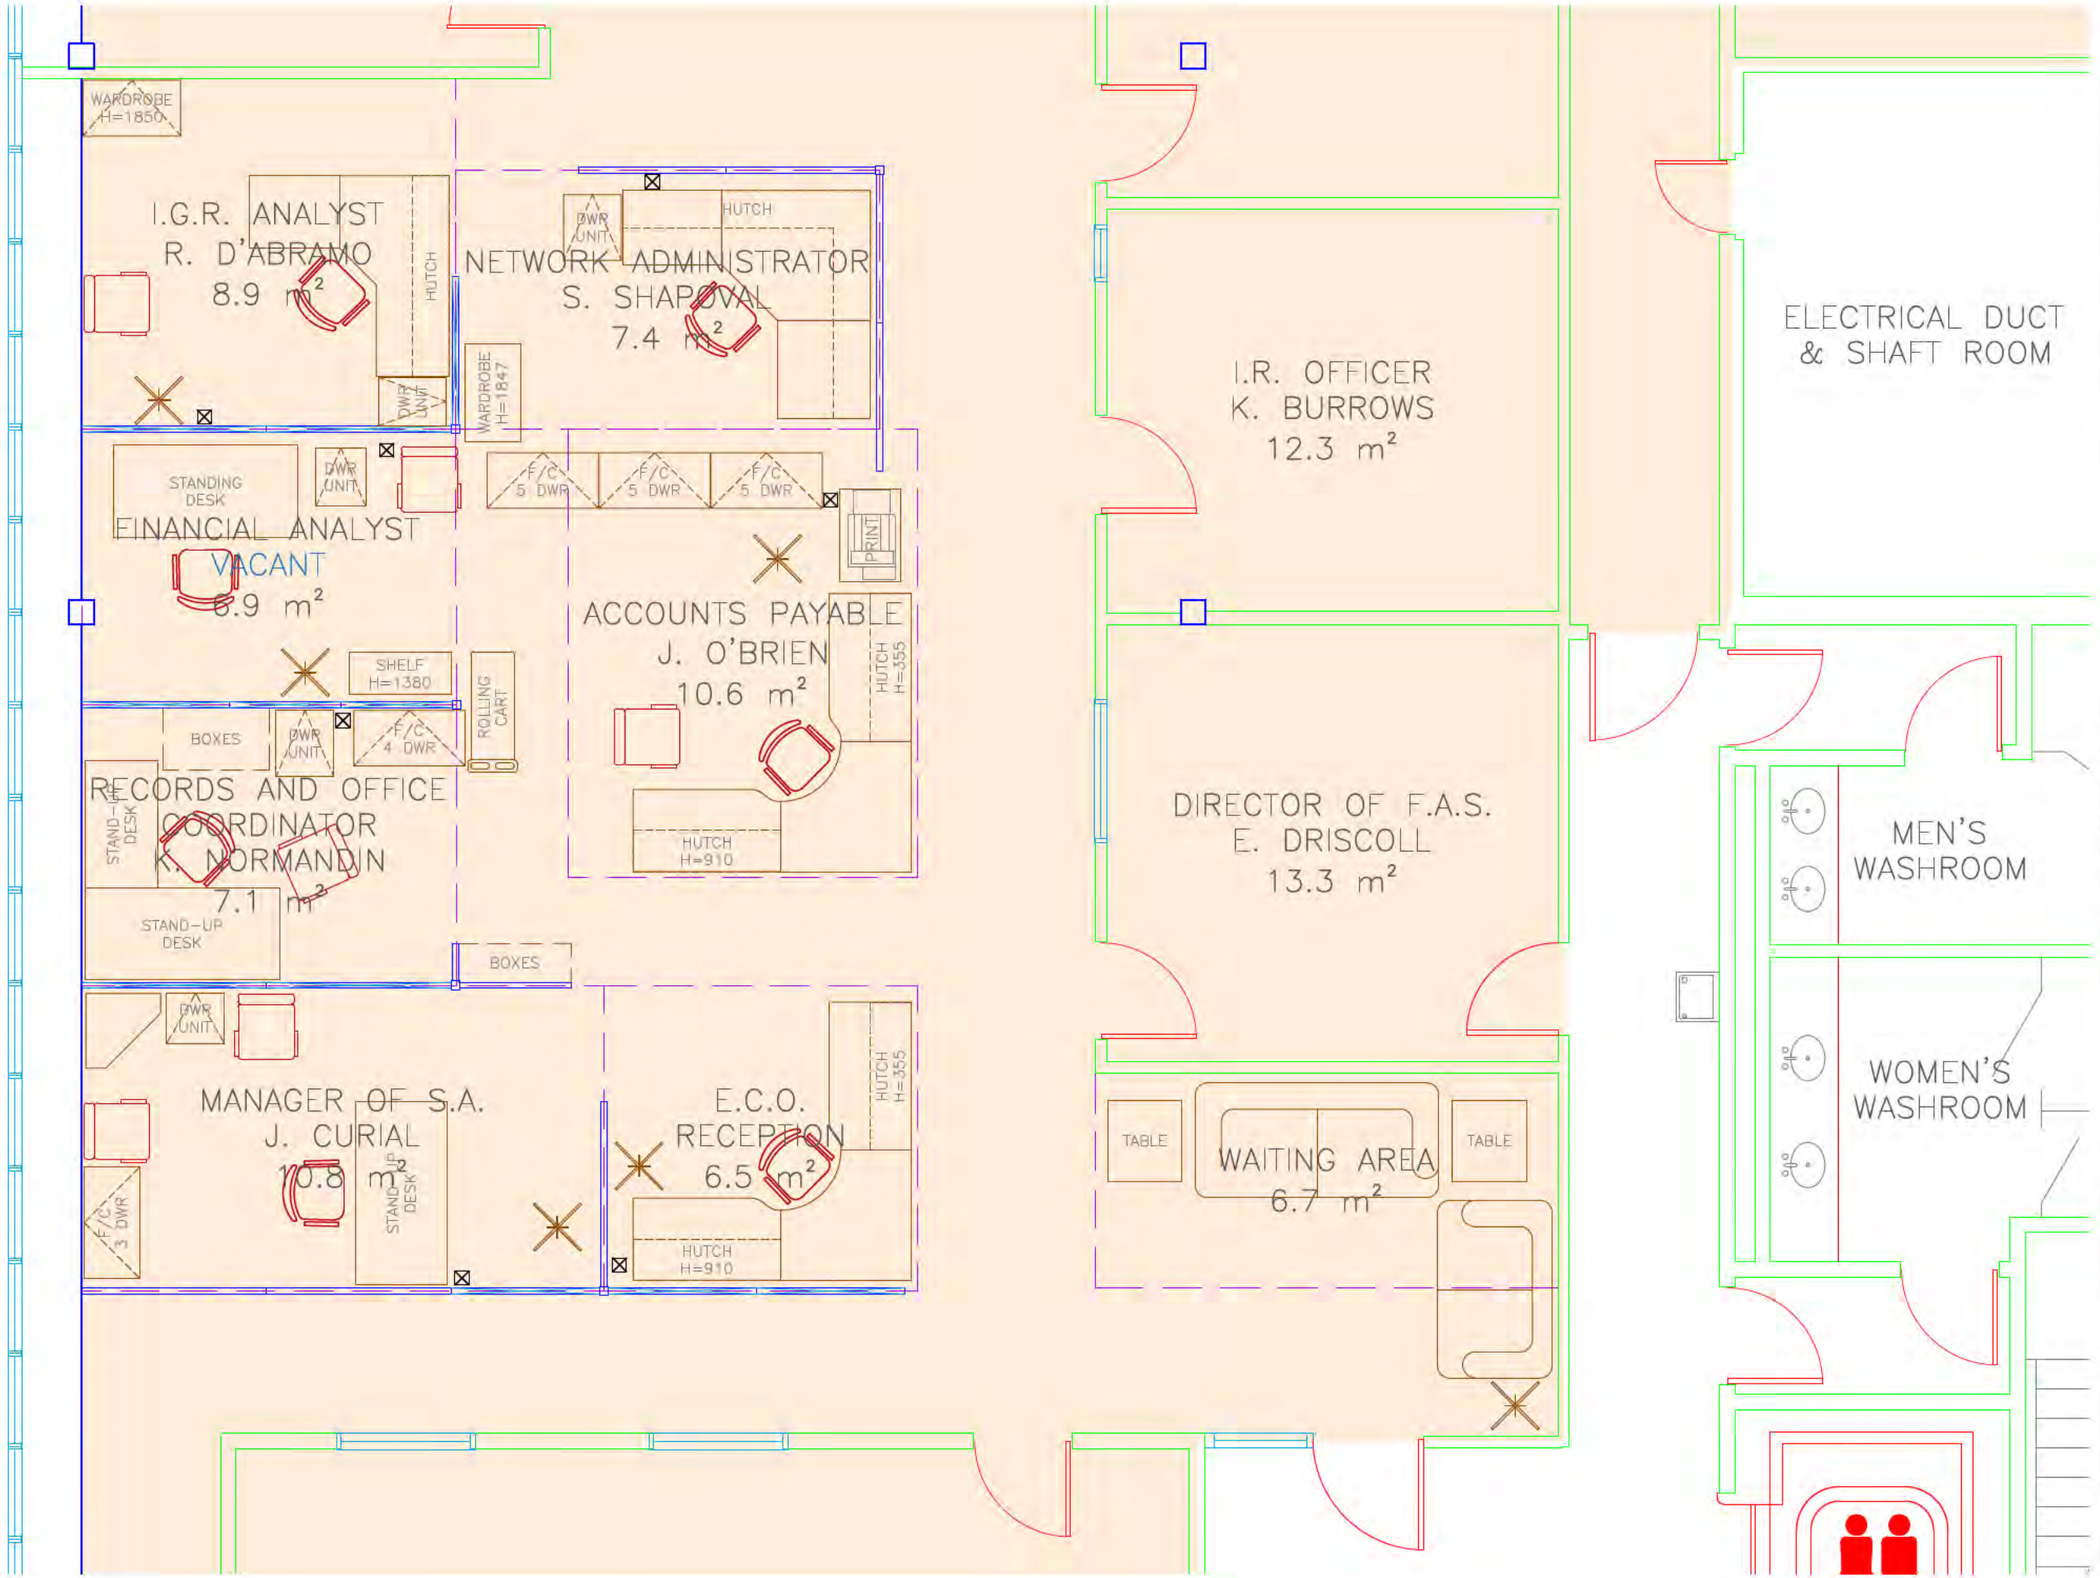

NOTES/REFERENCE DRAWINGS

LEGEND

- EXISTING INTERIOR WALL
- EXISTING EXTERIOR WALL
- GLAZING
- WORKSTATION
- BULKHEAD
- ACOUSTIC INSULATION
- EXISTING DOOR
- EXISTING CONNECTION (INCLUDES ELECTRICAL AND/OR VOICE-DATA)
- DEDICATED LIGHT SWITCH

EXECUTIVE COUNCIL OFFICES

ALL UNITS ARE IN MILLIMETERS UNLESS SPECIFIED

REVISIONS & ISSUES

NO.	yy/mm/dd	DESCRIPTION	BY
–	–/–/–	–	–
–	–/–/–	–	–
01	19/01/22	POSITIONS UPDATED	ME

DRAWN: ME
CHK'D: –
SCALE: NTS

Yukon
Highways and Public Works
Property Management Division

BLDG # 1259
MAIN ADMINISTRATION BUILDING


2071 SECOND AVENUE
WHITEHORSE, YT

2nd FLOOR PLAN:
ECO SPACE

EXISTING LAYOUT

Sheet 1 OF 4

REV. 01

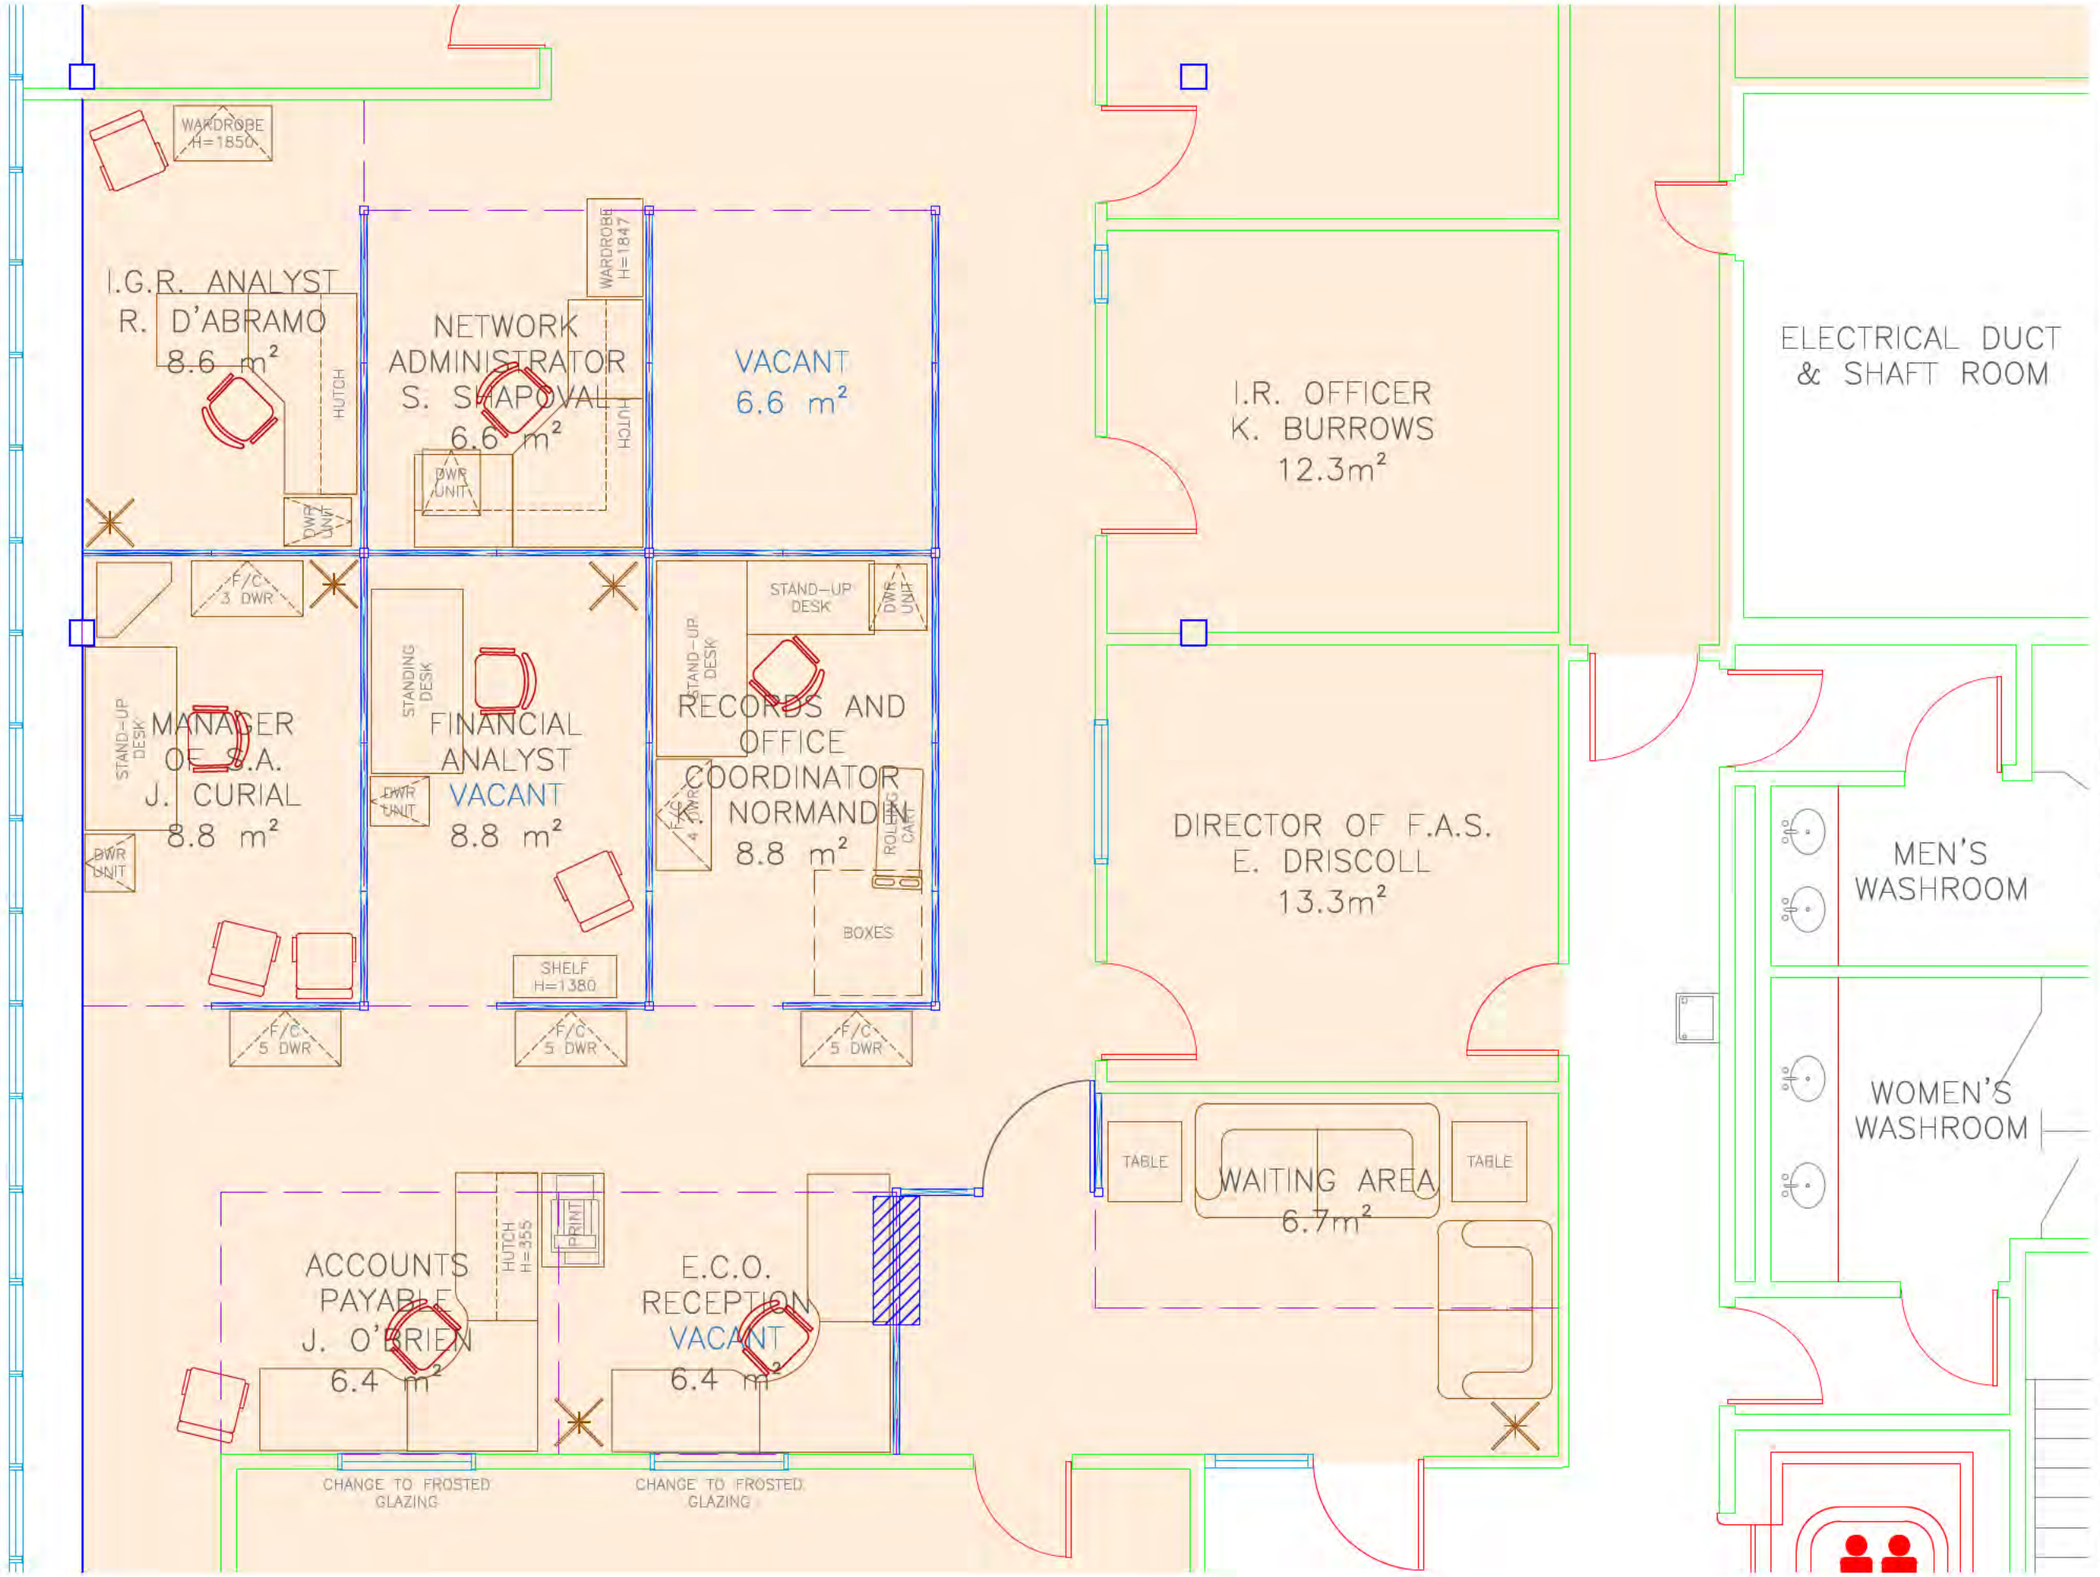

NOTES/REFERENCE DRAWINGS

LEGEND

- EXISTING INTERIOR WALL
- EXISTING EXTERIOR WALL
- GLAZING
- WORKSTATION
- BULKHEAD
- ACOUSTIC INSULATION
- EXISTING DOOR
- EXISTING CONNECTION (INCLUDES ELECTRICAL AND/OR VOICE-DATA) V/D
- DEDICATED LIGHT SWITCH S

EXECUTIVE COUNCIL OFFICES

ALL UNITS ARE IN MILLIMETERS UNLESS SPECIFIED

REVISIONS & ISSUES

NO.	yy/mm/dd	DESCRIPTION	BY
–	--/--/--	–	–
–	19/02/20	FOR APPROVAL	ME
01	19/01/22	POSITIONS UPDATED	ME

DRAWN ME | SCALE NTS
CHK'D –

Yukon
Highways and Public Works
Property Management Division

BLDG # 1259
MAIN ADMINISTRATION BUILDING


2071 SECOND AVENUE
WHITEHORSE, YT

2nd FLOOR PLAN:
ECO SPACE

PROPOSED LAYOUT

Sheet 2 OF 4

REV. 01

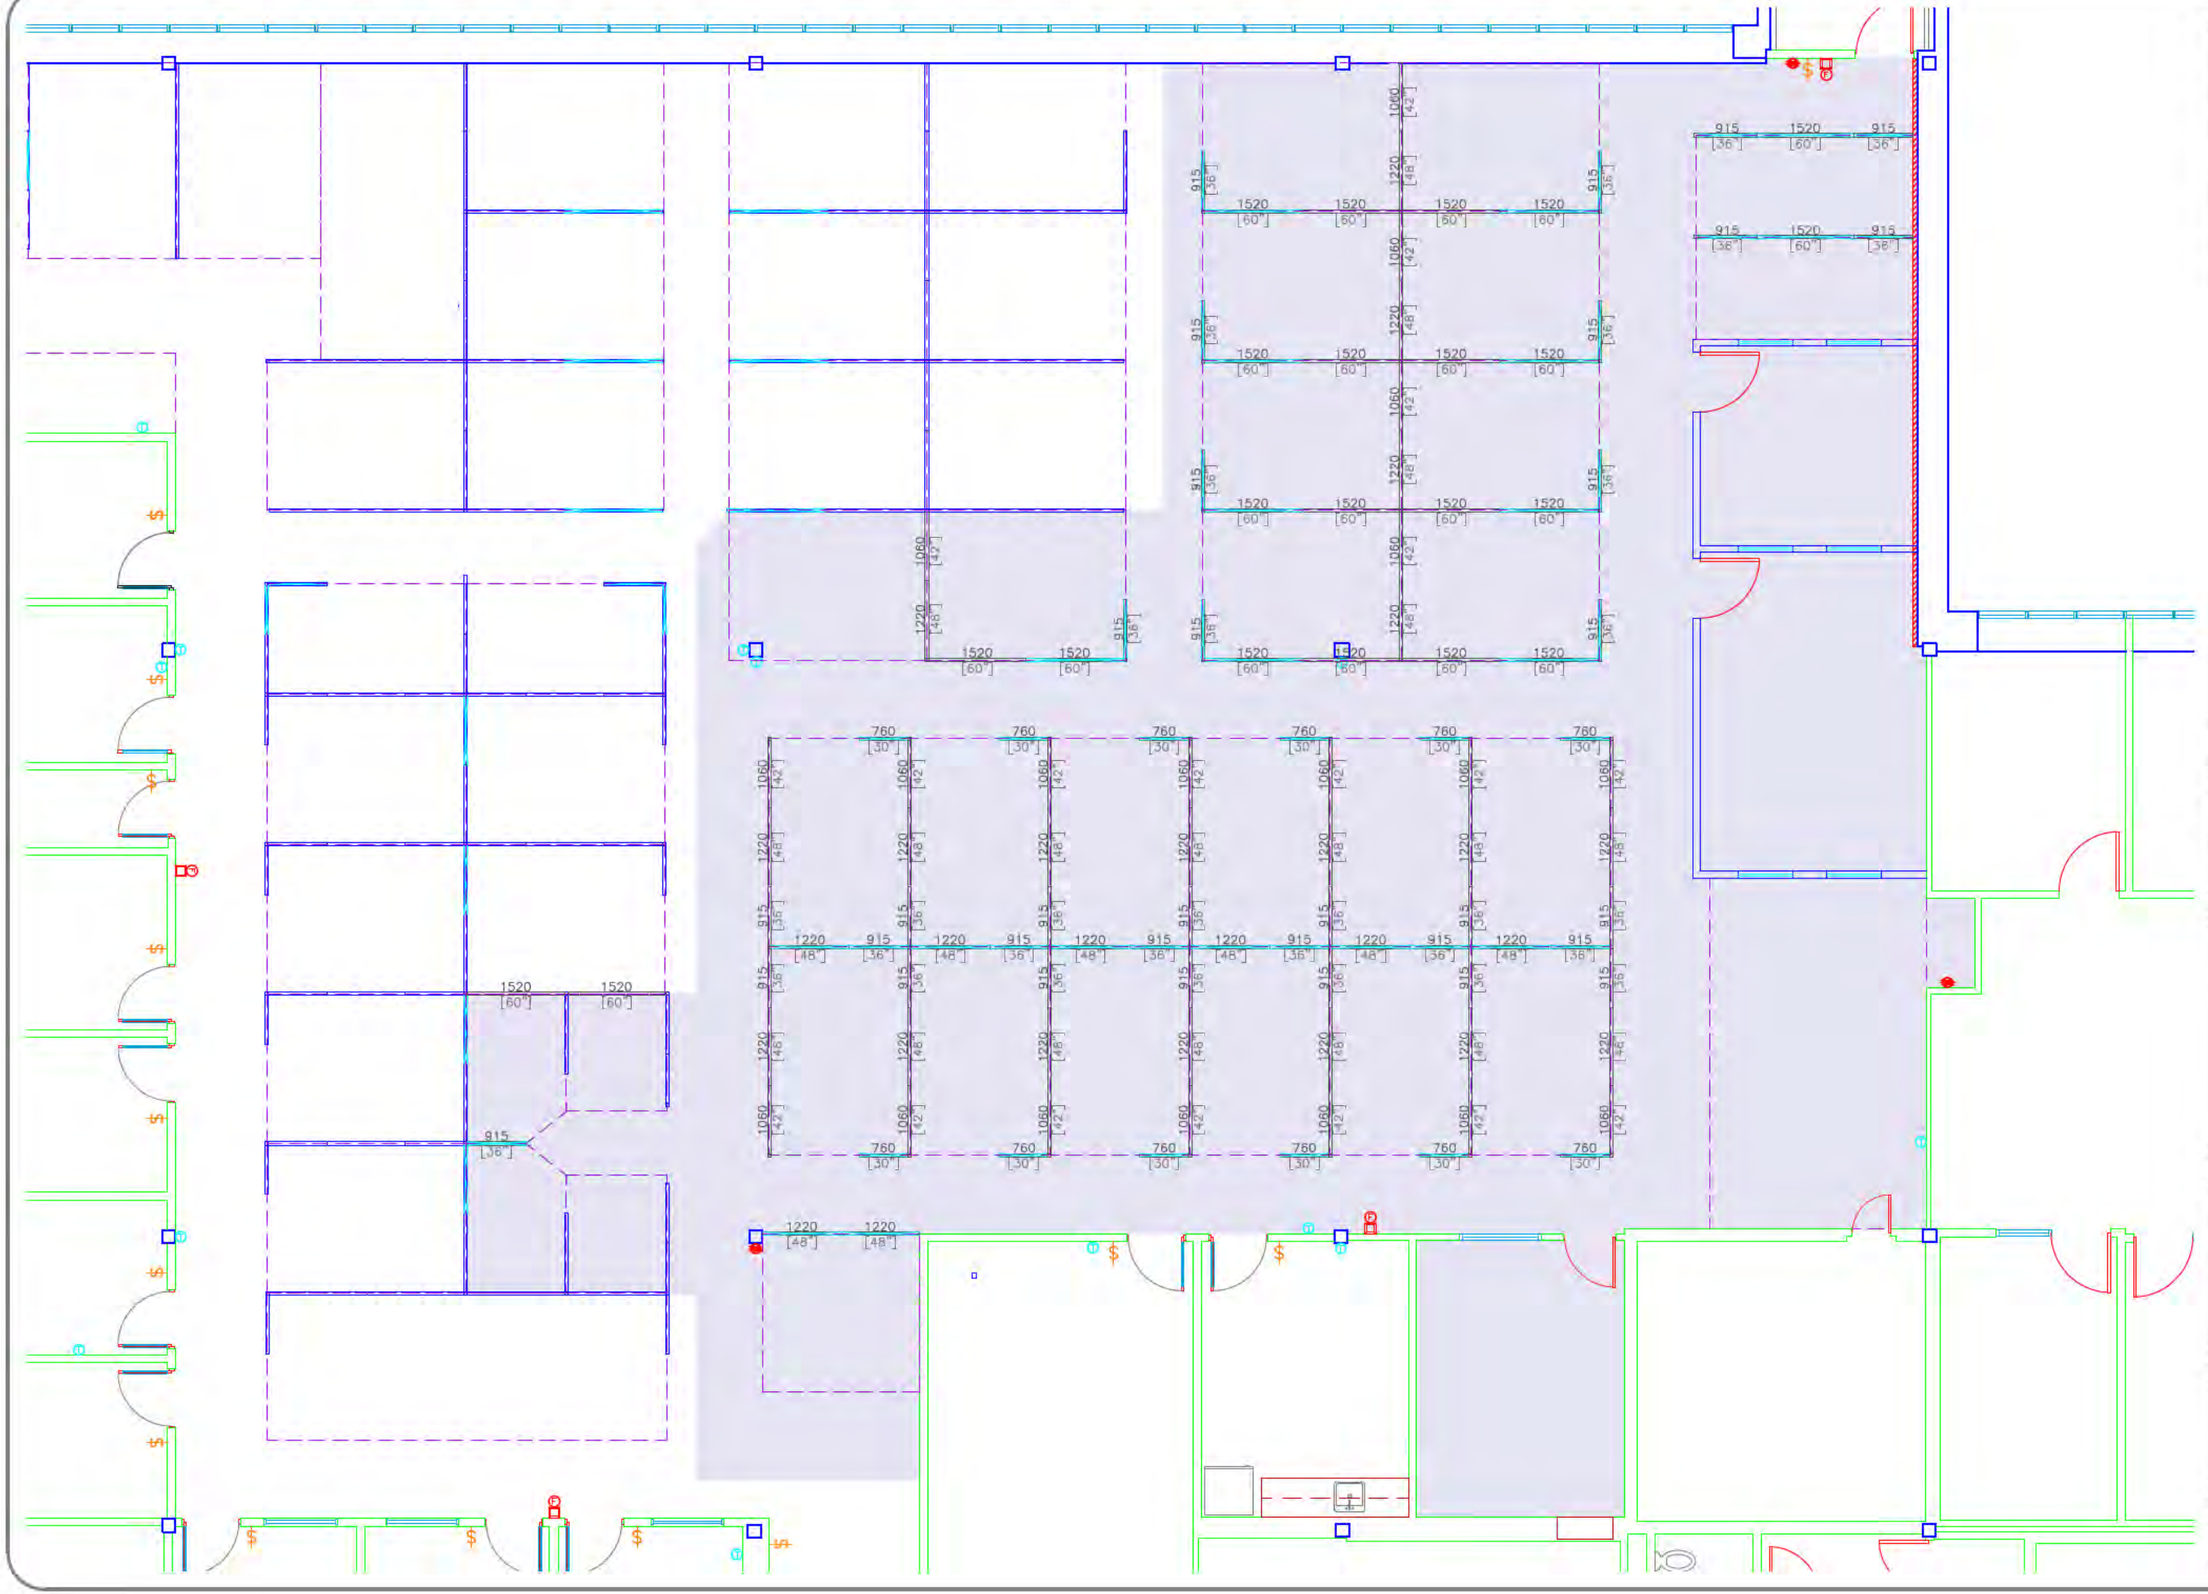

NOTES/REFERENCE DRAWINGS

LEGEND

EXISTING PARTITIONS

NEW PARTITIONS

GLAZING

DEMOLITION

AREA OF CHANGE

ALL UNITS ARE IN MILLIMETERS UNLESS SPECIFIED

REVISIONS & ISSUES

NO.	dd/mm/yy	DESCRIPTION	BY
–	--/--/--	–	–
–	--/--/--	–	–
00	14/12/2018	FOR APPROVAL	ME

DRAWN ME

CHK'D –

SCALE NTS

Yukon

Highways and Public Works
Property Management Division

BLDG # 1259
MAIN ADMINISTRATION BUILDING


2071 SECOND AVENUE
WHITEHORSE, YT

2nd FLOOR PLAN:

PROPOSED PSC SPACE
OPTION 1B

Sheet 1 OF 1

REV. 00

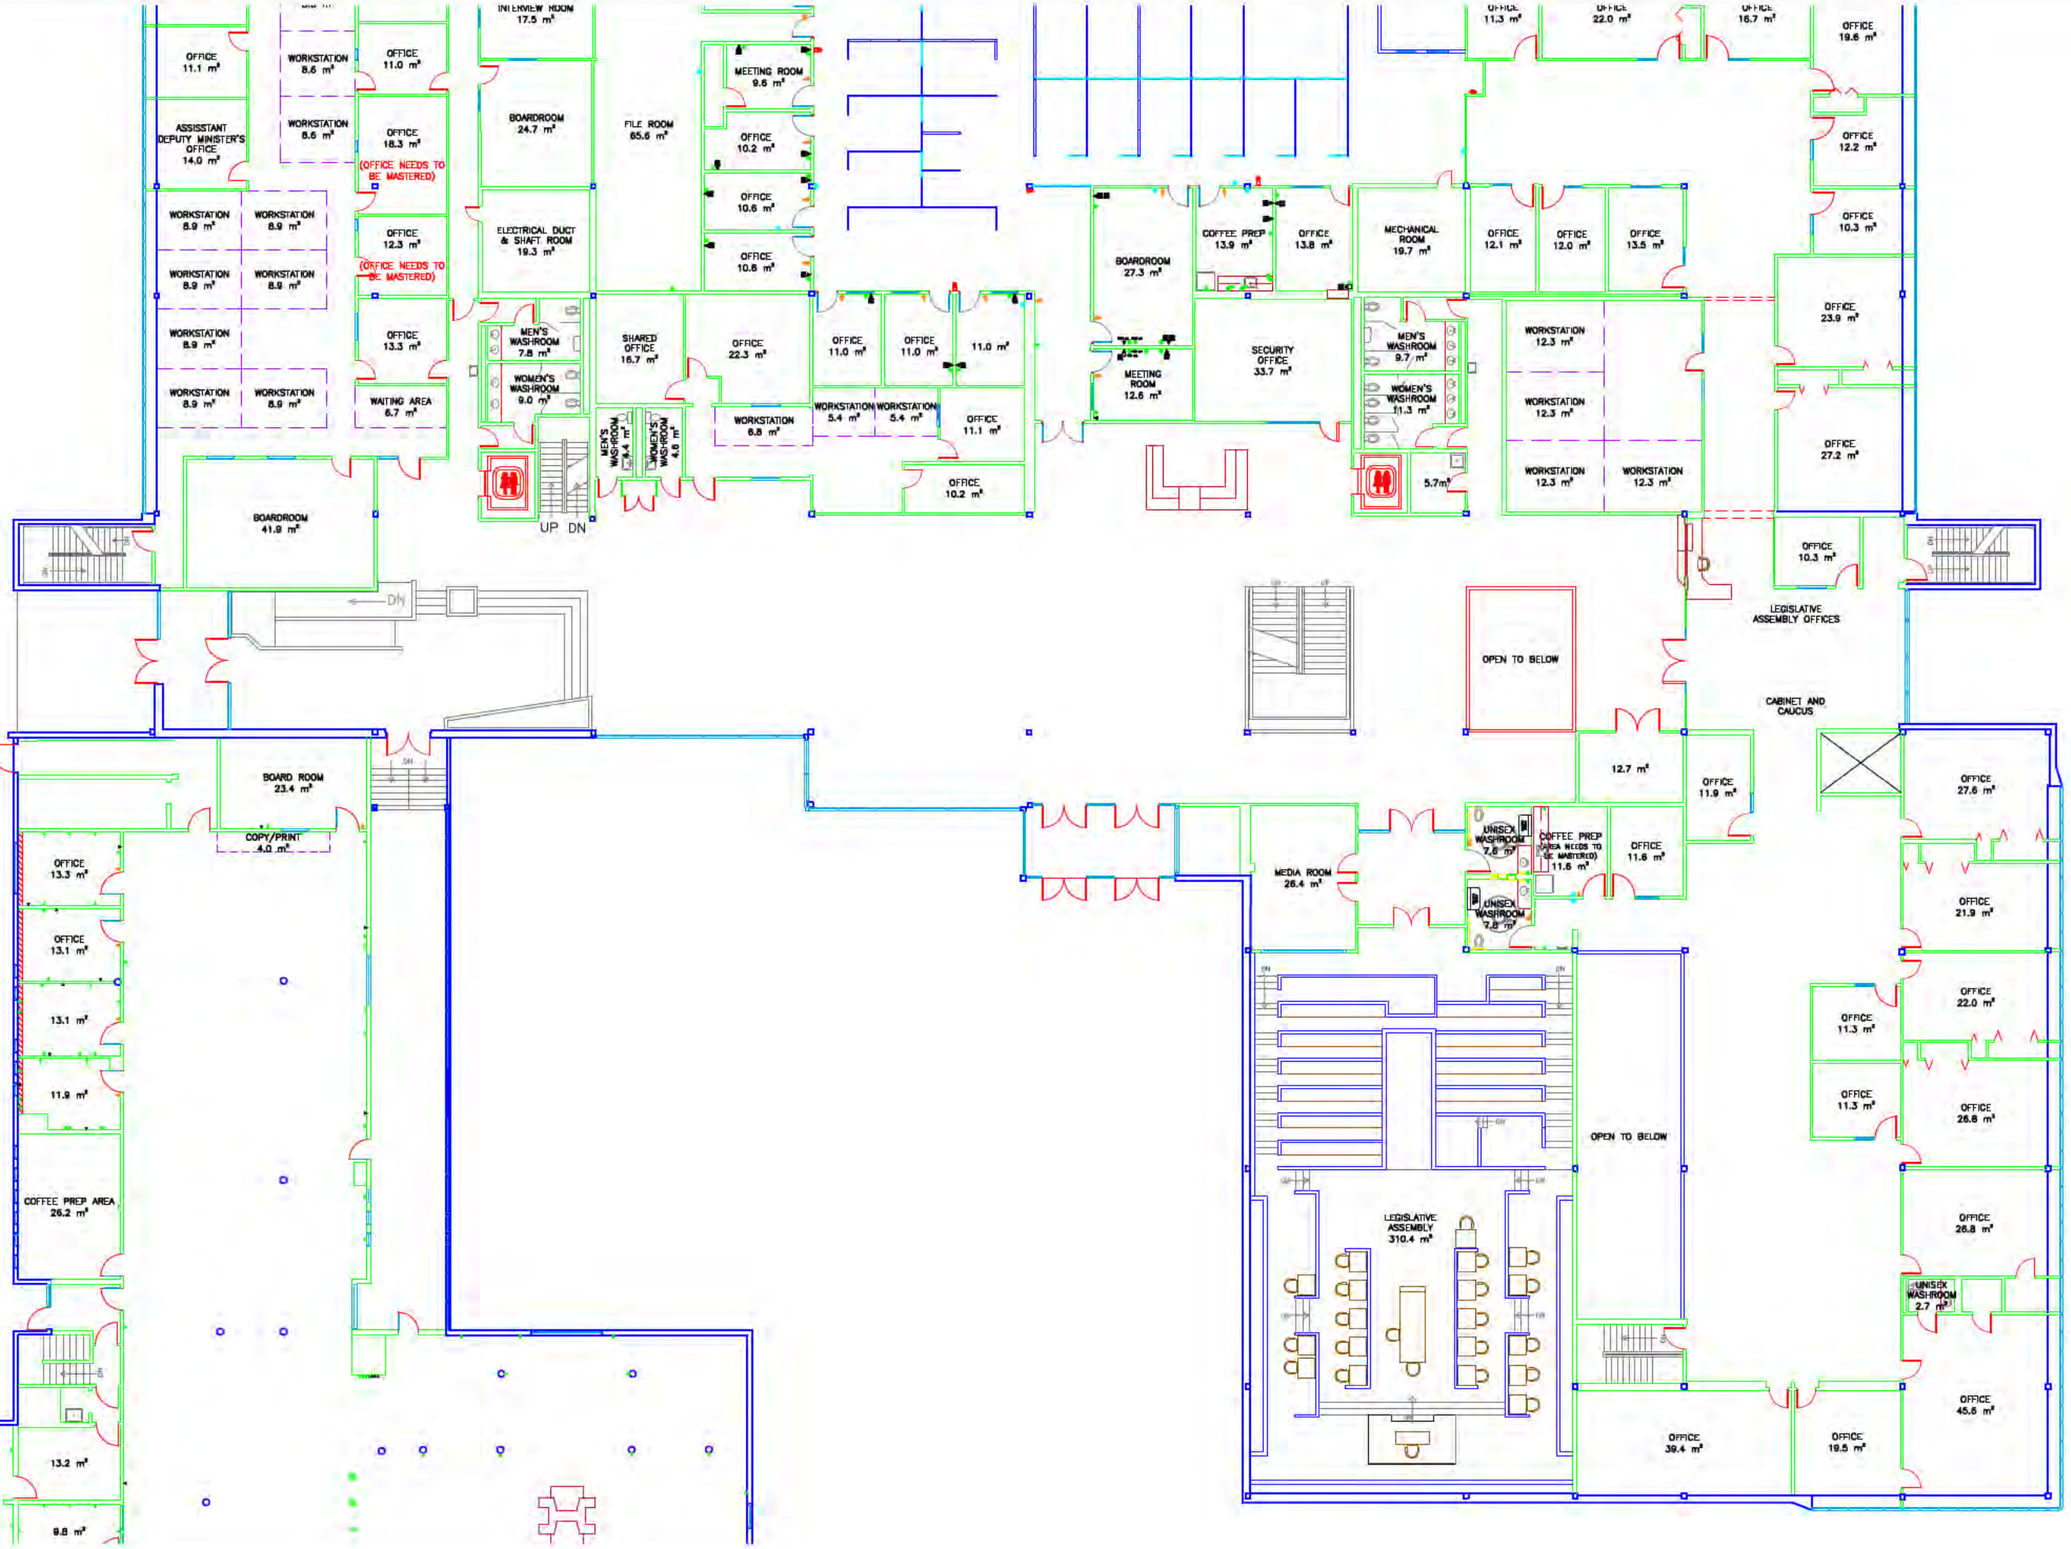

NOTES/REFERENCE DRAWINGS

LEGEND

- EXISTING INTERIOR WALL
- EXISTING EXTERIOR WALL
- GLAZING
- WORKSTATION
- BULKHEAD
- ACOUSTIC INSULATION
- EXISTING DOOR
- EXISTING CONNECTION (INCLUDES ELECTRICAL AND/OR VOICE-DATA) V/D
- DEDICATED LIGHT SWITCH $
- WASHROOMS
- VERTICAL PENETRATION
- ENTRYWAY
- MECHANICAL
- EXECUTIVE COUNCIL OFFICES
- PUBLIC SERVICE COMMISSION
- HIGHWAYS & PUBLIC WORKS
- LEGISLATURE

ALL UNITS ARE IN MILLIMETERS UNLESS SPECIFIED

REVISIONS & ISSUES

NO	dd/mm/yy	DESCRIPTION	BY
01	15/06/18	MASTERED	CS
00	--/08/09	REVISED	–

DRAWN: ME
CHK'D: –
SCALE: NTS

Yukon
Highways and Public Works
Property Management Division

BLDG # 1259
MAIN ADMINISTRATION BUILDING


2071 SECOND AVENUE
WHITEHORSE, YT

2nd FLOOR PLAN WEST SIDE:

MASTER

Sheet 1 OF 1

REV 00

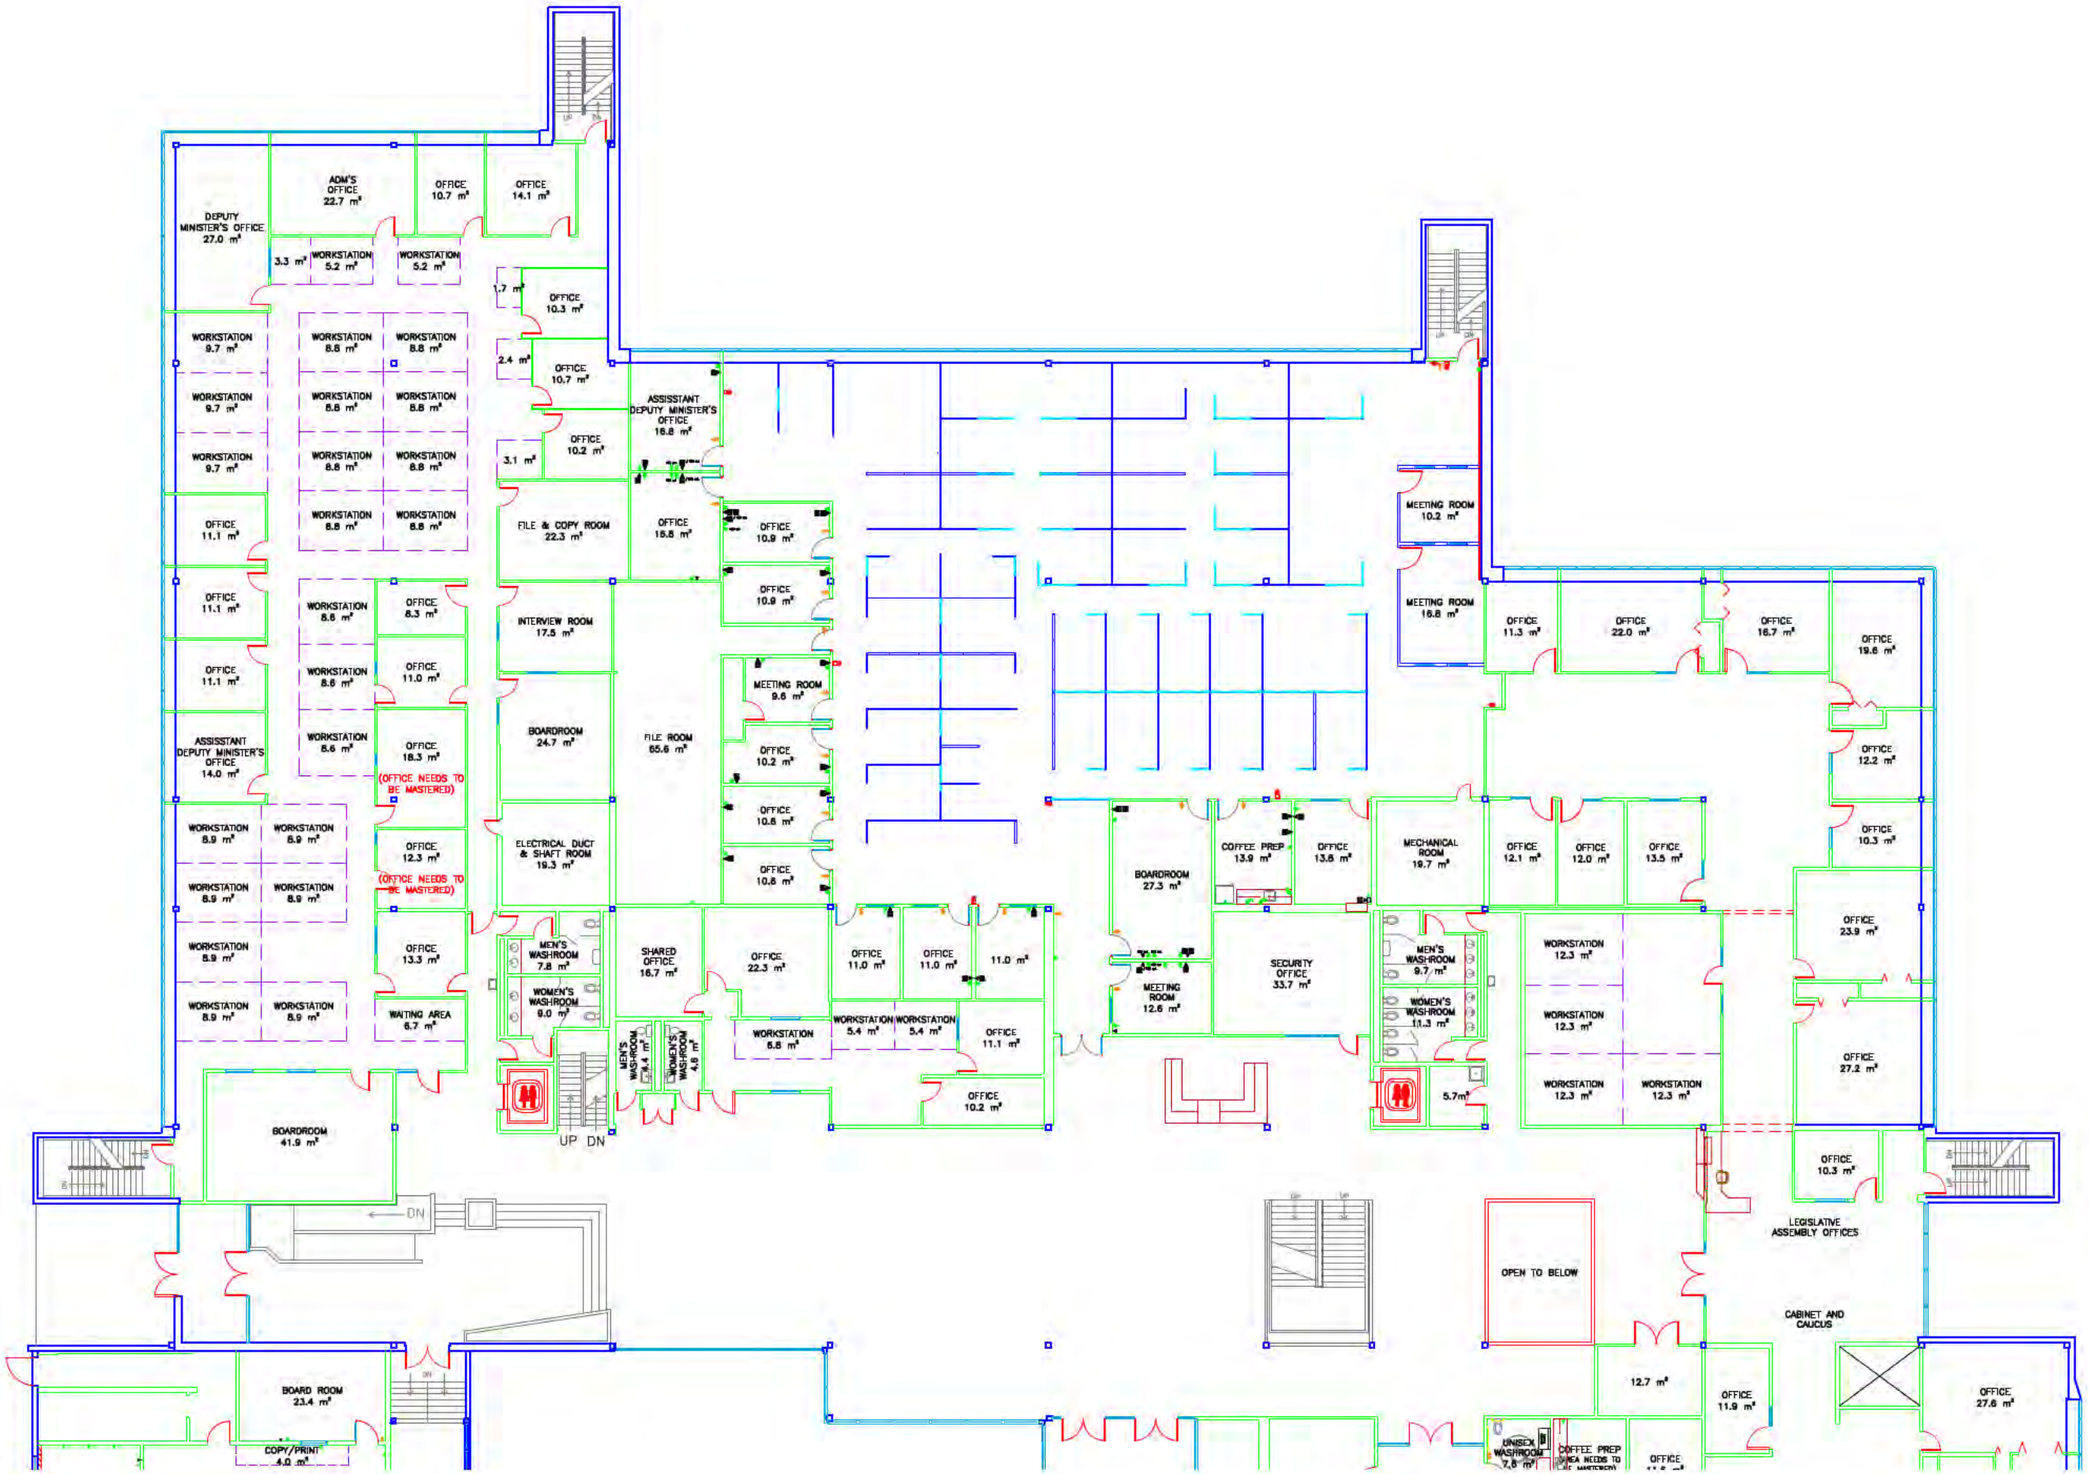

NOTES/REFERENCE DRAWINGS

LEGEND

- EXISTING INTERIOR WALL
- EXISTING EXTERIOR WALL
- GLAZING
- WORKSTATION
- BULKHEAD
- ACOUSTIC INSULATION
- EXISTING DOOR
- EXISTING CONNECTION (INCLUDES ELECTRICAL AND/OR VOICE-DATA) V/D
- DEDICATED LIGHT SWITCH $
- WASHROOMS
- VERTICAL PENETRATION
- ENTRYWAY
- MECHANICAL
- EXECUTIVE COUNCIL OFFICES
- PUBLIC SERVICE COMMISSION
- HIGHWAYS & PUBLIC WORKS
- LEGISLATURE

ALL UNITS ARE IN MILLIMETERS UNLESS SPECIFIED

REVISIONS & ISSUES

NO	dd/mm/yy	DESCRIPTION	BY
01	15/06/18	MASTERED	CS
00	--/08/09	REVISED	–

DRAWN ME | CHK'D – | SCALE NTS

Yukon
Highways and Public Works
Property Management Division

BLDG # 1259
MAIN ADMINISTRATION BUILDING


2071 SECOND AVENUE
WHITEHORSE, YT

2nd FLOOR PLAN EAST SIDE:

MASTER

Sheet 1 OF 1

REV 00

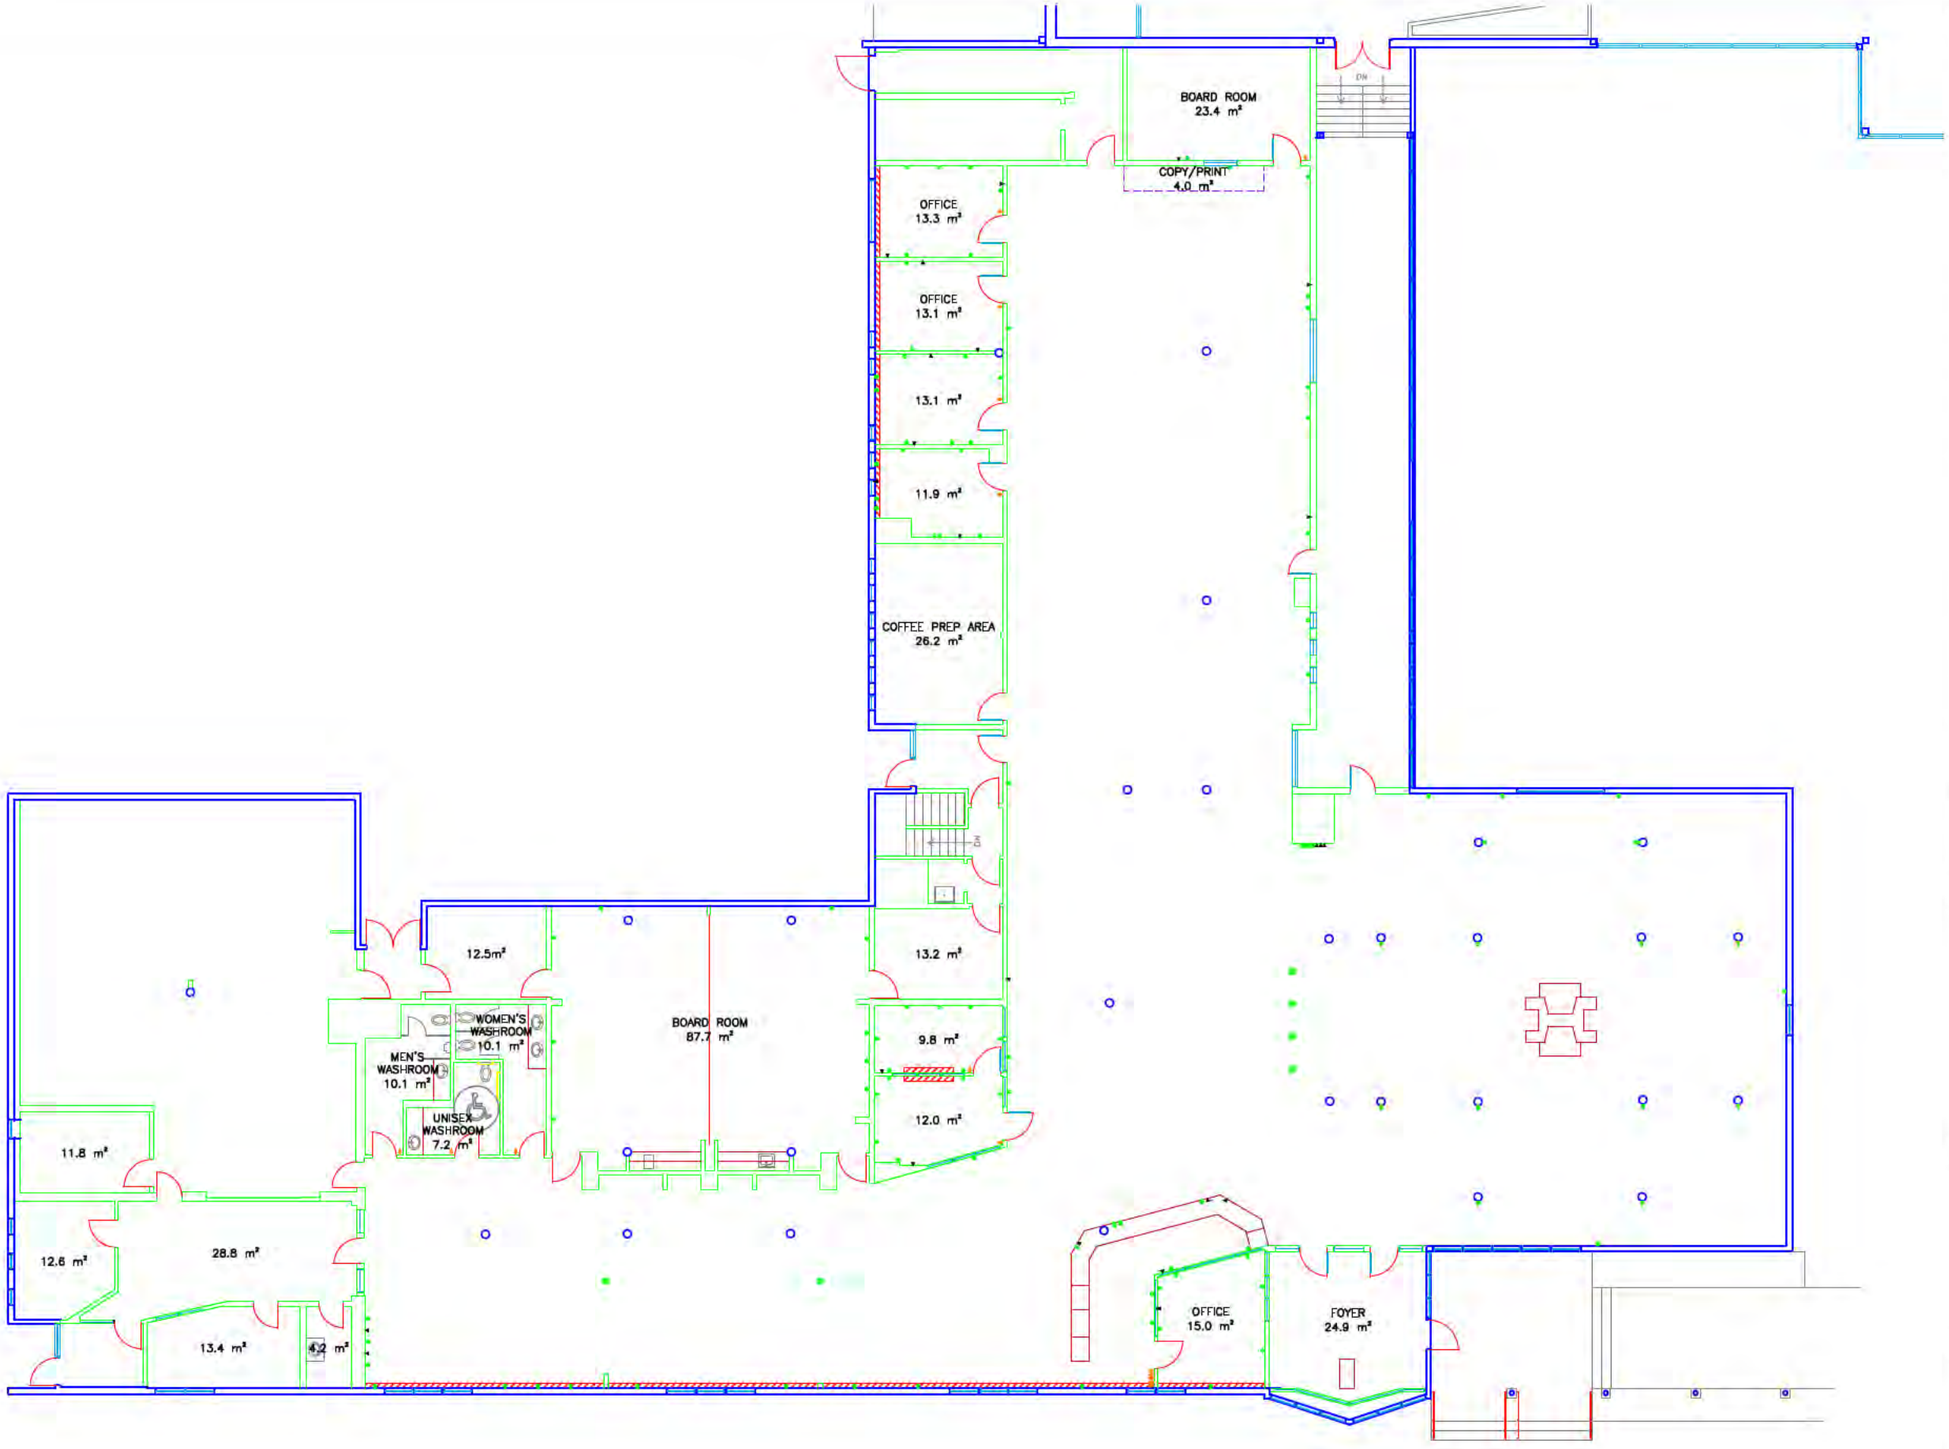

NOTES/REFERENCE DRAWINGS

LEGEND

- EXISTING INTERIOR WALL
- EXISTING EXTERIOR WALL
- GLAZING
- WORKSTATION
- BULKHEAD
- ACOUSTIC INSULATION
- EXISTING DOOR
- EXISTING CONNECTION (INCLUDES ELECTRICAL AND/OR VOICE-DATA) V/D
- DEDICATED LIGHT SWITCH $

- WASHROOMS
- VERTICAL PENETRATION
- ENTRYWAY
- MECHANICAL
- HIGHWAYS & PUBLIC WORKS
- SWING SPACE
- SWING SPACE (VACANT)

ALL UNITS ARE IN MILLIMETERS UNLESS SPECIFIED

REVISIONS & ISSUES

NO.	dd/mm/yy	DESCRIPTION	BY
00	--/--/--	-	-

DRAWN: ME
CHK'D: -
SCALE: NTS

Yukon
Highways and Public Works
Property Management Division


BLDG # 1259
MAIN ADMINISTRATION BUILDING

2071 SECOND AVENUE
WHITEHORSE, YT

2nd FLOOR PLAN:
MASTER

Sheet 1 OF 1

REV. 00

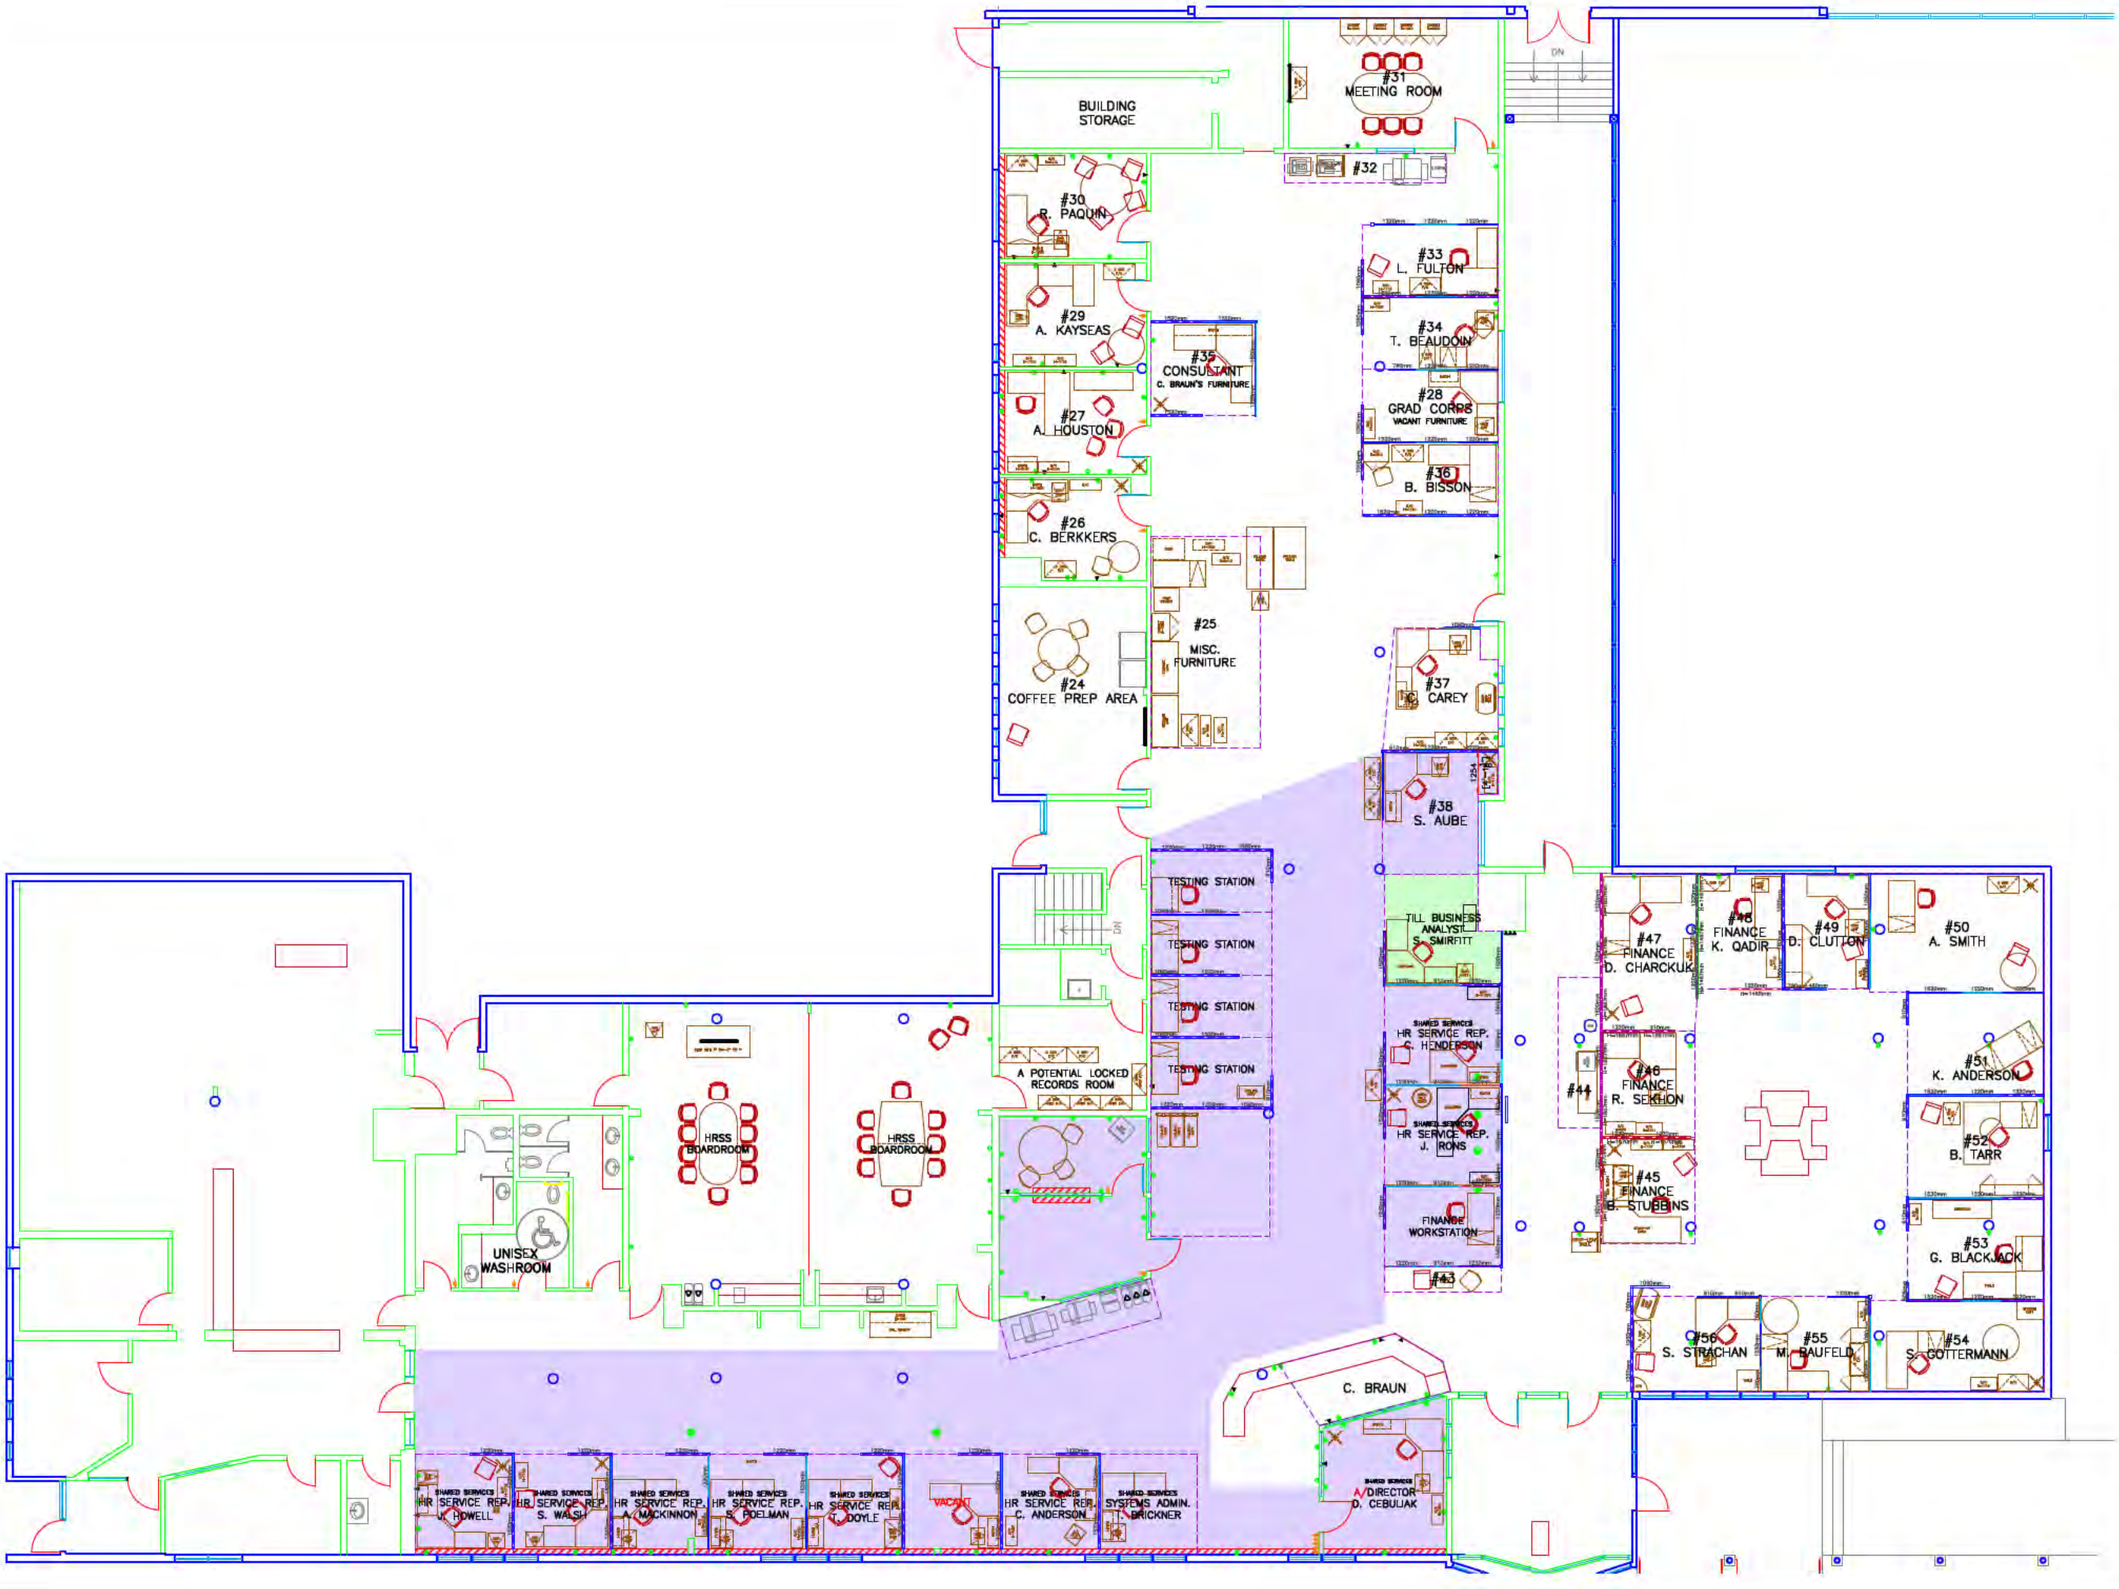

NOTES/REFERENCE DRAWINGS

LEGEND

- EXISTING INTERIOR WALL
- EXISTING EXTERIOR WALL
- GLAZING
- WORKSTATION
- BULKHEAD
- ACOUSTIC INSULATION
- EXISTING DOOR
- EXISTING CONNECTION (INCLUDES ELECTRICAL AND/OR VOICE-DATA) V/D
- DEDICATED LIGHT SWITCH $
- DEPARTMENT TO BE MOVED

ALL BLUE PARTITIONS ARE A HEIGHT OF 1866mm

ALL UNITS ARE IN MILLIMETERS UNLESS SPECIFIED

REVISIONS & ISSUES

NO.	dd/mm/yy	DESCRIPTION	BY
–	--/--/--	–	–
–	--/--/--	–	–
–	--/--/--	–	–

DRAWN	ME	SCALE	NTS
CHK'D	–		

Yukon
Highways and Public Works
Property Management Division

BLDG # 1259
MAIN ADMINISTRATION BUILDING

2071 SECOND AVENUE
WHITEHORSE, YT

2nd FLOOR PLAN:
PRELIMINARY PROPOSAL

Sheet 1 OF 1

REV. 00

BOARDROOM
41.9 m²

MANAGER
8.4m²

RECORDS OFFICER
8.0m²

FINANCIAL ANALYST
8.0m²

INTERGOVERNMENTAL RELATIONS ANALYST
9.2 m²

DIRECTOR OF INTERGOVERNMENTAL RELATIONS
14.0 m²

INTERGOVERNMENTAL RELATIONS OFFICER
11.1 m²

INTERGOVERNMENTAL RELATIONS OFFICER
11.1 m²

RECEPTION
8.4m²

ACCOUNTING CLERK
7.0m²

3.0m²

INTERGOVERNMENTAL RELATIONS ADMIN.
7.2 m²

EQUIP.

STUDENT
7.2 m²

INTERGOVERNMENTAL RELATIONS OFFICER
8.4 m²

WAITING ROOM
6.8 m²

DIRECTOR OF FINANCE
13.3 m²

INTERGOVERNMENTAL RELATIONS OFFICER
12.3 m²

ADM OF CORPORATE PROGRAMS AND INTERGOVERNMENTAL RELATIONS
18.3 m²

MANAGER
11.0 m²

HRC II
8.3 m²

UP DN

WOMEN'S WASHROOM

MEN'S WASHROOM

ELECTRICAL DUCT & SHAFT ROOM
19.3 m²

BOARDROOM (EPP ROOM)
24.7 m²

HRC II
8.8 m²

HRC II
8.8 m²

NOTES/REFERENCE DRAWINGS

LEGEND

- EXISTING INTERIOR WALL
- EXISTING EXTERIOR WALL
- GLAZING
- WORKSTATION
- BULKHEAD
- ACOUSTIC INSULATION
- EXISTING DOOR
- EXISTING CONNECTION (INCLUDES ELECTRICAL AND/OR VOICE-DATA) V/D
- DEDICATED LIGHT SWITCH

ALL UNITS ARE IN MILLIMETERS UNLESS SPECIFIED

REVISIONS & ISSUES

NO.	dd/mm/yy	DESCRIPTION	BY
–	–	–	–
–	–	–	–
00	25/10/17	FOR APPROVAL	ME

DRAWN ME
CHK'D –
SCALE NTS

Yukon
Highways and Public Works
Property Management Division

BLDG # 1259
MAIN ADMINISTRATION BUILDING

2071 SECOND AVENUE
WHITEHORSE, YT

2nd FLOOR PLAN:
ECO LAYOUT

Sheet 1 OF 1

REV. 00



NOTES/REFERENCE DRAWINGS

LEGEND

EXISTING PARTITIONS

NEW PARTITIONS

GLAZING

DEMOLITION

EXISTING CONNECTION
INCLUDES ELECTRICAL AND/OR VOICE-DATA

NEW CONNECTION
INCLUDES ELECTRICAL AND/OR VOICE-DATA

DEDICATED 20amp RECEPTACLE

AREA OF CHANGE

ALL NEW PAC-POLES ARE TO MATCH EXISTING BEIGE PAC-POLES

THE DE-MOUNTABLE WALL SYSTEM (WHITE) TO BE SALVAGE AND STORED ON-SITE AT CLIENTS REQUEST

PARTITIONS TO BE SUPPLIED BY DEPARTMENT

ALL UNITS ARE IN MILLIMETERS UNLESS SPECIFIED

REVISIONS & ISSUES

NO.	dd/mm/yy	DESCRIPTION	BY
–	--/--/--	–	–
01	08/01/2019	PAC-POLE CHANGES	ME
00	14/12/2018	FOR APPROVAL	ME

DRAWN ME

CHK'D –

SCALE NTS

Yukon
Highways and Public Works
Property Management Division

BLDG # 1259
MAIN ADMINISTRATION BUILDING

2071 SECOND AVENUE
WHITEHORSE, YT

2nd FLOOR PLAN:

PROPOSED PSC SPACE
OPTION 1B


Sheet 1 OF 2

REV. 00

DATE: _____

AUTHORIZED BY: _____

SIGNATURE: _____

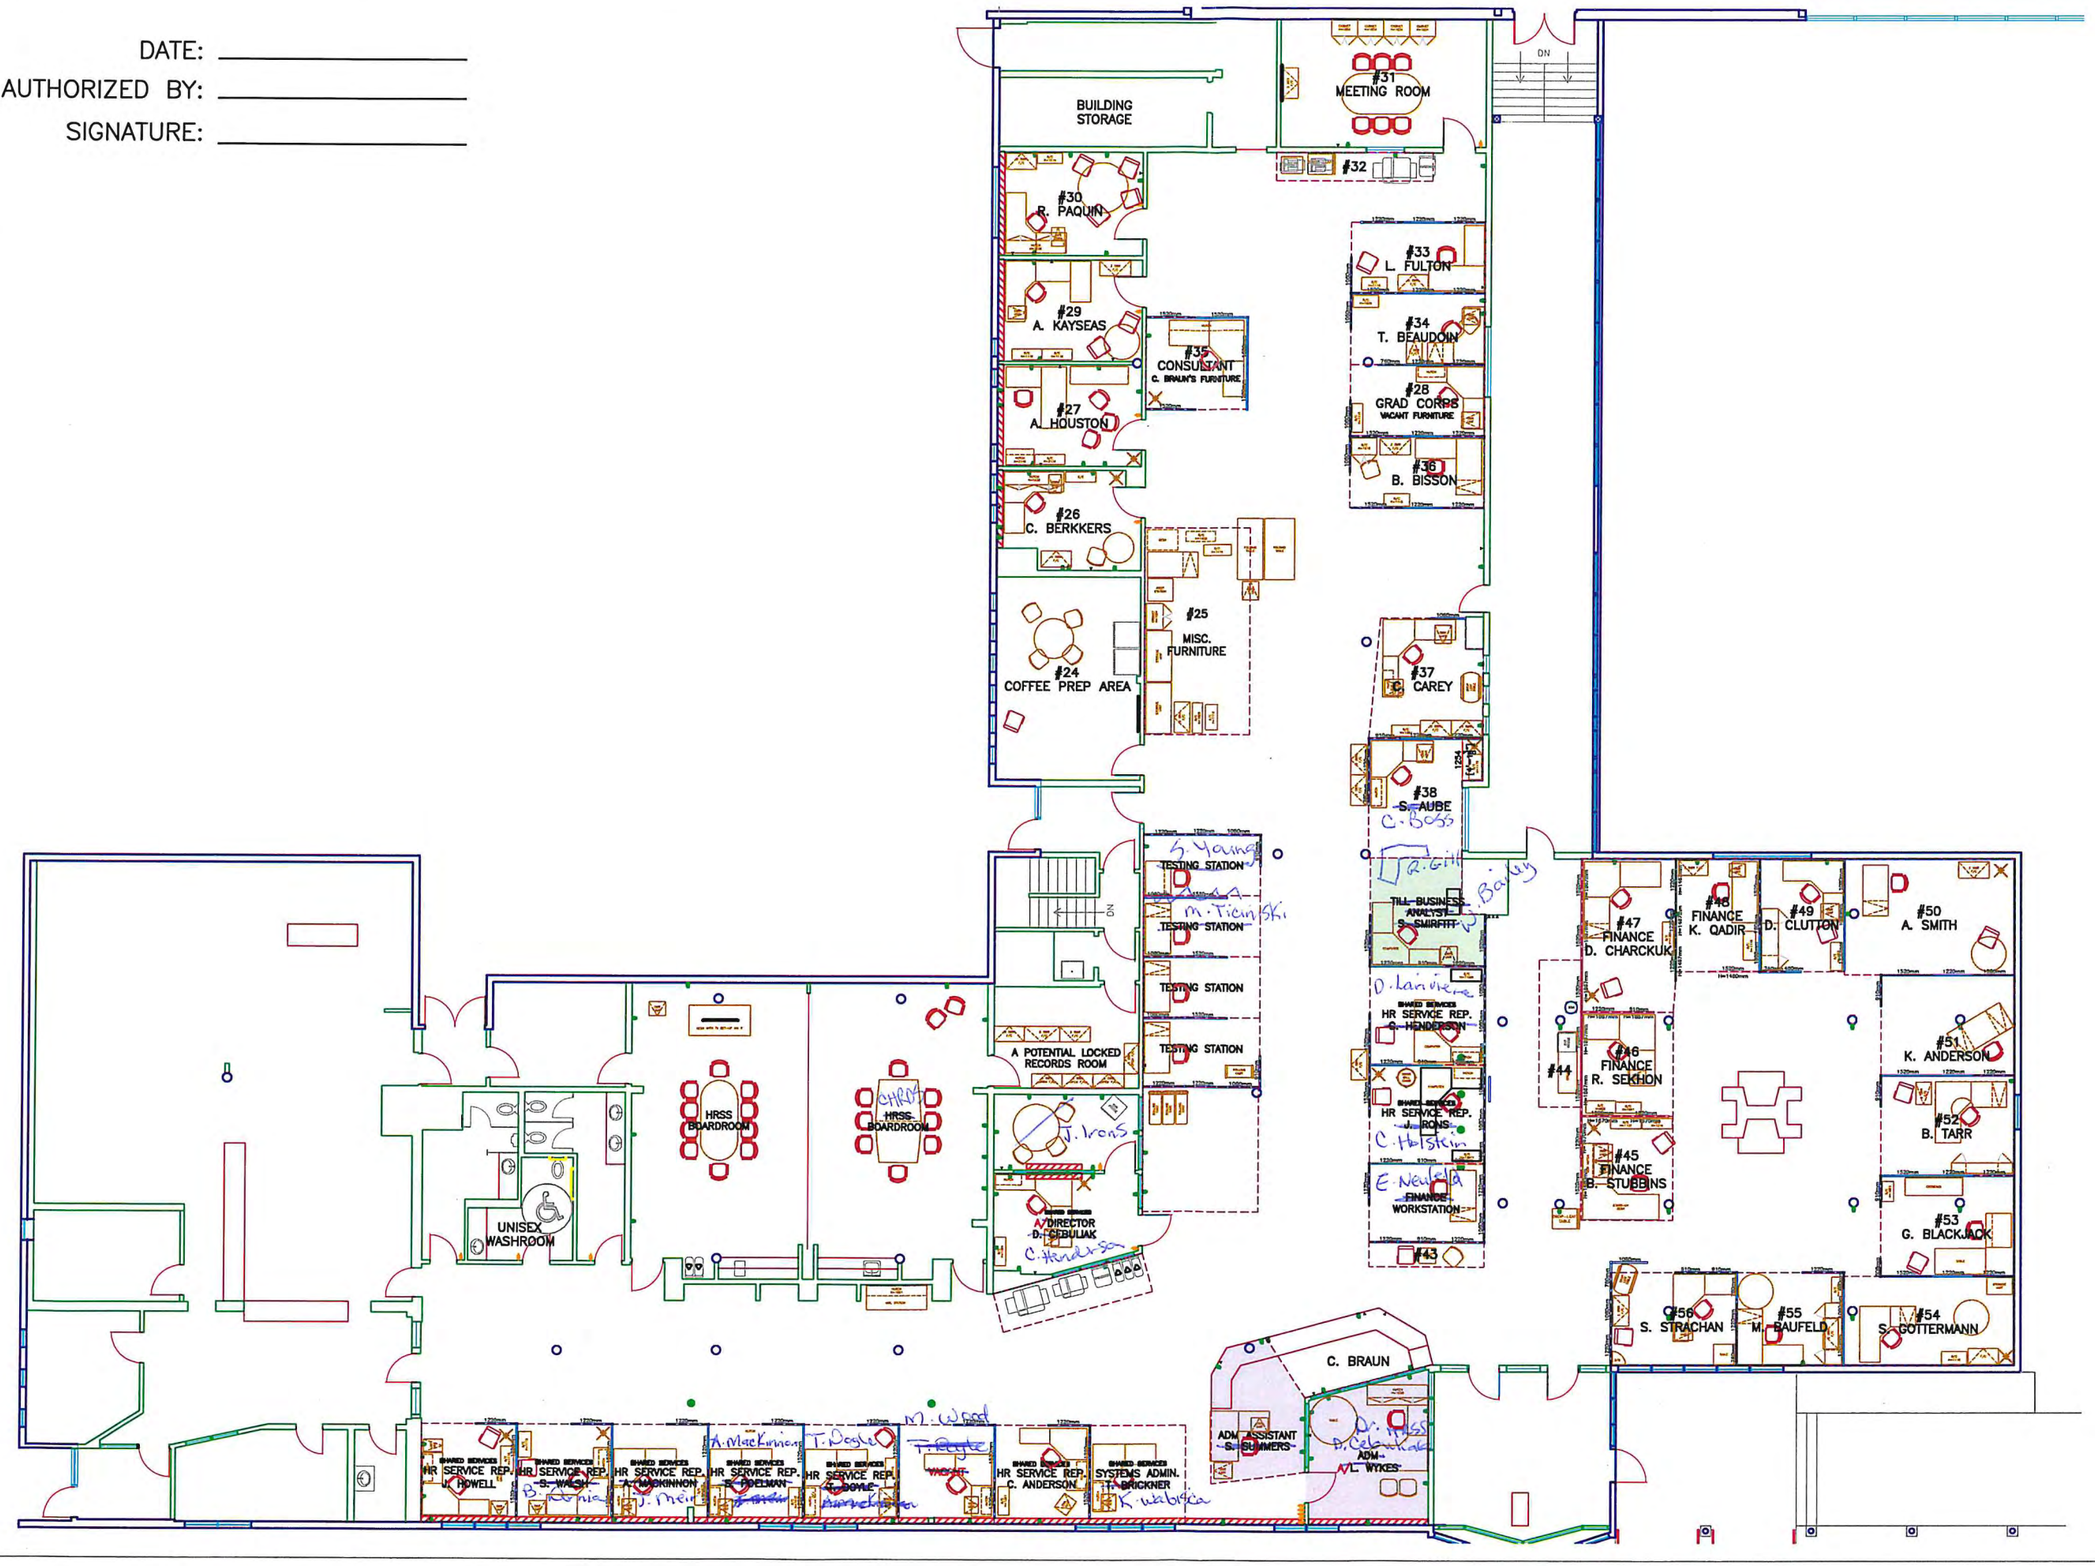

NOTES/REFERENCE DRAWINGS

LEGEND

- EXISTING INTERIOR WALL
- EXISTING EXTERIOR WALL
- GLAZING
- WORKSTATION
- BULKHEAD
- ACOUSTIC INSULATION
- EXISTING DOOR
- EXISTING CONNECTION (INCLUDES ELECTRICAL AND/OR VOICE-DATA) — V/D
- DEDICATED LIGHT SWITCH — $
- DEPARTMENT TO BE MOVED
- DEPARTMENT TO BE MOVED

ALL BLUE PARTITIONS ARE A HEIGHT OF 1866mm

ALL UNITS ARE IN MILLIMETERS UNLESS SPECIFIED

REVISIONS & ISSUES

01	16/02/18	FOR APPROVAL	ME
00	26/01/18	FOR APPROVAL	ME
NO.	dd/mm/yy	DESCRIPTION	BY

DRAWN ME	SCALE NTS
CHK'D –	

Yukon

Highways and Public Works
Property Management Division


BLDG # 1259
MAIN ADMINISTRATION BUILDING

2071 SECOND AVENUE
WHITEHORSE, YT

2nd FLOOR PLAN:
PRELIMINARY PROPOSAL

Sheet 1 OF 1

REV. 00

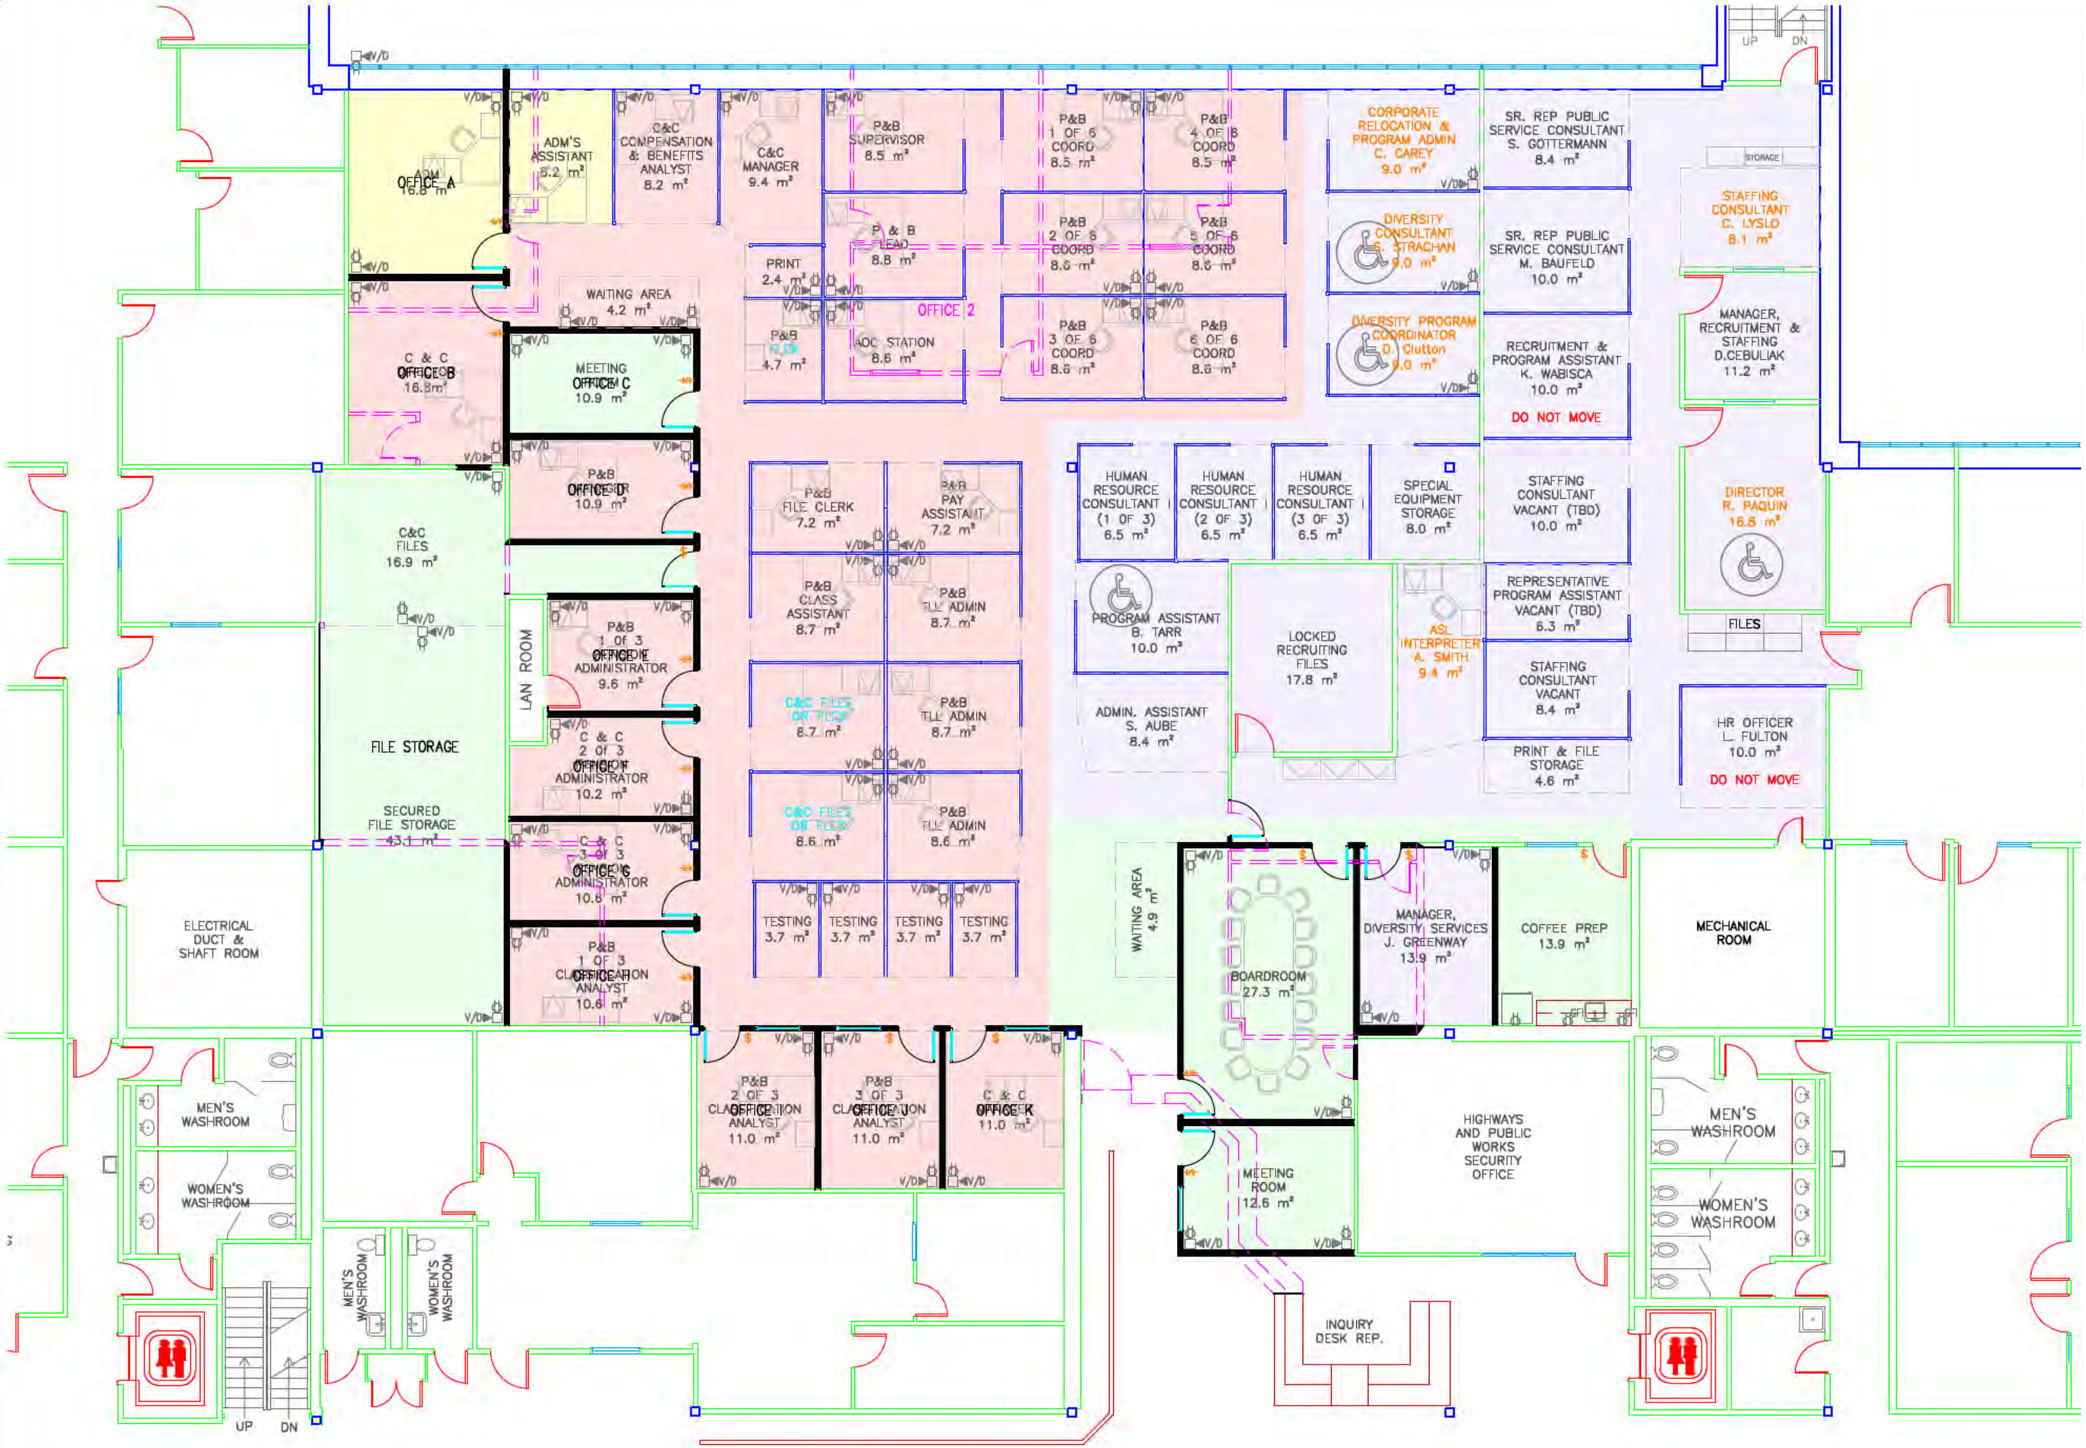

NOTES/REFERENCE DRAWINGS

LEGEND

- EXISTING INTERIOR WALL
- EXISTING EXTERIOR WALL
- GLAZING
- WORKSTATION
- BULKHEAD
- ACOUSTIC INSULATION
- EXISTING DOOR
- PROPOSED CONNECTION (INCLUDES ELECTRICAL AND/OR VOICE-DATA) V/D
- PROPOSED LIGHT SWITCH $
- NEW CONSTRUCTION
- ADM OFFICE
- PSC (COMPENSATION & CLASSIFICATION, PAY AND BENEFITS)
- PSC (RECRUITING SERVICES)
- SHARED SPACE

REVISIONS & ISSUES

NO	dd/mm/yy	DESCRIPTION	BY
–	–	–	–
–	–	–	–
–	–	–	–
00	10/02/17	FOR APPROVAL	ME

DRAWN ME | CHK'D – | SCALE NTS

Yukon
Highways and Public Works
Property Management Division


BLDG # 1259
MAIN ADMINISTRATION BUILDING

2071 SECOND AVENUE
WHITEHORSE, YT

PSC

2nd FLOOR PLAN:
PROPOSED PLAN B

Sheet 1 OF 1 | REV. 00

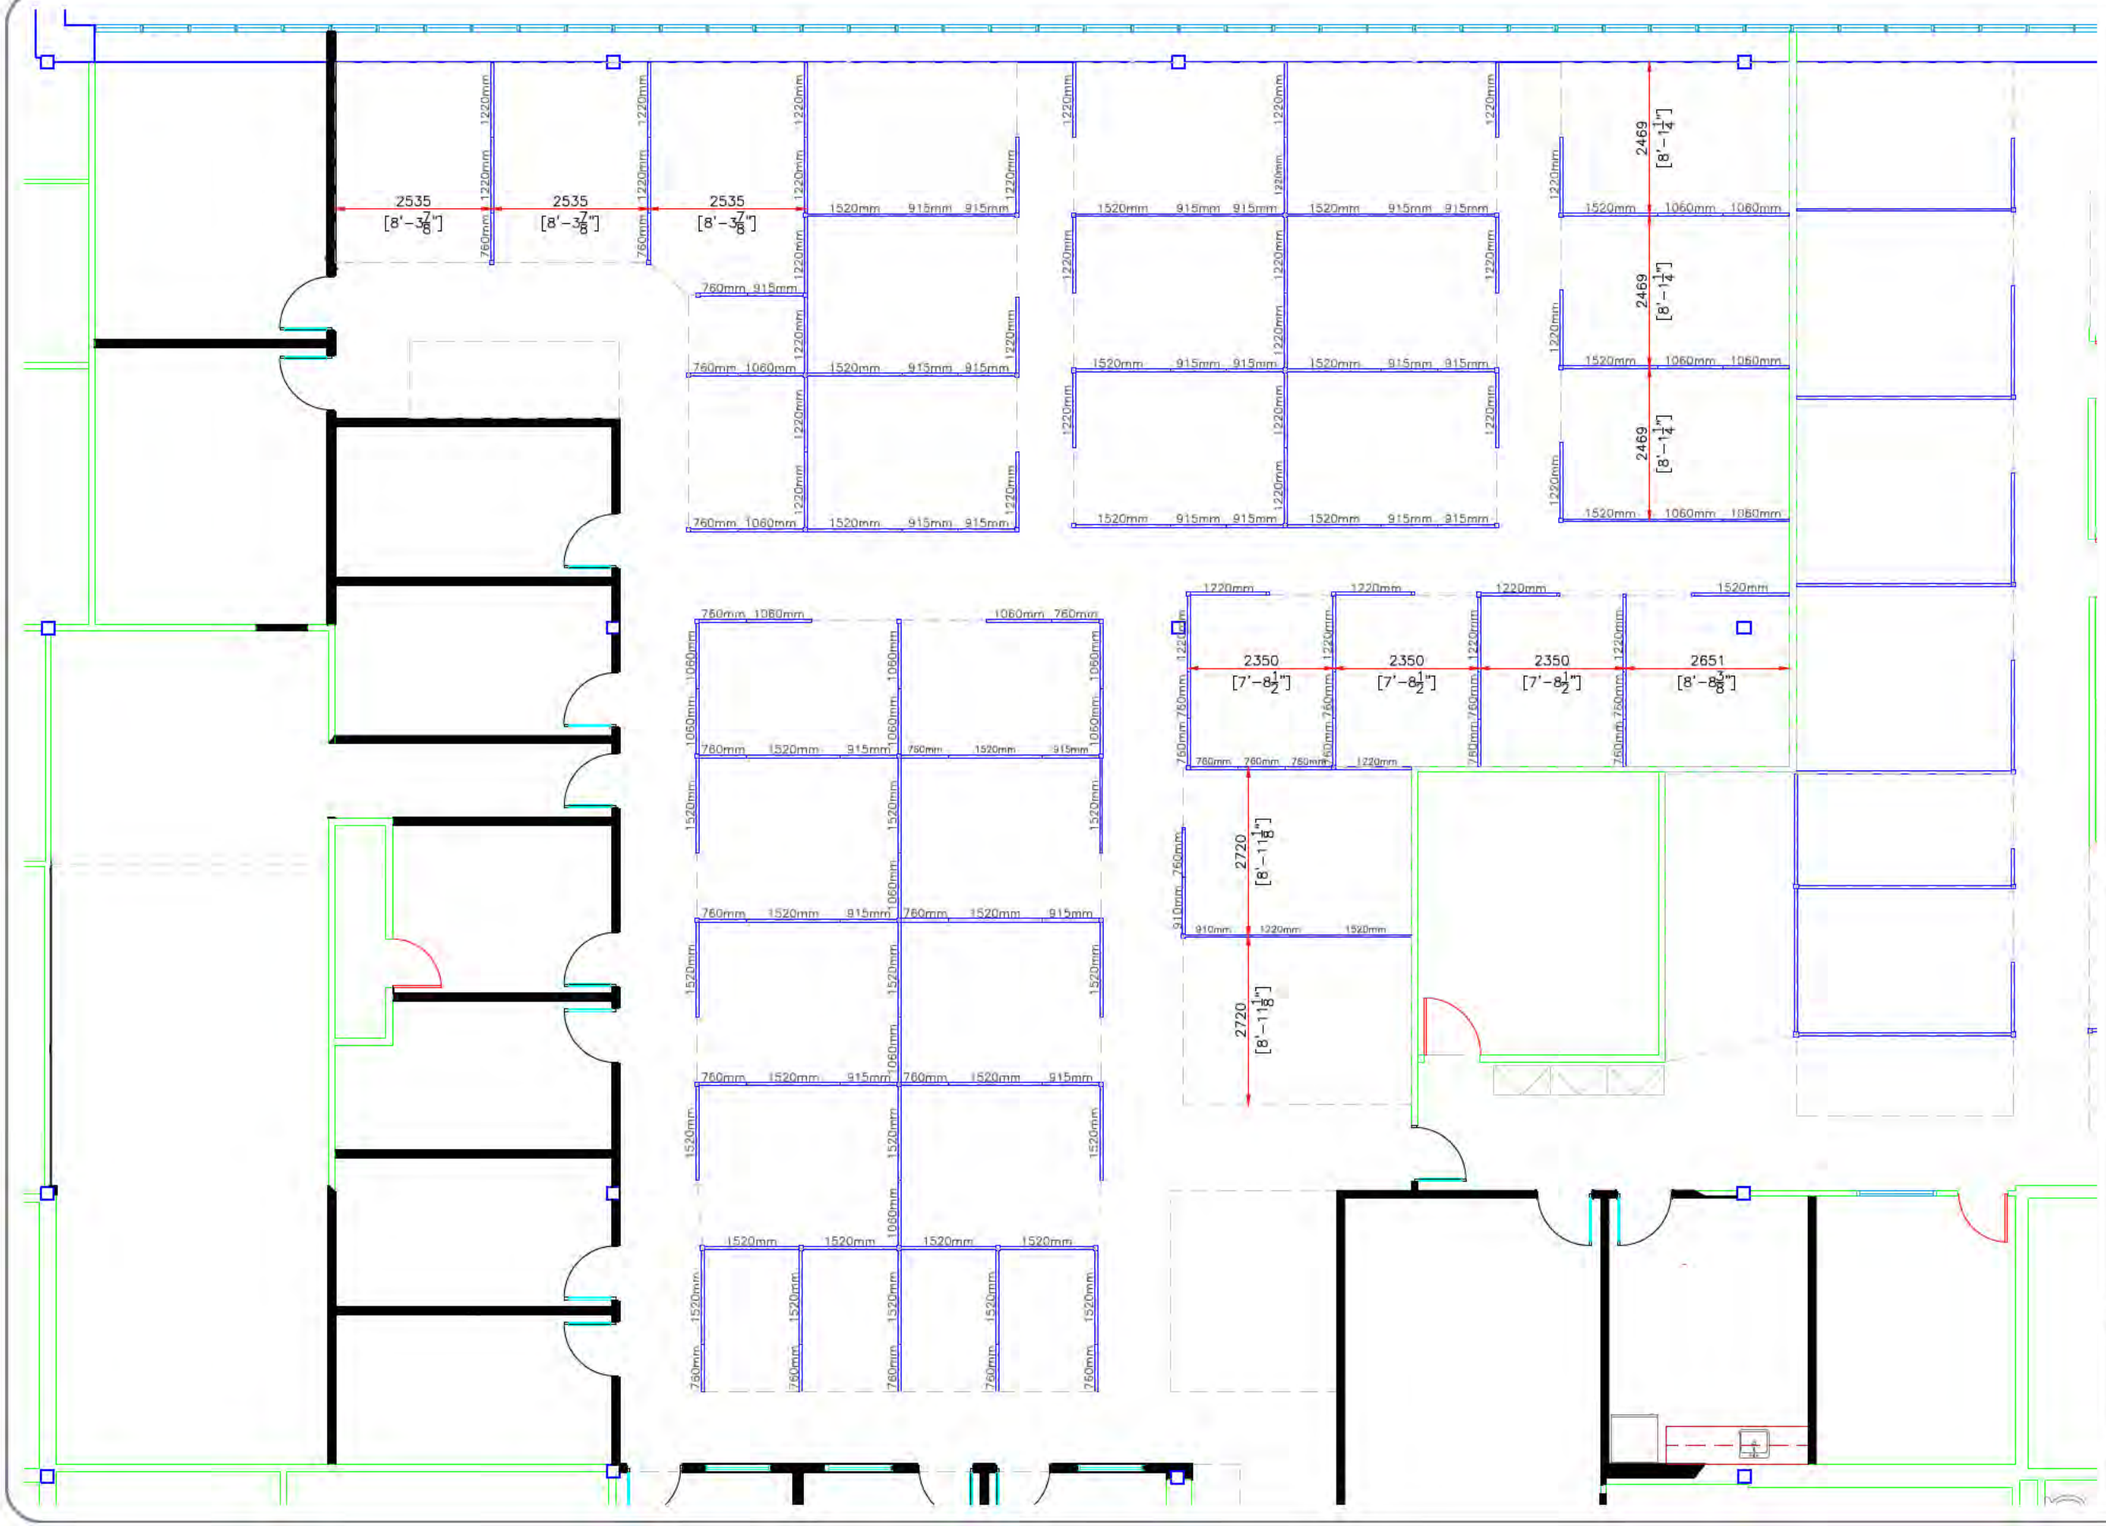

NOTES/REFERENCE DRAWINGS

LEGEND

- EXISTING INTERIOR WALL
- EXISTING EXTERIOR WALL
- GLAZING
- WORKSTATION
- BULKHEAD
- ACOUSTIC INSULATION
- EXISTING DOOR
- PROPOSED CONNECTION (INCLUDES ELECTRICAL AND/OR VOICE-DATA)
- PROPOSED LIGHT SWITCH
- NEW CONSTRUCTION

REVISIONS & ISSUES

NO	dd/mm/yy	DESCRIPTION	BY
–	–	–	–
–	–	–	–
00	24/01/18	FOR APPROVAL	ME

DRAWN	ME	SCALE	NTS
CHK'D	–		

Yukon
Highways and Public Works
Property Management Division


BLDG # 1259
MAIN ADMINISTRATION BUILDING

2071 SECOND AVENUE
WHITEHORSE, YT

2nd FLOOR PLAN:
PARTITIONS

Sheet 1 OF 1

REV. 00

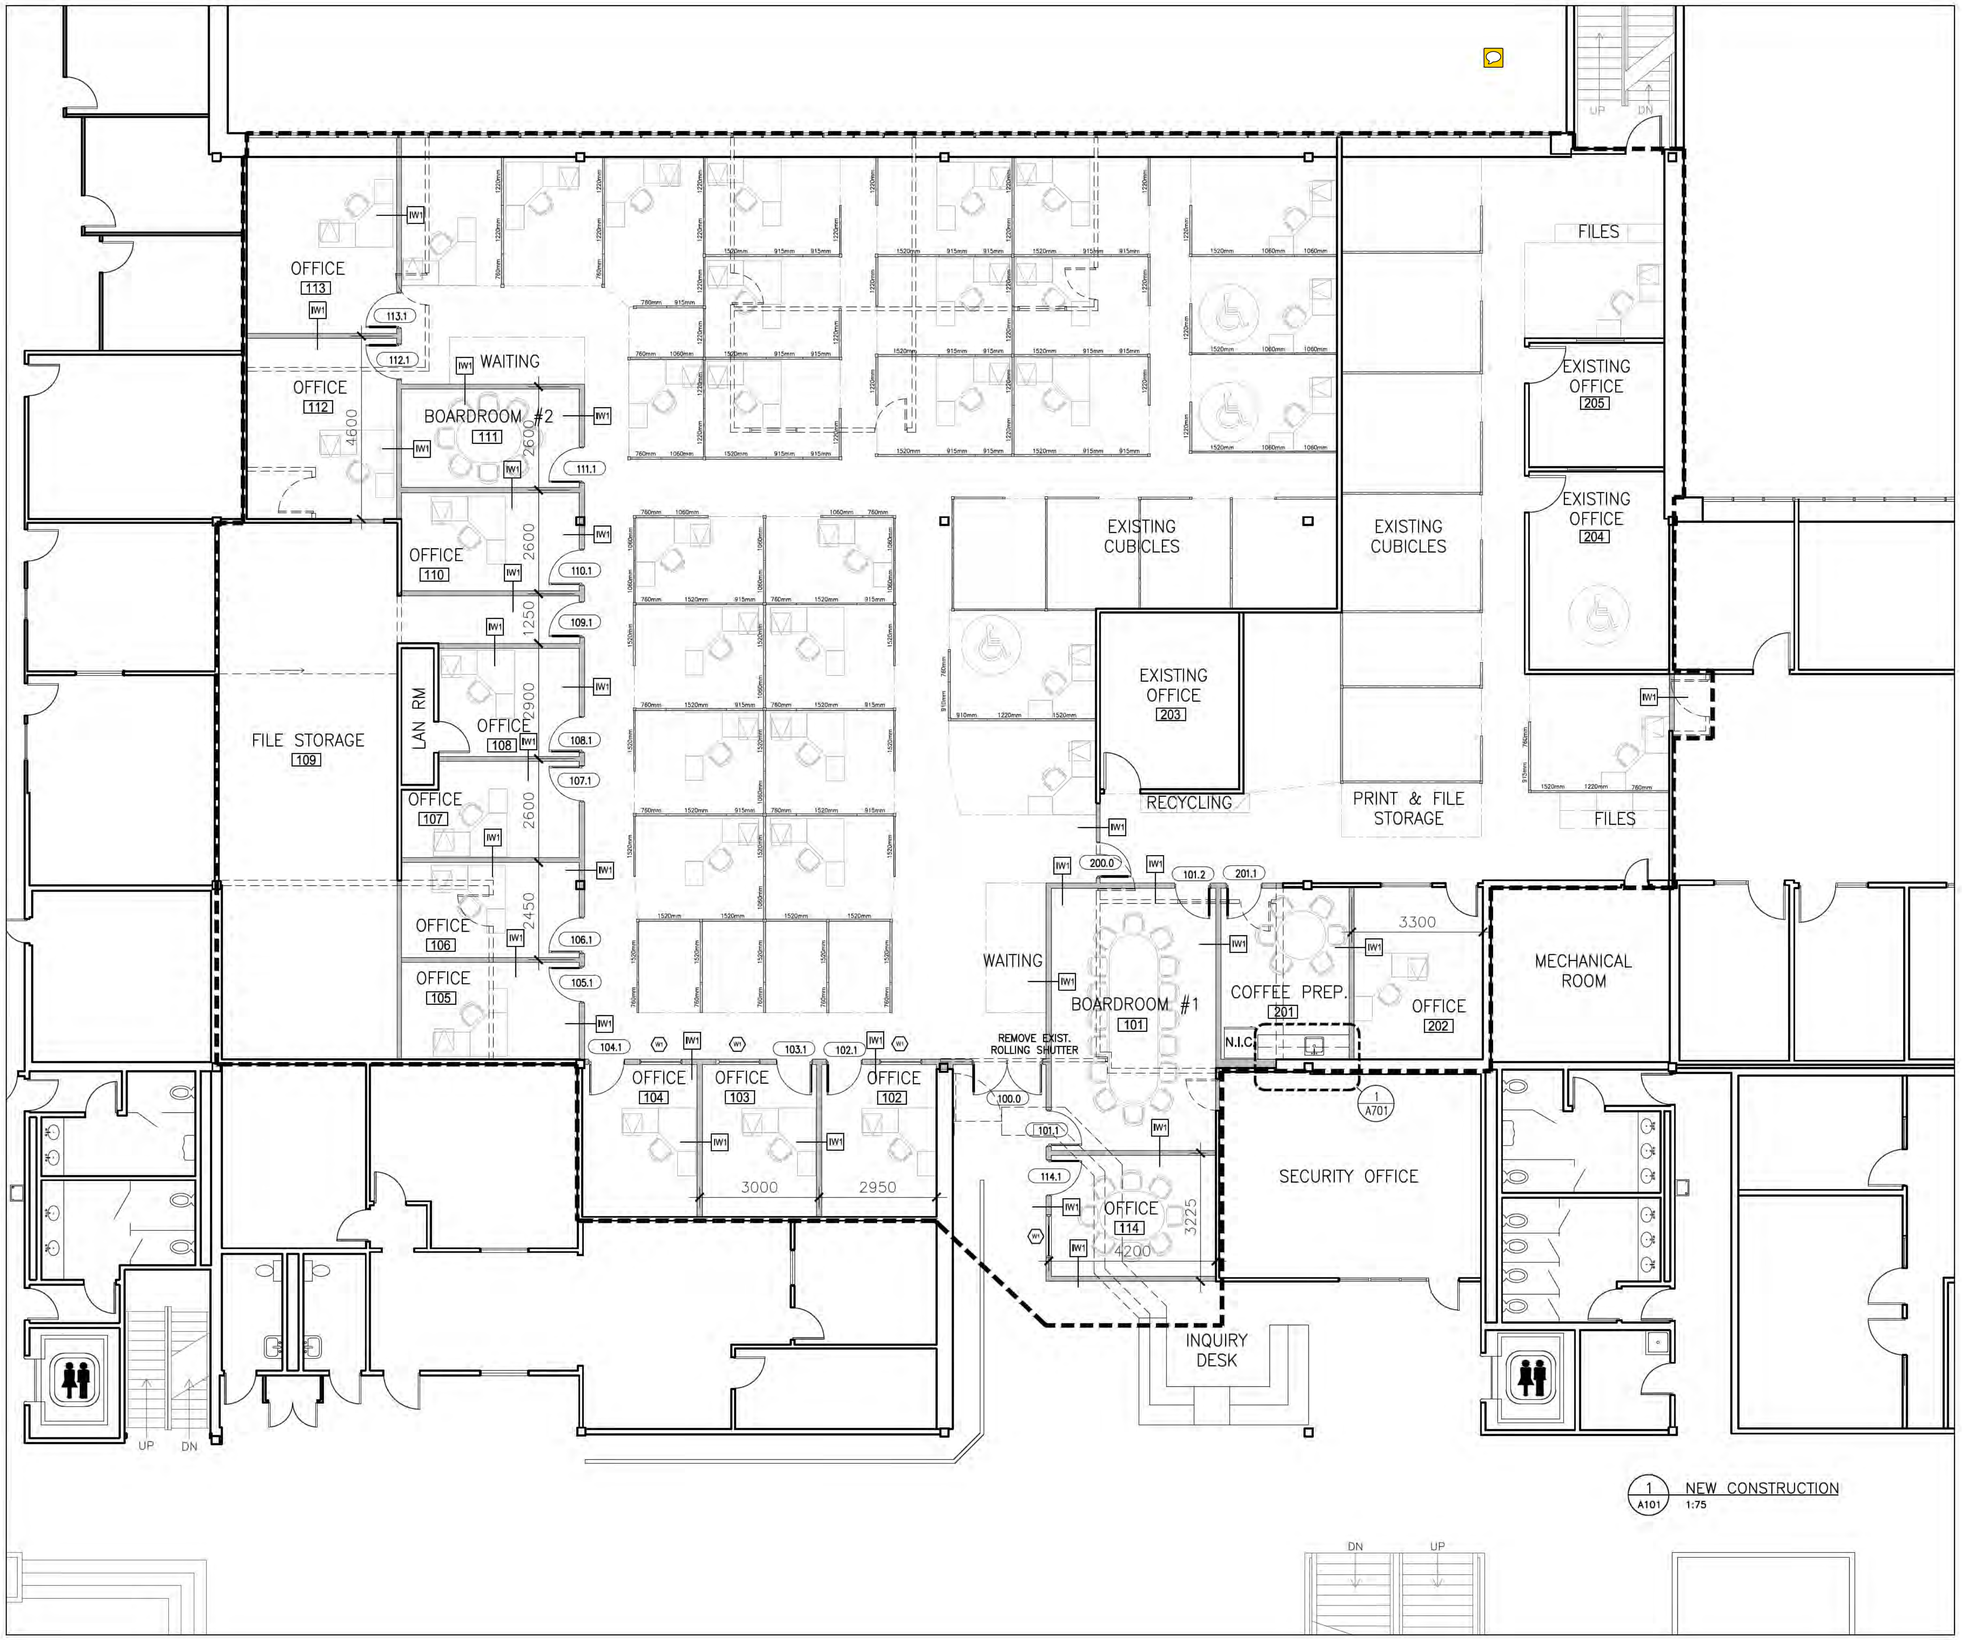

Stantec

Stantec Architecture Ltd.
202 107 Main Street
Whitehorse YT
Tel. 867.633.2400
www.stantec.com

The Contractor shall verify and be responsible for all dimensions. DO NOT scale the drawing - any errors or omissions shall be reported to Stantec without delay. The Copyrights to all designs and drawings are the property of Stantec. Reproduction or use for any purpose other than that authorized by Stantec is forbidden.

Legend

BUILDING NORTH

- AREA OF WORK OUTLINE
- EXISTING WALLS
- CUBICLES
- DEMOLITION
- NEW WALL CONSTRUCTION TO U/S OF T-BAR CEILING
- ALLOCATED WORKSPACE
- IW1 WALL TYPE
- 111.1 DOOR NUMBER
- W1 WINDOW TYPE

Revision		By	Appd.	YY.MM.DD
A	ISSUED FOR 65% DESIGN REVIEW	TF	JB	17.06.14

Issued

File Name:	Dwn.	Chkd.	Dsgn.	YY.MM.DD

Permit-Seal

PRELIMINARY
NOT TO BE USED FOR CONSTRUCTION

Client/Project
GOVERNMENT OF YUKON


MAIN ADMINISTRATION BUILDING
MAIN FLOOR INTERIOR RENOVATION
WHITEHORSE, Y.T.

Title
MAIN FLOOR PLAN

Project No.	Scale	
144902484	1:75	
Drawing No.	Sheet	Revision
A101	1 of 3	0

Y:\144P\active\144902484\3000_tech\04_drawings\architects\02484A_[0]_main floor Plan.dwg
2017/06/14 2:11 PM by Hensen, Thor

ORIGINAL SHEET - ISO A1

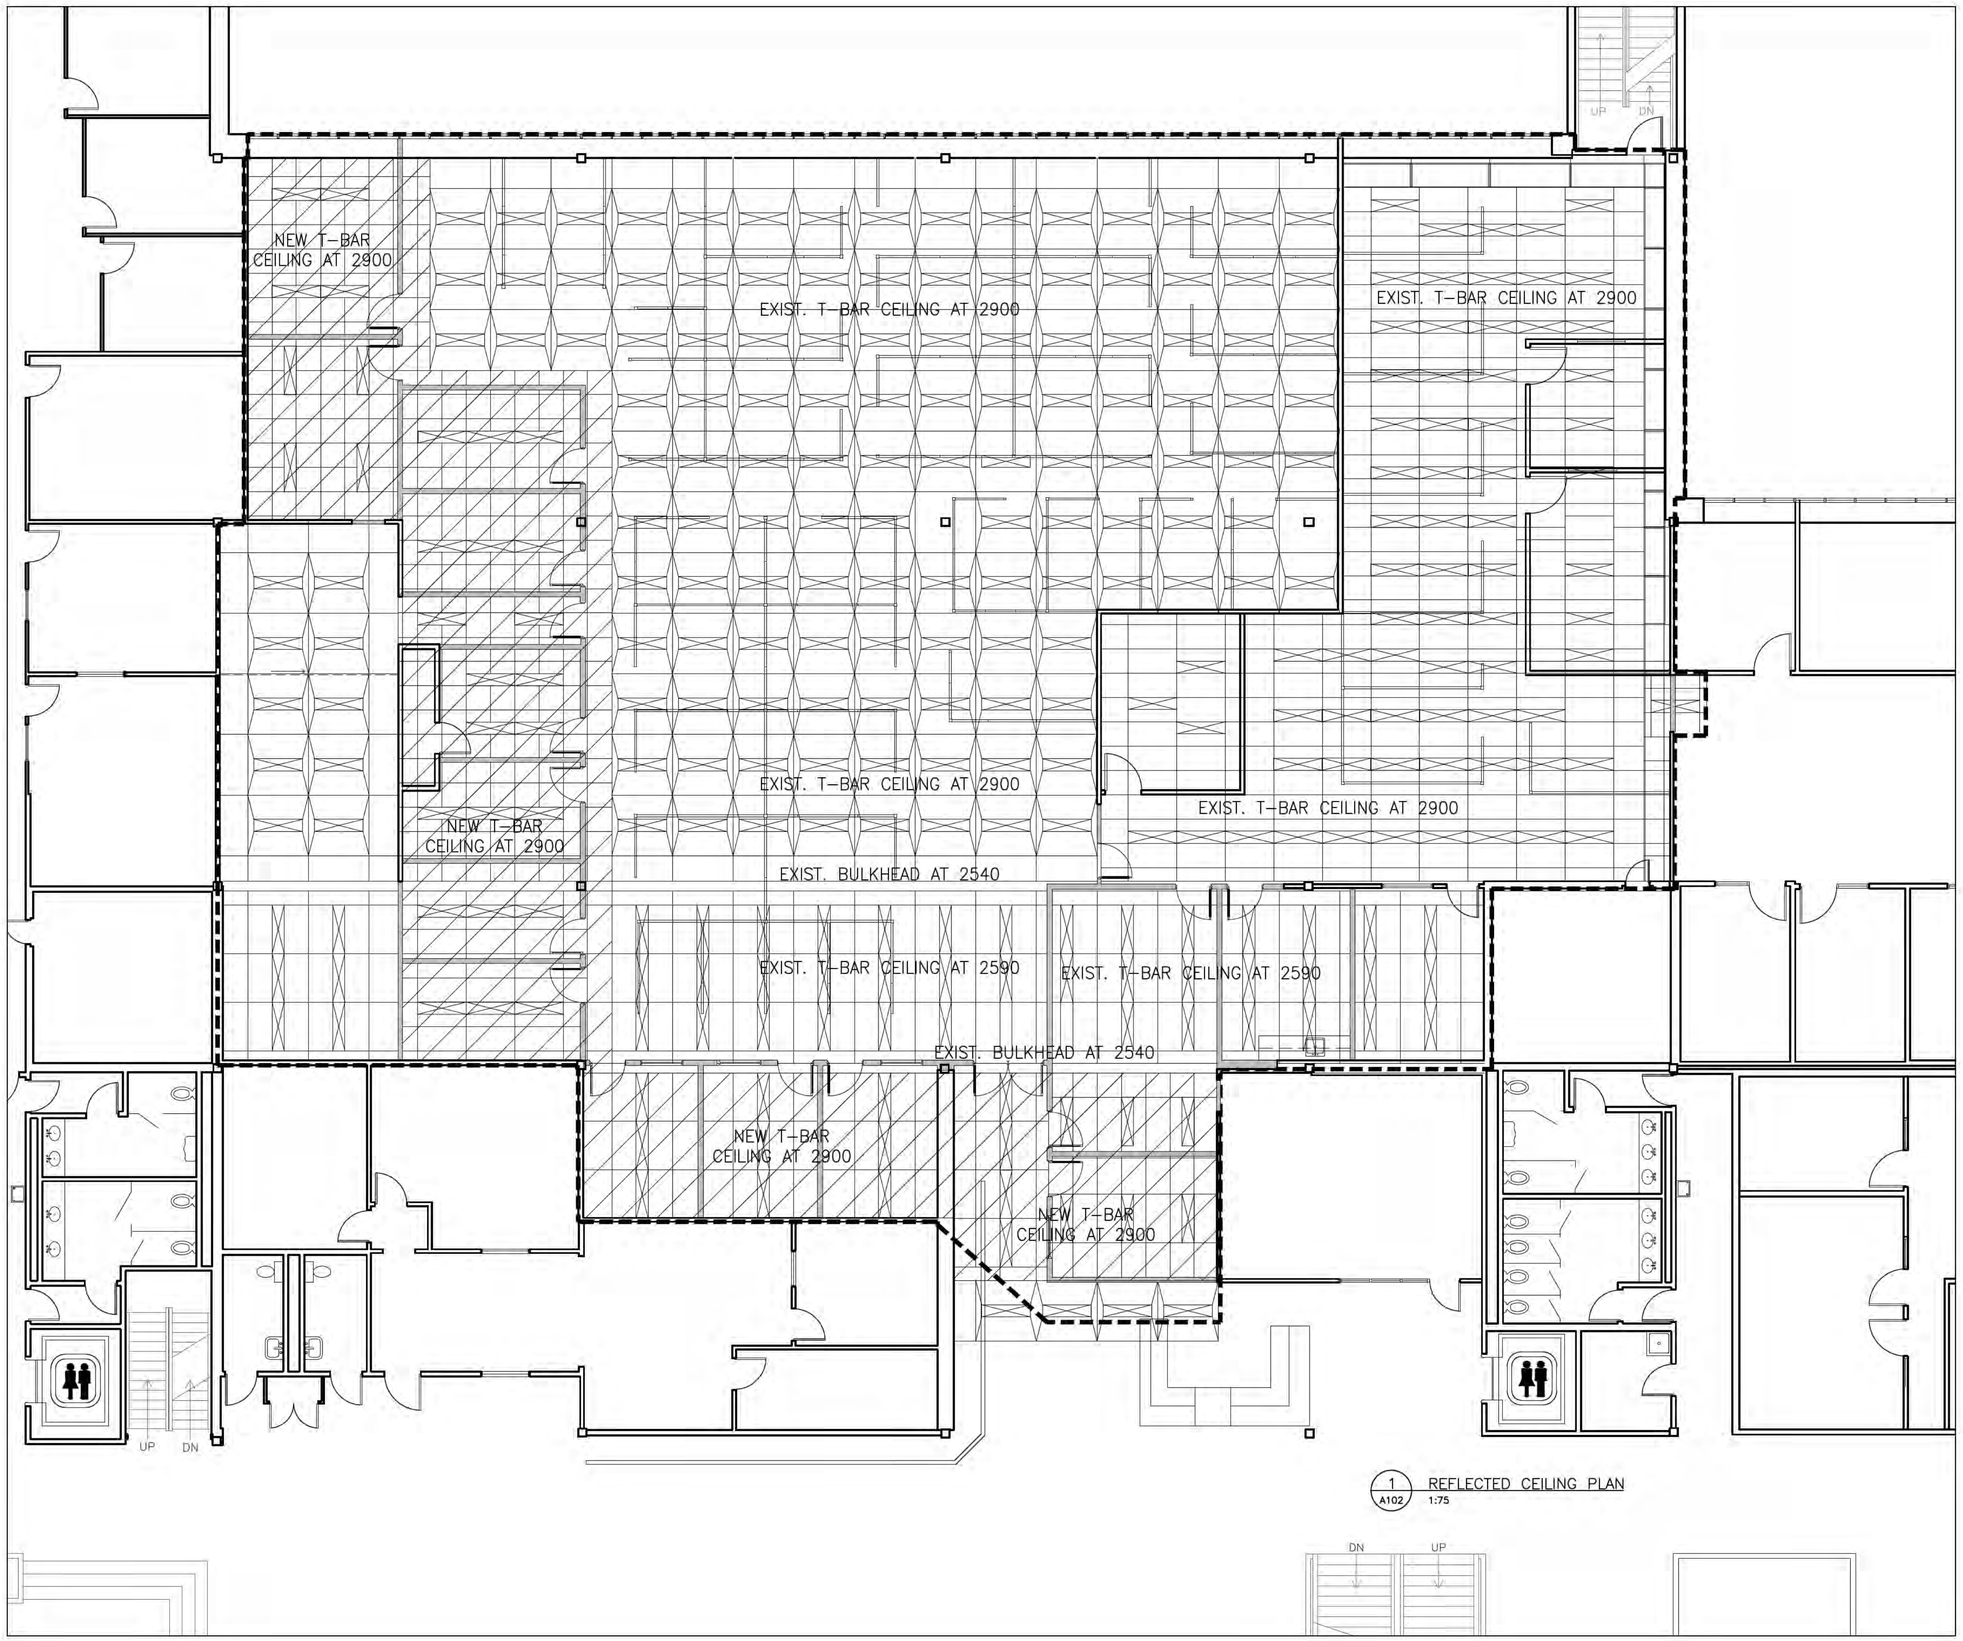

1 A102 REFLECTED CEILING PLAN
1:75

Stantec

Stantec Architecture Ltd.
202 107 Main Street
Whitehorse YT
Tel. 867.633.2400
www.stantec.com

The Contractor shall verify and be responsible for all dimensions. DO NOT scale the drawing - any errors or omissions shall be reported to Stantec without delay. The Copyrights to all designs and drawings are the property of Stantec. Reproduction or use for any purpose other than that authorized by Stantec is forbidden.

Legend

BUILDING NORTH

AREA OF WORK OUTLINE
EXISTING WALLS
CUBICLES
DEMOLITION
NEW WALL CONSTRUCTION TO U/S OF T-BAR CEILING
ALLOCATED WORKSPACE
CEILING LIGHT FIXTURES
IW1 WALL TYPE
111.1 DOOR NUMBER
W1 WINDOW TYPE
NEW T-BAR CEILING

Revision		By	Appd.	YY.MM.DD
A	ISSUED FOR 65% DESIGN REVIEW	TF	JB	17.06.14

Issued	By	Appd.	YY.MM.DD
File Name:	Dwn.	Chkd.	Dsgn.	YY.MM.DD

Permit-Seal

PRELIMINARY
NOT TO BE USED FOR CONSTRUCTION

Client/Project
GOVERNMENT OF YUKON


MAIN ADMINISTRATION BUILDING
MAIN FLOOR INTERIOR RENOVATION
WHITEHORSE, Y.T.

Title
REFLECTED CEILING PLAN

Project No.	Scale	
144902484	1:75	
Drawing No.	Sheet	Revision
A102	2 of 3	0


Y:\144Projects\144902484\2000_arch\06_drawings\architecture\02484A_100_RCP.dwg
2017/06/14 11:37 AM By: Hansen, Thor

ORIGINAL SHEET - ISO A1

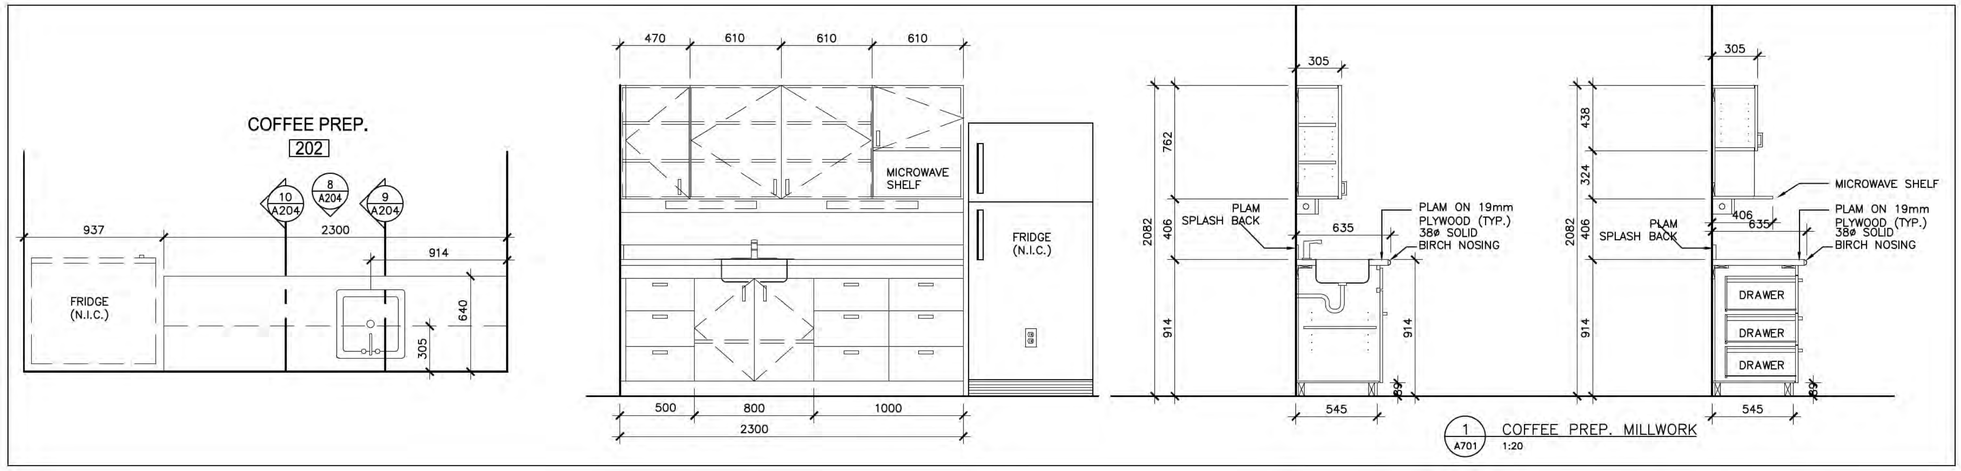


1 A701 COFFEE PREP. MILLWORK
1:20


PS 350 PARTITION WALL DETAILS M. 1:5

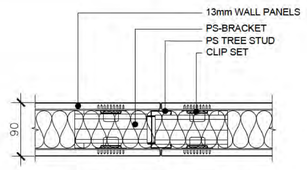


STANDARD WALL PLAN DETAIL

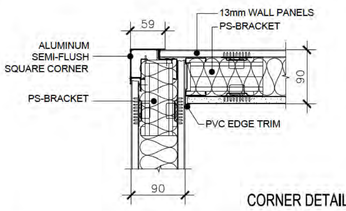


CORNER DETAIL

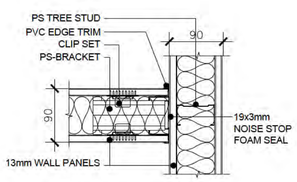

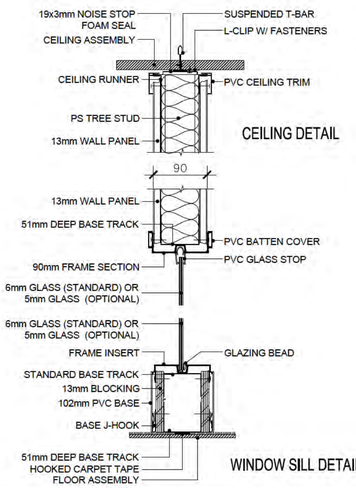


CEILING DETAIL

WINDOW SILL DETAIL

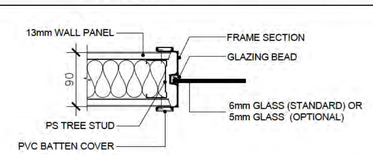


WINDOW JAMB DETAIL


WALL TOP CAP DETAIL

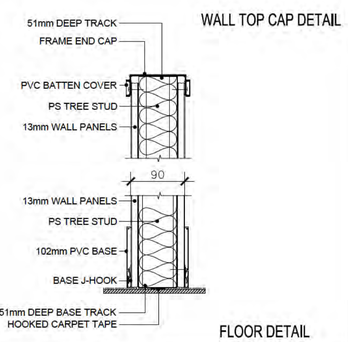


FLOOR DETAIL

DOOR HEAD DETAIL

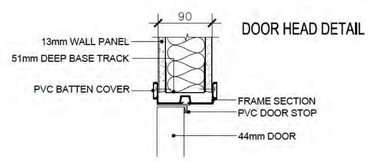

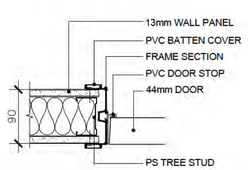

DOOR JAMB DETAIL

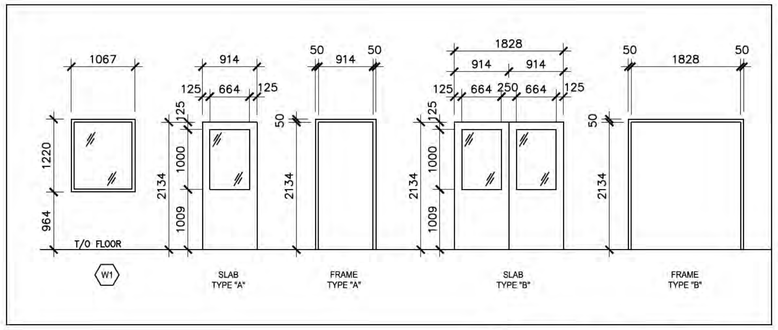

2 A701 WINDOW & DOOR ELEVATIONS
1:50

Stantec

Stantec Architecture Ltd.
202 107 Main Street
Whitehorse YT
Tel. 867.633.2400
www.stantec.com

The Contractor shall verify and be responsible for all dimensions. DO NOT scale the drawing - any errors or omissions shall be reported to Stantec without delay. The Copyrights to all designs and drawings are the property of Stantec. Reproduction or use for any purpose other than that authorized by Stantec is forbidden.

Legend

Revision		By	Appd.	YY.MM.DD
A	ISSUED FOR 65% DESIGN REVIEW	TF	JB	17.06.14

Issued — By — Appd. — YY.MM.DD

File Name: — Dwn. — Chkd. — Dsgn. — YY.MM.DD

Permit-Seal

PRELIMINARY
NOT TO BE USED FOR CONSTRUCTION


Client/Project
GOVERNMENT OF YUKON

MAIN ADMINISTRATION BUILDING
MAIN FLOOR INTERIOR RENOVATION
WHITEHORSE, Y.T.

Title
DETAILS


Project No.	Scale	
144902484	AS SHOWN	
Drawing No.	Sheet	Revision
A701	3 of 3	0

V:\1449\active\144902484\3000_prch\0A_drawings\architects\024844_701_details.dwg
2017/06/14 11:38 AM by Fletcher, Thor
ORIGINAL SHEET - ISO A1

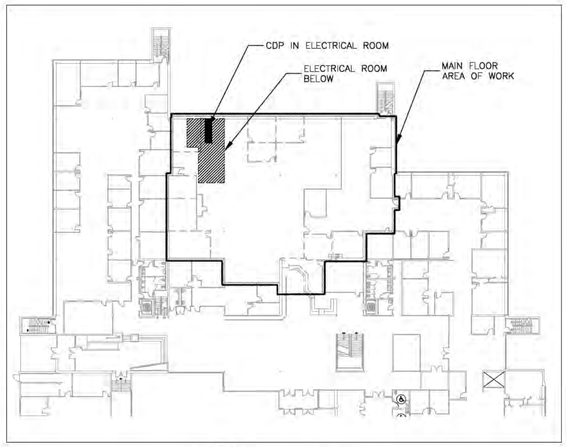

1 / E101 KEY PLAN
1:500

LEGEND	
	DUPLEX 5-15R RECEPTACLE
GF	DUPLEX 5-15R RECEPTACLE C/W INTEGRAL GFCI PROTECTION
PP	SERVICE COLUMN / PACK POLE (OUTLETS AS INDICATED)
J	CEILING MOUNTED JUNCTION OR OUTLET BOX
	POWER PANELBOARD
F	FIRE ALARM MANUAL STATION
EH	FIRE ALARM ELECTRONIC HORN/SOUNDER/CHIME c/w STROBE
S	FIRE ALARM SMOKE DETECTOR
	RECESSED LED LUMINAIRE, 1'x4'
	LINE VOLTAGE SWITCH (120V TO 347V)
D	LINE VOLTAGE DIMMER SWITCH
OS	LINE VOLTAGE SWITCH c/w OCCUPANCY SENSOR
	CEILING MOUNTED EXIT SIGN (TEXT ON SHADED SIDES, ARROWS AS INDICATED)
	WALL MOUNTED EXIT SIGN (TEXT ON SHADED SIDES)
#	WALL MOUNTED TELECOM OUTLET (# DENOTES NUMBER OF CABLES)
*	DEVICE MOUNTED ABOVE MILLWORK COUNTERTOP

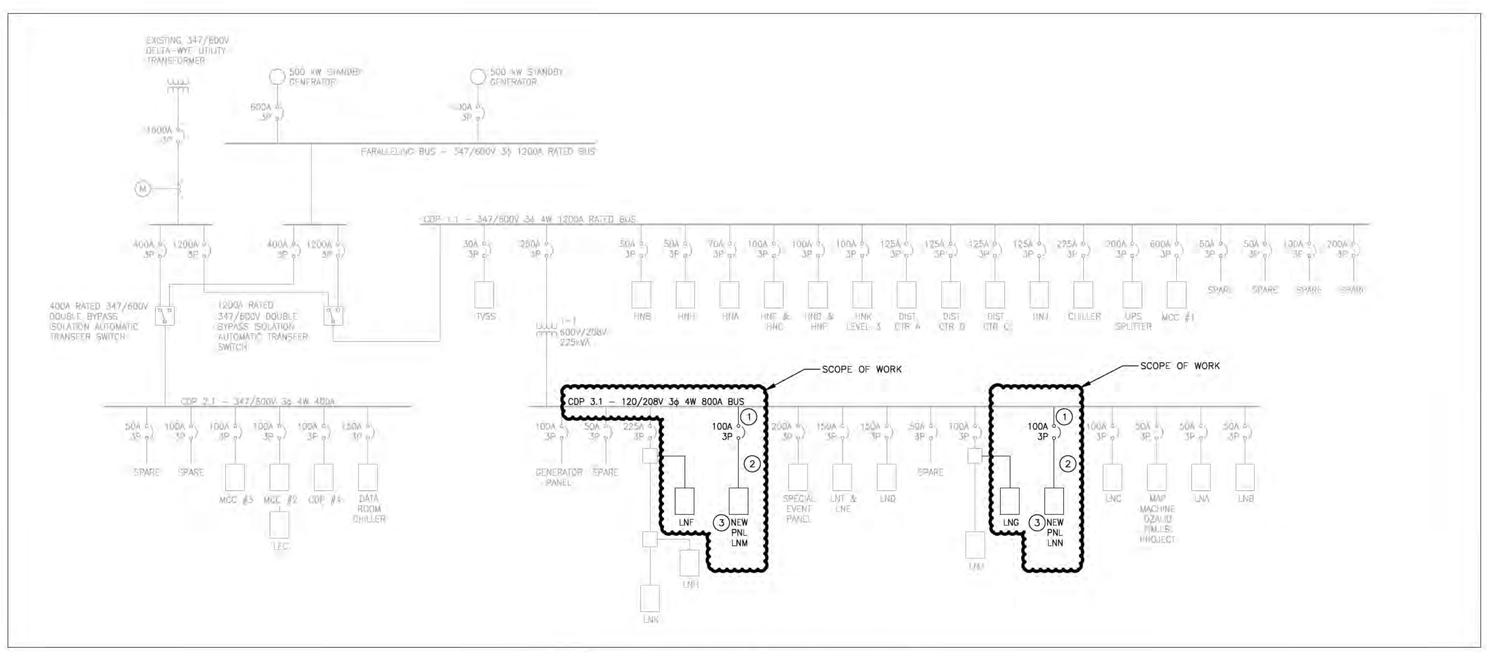

2 / E101 MODIFIED SINGLE LINE DIAGRAM
NTS

NOTES:

1. NEW 3P100A BREAKER
2. NEW SINGLE RUN OF 4C #3/0 AWG CU RW90 XLPE+ #6 CU BOND IN 53mm EMT CONDUIT
3. NEW 54CCT, 120/208V, 3ϕ, 225A BUS, PANEL
4. EXISTING CDP3.1 SCHNIDER SQUARE D

Stantec

Stantec Architecture Ltd.
202 107 Main Street
Whitehorse YT
Tel. 867.633.2400
www.stantec.com

The Contractor shall verify and be responsible for all dimensions. DO NOT scale the drawing - any errors or omissions shall be reported to Stantec without delay. The Copyrights to all designs and drawings are the property of Stantec. Reproduction or use for any purpose other than that authorized by Stantec is forbidden.

Consultants

Legend

GENERAL NOTES:

1. EXISTING INFORMATION PREPARED USING A COMBINATION OF OWNER SUPPLIED DRAWINGS FROM THE ORIGINAL 1974 CONSTRUCTION DRAWINGS THRU TO THE DRAWINGS DATED 2014. REVIEW EXACT LOCATIONS ON SITE. NOTIFY ENGINEER OF ANY SIGNIFICANT DISCREPANCANCIES PRIOR TO COMMENCEMENT OF WORK.

Revision	By	Appd.	YY.MM.DD
A ISSUED FO 65%	KG	JY	17.06.14

Issued	By	Appd.	YY.MM.DD
File Name:	Dwn.	Chkd.	Dsgn.	YY.MM.DD

Permit-Seal

PRELIMINARY
NOT TO BE USED FOR CONSTRUCTION

Client/Project
GOVERNMENT OF YUKON


MAIN ADMINISTRATION BUILDING
MAIN FLOOR INTERIOR RENOVATION
WHITEHORSE, Y.T.

Title
SINGLE LINE DIAGRAM, LEGEND

Project No.	Scale	
144902484	AS SHOWN	
Drawing No.	Sheet	Revision
E100	1 of 5	A

V:\1449\active\144902484\400_design\144902484_E100.dwg
2017/06/14 2:53 PM By: Gallich, Konrad

ORIGINAL SHEET - ISO A1

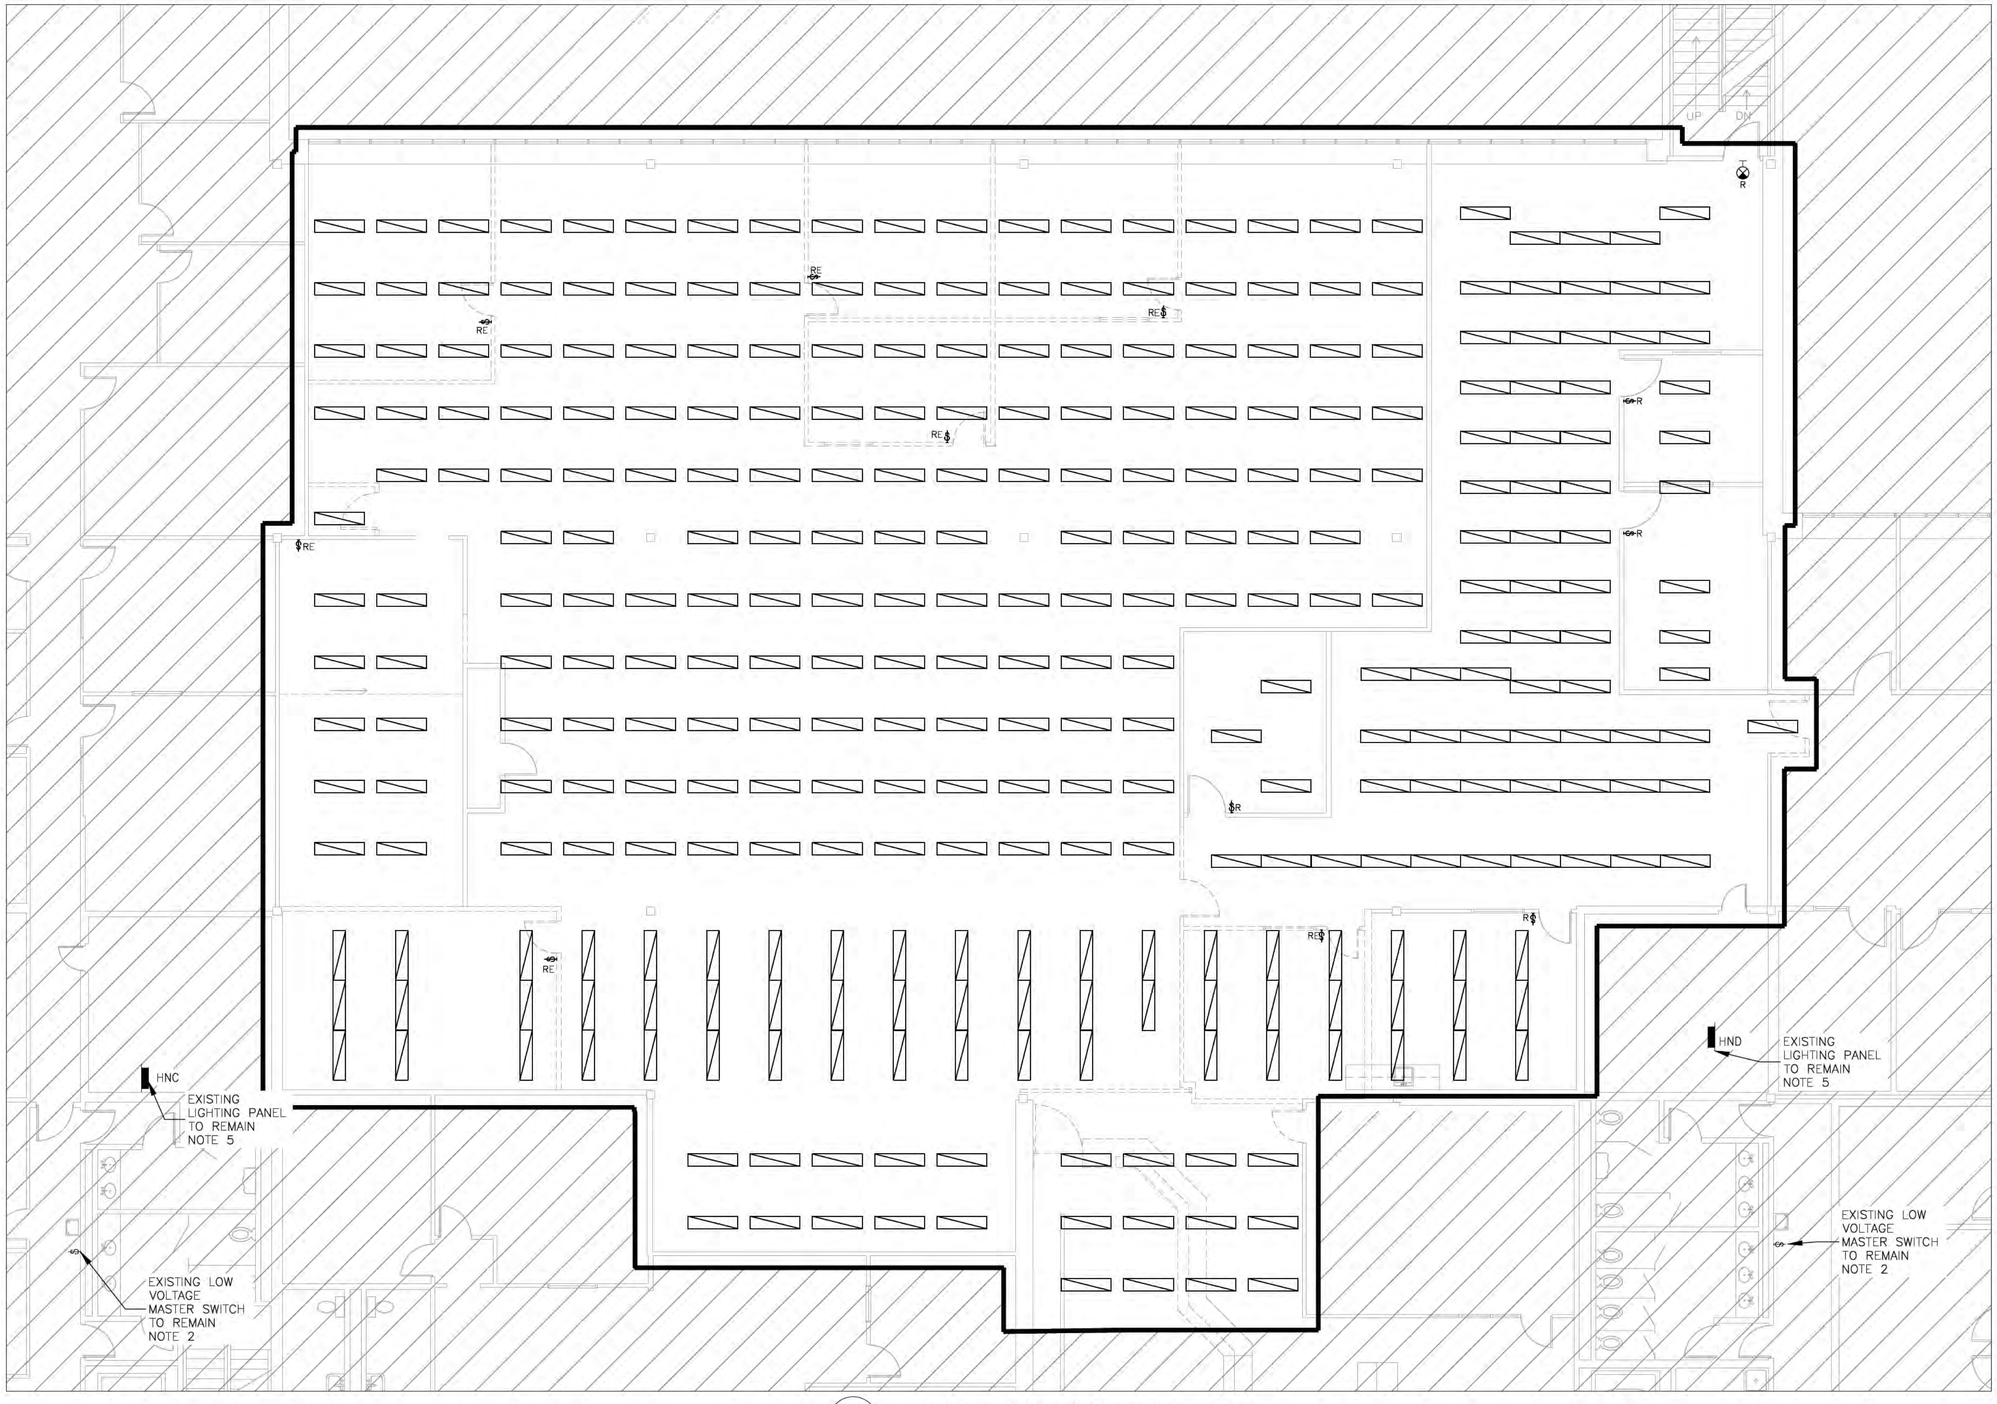

1 / E101 LIGHTING EXISTING/DEMOLITION LAYOUT
1:75

INDICATES AREAS NOT IN CONTRACT

NOTES:

1. ALL EXISTING LIGHTING FIXTURES AND SWITCHES TO BE REMOVED UNLESS OTHERWISE INDICATED.
2. MOVE ONLY SWITCH LEGS FOR AREA THAT IS IN CONTRACT. REFER TO 1/E103 FOR NEW MASTER SWITCH LOCATION.
3. LETTER 'RE' BESIDE DEVICE INDICATES THAT EXISTING EQUIPMENT SHOULD BE REMOVED AND ALL ASSOCIATED WIRING TO BE DISCONNECTED AND REMOVED.
4. LETTER 'R' BESIDE DEVICE INDICATES THAT EXISTING EQUIPMENT SHOULD REMAIN
5. EXISTING PANELS WESTINGHOUSE NQB

Stantec

Stantec Architecture Ltd.
202 107 Main Street
Whitehorse YT
Tel. 867.633.2400
www.stantec.com

The Contractor shall verify and be responsible for all dimensions. DO NOT scale the drawing - any errors or omissions shall be reported to Stantec without delay. The Copyrights to all designs and drawings are the property of Stantec. Reproduction or use for any purpose other than that authorized by Stantec is forbidden.

Consultants

Legend

GENERAL NOTES:

1. EXISTING INFORMATION PREPARED USING A COMBINATION OF OWNER SUPPLIED DRAWINGS FROM THE ORIGINAL 1974 CONSTRUCTION DRAWINGS THRU TO THE DRAWINGS DATED 2014. REVIEW EXACT LOCATIONS ON SITE. NOTIFY ENGINEER OF ANY SIGNIFICANT DISCREPANCANCIES PRIOR TO COMMENCEMENT OF WORK.

Revision	By	Appd.	YY.MM.DD
A ISSUED FO 65%	KG	JY	17.06.14

Issued	By	Appd.	YY.MM.DD
File Name:	Dwn.	Chkd.	Dsgn.

Permit-Seal

PRELIMINARY
NOT TO BE USED FOR CONSTRUCTION

Client/Project
GOVERNMENT OF YUKON


MAIN ADMINISTRATION BUILDING
MAIN FLOOR INTERIOR RENOVATION
WHITEHORSE, Y.T.

Title
LIGHTING EXISTING/DEMOLITION LAYOUT

Project No.	Scale	
144902484	AS SHOWN	
Drawing No.	Sheet	Revision
E101	2 of 5	A

V:\144P\active\144902484\400_elect\05_drawings\144902484_E100.dwg
2017/06/14 2:55 PM By: Colluch, Konrad

ORIGINAL SHEET - ISO A1

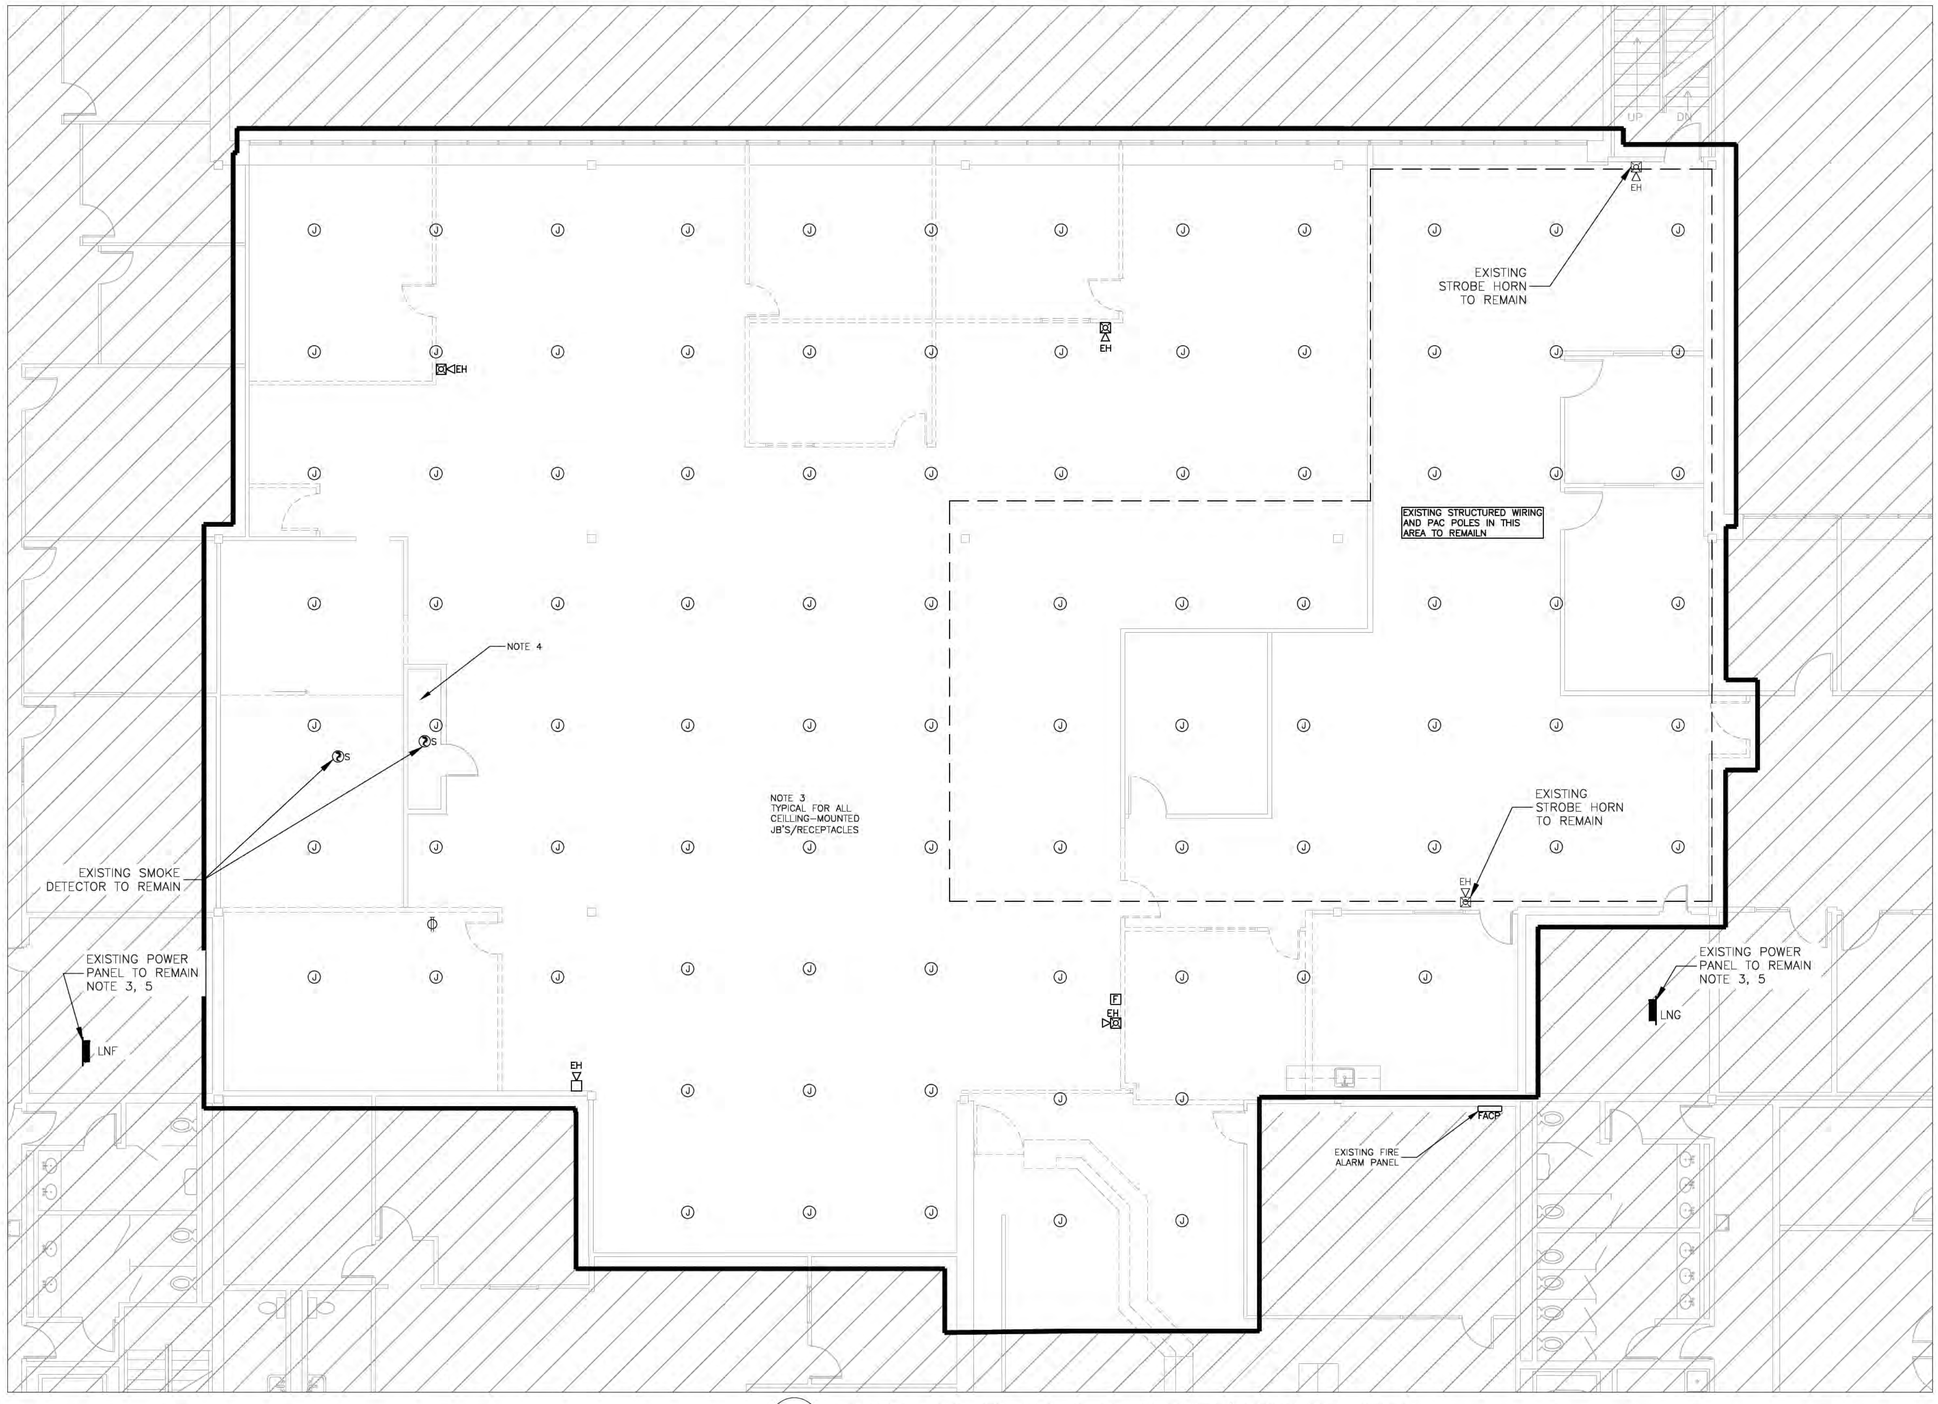

1 / E102 POWER, DATA AND FIRE ALARM EXISTING/DEMOLITION LAYOUT
1:75

INDICATES AREAS NOT IN CONTRACT

NOTES:

1. RECEPTACLES AND FIRE ALARM DEVICES TO BE REMOVED UNLESS OTHERWISE INDICATED.
2. EXISTING PAC POLES (NOT SHOWN) TO BE REMOVED UNLESS OTHERWISE SHOWN.
3. EXISTING JB/QUAD RECEPTACLES IN CEILING SPACE FOR PAC POLE CONNECTION TO REMAIN. JB/QUAD RECEPTACLES TO BE RE-CIRCUITED FROM PANELS LNF/LNG TO NEW PANELS AS PER DRAWING E104.
4. ALL EXISTING DATA CABLING TO BE REMOVED BACK TO LAN CLOSET UNLESS OTHERWISE SHOWN.
5. EXISTING PANEL WESTINGHOUSE NQB

GENERAL NOTES:

1. EXISTING INFORMATION PREPARED USING A COMBINATION OF OWNER SUPPLIED DRAWINGS FROM THE ORIGINAL 1974 CONSTRUCTION DRAWINGS THRU TO THE DRAWINGS DATED 2014. REVIEW EXACT LOCATIONS ON SITE. NOTIFY ENGINEER OF ANY SIGNIFICANT DISCREPANCANCIES PRIOR TO COMMENCEMENT OF WORK.

Stantec

Stantec Architecture Ltd.
202 107 Main Street
Whitehorse YT
Tel. 867.633.2400
www.stantec.com

The Contractor shall verify and be responsible for all dimensions. DO NOT scale the drawing - any errors or omissions shall be reported to Stantec without delay. The Copyrights to all designs and drawings are the property of Stantec. Reproduction or use for any purpose other than that authorized by Stantec is forbidden.

Consultants

Legend

Revision	By	Appd.	YY.MM.DD
A ISSUED FO 65%	KG	JY	17.06.14

Issued	By	Appd.	YY.MM.DD
File Name:	Dwn.	Chkd.	Dsgn. YY.MM.DD

Permit-Seal

PRELIMINARY
NOT TO BE USED FOR CONSTRUCTION

Client/Project
GOVERNMENT OF YUKON


MAIN ADMINISTRATION BUILDING
MAIN FLOOR INTERIOR RENOVATION
WHITEHORSE, Y.T.

Title
POWER, DATA AND FIRE ALARM EXISTING/DEMOLITION LAYOUT

Project No.	Scale	
144902484	AS SHOWN	
Drawing No.	Sheet	Revision
E102	3 of 5	A

V:\144902484\active\144902484.0400_elec\04_drawings\144902484_E102.dwg
2017/06/14 2:55 PM By: Golich, Konrad

ORIGINAL SHEET - ISO A1

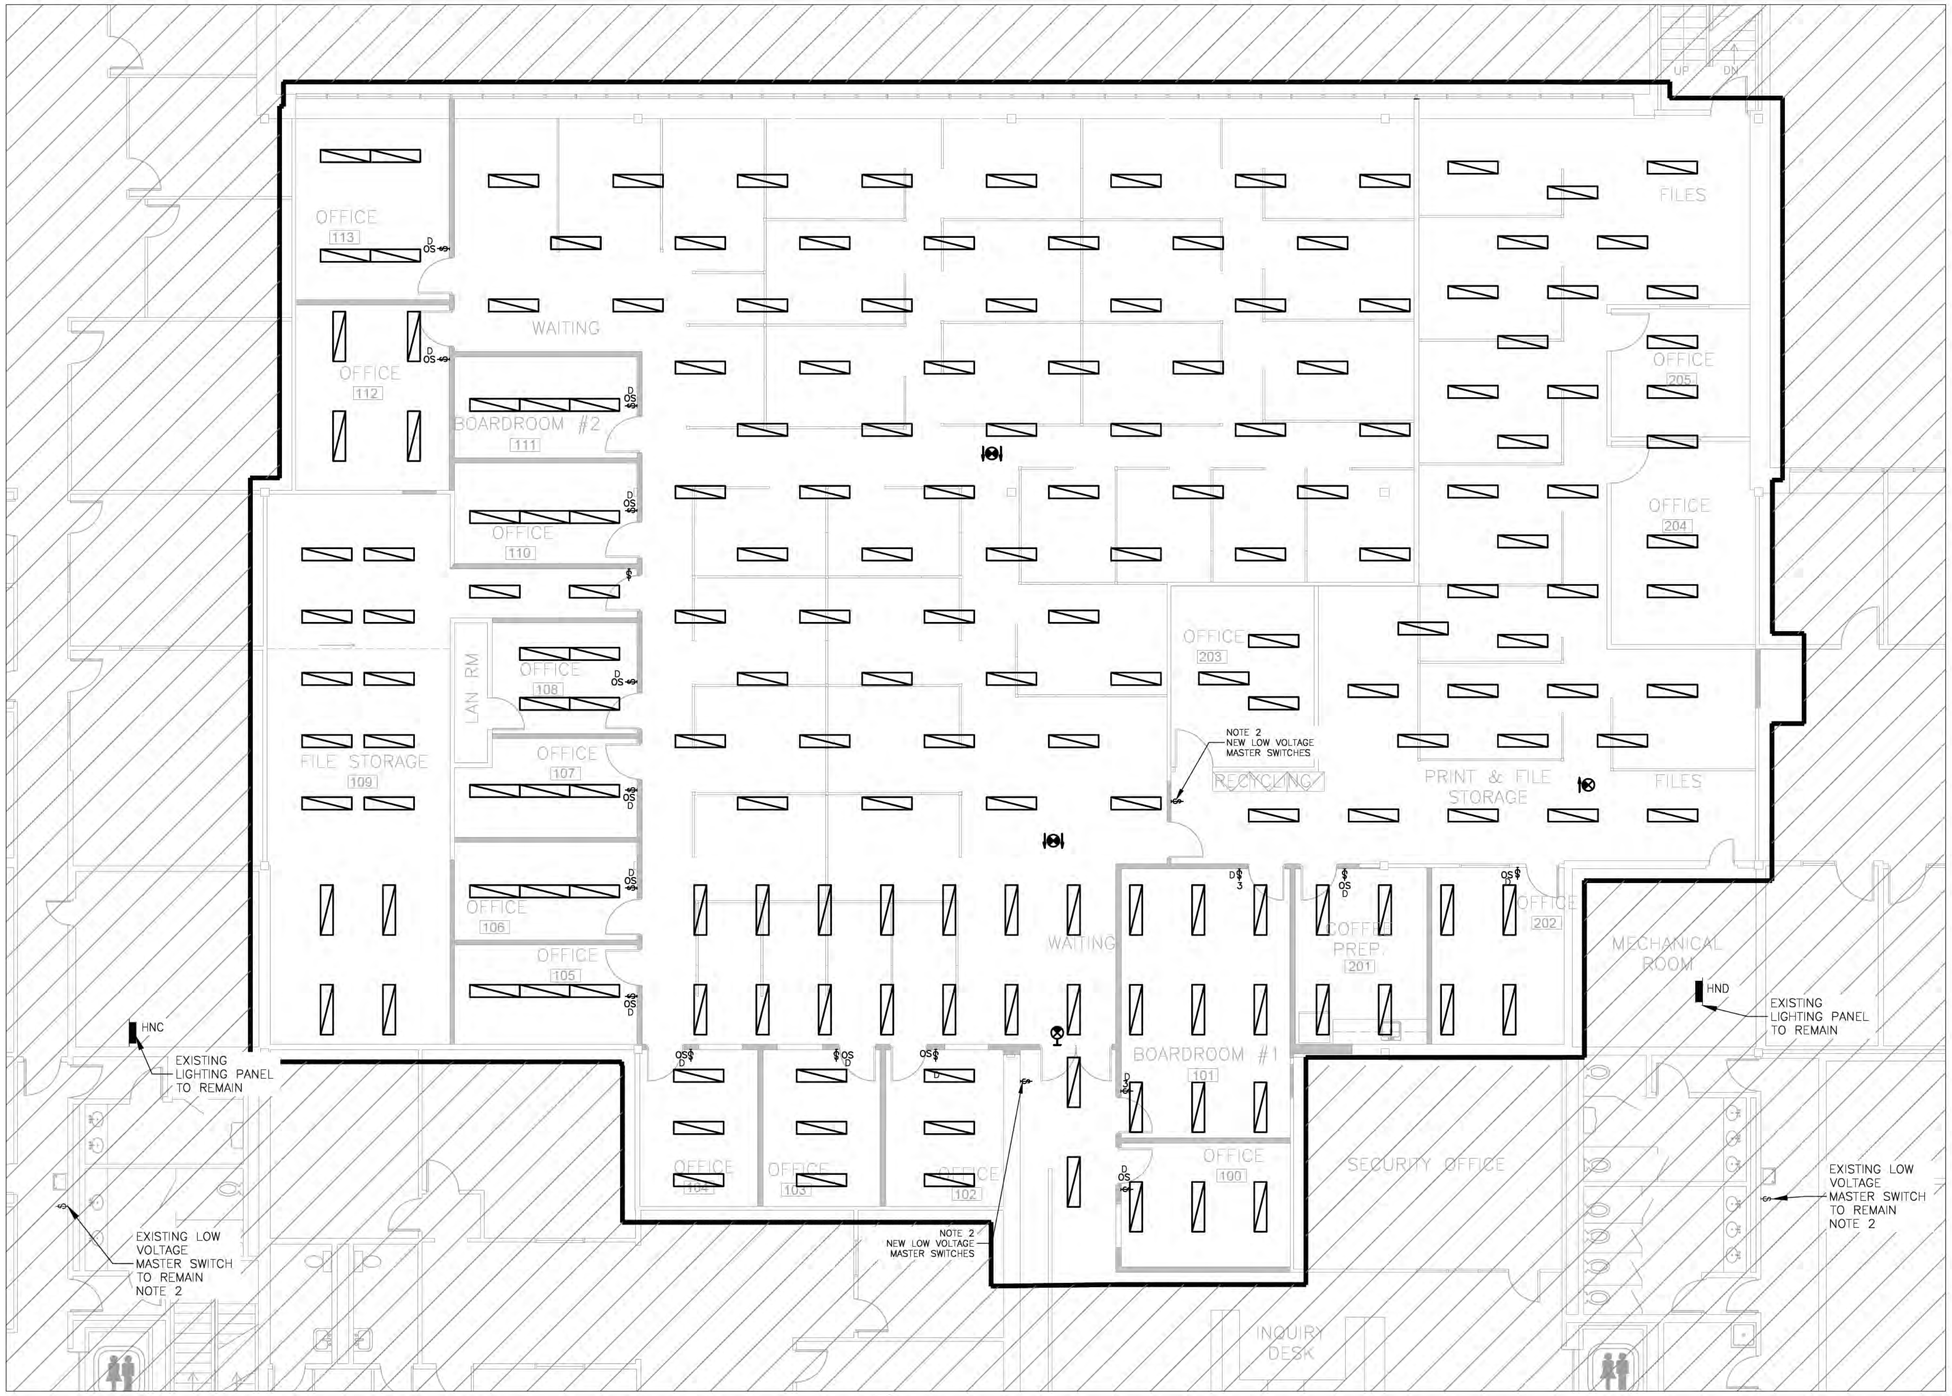

1 / E103 LIGHTING NEW LAYOUT
1:75

INDICATES AREAS NOT IN CONTRACT

NOTES:

1. ONLY NEW LIGHTING FIXTURES AND SWITCHES SHOWN.
2. EXISTING MASTER SWITCH LEGS FOR OPEN OFFICE AREAS TO BE RELOCATED TO NEW MASTER SWITCH LOCATIONS.

LUMINAIRE SCHEDULE

	DESCRIPTION	LAMP	MOUNTING	VOLTAGE	WATTAGE	LUMENS DELIVERED	DETAILS
	305x1220mm DIRECT/INDIRECT TROFFER	LED	RECESSED	347	21	2500	CRI<85 CCT 4000K 0-10V DIMMING DRIVER TO BE EATON 14EN SERIES OR APPROVED EQUIVALENT.

Stantec

Stantec Architecture Ltd.
202 107 Main Street
Whitehorse YT
Tel. 867.633.2400
www.stantec.com

The Contractor shall verify and be responsible for all dimensions. DO NOT scale the drawing - any errors or omissions shall be reported to Stantec without delay. The Copyrights to all designs and drawings are the property of Stantec. Reproduction or use for any purpose other than that authorized by Stantec is forbidden.

Consultants

Legend

GENERAL NOTES:

1. EXISTING INFORMATION PREPARED USING A COMBINATION OF OWNER SUPPLIED DRAWINGS FROM THE ORIGINAL 1974 CONSTRUCTION DRAWINGS THRU TO THE DRAWINGS DATED 2014. REVIEW EXACT LOCATIONS ON SITE. NOTIFY ENGINEER OF ANY SIGNIFICANT DISCREPANCIES PRIOR TO COMMENCEMENT OF WORK.

Revision	By	Appd.	YY.MM.DD
A ISSUED FO 65%	KG	JY	17.06.14

Issued	By	Appd.	YY.MM.DD
File Name:	Dwn.	Chkd.	Dsgn. YY.MM.DD

Permit-Seal

PRELIMINARY
NOT TO BE USED FOR CONSTRUCTION

Client/Project
GOVERNMENT OF YUKON


MAIN ADMINISTRATION BUILDING
MAIN FLOOR INTERIOR RENOVATION
WHITEHORSE, Y.T.

Title
LIGHTING NEW LAYOUT

Project No.	Scale	
144902484	AS SHOWN	
Drawing No.	Sheet	Revision
E103	4 of 5	A

V:\1449\active\144902484\3400_allect\0s_drawings\144902484_E100.dwg
2017/06/14 2:55 PM By: Gallon, Konrad

ORIGINAL SHEET - ISO A1

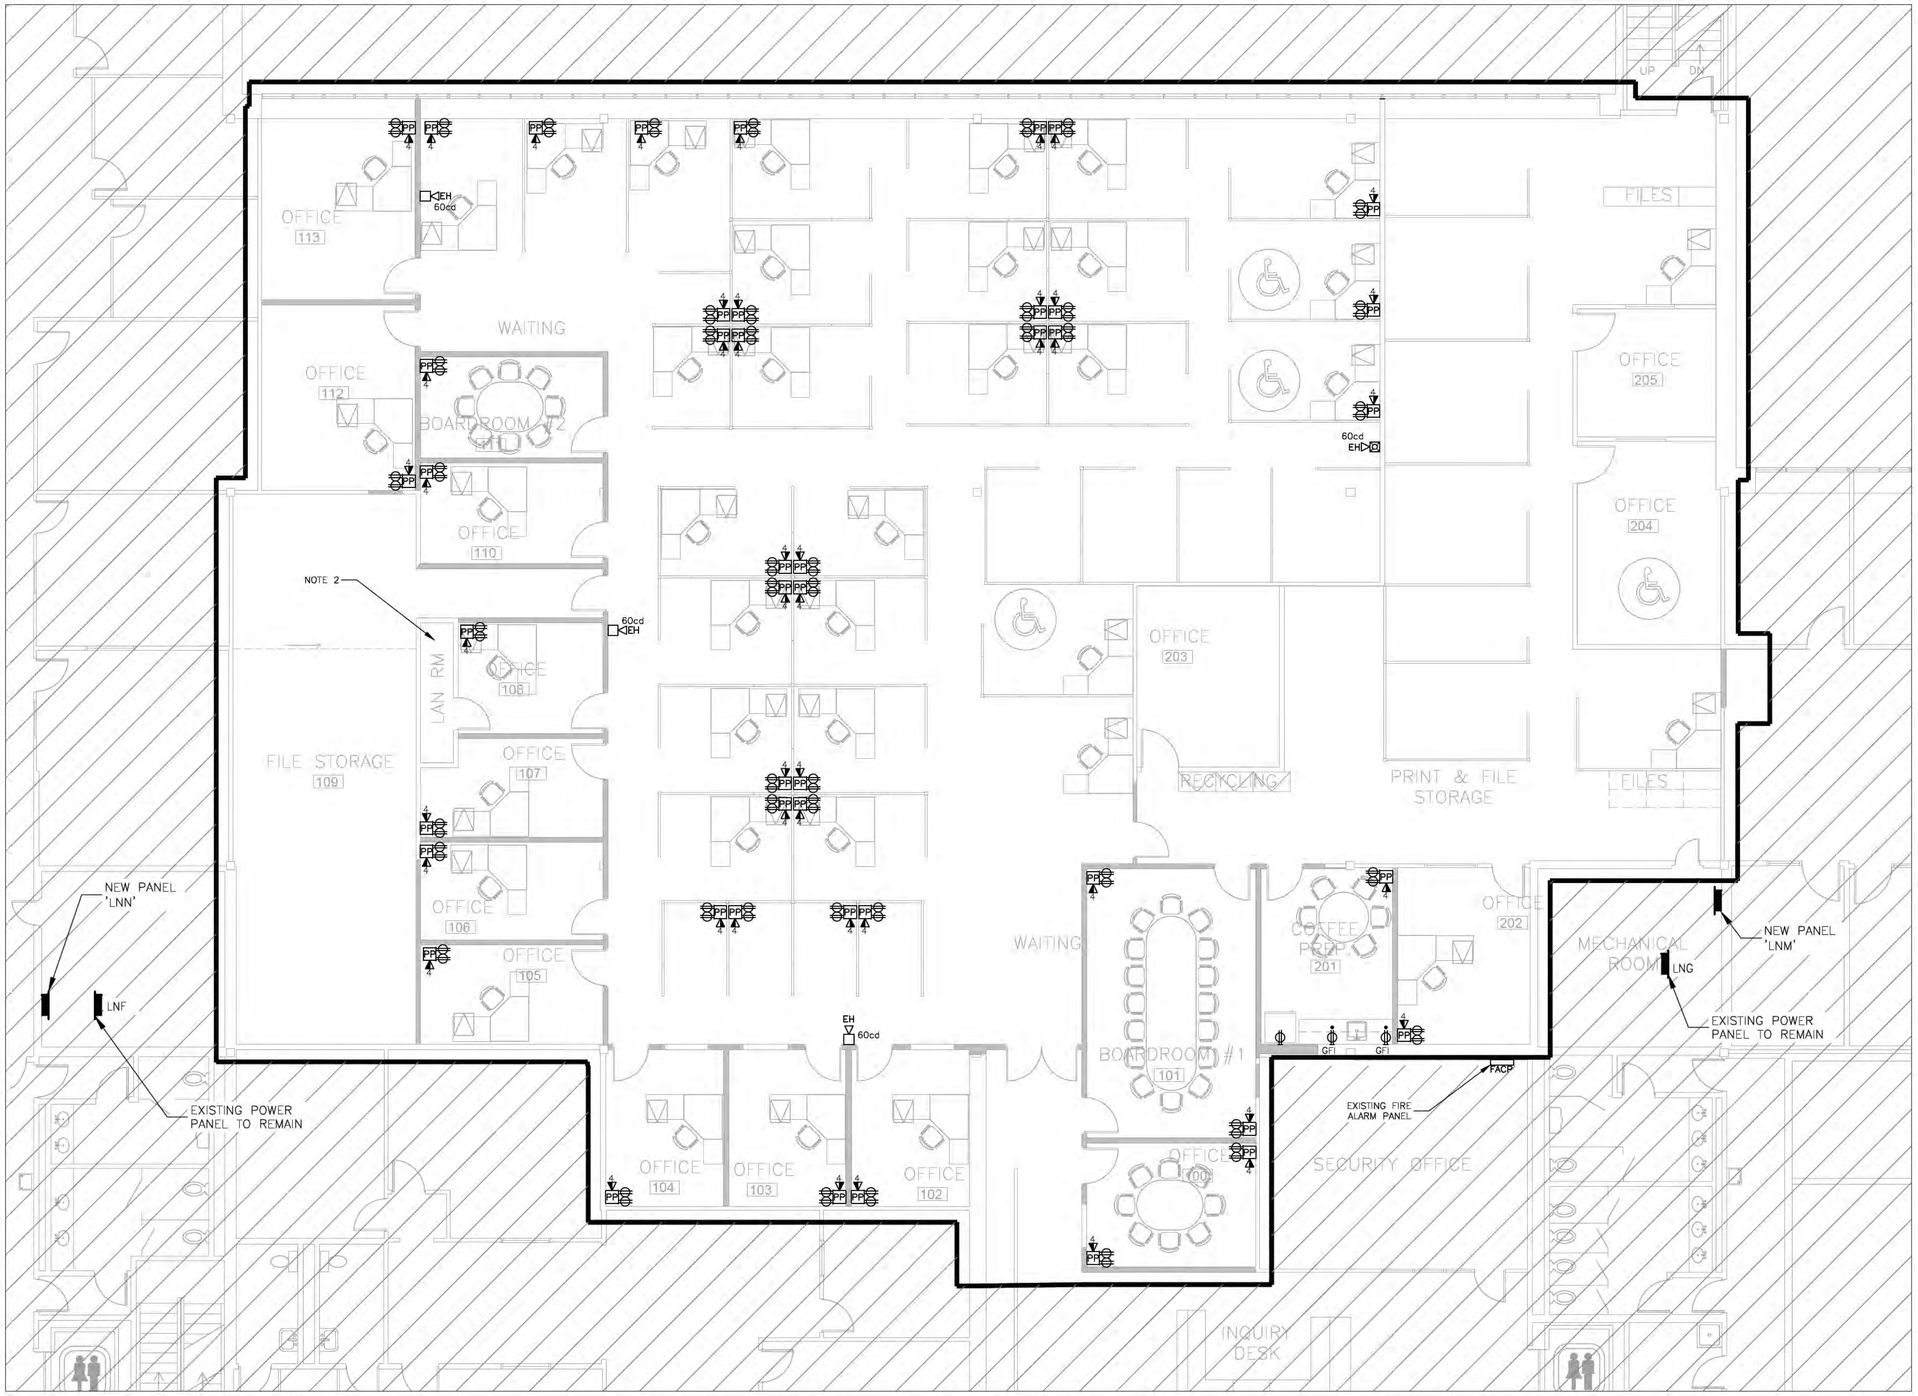

1 / E104 POWER, DATA AND FIRE ALARM SYSTEM NEW LAYOUT
1:75

INDICATES AREAS NOT IN CONTRACT

NOTES:

1. ALL DEVICES SHOWN ARE TO BE NEW UNLESS OTHERWISE INDICATED.
2. ALL CAT 6 DATA CABLING HOME RUNS TO TERMINATE AT LAN CLOSET.

GENERAL NOTES:

1. EXISTING INFORMATION PREPARED USING A COMBINATION OF OWNER SUPPLIED DRAWINGS FROM THE ORIGINAL 1974 CONSTRUCTION DRAWINGS THRU TO THE DRAWINGS DATED 2014. REVIEW EXACT LOCATIONS ON SITE. NOTIFY ENGINEER OF ANY SIGNIFICANT DISCREPANCANCIES PRIOR TO COMMENCEMENT OF WORK.

Stantec

Stantec Architecture Ltd.
202 107 Main Street
Whitehorse YT
Tel. 867.633.2400
www.stantec.com

The Contractor shall verify and be responsible for all dimensions. DO NOT scale the drawing - any errors or omissions shall be reported to Stantec without delay. The Copyrights to all designs and drawings are the property of Stantec. Reproduction or use for any purpose other than that authorized by Stantec is forbidden.

Consultants

Legend

Revision	By	Appd.	YY.MM.DD
A ISSUED FO 65%	KG	JY	17.06.14

Issued	By	Appd.	YY.MM.DD
File Name:	Dwn.	Chkd.	Dsgn. YY.MM.DD

Permit-Seal

PRELIMINARY
NOT TO BE USED FOR CONSTRUCTION

Client/Project
GOVERNMENT OF YUKON

MAIN ADMINISTRATION BUILDING
MAIN FLOOR INTERIOR RENOVATION
WHITEHORSE, Y.T.

Title
POWER, DATA AND FIRE ALARM SYSTEM NEW LAYOUT

Project No.	Scale	
144902484	AS SHOWN	
Drawing No.	Sheet	Revision
E104	5 of 5	A

V:\1449\active\144902484\0400_elec\05_drawings\144902484_E103.dwg
2017/06/14 2:55 PM By: Galuch, Konrad


ORIGINAL SHEET - ISO A1

HVAC SYMBOLS

- ###x### — RECTANGULAR DUCT
- ###ø — ROUND DUCT
- SQUARE ELBOW TURN (SUPPLY UP/DOWN)
- SQUARE ELBOW TURN (RETURN UP/DOWN)
- ELBOW, ROUND, SMOOTH RADIUS (UP/DOWN)
- TEE, 45 DEG., RECTANGULAR MAIN AND BRANCH
- TEE, 45 DEG., RECTANGULAR MAIN AND BRANCH, SQUARE TO ROUND
- TEE, 45 DEG., ROUND MAIN AND BRANCH
- ELBOW, RECTANGULAR, SMOOTH RADIUS WITHOUT VANES (1.5 R/W DEFAULT)
- ELBOW, ROUND, SMOOTH RADIUS (1.5 R/W DEFAULT)
- ELBOWS, 90 DEG., RECTANGULAR TEE
- TRANSITION, RECTANGULAR, PYRAMIDAL (30° CONTRACTUAL ANGLE DEFAULT)
- SINGLE–LINE DUCT BRANCH
- SINGLE–LINE DUCT TAKEOFF
- DUCT CAP
- DUCT BREAK
- SINGLE–LINE SUPPLY OR RETURN DUCT
- SINGLE–LINE EXHAUST DUCT
- T — THERMOSTAT
- SINGLE SLOT TROFFER
- RETURN GRILLE
- CEILING DIFFUSER 600x600/300x300
- AIR FLOW ARROWS
- VAV BOX (REFER TO SCHEDULE)
- QUANTITY / TYPE / SIZE (mm) / VOLUME (L/s) — AIR OUTLET TAG (REFER TO SCHEDULE)
- DOOR GRILLE TAG (REFER TO SCHEDULE)
- DAMPER TAG — BD – BALANCING, CD – CONTROL
- FD — TYPE (2/1) / RATING (hrs) — FIRE DAMPER TAG
- EQUIPMENT TAG

KEYNOTES:

1. REMOVE & SALVAGE R/A GRILLE FOR RE–USE IN NEW T–BAR CEILING.
2. REMOVE & SALVAGE EXISTING PNEUMATIC T–STAT FOR RE–USE. TURN OVER AN EXTRA REMOVED T–STATS NOT REUSED TO BUILDING MAINTAINER.

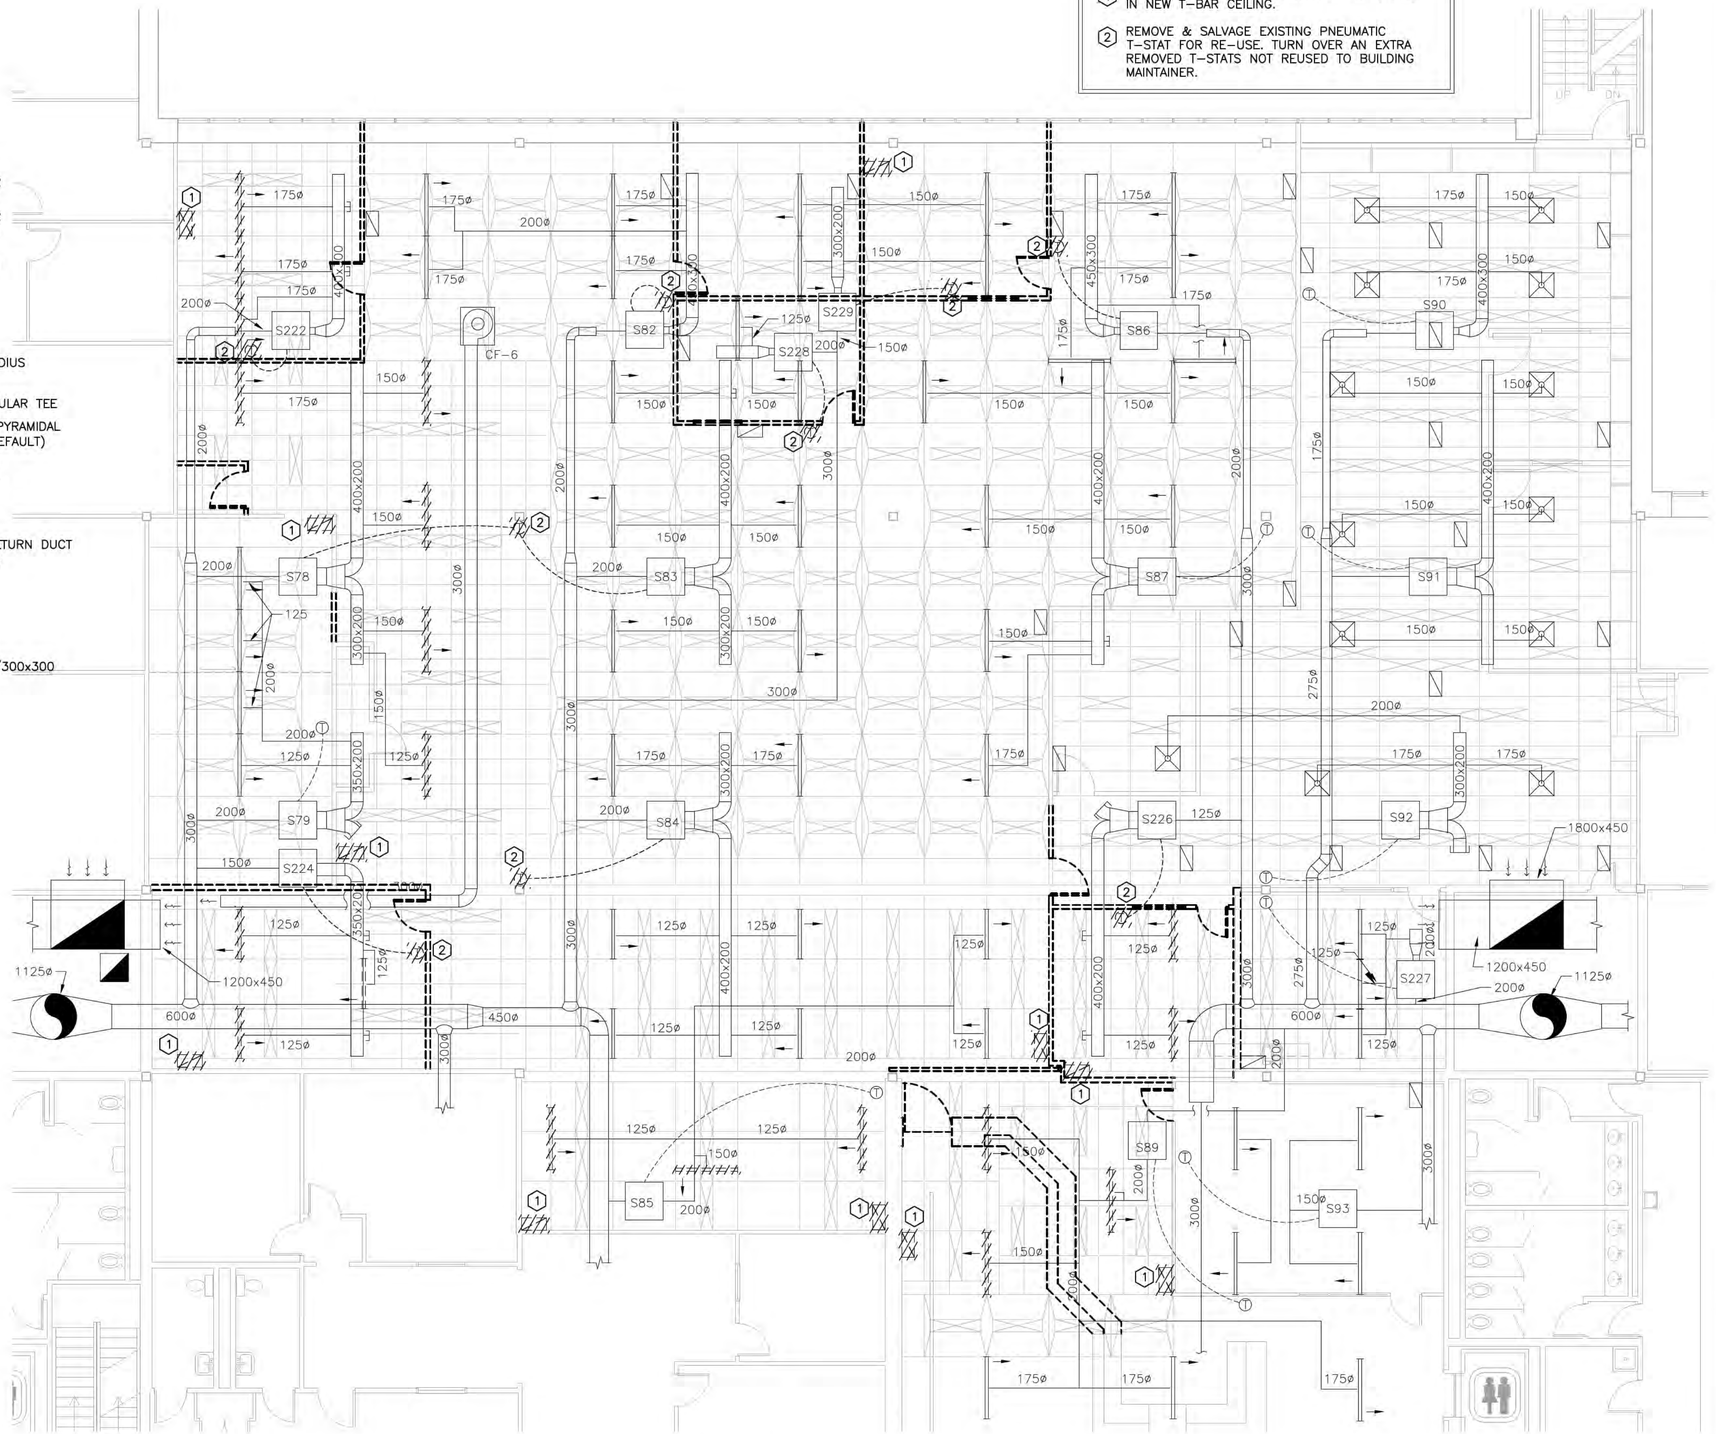

1 / M101 VENTILATION PLAN – DEMOLITION
SCALE: 1:75

Stantec

Stantec Architecture Ltd.
202 107 Main Street
Whitehorse YT
Tel. 867.633.2400
www.stantec.com

The Contractor shall verify and be responsible for all dimensions. DO NOT scale the drawing - any errors or omissions shall be reported to Stantec without delay. The Copyrights to all designs and drawings are the property of Stantec. Reproduction or use for any purpose other than that authorized by Stantec is forbidden.

Consultants

Legend

- EXISTING WALLS
- CUBICLES
- DEMOLITION
- NEW WALL CONSTRUCTION
- ALLOCATED WORKSPACE

BY OTHERS (FOR INFO ONLY)

LIGHT = EXIST
DARK = NEW
AREA TO BE DEMOLISHED

Revision	By	Appd.	YY.MM.DD
A ISSUED FOR 65% PEER REVIEW	BZ	BZ	17.06.08

Issued	By	Appd.	YY.MM.DD
File Name: 02484_M100_plans.dwg	BZ Dwn.	SB Chkd.	BZ Dsgn. 17.06.12

Permit-Seal

PRELIMINARY
NOT TO BE USED FOR CONSTRUCTION

Client/Project
GOVERNMENT OF YUKON

MAIN ADMINISTRATION BUILDING
MAIN FLOOR INTERIOR RENOVATION
WHITEHORSE, Y.T.

Title
VENTILATION PLAN
DEMOLITION


Project No.	Scale	
144902484	AS SHOWN @ ISO A1	
Drawing No.	Sheet	Revision
M101	1 of 5	A

V:\1447\active\144902484\0000_mech\06_drawings\02484_M100_plans.dwg
2017.06.08 12:40 PM by Zoom Bretton

ORIGINAL SHEET - ISO A1

KEYNOTES:

1. RE-USE SALVAGED R/A GRILLE.
2. RE-USE SALVAGE PNEUMATIC T-STAT. PROVIDE NEW PNEUMATIC TUBING FOR FULL LENGTH FROM T-STAT TO VAV BOX.

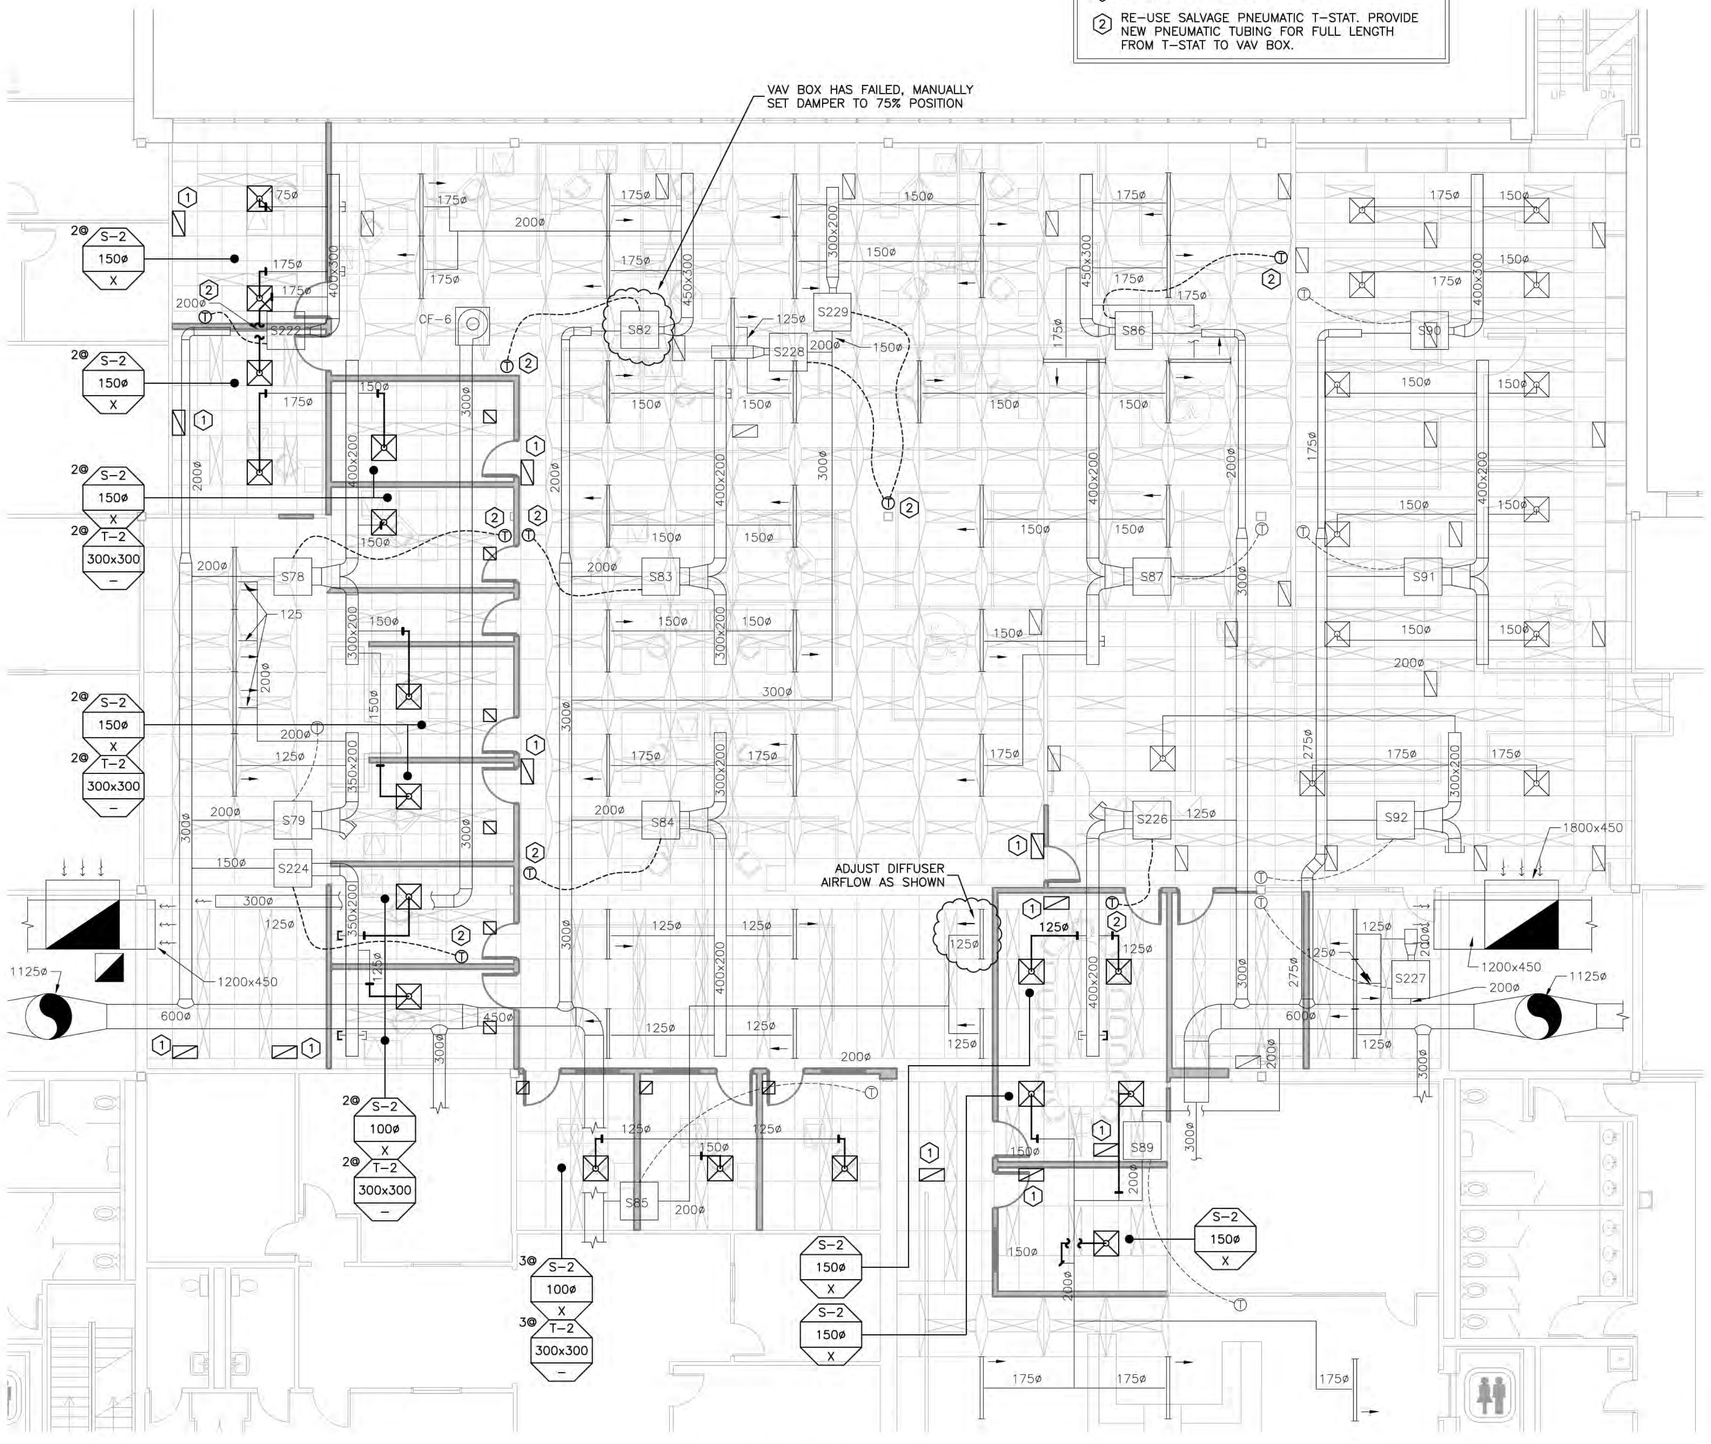

1 / M102 VENTILATION PLAN – NEW
SCALE: 1:75

Stantec Architecture Ltd.
202 107 Main Street
Whitehorse YT
Tel. 867.633.2400
www.stantec.com

The Contractor shall verify and be responsible for all dimensions. DO NOT scale the drawing - any errors or omissions shall be reported to Stantec without delay. The Copyrights to all designs and drawings are the property of Stantec. Reproduction or use for any purpose other than that authorized by Stantec is forbidden.

Consultants

Legend

- EXISTING WALLS
- CUBICLES
- DEMOLITION
- NEW WALL CONSTRUCTION
- ALLOCATED WORKSPACE

BY OTHERS (FOR INFO ONLY)

LIGHT = EXIST
DARK = NEW
AREA TO BE DEMOLISHED

Revision	By	Appd.	YY.MM.DD
A ISSUED FOR 65% PEER REVIEW	BZ	BZ	17.06.08
Issued	By	Appd.	YY.MM.DD
File Name: 02484_M100_plans.dwg	BZ Dwn.	SB Chkd.	BZ Dsgn.	17.06.12 YY.MM.DD

Permit-Seal

PRELIMINARY
NOT TO BE USED FOR CONSTRUCTION

Client/Project
GOVERNMENT OF YUKON

MAIN ADMINISTRATION BUILDING
MAIN FLOOR INTERIOR RENOVATION
WHITEHORSE, Y.T.

Title
VENTILATION PLAN
NEW

Project No.	Scale	
144902484	AS SHOWN @ ISO A1	
Drawing No.	Sheet	Revision
M102	2 of 5	A

V:\1-MAP\active\144902484\03000_mech\10&_drawings\02484_M100_plans.dwg
2017/06/08 12:40 PM by: Darrin Bertsch

ORIGINAL SHEET - ISO A1

PIPING IDENTIFICATION AND SYMBOLS


- SAN — SANITARY DRAIN (ABOVE GRADE OR FLOOR)
- SAN — SANITARY DRAIN (BELOW GRADE OR FLOOR)
- V — VENT
- DOMESTIC COLD WATER
- DOMESTIC HOT WATER
- DOMESTIC HOT WATER RECIRC.
- PIPE CAP
- PIPE BREAK
- FLOW ARROW
- PIPING ELBOW DOWN
- PIPING ELBOW UP
- PIPING TEE UP
- PIPING TEE DOWN
- PIPING TEE
- SANITARY/STORM BRANCH
- CO — STANDARD CLEAN–OUT IN LINE END OF RUN
- % SLOPE — PIPING SLOPE
- FIXTURE TRAP
- BUILDING TRAP
- FD — FLOOR DRAIN
- GATE VALVE
- GLOBE VALVE
- BALL VALVE
- BALANCING VALVE
- PRESSURE GAUGE AND COCK
- UNION CONNECTION
- THERMOMETER
- VACUUM BREAKER
- TYPE / QUANTITY — PLUMBING FIXTURE TAG (REFER TO SCHEDULE)
- PLUMBING FIXTURES

FIRE PROTECTION

- SP — SPRINKLER LINE
- FIRE EXTINGUISHER
- UPRIGHT SPRINKLER
- PENDANT SPRINKLER
- SIDEWALL SPRINKLER
- DP — DRY PENDANT SPRINKLER
- DP — DRY SIDEWALL SPRINKLER

KEYNOTES:

1. RELOCATE SPRINKLER HEAD PER 1/M202

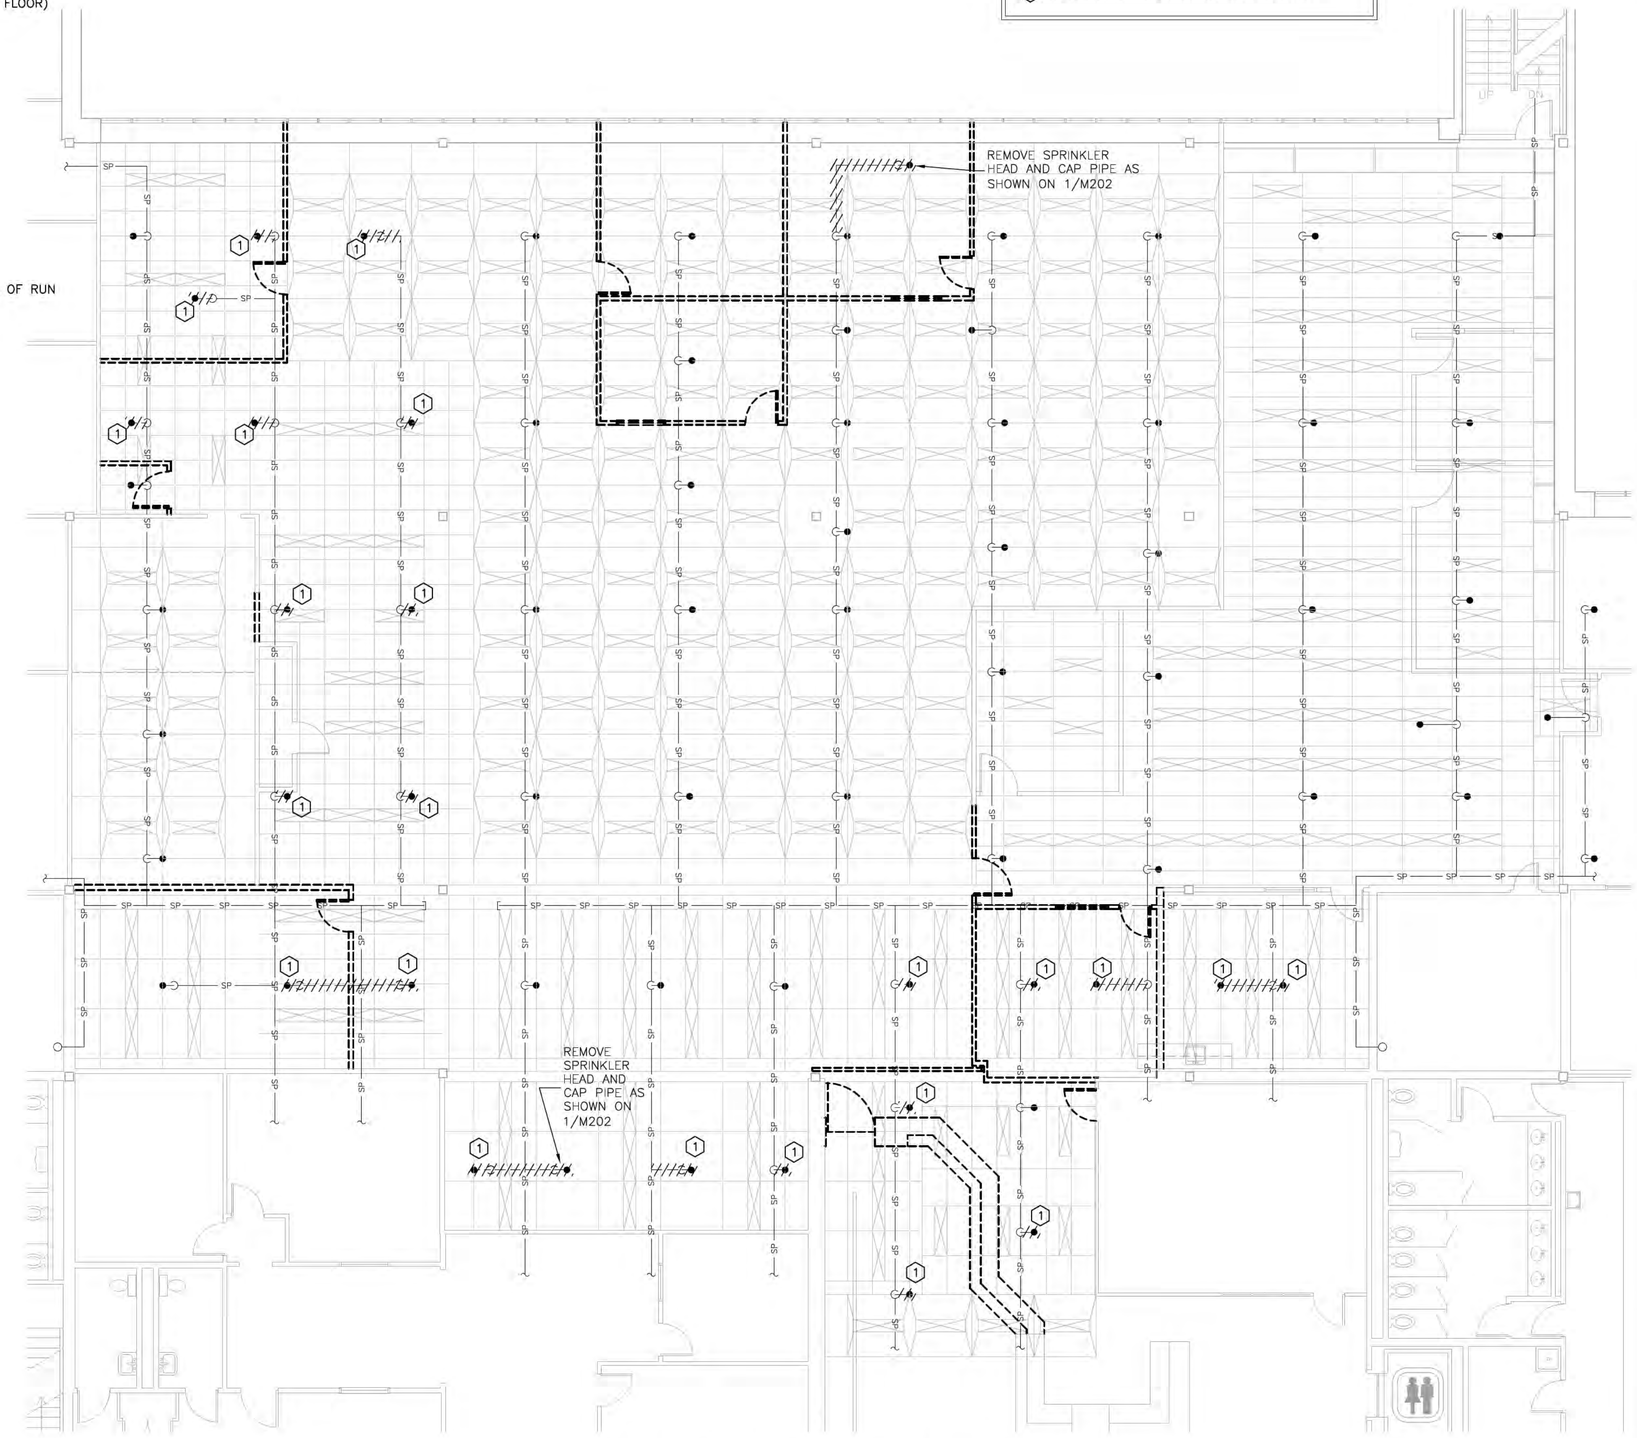

1 / M201 PLUMBING & FIRE PROTECTION PLAN – DEMOLITION
SCALE: 1:75

Stantec

Stantec Architecture Ltd.
202 107 Main Street
Whitehorse YT
Tel. 867.633.2400
www.stantec.com

The Contractor shall verify and be responsible for all dimensions. DO NOT scale the drawing - any errors or omissions shall be reported to Stantec without delay. The Copyrights to all designs and drawings are the property of Stantec. Reproduction or use for any purpose other than that authorized by Stantec is forbidden.

Consultants

Legend

- EXISTING WALLS
- CUBICLES
- DEMOLITION
- NEW WALL CONSTRUCTION
- ALLOCATED WORKSPACE

BY OTHERS (FOR INFO ONLY)

LIGHT = EXIST
DARK = NEW
AREA TO BE DEMOLISHED

Revision	By	Appd.	YY.MM.DD
A ISSUED FOR 65% PEER REVIEW	BZ	BZ	17.06.08

Issued	By	Appd.	YY.MM.DD
File Name: 02484_M100_plans.dwg	BZ Dwn.	SB Chkd.	BZ Dsgn.	17.06.12 YY.MM.DD

Permit-Seal

PRELIMINARY
NOT TO BE USED FOR CONSTRUCTION

Client/Project
GOVERNMENT OF YUKON

MAIN ADMINISTRATION BUILDING
MAIN FLOOR INTERIOR RENOVATION
WHITEHORSE, Y.T.

Title
PLUMBING & FIRE PROTECTION PLAN DEMOLITION


Project No.	Scale	
144902484	AS SHOWN @ ISO A1	
Drawing No.	Sheet	Revision
M201	3 of 5	A

Y:\1447\active\144902484\0300_mech\06_drawings\02484_M100_plans.dwg
2017/06/08 12:40 PM By: Zach Shenton

ORIGINAL SHEET - ISO A1

KEYNOTES:

(1) RELOCATE SPRINKLER HEAD AS INDICATED, PIPE SIZE PER EXISTING SERVING HEAD (MIN 25ø).

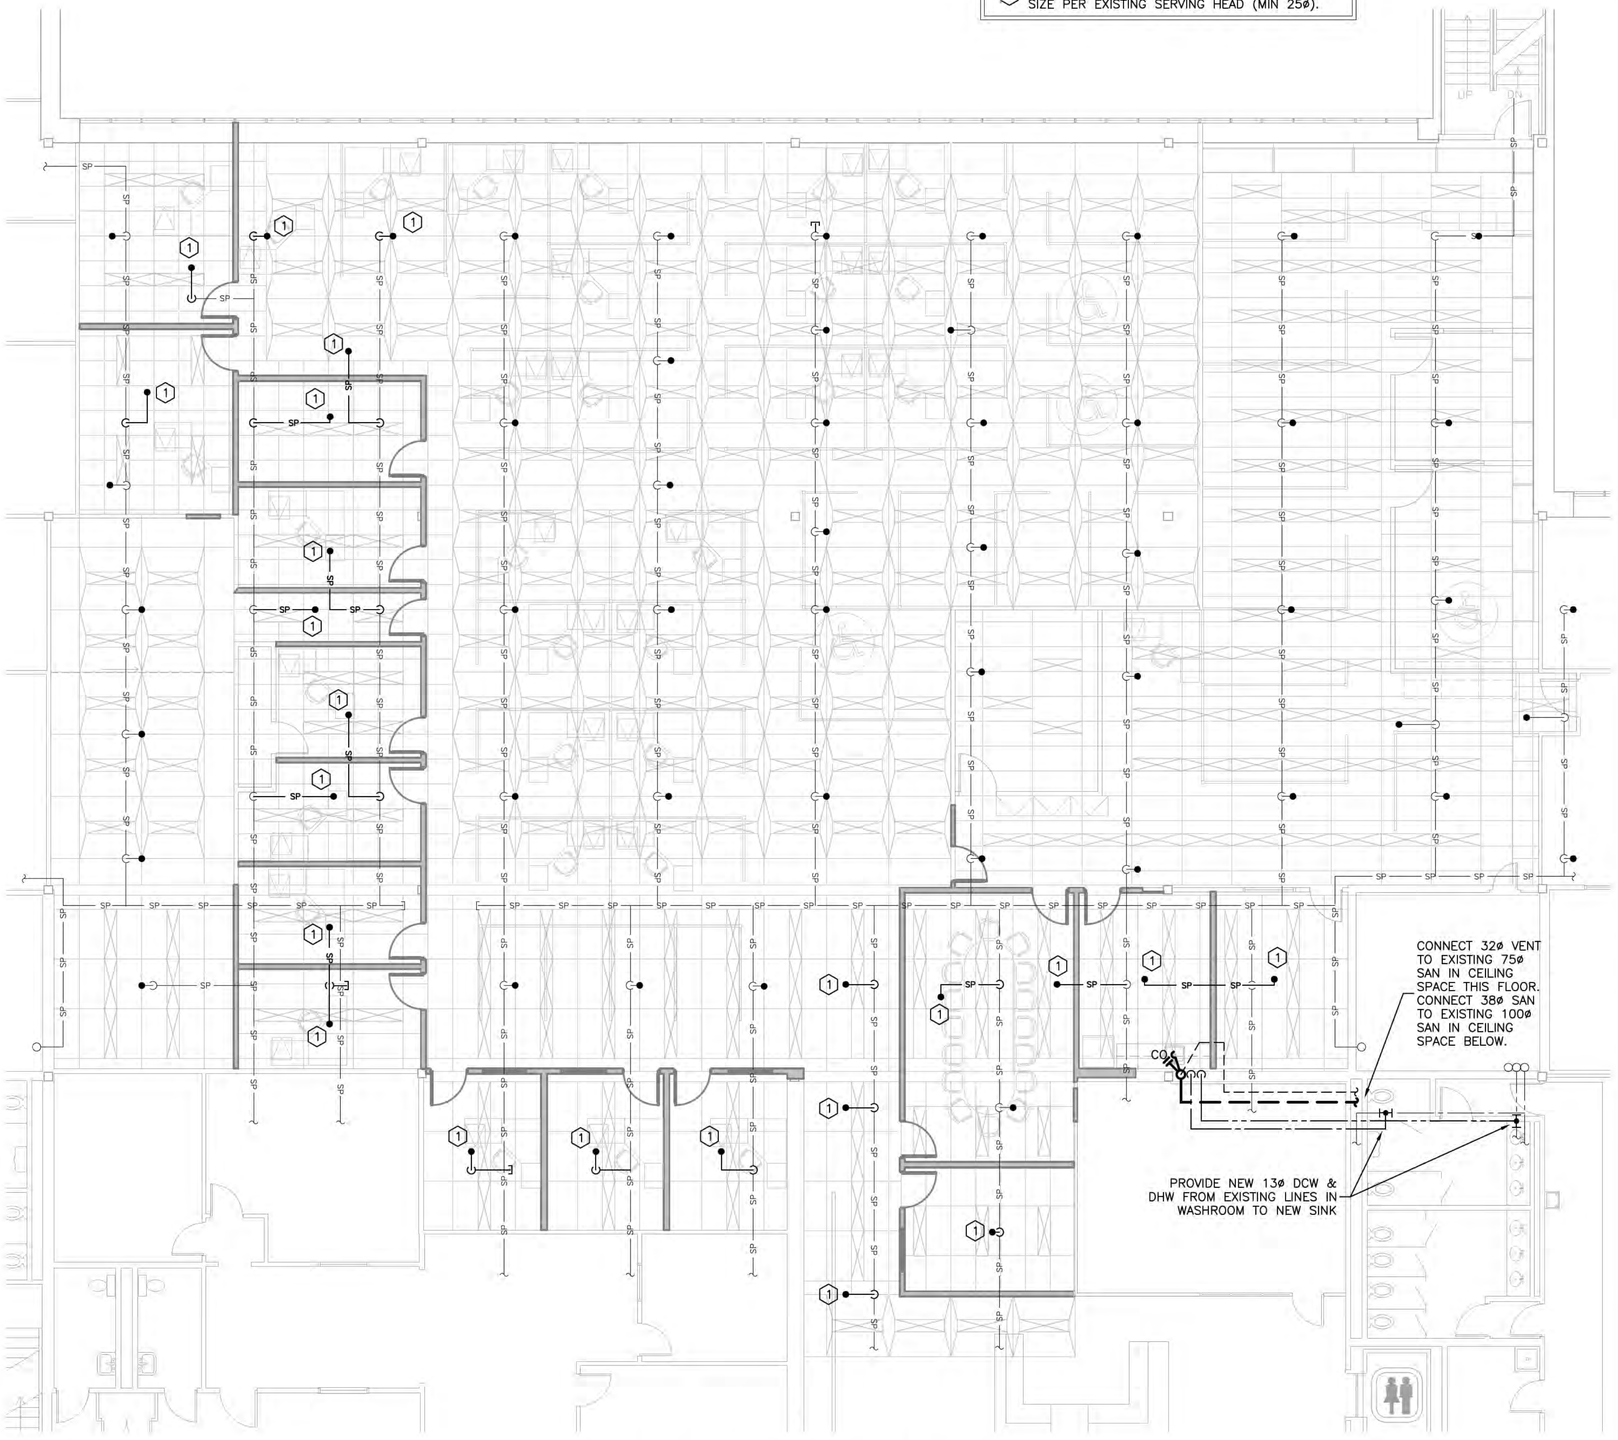

1 / M202 PLUMBING & FIRE PROTECTION PLAN – NEW
SCALE: 1:75

Stantec

Stantec Architecture Ltd.
202 107 Main Street
Whitehorse YT
Tel. 867.633.2400
www.stantec.com

The Contractor shall verify and be responsible for all dimensions. DO NOT scale the drawing - any errors or omissions shall be reported to Stantec without delay. The Copyrights to all designs and drawings are the property of Stantec. Reproduction or use for any purpose other than that authorized by Stantec is forbidden.

Consultants

Legend

EXISTING WALLS
CUBICLES
DEMOLITION
NEW WALL CONSTRUCTION
ALLOCATED WORKSPACE

BY OTHERS (FOR INFO ONLY)

LIGHT = EXIST
DARK = NEW
AREA TO BE DEMOLISHED

Revision		By	Appd.	YY.MM.DD
A	ISSUED FOR 65% PEER REVIEW	BZ	BZ	17.06.08
Issued		By	Appd.	YY.MM.DD
File Name: 02484_M100_plans.dwg		BZ Dwn.	SB Chkd.	BZ Dsgn.	17.06.12 YY.MM.DD

Permit-Seal

PRELIMINARY
NOT TO BE USED FOR CONSTRUCTION

Client/Project
GOVERNMENT OF YUKON

MAIN ADMINISTRATION BUILDING
MAIN FLOOR INTERIOR RENOVATION
WHITEHORSE, Y.T.

Title
PLUMBING & FIRE PROTECTION PLAN NEW

Project No.	Scale	
144902484	AS SHOWN @ ISO A1	
Drawing No.	Sheet	Revision
M202	4 of 5	A

Y:\1-MP\active\144902484.000D_mech\04_drawings\02484_M100_plans.dwg
2017/06/08 12:40 PM By: Zorin, Brandon

ORIGINAL SHEET - ISO A1

1.0 GENERAL

1.1. INTENT

.1 The intent of this specification and drawings is to provide a complete and fully operating mechanical layout in complete accord with applicable codes. The Mechanical Contractor shall make provisions for labor, material, and equipment necessary to complete the mechanical work.
.2 Drawings and specifications are complementary to each other and what is called for by one is to be binding as if called for by both. Should any discrepancy appear between drawings and specifications which leaves doubt as to the true intent and meaning, obtain a ruling from the Consultant.
.3 Mechanical drawings indicate general location and route to be followed by mechanical systems and do not show all structural and electrical details. In some cases, mechanical systems are shown diagrammatically in schematic only. Mechanical systems to be installed to provide a complete operating job and to be installed physically to conserve headroom, furring spaces, etc.
.4 Scope
.1 This summary informs but does not supersede the information presented on drawings M101, M102, M201, and M202.
.2 Relocate existing sprinkler heads as indicated to suit new full height walls.
.1 The existing sprinkler system is a WET system.
.3 Remove and salvage existing pneumatic thermostats and return air grilles as indicated for re-use in new space layout. Re-install in new locations as indicated.
.4 Remove existing supply air slot diffusers as indicated. Replace with new diffusers and extend existing supply air ducting to connect to new diffusers. Provide new return air grilles where indicated.
.5 Install new kitchen sink in lunch area and connect sanitary, sanitary vent, and domestic cold and hot water to existing serving nearby washrooms.
.6 Balancing of existing and new supply air diffusers
.7 Ensure the sprinkler, domestic water, sanitary, ducting, and thermostats/associated VAV boxes affected by this project are in good working condition at the end of the contract.

1.2. LIABILITY

.1 Assume responsibility for layout work and for damage caused to the Owner, Tenant, or others by improper execution of work.
.2 Protect finished and unfinished work from damage.
.3 Take responsibility for condition of materials and equipment supplied and protect until work is completed and accepted. Reinstate damaged or alterations to match existing conditions, including any fuel spills resulting from work to satisfaction of owner.

1.3. CERTIFICATES

.1 Give notices, obtain permits, and pay fees so work specified may be carried out. Furnish certificates if requested, as evidence that work conforms with laws and regulations of authorities having jurisdiction.

1.4. COORDINATION OF WORK

.1 Coordinate the schedule with the building maintenance personnel and occupant representative. Provide a schedule within 10 days of contract award and prior to commencement of work on site.
.2 Provide for continuous owner occupancy of areas adjacent to work area throughout the duration of the work. Owner will vacate work area prior to project work starting.
.3 Cooperate and coordinate with other trades on the project.
.4 Make reference to electrical, mechanical, structural and architectural drawings when setting out work. Consult with respective Divisions in setting out locations for ductwork, equipment, and piping, so that conflicts are avoided and symmetrical even spacing is maintained. Provide coordination of drawings showing the work of all trades and contractors involved, in areas of potential conflict or congestion.
.5 Where dimensional details are required, work with the applicable architectural drawings.
.6 Full size and detailed drawings shall take precedence over scale measurements from drawings.

1.5 CUTTING AND PATCHING

.1 Give locations for holes for mechanical equipment and provide sleeves required for the mechanical installations.
.2 Be responsible for the coordination of cutting and patching of building structure required by mechanical work unless otherwise indicated. Review existing base building structural system prior to commencement of coring and obtain approval from Structural Consultant if required for special conditions (ie. post tension structural slabs).
.3 Seal all openings around pipes that penetrate floors or fire rated walls with a fire barrier material equal to the rating of the floor or wall.

1.6 PAINTING AND IDENTIFICATION

.1 Paint all new exposed ducts and pipes as indicated on drawing with colours to match interior finishes or in colours to match existing or as directed by the Consultant.
.2 Identify ducting, domestic water, sanitary, and sprinkler piping with labels and flow arrows. Provide identification at 15m. maximum intervals, before and after pipes passing through walls, at all sides of tees, behind access doors. Use Brady B-500 vinyl cloth labels or provide labels to match existing identification. Minimum one label for each new system.

1.7 WARRANTEE

.1 Provide the Owner with a written guarantee warranting apparatus furnished to remain in serviceable condition for a period of one (1) year from the date of final acceptance by the Owner.

1.8 STANDARD OF MATERIALS AND WORKMANSHIP

.1 Materials shall be new and of uniform pattern throughout, where specifically identified in this specification. This is for the purpose of establishing a standard of quality of materials and workmanship and not to limit selection.
.2 Workmanship shall follow the best tradition and tradesmanship. Employ only tradesmen properly licensed for work requiring tradesman with special skill.

1.9 RECORD DRAWINGS

.1 Keep on site an extra set of white prints and specifications, recording changes and deviations daily.
.2 Upon completion of work provide redline of as-built drawings, in the same scale as the Architectural set to the Owner. These must be submitted within two (2) weeks after substantial completion. Failure to submit drawings will result in the work being done by the Owner and the cost deducted from final payment.

1.10 FINAL INSPECTION

.1 All systems to be fully operational and any deficiencies noted by contractor shall be completed and air balancing reports submitted to the Consultant prior to final inspection.
..2 All deficiencies shall be completed within two (2) weeks after final inspection and letter submitted to Consultant within that time advising that the work is complete. Failure to complete work will result in work being done by the Owner and the costs deducted from final payment.

1.11 OPERATION AND MAINTENANCE MANUALS

.1 Turn over all shop drawings, product literature, product data sheets, warrantee sheets, maintenance information for inclusion in the project O&M manual per Division 01 specifications.

1.12 SEISMIC RESTRAINT

.1 Provide and install seismic restraint for all equipment and piping installed. Engage a Yukon-registered Engineer for design of the seismic restraint and provide a stamped letter of assurance for the installation. Restraints are to be in accordance with the latest edition of SMACNA "Guidelines for Seismic Restraints of Mechanical Systems and Plumbing Piping Systems" and ASHRAE application handbook, chapter 3.

2.0 TESTING

2.1. QUALITY ASSURANCES

.1 Test equipment and material where required by specification or authority having jurisdiction to demonstrate its proper and safe operation.
.2 Test procedures in accordance with applicable portions of ASME, NFPA, ASHRAE, SMACNA, and other recognized test codes as far as field conditions permit. Perform tests on site to the satisfaction of the Engineer.
.3 Piping, fixtures or equipment shall not be concealed or covered until installation is inspected and approved by the Engineer.

2.2. PIPE & EQUIPMENT TESTS

.1 Prior to starting equipment or systems, secure and review manufacturer's installation, operation, and starting instructions. Read in conjunction with procedures defined herein.
.2 All final test logs/sheets to be verified and signed by testing personnel and Authority having jurisdiction. Submit for review within 5 days and include in O&M manual.
.3 Prior to tests, isolate all equipment or other parts which are not designed to withstand test pressures or test medium.
.5 DWV Piping: Hydraulic test for all drainage piping with minimum 5'-0" of hydrostatic head for 15 minutes.
.6 Domestic water (Rigid or PEX): Initial test: Pneumatic. Acceptable for boarding where heating not available. Test pressure not less than 60psig. Final test: Hydraulic. Minimum 100psig. Minimum 12hrs.
.7 Sprinkler piping: Hydraulic. Minimum 200psig. Minimum 2hrs with no leakage or loss in pressure.

2.0 TESTING (cont'd)

2.3 BALANCING

.1 TAB means to test, adjust and balance to perform in accordance with requirements of Contract Documents and to do other work as specified in this section.
.2 Do all testing over entire operating range in accordance with most stringent conditions of this specification of this specification and standards of the following organizations:
.1 AABC Associated Air Balance Council.
.2 ASHRAE
.3 Ensure start-up, verification for proper, normal and sage operation of mechanical and associated electrical and control systems affecting TAB prior to commencing TAB.
.4 Do TAB to following tolerances of design values:
.1 HVAC systems: Plus or minus 10%.
.2 Measured values to be accurate to within plus or minus 5% of actual values.
.5 Systems to be balanced within work area only:
.1 New ceiling supply air diffusers
.2 Existing ceiling supply air diffusers
.3 Existing VAV boxes.
.6 Submit TAB Report to Owner's Representative and allow 10 working days for consultant review & Approval prior to scheduling final inspection.

3.0 PLUMBING

3.1. PLUMBING GENERAL

.1 Provide all necessary piping material and labor for the systems as shown on the drawings. All piping systems to be installed in compliance with latest applicable codes.
.2 Provide dielectric type connections wherever jointing dissimilar metals in open systems. Brass adapters and valves are acceptable.
.3 Install vacuum breakers on plumbing lines where contamination of domestic water may occur.
.4 Check invert elevations prior to sanitary and drainage connections.
.5 Grade drainage lines 1:50, unless noted otherwise.
.6 Provide plumbing fixtures per "Plumbing Fixtures Schedule".

3.2. PIPING

.1 Above grade Drainage and vent piping shall be Type "DWV" copper c/w 50/50 solder joints or cast iron.
.2 Domestic water main piping shall be Type "L" hard copper to ASTM B88M c/w 95/5 solder joints. No compression fittings will be allowed unless approved by Consultant.
.3 Sprinkler piping: sched 40 threaded or sched 10 steel with external gasketted roll-groove couplers, to match existing sprinkler piping.
.4 Valves to be minimum 125 lb class, bronze body screwed or soldered connections, Accept Mat'l: Toyo, Kitz
.5 Union and couplings size 50mm and under: 1035kPa malleable iron, bronze to iron ground joint unions for threaded ferrous piping, air tested for gas service, all bronze for copper piping.
.6 Route piping in orderly manner and maintain proper grades. Install to conserve headroom and interfere as little as possible with use of space. Run exposed piping parallel to walls. Group piping wherever practical at common elevations. Install concealed pipes close to the building structure to keep furring to a minimum.
.7 Pipe the discharge from all relief valves, safety valves, vents, drains, equipment slowdowns, water columns, and overflows to the nearest building floor drain or drain.
.8 Install piping to allow for expansion and contraction without unduly stressing pipe or equipment connected.
.9 Flush out new building sewer systems and ensure free running pipes. Supply all equipment and water required.

3.3 PIPE HANGERS AND SUPPORTS

.1 All piping shall be firmly supported and securely braced. Provide copper plated hangers and supports for copper piping and galvanized hangers and supports for steel piping.
.2 Use of perforated straps is not permitted for pipe hangers.
.3 Provide ring type hangers for piping up to 38mm and clevis type hangers for piping over 38mm.
.4 Provide riser clamps at all floor penetrations and the base of all piping risers. Exception branch DW piping 25 diam. or smaller.

Pipe Size (mm)	Rod Diameter (mm)	Spacing (m)
13	10	2.0m
19-38	10	2.5m
50-65	10	3.0m
75-100	16	3.5m

3.4 PIPING INSULATION:

.1 All above grade interior piping insulation to be TIAC A-3 insulation:
.1 TIAC Code A-3: Rigid molded formaldehyde free mineral fibre piping insulation with factory applied vapour retarder jacket to CAN/CGSB-51.9-92 and CGSB SI-GP-52M.
.2 Materials:
.1 Insulation: molded, heavy density one piece, inorganic glass fiber bonded with thermosetting resin.
.2 Jacket: white kraft paper bonded to aluminum foil and reinforced with glass fibers. Lap seal: self adhesive.
.3 Temperature range: -29degC to 537degC
.4 Thermal Conductivity "k" shall not exceed 0.031 W/m. deg.C at 24 deg.C mean temperature when tested in accordance with ASTM C 335-95.
.5 Surface Burning Characteristics:
.1 To STM E84-98e, Test Method for Surface Burning Characteristics of Building Materials and ANSI/NFPA 255-2000, Burning Characteristics of Building Materials and CAN/ULCS102-M88.
.2 UL Classified. Flame spread <25 Smoke developed<50
.6 Vapour Transmission: Maximum: 0.02 perms, To ASTM E 96-00e1, Standard Test Methods for Water Vapor Transmission of Materials.
.7 ASTM listed to not promote growth of fungi or bacteria.
.8 Jacket for all exposed pipe: PVC jacket
.9 Acceptable material: Knauf Fiberglass Pipe Insulation.
.2 Install 25mm insulation on all DCW, DHW, and DHWR piping

3.5 SLEEVES AND ESCUTCHEONS

.1 Install min 16ga formed steel or galvanized sched 40 pipe sleeves where pipes pass through masonry, concrete structures, fire rated assemblies, and elsewhere as indicated. Sleeves to have annular fin continuously welded at midpoint or offset. Clearance between sleeve and uninsulated pipe or between sleeve and insulation to be 1/4" minimum, 1/2" maximum. Coat exposed exterior surfaces of ferrous sleeves with heavy application of zinc rich paint to CAN/CGSB-1.181-99.
.1 Seal foundation walls and below grade floors with fire retardant, waterproof non-hardening mastic.
.2 Install escutcheons on pipes passing through walls, partitions, floors, and ceilings in finished areas.
.1 Construction: One piece type with set screws. Chrome or nickel plated brass or type 302 stainless steel.
.2 Sizes: Outside diameter to cover opening or sleeve. Inside diameter to fit around pipe or outside of insulation if so provided.

3.0 PLUMBING (cont'd)

3.6 DOMESTIC HOT AND COLD WATER SYSTEM VALVES

.1 Ball valves up to 50mm: Bronze Body, Class 600, 4140kPa, full bore chrome plated bronze ball, threaded or soldered ends, PTFE seat and packing. Acceptable material: Kitz, Toyo, WOG, Jenkins
.2 Globe valves up to 50mm: Bronze body to MSS SP-80-1997, Class 125, 860 kPa, screwed bonnet, renewable Teflon disc, swivel type disc holder, screwed or soldered. Lock shield handles as indicated. Acceptable material: Kitz Fig 11/12/Toyo.

3.7 FLUSHING AND CLEANING AND DISINFECTION

For domestic hot and cold water systems:
1. Flush from all domestic water downstream of nearest isolation valve upstream of work area for 2 h.

3.8 FIRESTOPPING

Provide the following fire stopping systems for pipework penetrating fire separations:
.1 Metallic insulated pipes: Sleeve penetration and secure to wall. Pipe insulation to be continuous thru sleeve. Pack void with approved fire stop insulation or backing to ULC listing of sealant. Fire seal sleeve to wall with listed intumescent sealant to manufactured listings. Fire seal insulation to sleeve with minimum thickness listed intumescent sealant as per ULC listing of sealant.
.2 Plastic uninsulated pipes 50diam or less: Sleeves not required. Fire and smoke seal piping in place with listed intumescent sealant to manufactured and ULC listings.
.3 Plastic uninsulated pipes 63diam or larger: Sleeves not required. Provide listed fire stop collar smoke sealed in place with listed intumescent sealant to manufactured and ULC listings.
.4 All piping/duct penetrations thru 45min rated assemblies without separations to be cold smoke sealed/fire sealed with listed intumescent sealant or approved cold smoke sealed at fire penetrations to sealant ULC listing.
.5 Intumescent sealant:
.1 ULC/FM listed intumescent sealant, water based, containing no halogen, solvents or asbestos, suitable as fire and smoke sealant.
.2 Testing: to ULC S-115.
.3 Density: 1.5g/cm3.
.4 Working time: approx 20-30min.
.5 Curing time: approx 14-21 days.
.6 Intumescent activation: approx 121degC.
.7 Temperature resistance: -40degC to 100degC.
.8 Application temperature: 2degC to 38degC.
.9 Flame spread: 0 to ASTM E84-96.
.10 Smoke developed: 5 to ASTM E84-96
.11 Acceptable material: Hilti FS-One/3M.
.6 Intumescent Fire Stop Collars: ULC/FM listed with galvanized metal collar, intumescent fire sealant for use with PVC and ABS sched 40 drainage piping, acceptable material: Hilti CP 642/643/3M

4.0 VENTILATION, DUCTWORK, AND ACCESSORIES

.1 Ductwork shall be galvanized steel, lock forming quality. Fabricate in accordance with SMACNA Duct Manual and ASHRAE Handbooks. Ductwork shall meet the requirements of NFPA 90A and 90B and conform to applicable codes.
.2 All duct joints to be sealed. Sealants and gasketing to be water resistant, fire resistive, and compatible with mating materials. No duct tape shall be allowed for sealing ducts.
.3 Prior to fabrication of ductwork, check all heights and conflictions with other trades.
.4 Duct Sizes: Inside clear dimensions. For acoustically lined or internally insulated ducts maintain sizes inside ducts.
.5 Duct hangers and spacing shall conform to SMACNA manuals.
.6 Size round ducts, installed in place of rectangular ducts, from ASHRAE table of equivalent rectangular and round ducts. No variation of duct configuration or sizes permitted except by permission from CONSULTANT.
.7 The minimum sheet metal thickness for low pressure ducts including fittings, access doors, and other accessories shall be as per SMACNA HVAC Duct Construction Standards.
.8 Flexible duct is not permitted.

5.0 CONTROLS

.1 Provide new pneumatic tubing from relocated thermostats to VAV boxes. Tubing shall be hard or soft drawn copper or polyethylene plastic. Plastic tubing must meet current NFPA and UL fire rating requirements and flame spread and smoke development. Tubing to be suitable for installation in a return air plenum.
.2 Sequence of operation:
.1 Thermostat to cycle VAV box airflow between min supply (outdoor) air position and maximum to satisfy setpoint.

PLUMBING FIXTURES SCHEDULE

TAG No.	MANUFACTURER	MODEL No.	DESCRIPTION	DCW (ømm)	DHW (ømm)	SAN (ømm)	VENT(ø mm)	REMARKS
SK-1	FRANKE	LBS6810-1	REGULAR SINGLE SINK	12	12	38	32	20 GAUGE TYPE 302 (18-8) STAINLESS STEEL, SELF RIMMING DROP-IN, 511x522x254mm, UNDERCOATED, #4 SATIN FINISH ON EXPOSED SURFACES, 3-HOLE 8" CENTERSET SINK, C/W 89mm CRUMB CUP STRAINER WITH 38mm BRASS TAILPIECE AND MOEN 87485 FAUCET (DECK MOUNT, SINGLE LEVER W/ COLOR INDEXES, 229mm FLOW ARC NECK, DURALAST CARTRIDGE, CHROME FINISH, 5.7 L/min AERATOR?.

GRILLE, DIFFUSER, AND LOUVER SCHEDULE

TAG No.	MANUFACTURER	MODEL No.	SIZE	SERVICE	DESCRIPTION	FINISH	REMARKS
S-1	-	-	SEE DWGS	SUPPLY	SLOT DIFFUSER	WHITE	EXISTING SLOT DIFFUSER (T-BAR LAY-IN) TO BE RE-USED
S-2	PRICE	SCDA	600x600	SUPPLY	ADJUSTABLE SQUARE CONE DIFFUSER	B12	NECK SIZE PER DRAWING TAG
T-1	-	-	600x300	TRANSFER	EGG CRATE	WHITE	EXISTING T/A GRILLE TO BE RE-USED
T-2	PRICE	80 SERIES	SEE DWGS	TRANSFER	EGG CRATE	B12	13mm EGG CRATE, STEEL CONSTRUCTION

Stantec

Stantec Architecture Ltd.
202 107 Main Street
Whitehorse YT
Tel. 867.633.2400
www.stantec.com

The Contractor shall verify and be responsible for all dimensions. DO NOT scale the drawing - any errors or omissions shall be reported to Stantec without delay. The Copyrights to all designs and drawings are the property of Stantec. Reproduction or use for any purpose other than that authorized by Stantec is forbidden.

Consultants

Legend

Revision	By	Appd.	YY.MM.DD
A ISSUED FOR 65% PEER REVIEW	BZ	BZ	17.06.08

Issued	By	Appd.	YY.MM.DD
File Name: 02484_M700_specs.dwg	BZ Dwn.	SB Chkd.	BZ 17.06.12 Dsgn. YY.MM.DD

Permit-Seal

PRELIMINARY
NOT TO BE USED FOR CONSTRUCTION

Client/Project
GOVERNMENT OF YUKON


MAIN ADMINISTRATION BUILDING
MAIN FLOOR INTERIOR RENOVATION
WHITEHORSE, Y.T.

Title
SPECIFICATIONS
& SCHEDULES


Project No. 144902484
Scale AS SHOWN @ ISO A1
Drawing No. M700
Sheet 5 of 5
Revision A

Y:\144902484\cadfiles\144902484-0000_mech\06_drawings\02484_M700_specs.dwg
2017/06/08 12:40 PM By: Zorn, Brendon

ORIGINAL SHEET - ISO A1

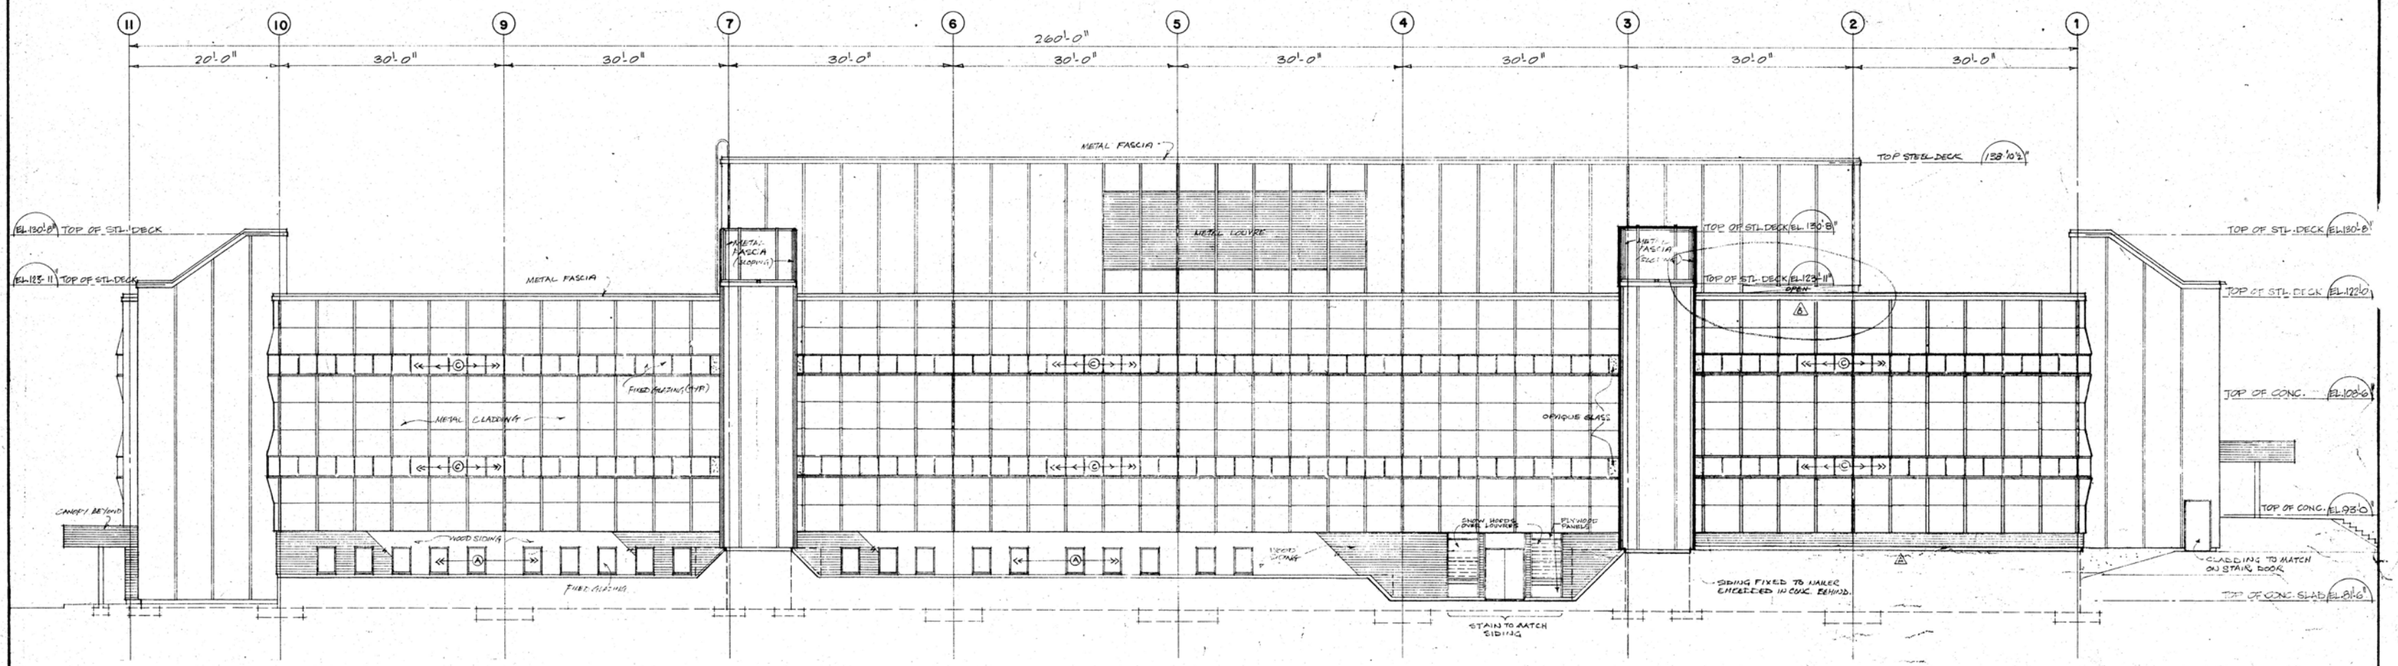

EAST ELEVATION

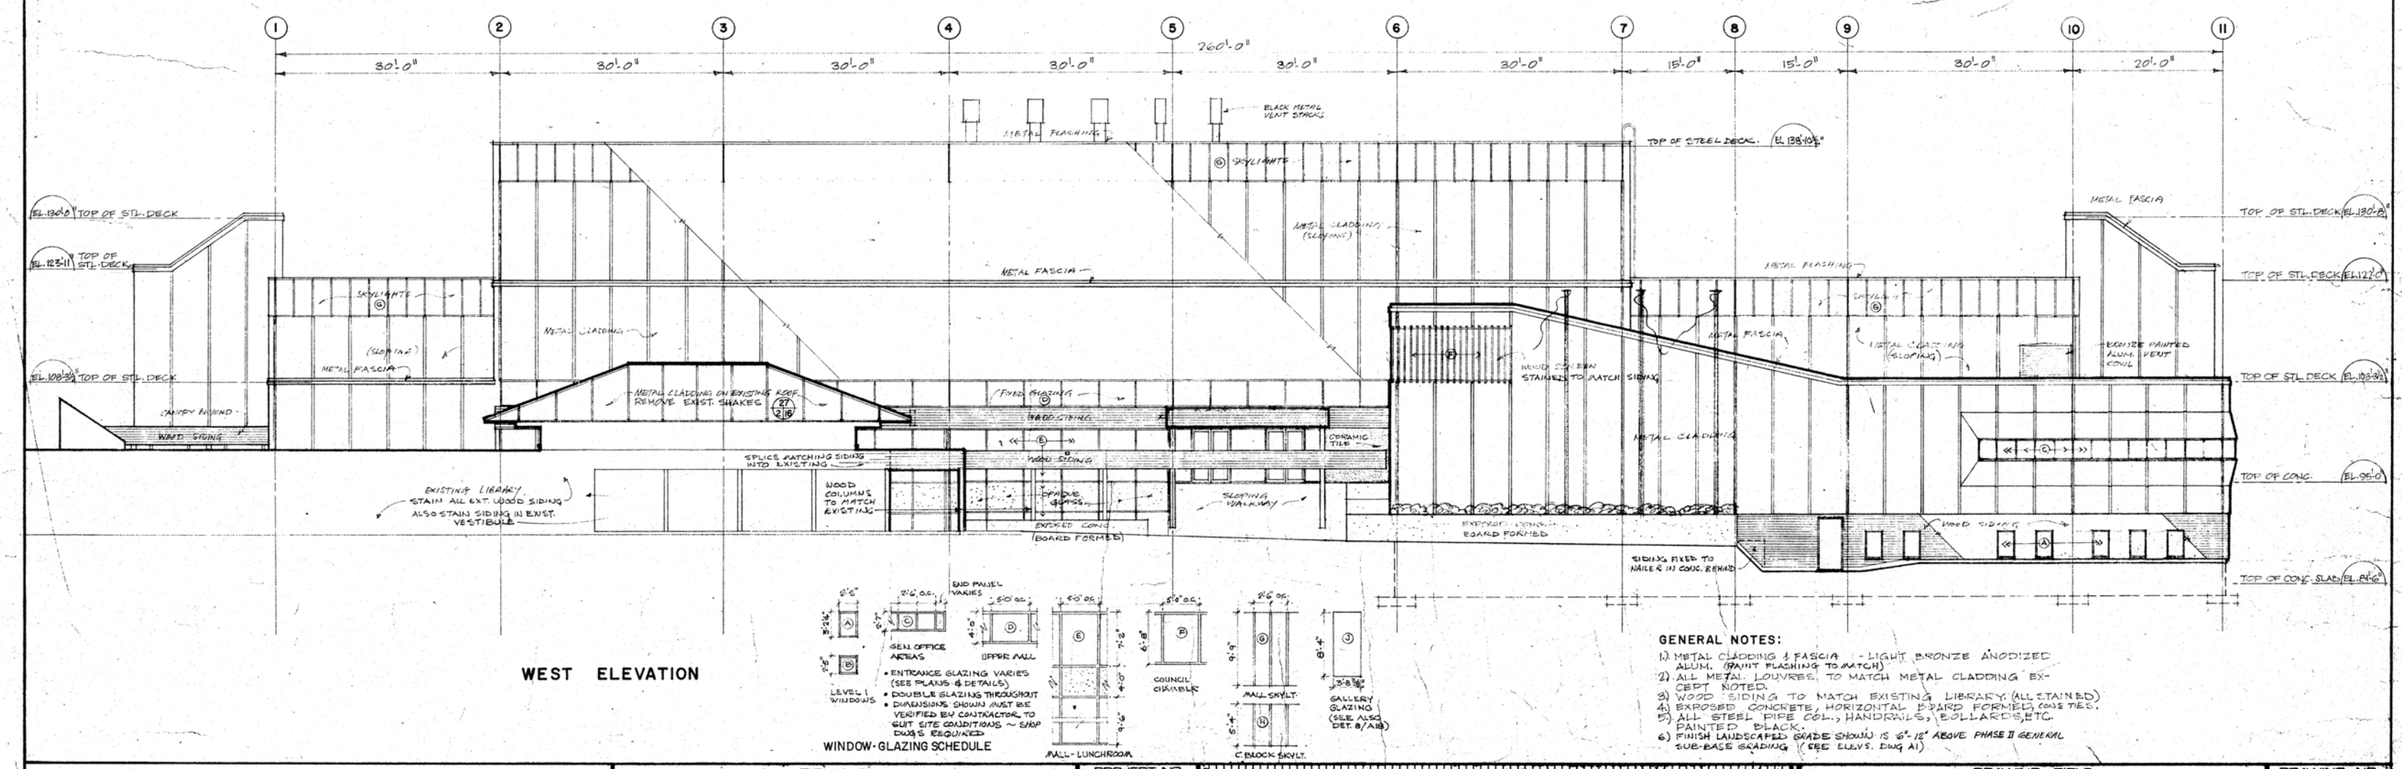

WEST ELEVATION

- ENTRANCE GLAZING VARIES (SEE PLANS & DETAILS)
- DOUBLE GLAZING THROUGHOUT
- DIMENSIONS SHOWN JUST BE VERIFIED BY CONTRACTOR, TO SUIT SITE CONDITIONS. ~ SHOP DWGS REQUIRED

WINDOW-GLAZING SCHEDULE

GENERAL NOTES:

1) METAL CLADDING & FASCIA - LIGHT BRONZE ANODIZED ALUM. (UNIT FLASHING TO MATCH)
2) ALL METAL LOUVRES TO MATCH METAL CLADDING EXCEPT NOTED.
3) WOOD SIDING TO MATCH EXISTING LIBRARY. (ALL STAINED)
4) EXPOSED CONCRETE, HORIZONTAL PLYWOOD FORMED, CONS TEC.
5) ALL STEEL PIPE COL., HANDRAILS, BOLLARDS, ETC. PAINTED BLACK.
6) FINISH LANDSCAPED GRADE SHOWN IS 6"-12" ABOVE PHASE II GENERAL SUB-BASE GRADING (SEE ELEVS. DWG A1)

REVISIONS		
NO.	DATE	DESCRIPTION
3	SEPT/74	EXTERIOR FINISH GRADE REVISED BETWEEN GL'S 8 TO 1; EAST ELEVATION.
2	OCT/74	CORRECT PENTHOUSE ELEVATION.
1	NOV/74	CORRECT WEST ELEVATION - FLAGPOLE.

Public Works Canada / Travaux publics Canada
Yukon Reg. / Région du Yukon


PROJECT NO. 8985?
DATE APRIL/74 | SCALE 1/8"=1'-0"
DRAWN R.G. | CHECK
APPROVED

GOVERNMENT OF THE YUKON TERRITORY


DRAWING TITLE
EAST & WEST ELEVATIONS

PROJECT TITLE
TERRITORIAL ADMINISTRATION BUILDING
WHITEHORSE, Y.T.


DRAWING NO.
A2

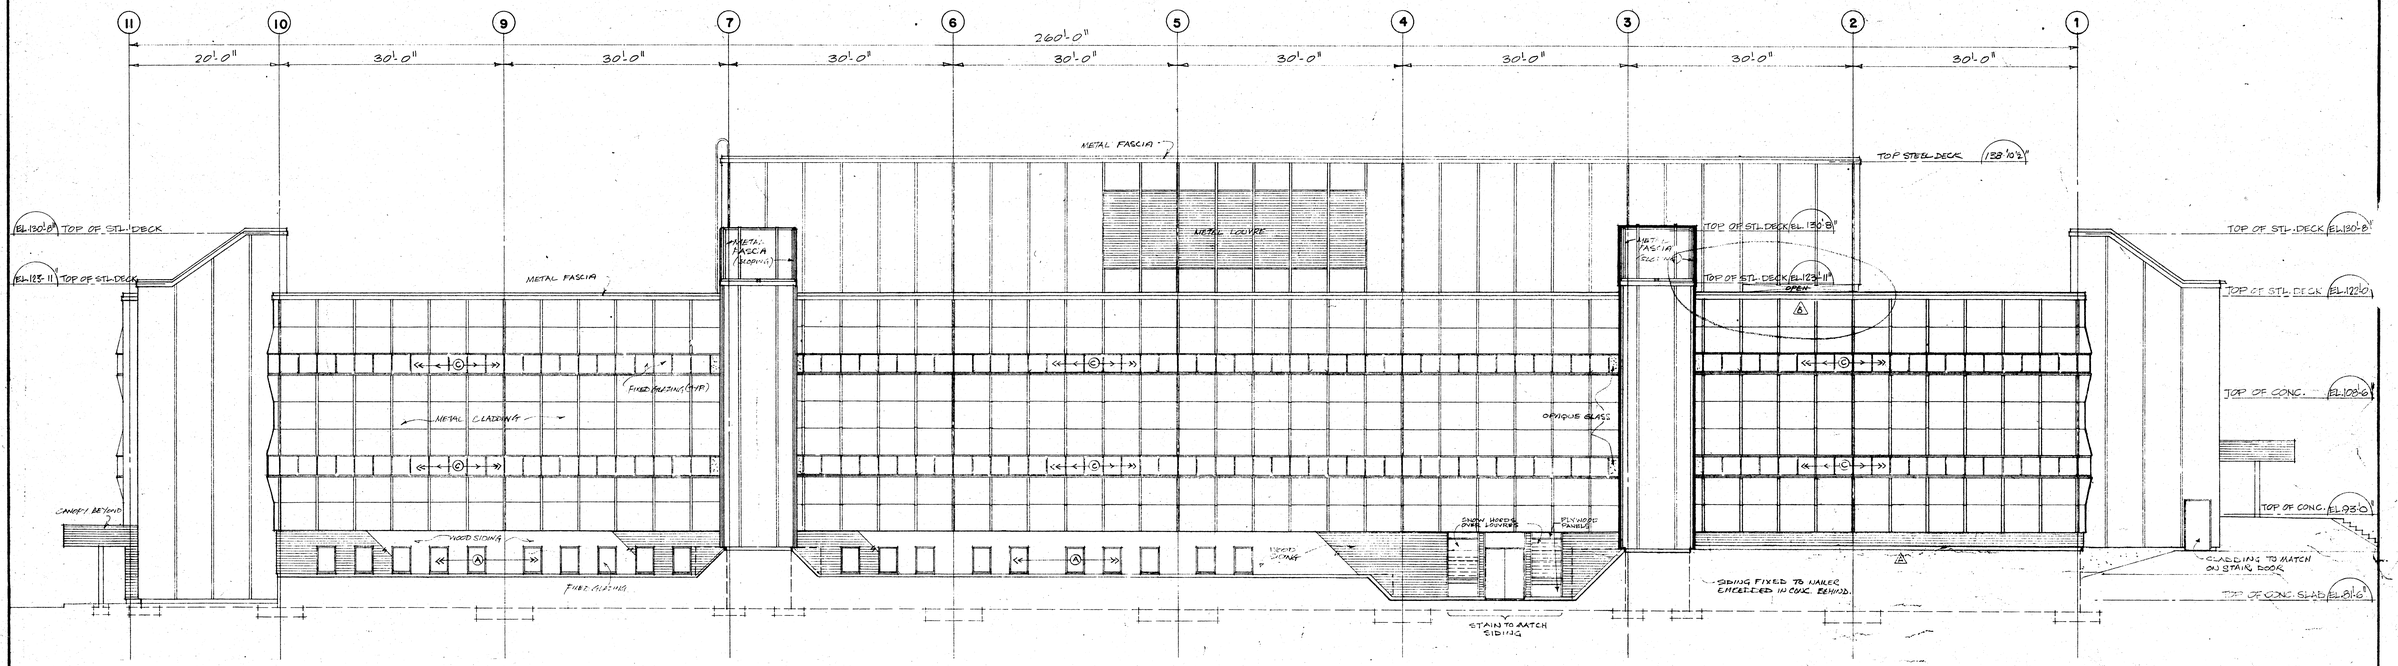

EAST ELEVATION

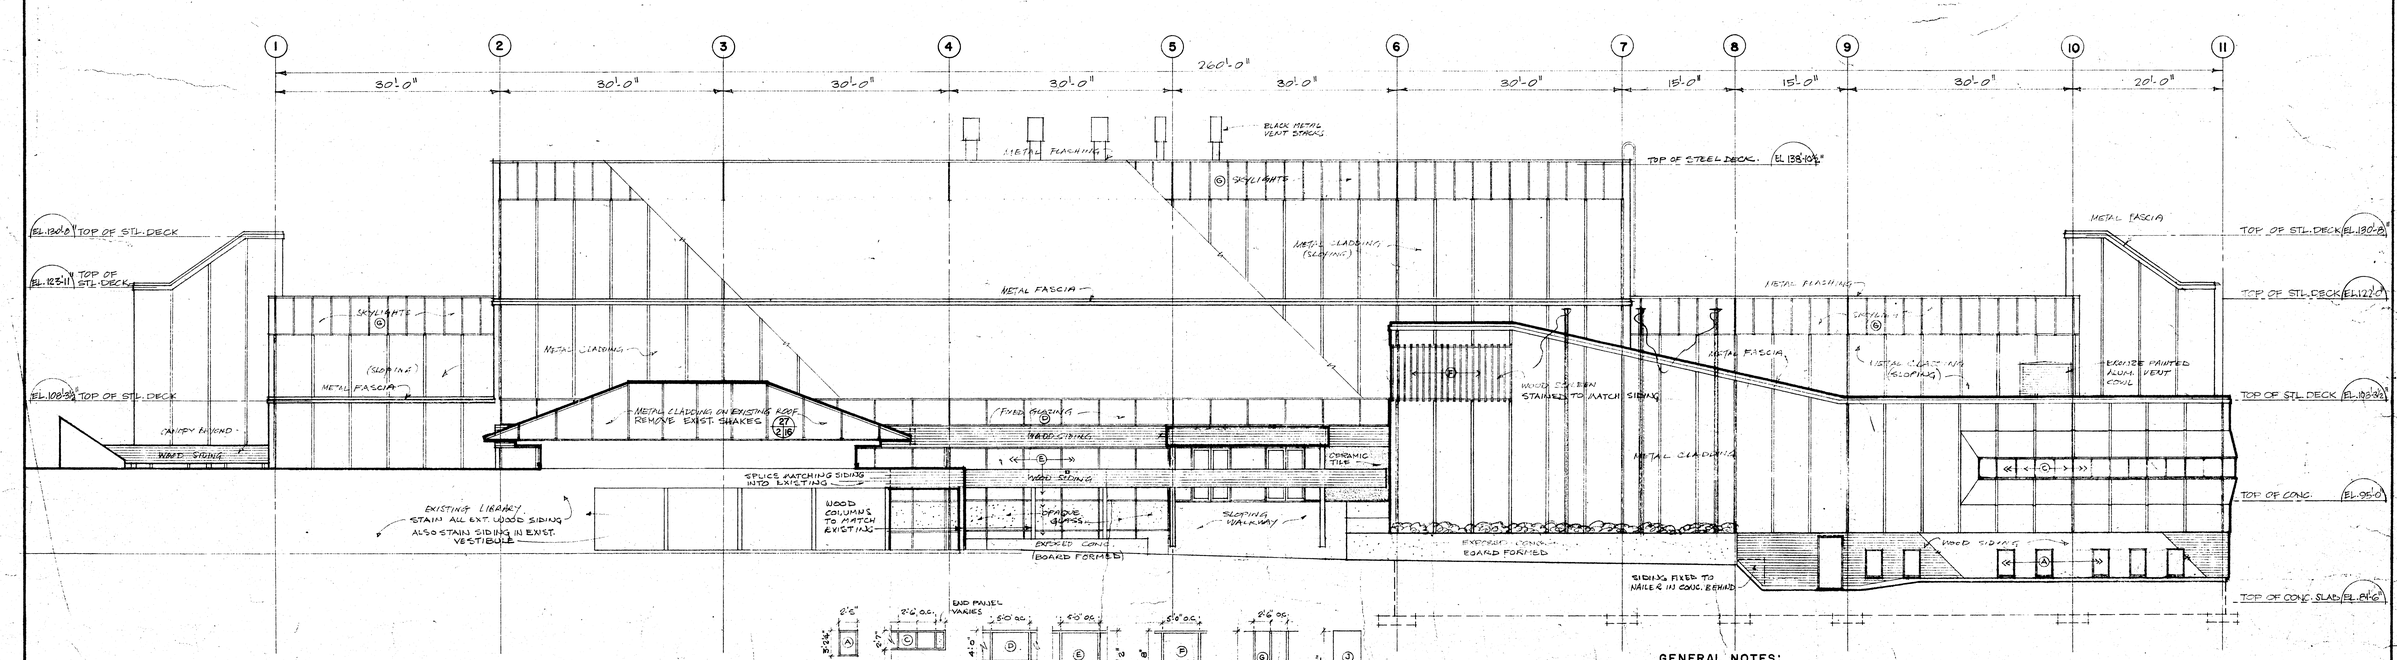

WEST ELEVATION

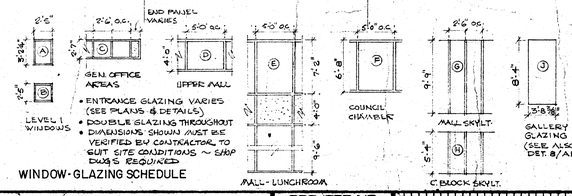

WINDOW-GLAZING SCHEDULE

- ENTRANCE GLAZING VARIES (SEE PLANS & DETAILS)
- DOUBLE GLAZING THROUGHOUT
- DIMENSIONS SHOWN MUST BE VERIFIED BY CONTRACTOR TO SUIT SITE CONDITIONS ~ SHOP DWGS REQUIRED

GENERAL NOTES:

1) METAL CLADDING & FASCIA - LIGHT BRONZE ANODIZED ALUM. (PAINT FLASHING TO MATCH)
2) ALL METAL LOUVRES, TO MATCH METAL CLADDING EXCEPT NOTED.
3) WOOD SIDING TO MATCH EXISTING LIBRARY (ALL STAINED)
4) EXPOSED CONCRETE, HORIZONTAL BOARD FORMED, CONC'S TES.
5) ALL STEEL PIPE COL., HANDRAILS, BOLLARDS ETC. PAINTED BLACK.
6) FINISH LANDSCAPED GRADE SHOWN IS 6"-12" ABOVE PHASE II GENERAL SUB-BASE GRADING (SEE ELEVS. DWG A1)

REVISIONS		
NO.	DATE	DESCRIPTION
1	SEPT/74	EXTERIOR FINISH GRADE REVISED BETWEEN GL'S 3 TO 1, EAST ELEVATION.
2	11 OCT. 74	CORRECT PENTHOUSE ELEVATION.
3	7/NOV/75	CORRECT WEST ELEVATION - FLAGPOLES.

Public Works Canada / Travaux publics Canada
Pacific Region

PROJECT NO. 8985

DATE APRIL/74 SCALE 1/8"

DRAWN RG CHECK


APPROVED

GOVERNMENT OF THE YUKON TERRITORY


DRAWING TITLE: EAST & WEST ELEVATIONS

PROJECT TITLE: TERRITORIAL ADMINISTRATION BUILDING WHITEHORSE, Y.T.


DRAWING NO. A2

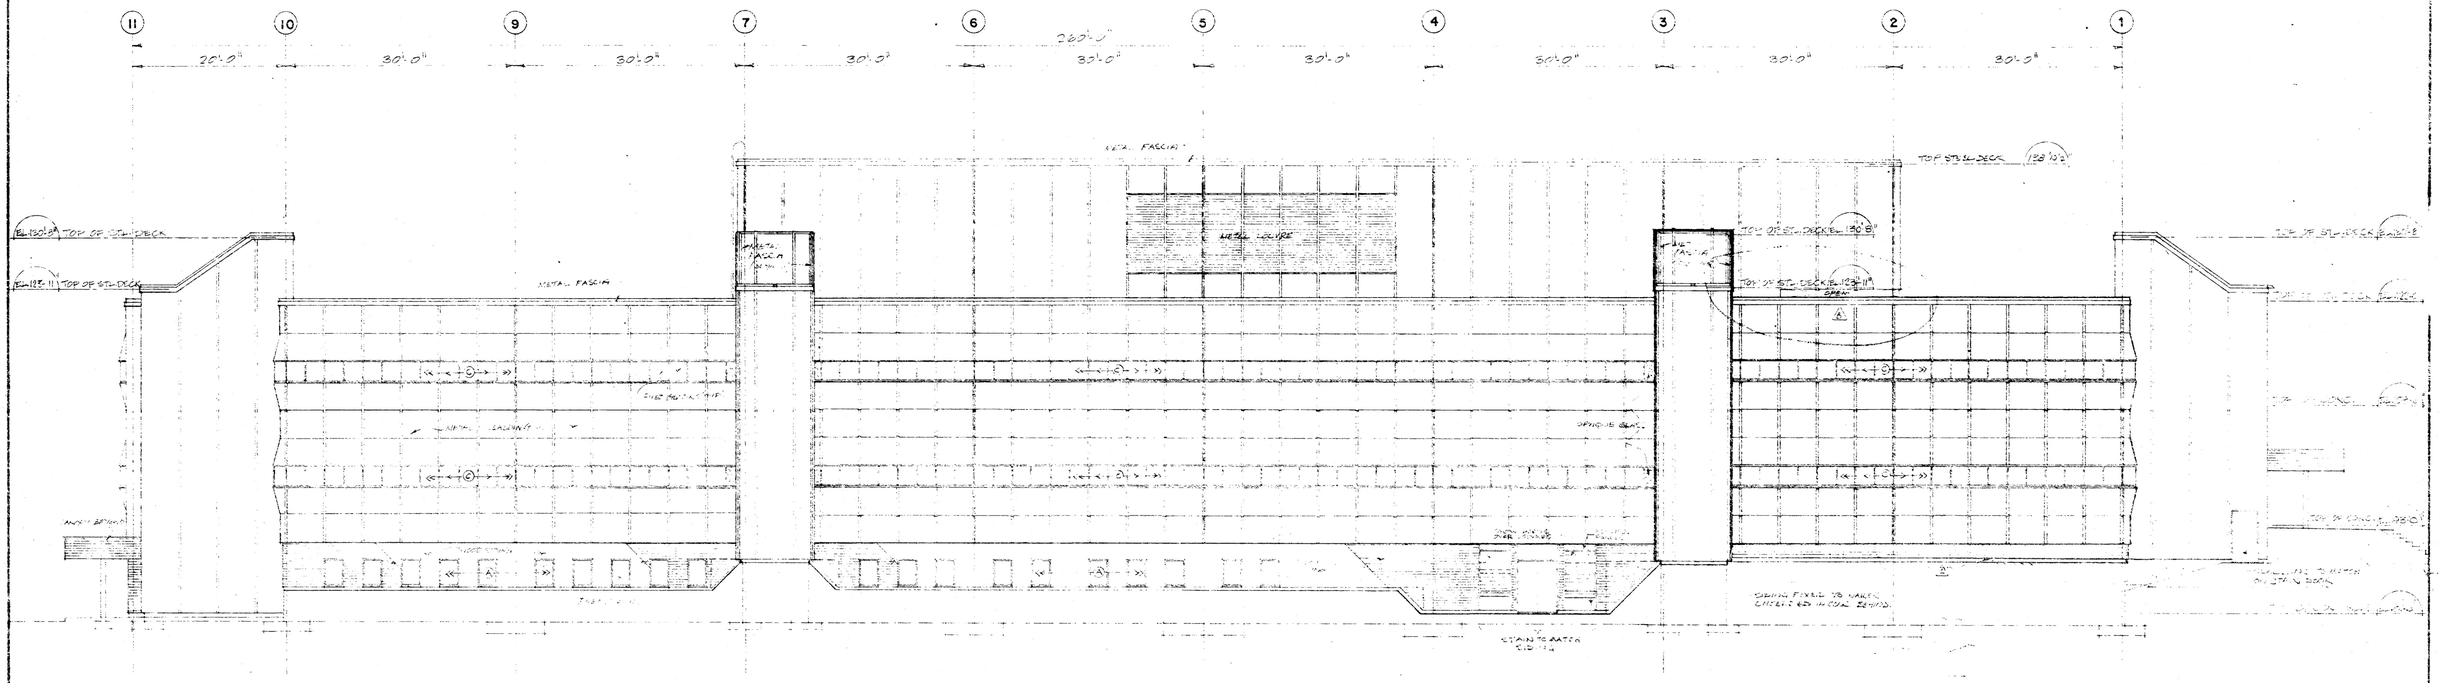

EAST ELEVATION

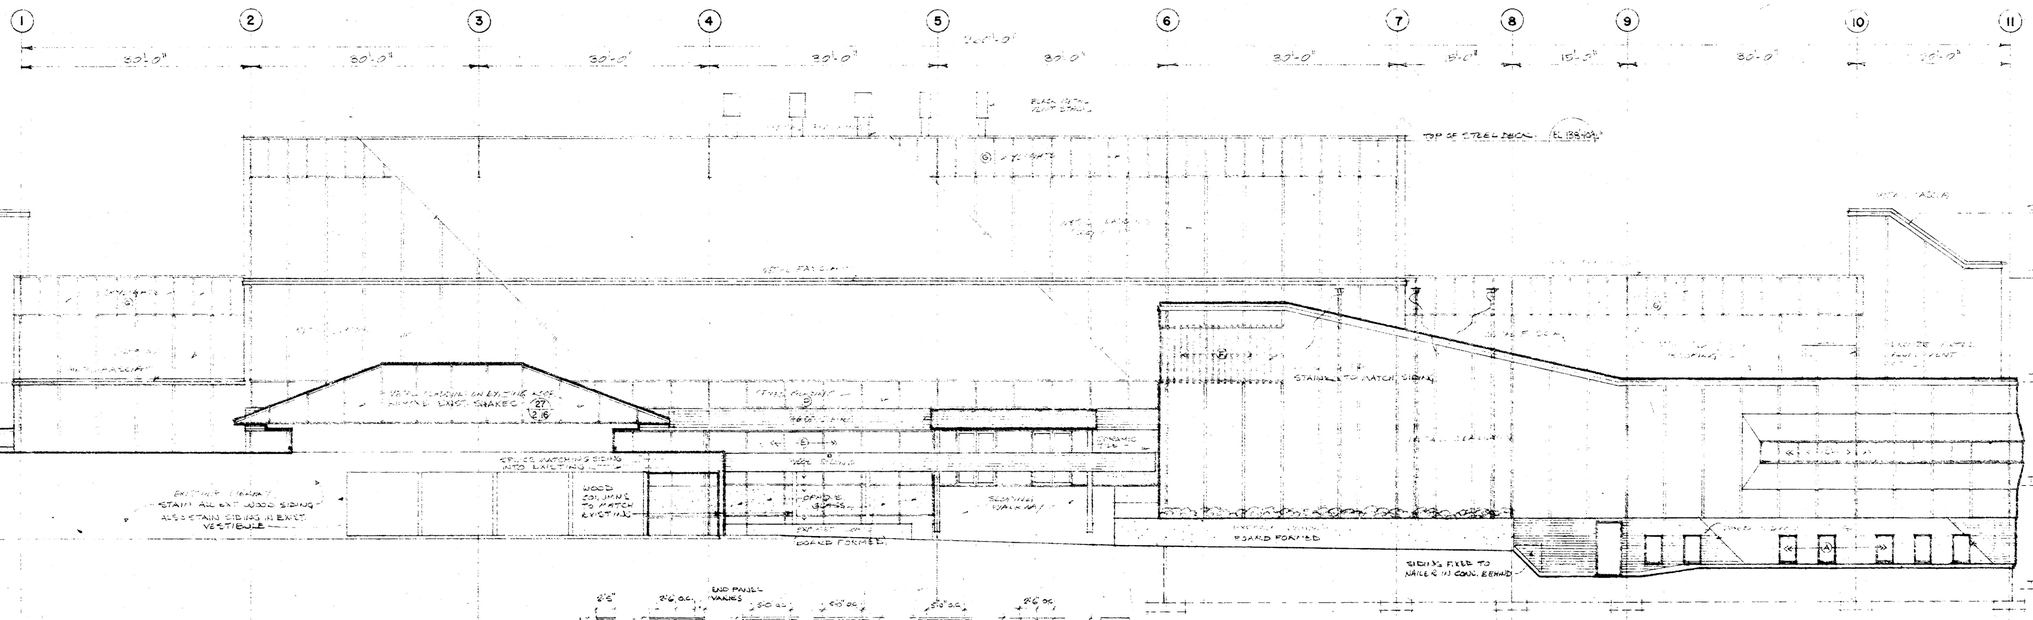

WEST ELEVATION

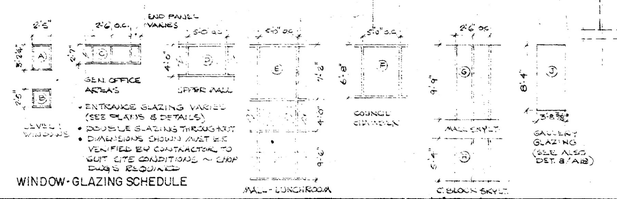

WINDOW-GLAZING SCHEDULE




Public Works Canada / Travaux publics Canada — Pacific Region	REVISIONS NO. DATE — DESCRIPTION 1 SEPT. 74 — INTERIOR FINISH GRADE REVISED SEE MEMO 74-15 & 74-21, EAST ELEVATION 2 OCT 74 — CORRECT PENTHOUSE ELEVATION 3 11/04/75 — CORRECT WEST ELEVATION - FLAGPOLE	PROJECT NO. 8985? DATE APRIL 74 — SCALE 1/8"=1'0" DRAWN R.S. — CHECK APPROVED	GOVERNMENT OF THE YUKON TERRITORY	DRAWING TITLE EAST & WEST ELEVATIONS PROJECT TITLE TERRITORIAL ADMINISTRATION BUILDING WHITEHORSE, Y.T.	DRAWING NO. A 2

ROOM NO.	ROOM NAME	FLOOR	NORTH WALL MAT.	NORTH WALL FIN.	EAST WALL MAT.	EAST WALL FIN.	SOUTH WALL MAT.	SOUTH WALL FIN.	WEST WALL MAT.	WEST WALL FIN.	CEILING MAT.	CEILING FIN.	HT.	REMARKS
173	VESTIBULE	C.T.	G.B.	P.	G.B.	P.	G.B.	P.	G.B.	P.	G.B.	P.	8'-0"	
174	ELEVATOR LOBBY	Q.T.	G.B.	P.	GLAZING	—	G.B.	P.	OPEN	—	AC.T.	—	9'-6"	
175	JANITOR	CONC. S.T.	G.B.	P.	G.B.	P.	G.B.	P.	G.B.	P.	G.B.	P.	9'-6"	
176	TOURISM/GAMES	CPT.	G.B.	P.	G.B.	P.	G.B.	P.	G.B.	P.	AC.T.	P.	8'-6	WALL @ GRIDLINES 'E' - '9-10' : G.B. BOTH SIDES, P.
	STAIRS "1,"2,"3,"4,"6	CONC. S.T.	G.B.	P.	G.B.	P.	G.B.	P.	G.B.	P.	EXPOSED STEEL	P.	VARIES	FINISHES TYPICAL @ ALL LEVELS, EXCEPT STAIR "6 (G.B. - P. ON UNDERSIDE OF STAIR FLIGHTS & CPT. ON FLOOR, TREADS + RISERS.)
	STAIR "5	CPT.												LAMINATED WOOD RAIL — STAINED UNDERSIDE OF STAIR FLIGHTS: - WOOD - C.W.S.
201	VESTIBULE	CONC. S.T.	GLAZING	—	G.B.	P.	GLAZING	—	G.B.	P.	WD.	C.W.S.	7'-11"	CONT. WOOD FASCIA - C.W.S., CHANGE ORDER 17, QUARRY TILING IN VESTIBULE 201 AND 204
202	MALL	Q.T.	GLAZING	—	G.B.	P.	GLAZING	—	G.B. GLAZING	P. —	WD.	C.W.S.	7'-11", VARIES	CONT. WOOD FASCIA - C.W.S., EXPOSED STEEL BEAM - P.
203	GALLERY	Q.T.	EXISTING WD.,	RE-STAIN	WD	MATCH EXISTING	WD GLAZING	MATCH EXISTING —	EXISTING WD.	RE-STAIN	WD.	C.W.S.	9'-5½"	
204	VESTIBULE	CONC. S.T.	WD. GLAZING	C.W.S. —	WD GLAZING	C.W.S. —	WD. G.B.	C.W.S. P.	WD. GLAZING	C.W.S. —	WD.	C.W.S.	7'-11"	SEE CHANGE ORDER 17 ABOVE
205	PRESS RM.	CPT.	G.B.	P.	G.B.	P.	G.B.	P.	G.B.	P.	AC.T.	—	9'-6"	
206	FOYER	CPT.	G.B.	P.	G.B.	P.	G.B.	P.	G.B.	P.	WD.	C.W.S.	7'-0"	
207	MEN'S WASHRM.	C.T.	C.T.	—	C.T.	—	C.T.	—	C.T.	—	G.B.	P.	8'-0"	
208	WOMEN'S WASHRM.	C.T.	C.T.	—	C.T.	—	C.T.	—	C.T.	—	G.B.	P.	8'-0"	
209	V.I.P.	CPT.	G.B.	P.	G.B.	P.	G.B.	P.	G.B.	P.	AC.T.	—	8'-0"	
210	PUBLIC GALLERY	CPT.	G.B.	P.	G.B.	P.	G.B.	P.	OPEN	—	WD.	C.W.S.	VARIES	CPT. FLOOR EXTEND OVER BUILT-IN SEATING - SEE DETAIL SHEET A-22. LAMINATED WOOD RAIL - STAINED
211	STATISTICIAN	CPT	G.B.	P.	G.B.	P.	G.B.	P.	G.B.	P.	AC.T	—	8'-0"	
212	FINANCIAL ADVISOR	CPT.	G.B.	P.	G.B.	P.	G.B.	P.	G.B.	P.	AC.T.	—	8'-0"	
213	LEGAL ADVISOR	CPT.	G.B.	P.	G.B.	P.	G.B.	P.	G.B.	P	AC.T.	—	8'-0"	
214	STORAGE	R.F.	G.B.	P.	G.B.	P.	G.B.	P.	G.B.	P.	G.B.	P.	8'-0"	
215	COUNCILLOR 1	CPT.	G.B.	P.	G.B.	P.	G.B. GLAZING	P. —	G.B.	P.	AC.T.	—	8'-0"	PREFAB. HEATING UNIT COVERS — P.
216	COUNCILLOR 2	CPT.	G.B.	P.	G.B.	P.	G.B. GLAZING	P. —	G.B.	P.	AC.T.	—	8'-0"	DITTO
217	COUNCILLOR 3	CPT.	G.B.	P.	G.B.	P.	G.B. GLAZING	P. —	G.B.	P.	AC.T.	—	8'-0"	DITTO
218	COUNCILLOR 4	CPT.	G.B.	P.	G.B.	P.	G.B. GLAZING	P. —	G.B.	P.	AC.T.	—	8'-0"	DITTO
219	COUNCILLOR 5	CPT.	G.B.	P.	G.B.	P.	G.B. GLAZING	P. —	G.B.	P.	AC.T.	—	8'-0"	DITTO
220	OFFICE AREA	CPT.	OPEN		G.B.	P.	G.B.	P.	G.B.	P.	AC.T.	—	9'-6"	
221	CONFERENCE	CPT.	G.B.	P.	G.B.	P.	G.B.	P.	G.B.	P.	AC.T.	—	8'-0"	PREFAB. HEATING UNIT COVERS - P.
222	EX. COM. SECRETARY	CPT.	G.B.	P.	G.B.	P.	G.B.	P.	G.B.	P.	AC.T.	—	8'-0"	DITTO
223	WASHROOM	C.T.	C.T.	—	C.T.	—	C.T.	—	C.T.	—	G.B.	P.	8'-0"	
224	STORAGE	R.F.	G.B.	P.	G.B.	P.	G.B.	P.	G.B.	P.	G.B.	P.	8'-0"	
225	STORAGE	R.F.	G.B.	P.	G.B.	P.	G.B.	P.	G.B.	P.	G.B.	P.	8'-0"	PREFAB. HEATING UNIT COVERS — P.
226	COMMISSIONER	CPT.	G.B.	P.	G.B.	P.	G.B. GLAZING	P. —	G.B.	P.	AC.T.	—	8'-0"	DITTO
227	WELFARE	CPT.	G.B. GLAZING	P —	G.B. GLAZING	P. —	G.B. GLAZING	P. —	G.B.	P.	AC.T.	—	9'-6"	WALL @ GRIDLINES '2' - 'E' - G.B. BOTH SIDES - P. / PREFAB. HEATING UNIT COVERS - P. *8'-6" CEILING BETWEEN 01E
228	VAULT	R.F.	G.B.	P	G.B.	P	G.B.	P.	G.B.	P.	AC.T.	—	9'-6"	
229	VESTIBULE	C.T.	G.B.	P.	G.B.	P.	G.B.	P.	G.B.	P.	G.B.	P.	8'-0"	
230	MEN'S WASHROOM	C.T.	C.T.	—	C.T.	—	C.T.	—	C.T.	—	G.B.	P.	8'-0"	
231	WOMEN'S WASHRM.	C.T.	C.T.	—	C.T.	—	C.T.	—	C.T.	—	G.B.	P.	8'-0"	
232	VESTIBULE	C.T.	G.B.	P.	G.B.	P.	G.B.	P.	G.B.	P.	G.B.	P.	8'-0"	
233	HEALTH	CPT.	OPEN.	—	G.B. GLAZING	P. —	OPEN	—	G.B.	P.	AC.T.	—	9'-6"	WALL @ GRIDLINES '5' - 'E-F' - G.B. BOTH SIDES - P. / PREFAB. HEATING UNIT COVERS - P. *DITTO.
234	CONFERENCE	CPT.	G.B.	P.	G.B.	P.	G.B.	P.	G.B.	P.	AC.T.	—	9'-6"	
235	MEN'S WASHRM.	C.T.	C.T.	—	C.T.	—	C.T.	—	C.T.	—	G.B.	P.	8'-0"	
236	WOMEN'S WASHRM.	C.T.	C.T.	—	C.T.	—	C.T.	—	C.T.	—	G.B.	P.	8'-0"	
237	CORRIDOR	CPT.	G.B.	P.	G.B.	P.	G.B.	P.	OPEN	—	ACT.	—	9'-6"	
238	FIRST AID	CPT.	G.B.	P.	G.B.	P.	G.B.	P.	G.B.	P.	AC.T.	—	9'-6"	
239	EDUCATION	CPT.	OPEN	—	G.B. GLAZING	P. —	G.B.	P.	G.B.	P.	AC.T.	—	9'-6"	PREFAB. HEATING UNIT COVERS — P. *DITTO.
240	VAULT	R.F.	G.B.	P.	G.B.	P.	G.B.	P.	G.B.	P.	AC.T.	—	8'-6"	
241	VESTIBULE	C.T.	G.B.	P.	G.B.	P.	G.B.	P.	G.B.	P.	G.B.	P.	8'-0"	
242	MEN'S WASHRM.	C.T.	C.T.	—	C.T.	—	C.T.	—	C.T.	—	G.B.	P.	8'-0"	
243	WOMEN'S WASHRM.	C.T.	C.T.	—	C.T.	—	C.T.	—	C.T.	—	G.B.	P.	8'-0"	
244	VESTIBULE	C.T.	G.B.	P.	G.B.	P.	G.B.	P.	G.B.	P.	G.B.	P.	8'-0"	
245	JANITOR	CONC. S.T.	G.B.	P.	G.B.	P.	G.B.	P.	G.B.	P.	G.B.	P.	8'-0"	
246	TERR. SECRETARY	CPT.	G.B.	P.	G.B. GLAZING	P. —	G.B. GLAZING	P. —	OPEN	—	AC.T.	—	9'-6"	PREFAB. HEATING UNIT COVERS — P. *DITTO.

NO. DATE REVISIONS DESCRIPTION

A. 89/06/16 Revised to 'As Builts'

DATE SCALE

DRAWN CHECK

APPROVED

PROJECT NO

GOVERNMENT OF THE YUKON TERRITORY

Public Works Travaux publics Canada

FINISH SCHEDULE

DRAWING TITLE

PROJECT TITLE


TERRITORIAL ADMINISTRATION BUILDING

WHITEHORSE, Y.T.


DRAWING NO

A-12

1900

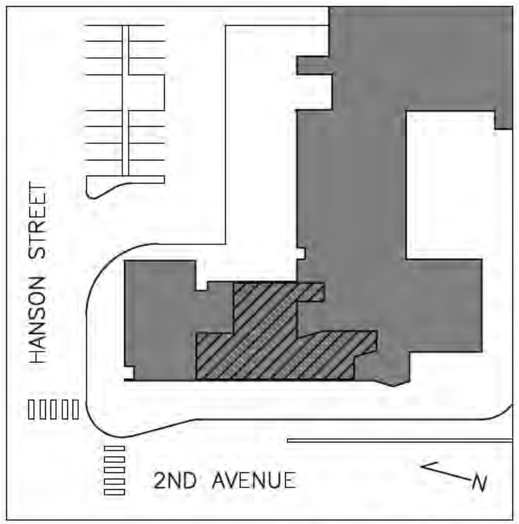

2/A1 **KEY PLAN**
NTS

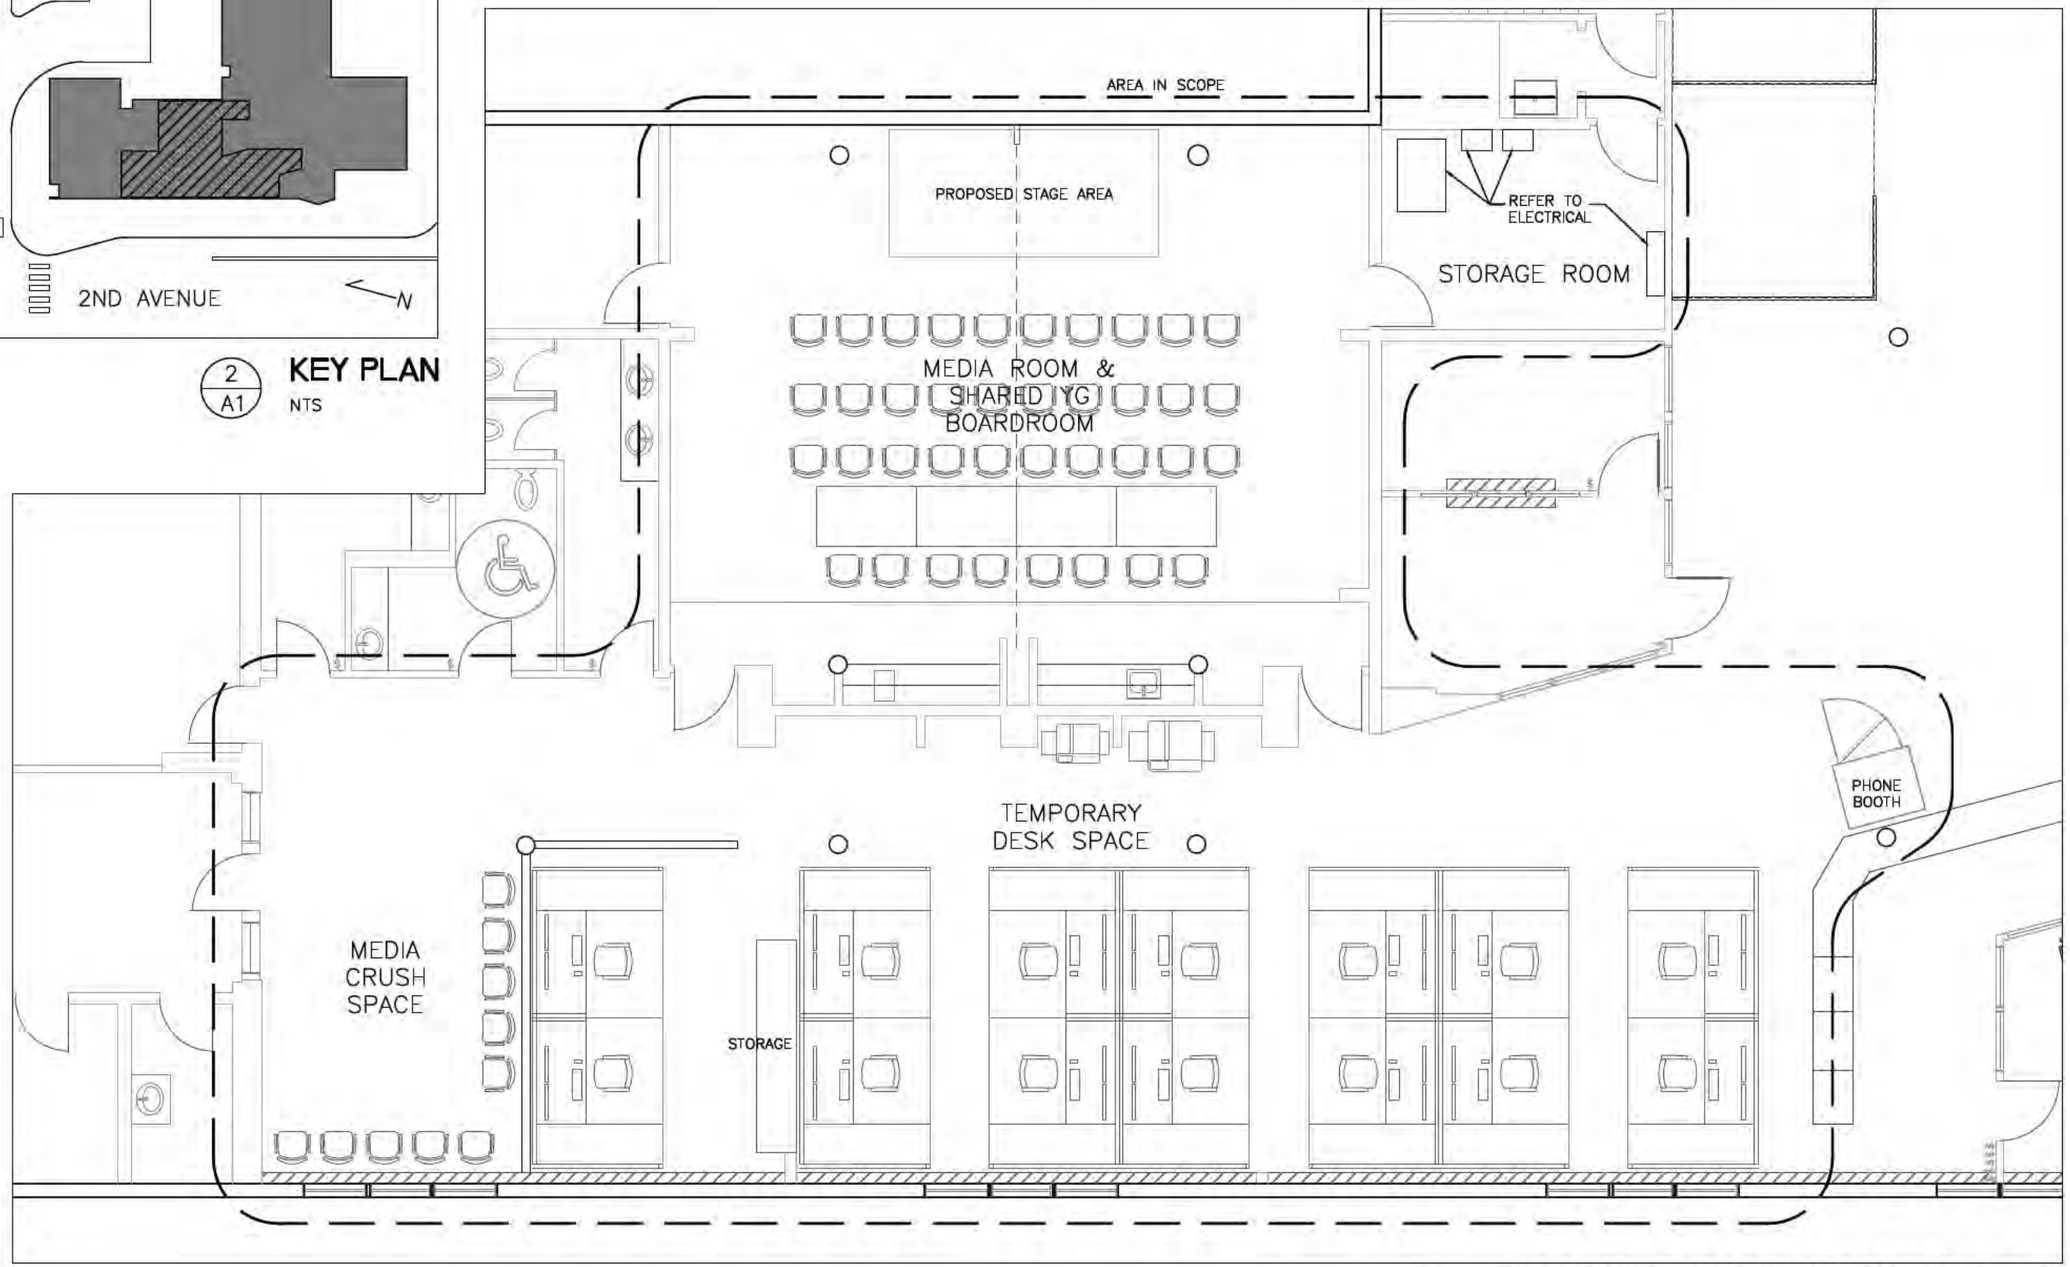

1/A1 **GROUND FLOOR RENOVATION AREA**
NTS

ALL UNITS ARE IN MILLIMETERS UNLESS SPECIFIED

REVISIONS & ISSUES			
03	05/07/22	ISSUED FOR TENDER	ST
02	02/06/22	ISSUED FOR 95% REVIEW	ST
01	04/05/22	ISSUED FOR 65% REVIEW	ST
NO.	dd/mm/yy	DESCRIPTION	BY

DRAWN	ST
CHK'D	–
SCALE	AS INDICATED

Yukon
Highways and Public Works
Property Management Division


BLDG # 1259
MAIN ADMINISTRATION BUILDING

2071 SECOND AVENUE
WHITEHORSE, YT

GROUND FLOOR
MEETING/MEDIA ROOM &
TEMPORARY DESK SPACE

Sheet: A1 OF 6

REV: 00

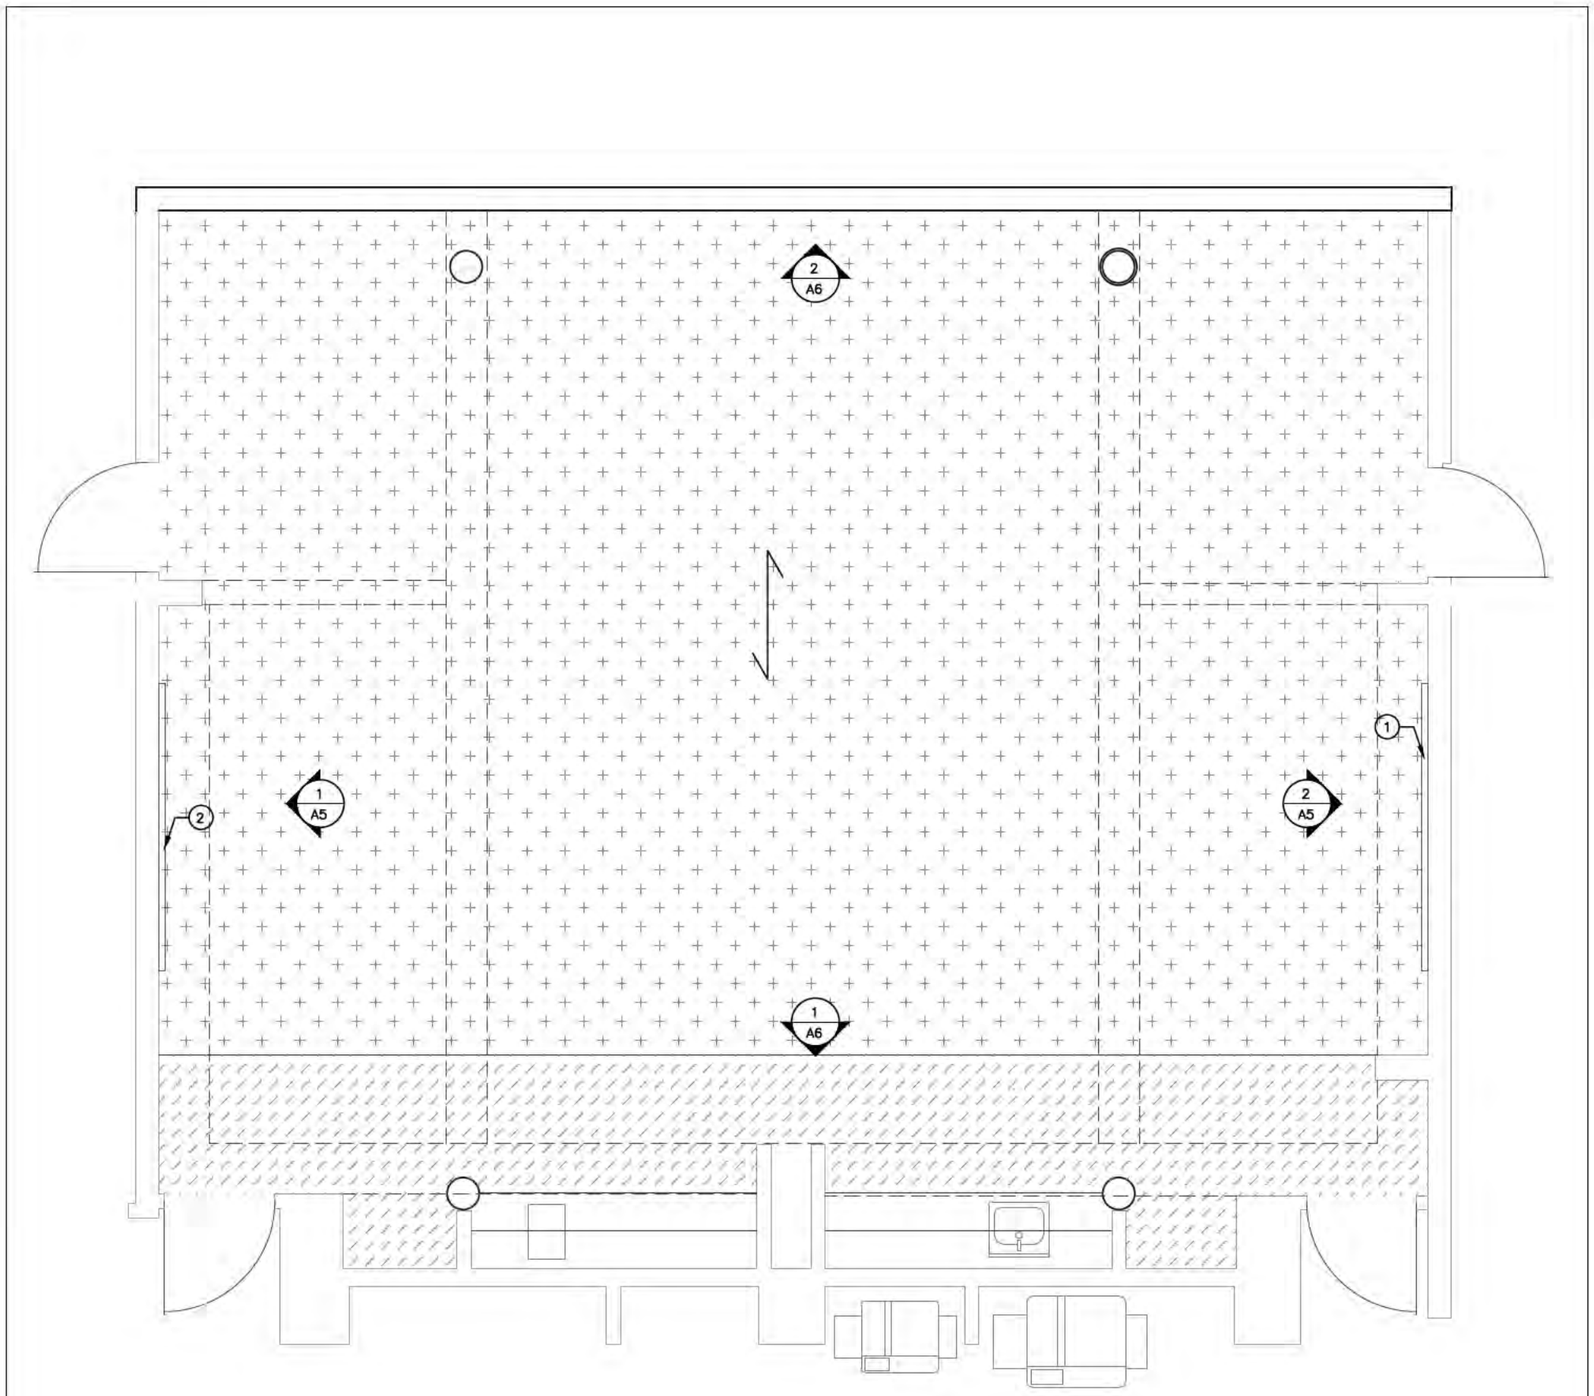

GENERAL NOTE:

EXISTING FLOOR MAKES NOISE WITH MOVEMENT FOR WHICH NON-STRUCTURAL REPAIR SHALL BE ADDRESSED DURING CARPET REPLACEMENT. TIGHTEN FASTENINGS TO UNDERLAYMENT, REPLACEMENT OF UNDERLYING MATERIAL ETC. AS REQUIRED.

REMOVE & REPLACE EXISTING CARPET WITH ASHLAR INSTALLATION CARPET TILE. STANDARD OF ACCEPTANCE- BEAULIEU, FASCINATION, 03 INCLINATION.

EXISTING RESILIENT FLOORING TO REMAIN.

NOTES:

1. EXISTING TV TO BE REMOUNTED. SEE ELECTRICAL FOR CONNECTIONS REQUIRED.
2. NEW 8'x4' MAGNETIC CERAMIC WHITEBOARD WITH ALUMINUM MARKER TRAY.

ALL UNITS ARE IN MILLIMETERS UNLESS SPECIFIED

REVISIONS & ISSUES			
03	05/07/22	ISSUED FOR TENDER	ST
02	02/06/22	ISSUED FOR 95% REVIEW	ST
01	04/05/22	ISSUED FOR 65% REVIEW	ST
NO.	dd/mm/yy	DESCRIPTION	BY

DRAWN	ST
CHK'D	–
SCALE	AS INDICATED

Yukon
Highways and Public Works
Property Management Division


BLDG # 1259
MAIN ADMINISTRATION BUILDING

2071 SECOND AVENUE
WHITEHORSE, YT

FLOOR FINISH PLAN

Sheet A2 OF 6

REV. 00

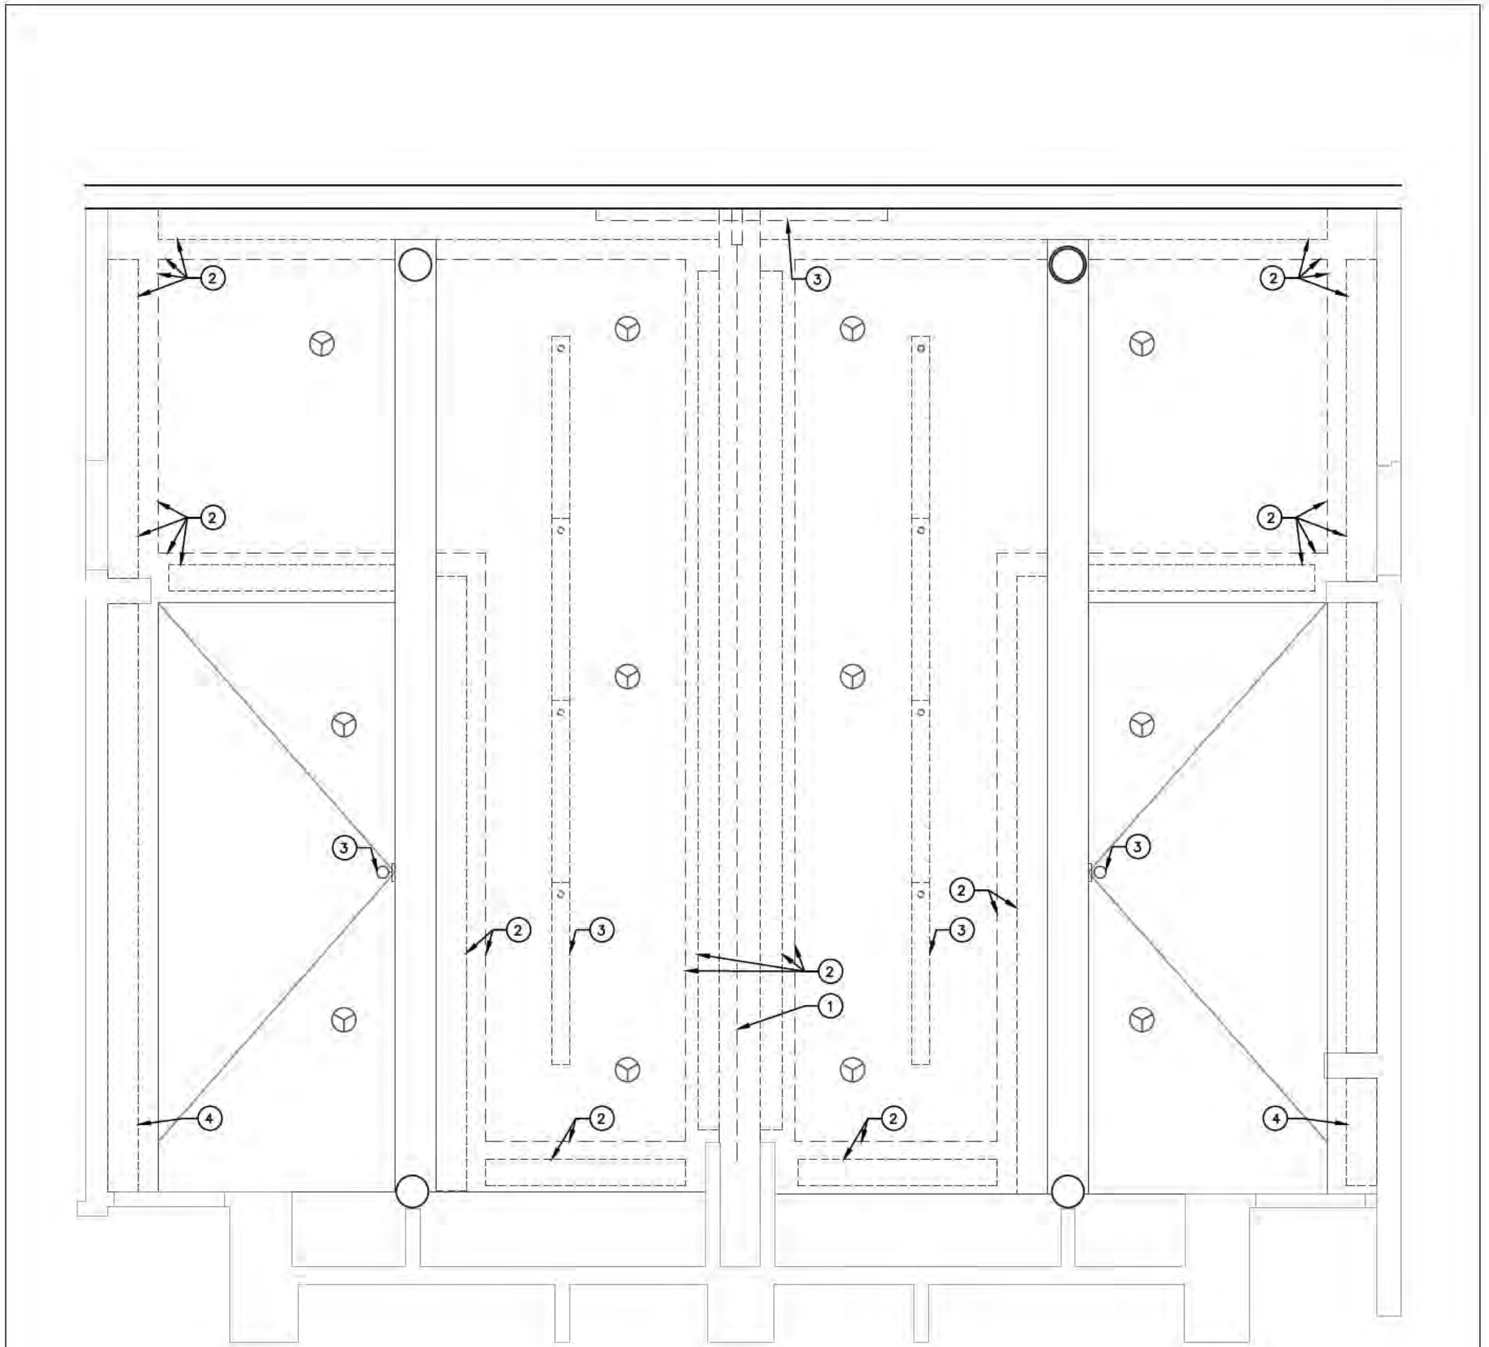

SPRINKLER HEAD

NOTES:

1. DEMO OPERABLE WALL & TRACK. VERIFY ANY EXISTING STRUCTURE ABOVE ON SITE.
2. DEMO BULKHEADS AS SHOWN INCLUDING ANY RECESSED LIGHTING.
3. REMOVE EXISTING LIGHT FIXTURES & TERMINATE– REFER TO ELECTRICAL.
4. REMOVE RECESSED LIGHTING FROM BULKHEAD THEN PATCH & PAINT GWB TO MATCH ADJACENT SURFACES.
5. REMOVE PROJECTOR SCREEN & HARDWARE. CLOSE OPENING TO MATCH ADJACENT SURFACES.
6. EXISTING SPRINKLER HEAD TO REMAIN

ALL UNITS ARE IN MILLIMETERS UNLESS SPECIFIED

REVISIONS & ISSUES			
03	05/07/22	ISSUED FOR TENDER	ST
02	02/06/22	ISSUED FOR 95% REVIEW	ST
01	04/05/22	ISSUED FOR 65% REVIEW	ST
NO.	dd/mm/yy	DESCRIPTION	BY

DRAWN	ST
CHK'D	–
SCALE	AS INDICATED

Yukon
Highways and Public Works
Property Management Division


BLDG # 1259
MAIN ADMINISTRATION BUILDING

2071 SECOND AVENUE
WHITEHORSE, YT

RCP DEMO PLAN

Sheet A3 OF 6

REV: 00

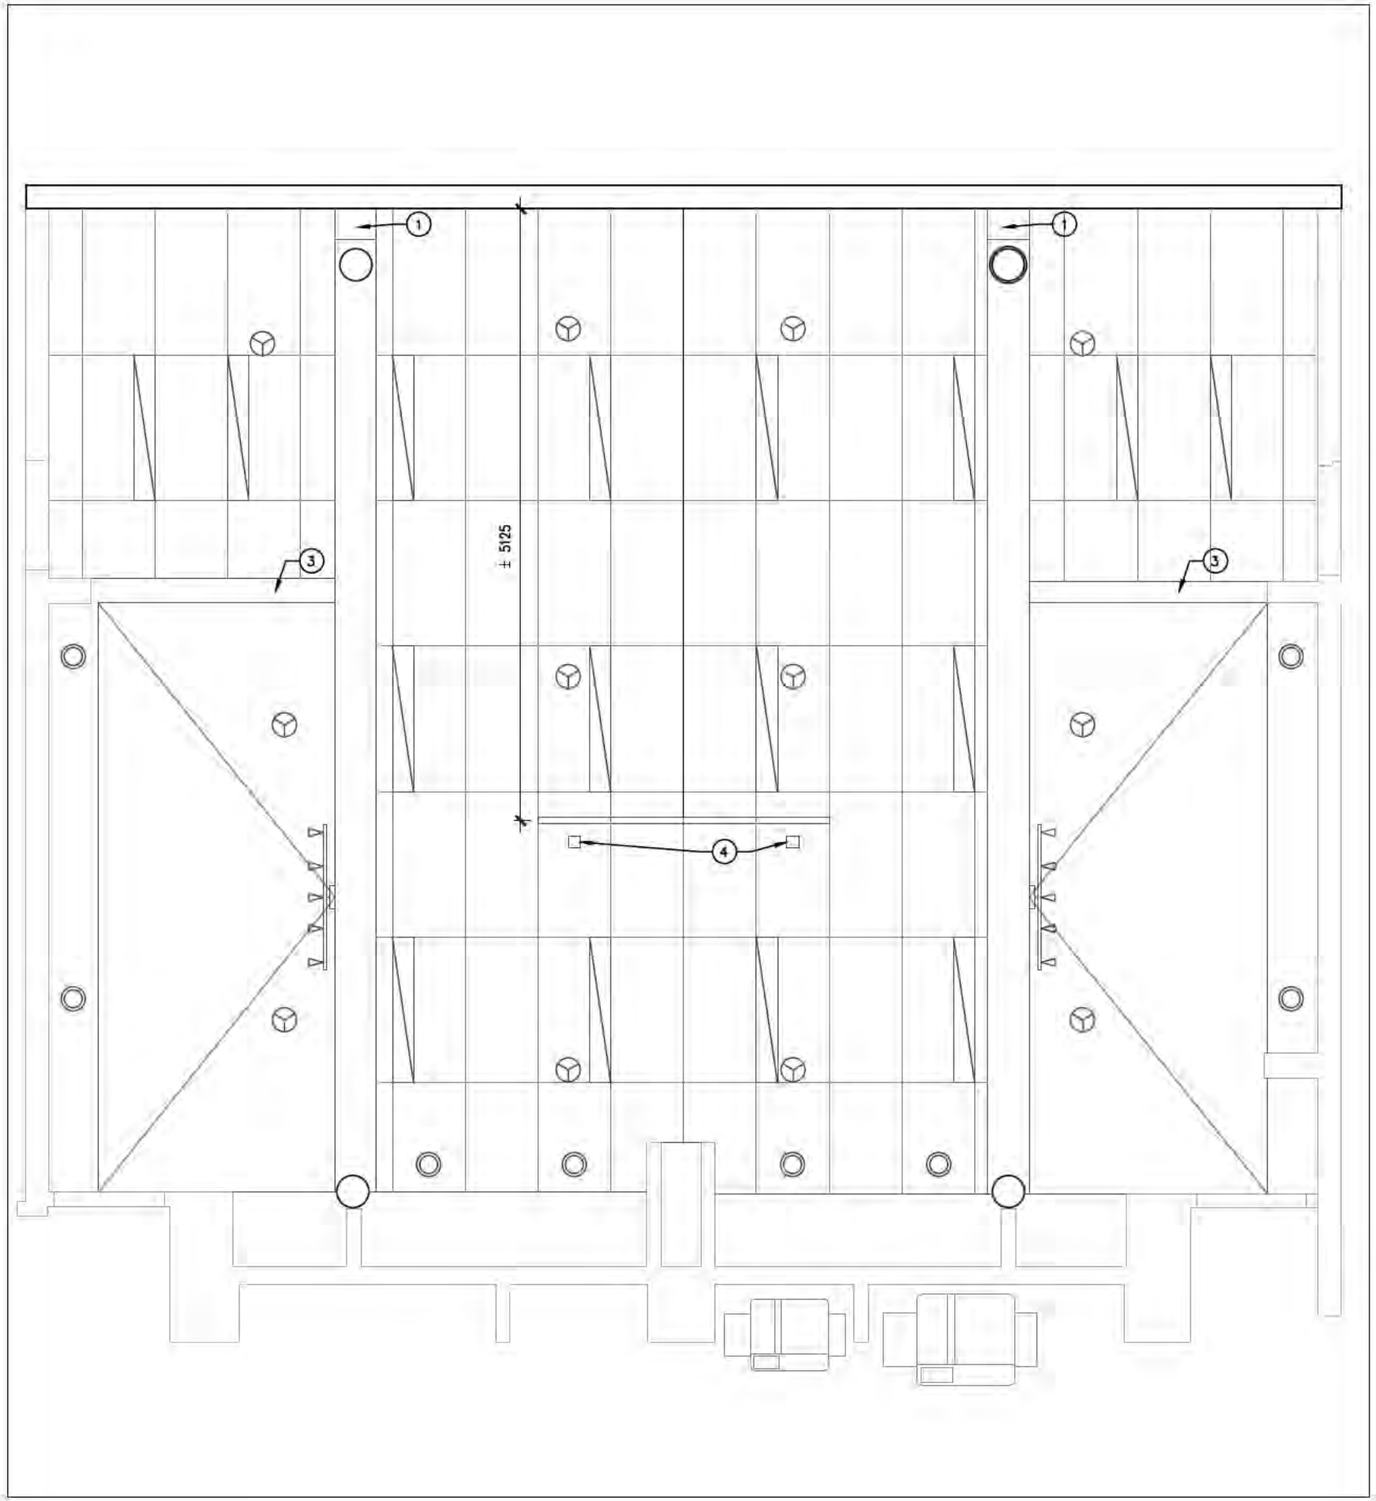

LEGEND:
REFER TO ELECTRICAL FOR SPECIFICATIONS

- SPRINKLER HEADS TO BE EXTENDED AS REQUIRED TO NEW CEILING HEIGHT
- POTLIGHT. REFER TO ELECTRICAL.
- SURFACE MOUNTED TRACK LIGHT. REFER TO ELECTRICAL.
- ACOUSTIC CEILING PANEL LIGHT. REFER TO ELECTRICAL.
- NEW ACOUSTIC CEILING TILE STANDARD OF ACCEPTANCE– ARMSTRONG, OPTIMA TEGULAR, 24" x 48"

NOTES:

1. EXTEND BEAM BOX TO WALL. MATCH FINISHES TO ADJACENT SURFACES.
2. RESERVED
3. RETAIN OR REBUILD PERIMITER WALL AT BOUNDARY OF SKYLIGHT LIGHT WELL. MATCH HEIGHT TO ADJACENT BULKHEADS.
4. NEW 2.44m (8ft) STAGE LIGHTING PIPE WITH POWER SUPPLY (REFER TO ELECTRICAL)

ALL UNITS ARE IN MILLIMETERS UNLESS SPECIFIED

REVISIONS & ISSUES			
03	05/07/22	ISSUED FOR TENDER	ST
02	02/06/22	ISSUED FOR 95% REVIEW	ST
01	04/05/22	ISSUED FOR 65% REVIEW	ST
NO.	dd/mm/yy	DESCRIPTION	BY

DRAWN ST
CHK'D —
SCALE AS INDICATED

Yukon
Highways and Public Works
Property Management Division


BLDG # 1259
MAIN ADMINISTRATION BUILDING

2071 SECOND AVENUE
WHITEHORSE, YT


MEETING/MEDIA ROOM
RCP

Sheet A4 OF 6

REV. 00

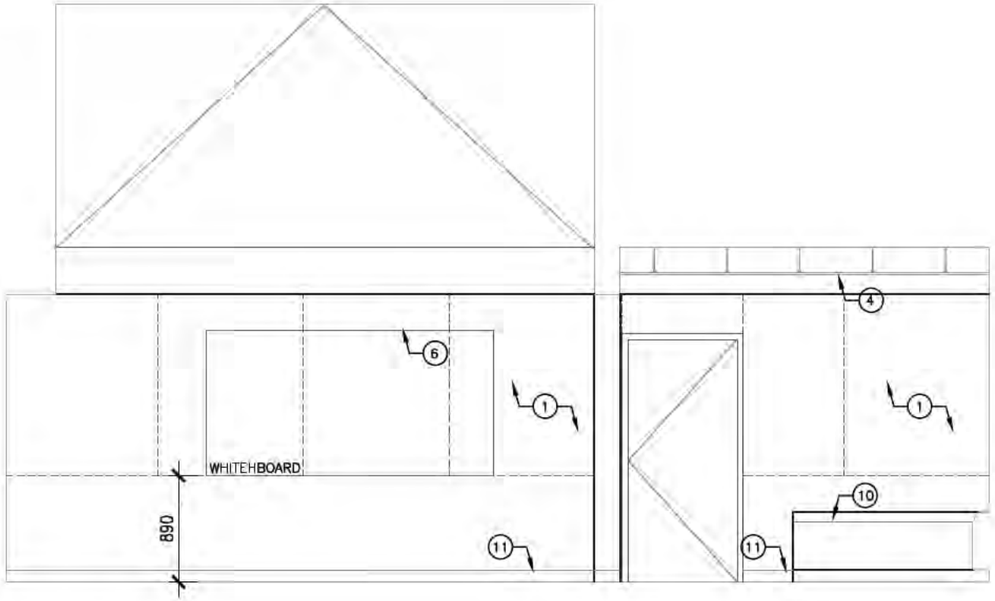

2 / A5 **SOUTH ELEVATION**

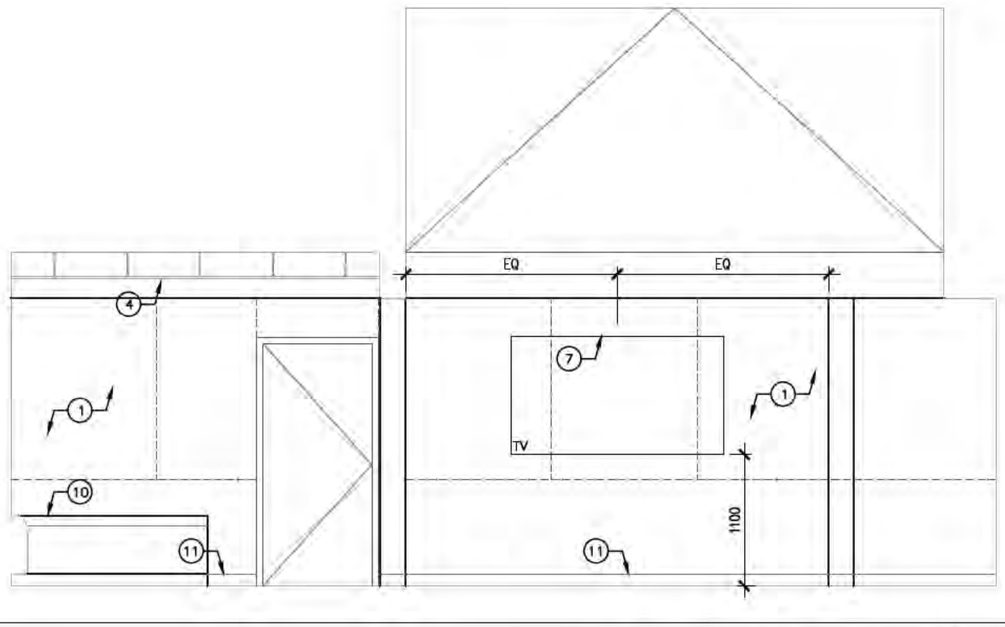

1 / A5 **NORTH ELEVATION**

GENERAL NOTES:
FRESH PAINT ON RADIATORS, CEILING & WALLS. STANDARD OF ACCEPTANCE BENJAMIN MOORE SIMPLY WHITE OC-117.

1. REMOVE ACOUSTIC WALL TREATMENT. MAKE GOOD, PATCH, & PAINT GWB.
2. REMOVE WHITEBOARD & PLYWOOD PANELLING. MAKE GOOD, PATCH, & PAINT GWB.
3. NEW 8FTx4FT DRY ERASE MAGNETIC PORCELAIN WHITEBOARD WITH ALUMINUM MARKER SHELF.
4. NEW ACOUSTIC CEILING TILE. STANDARD OF ACCEPTANCE- ARMSTRONG, OPTIMA TEGULAR, 24" x 48"
5. REMOVE EXISTING OPERABLE PARTITION & TRACK.
6. NEW 8'x4' MAGNETIC CERAMIC WHITEBOARD WITH ALUMINUM MARKER TRAY.
7. REMOVE & REMOUNT TV AFTER REMOVAL OF EXG. ACOUSTIC WALL COVERING & PATCH & PAINT OF WALL.
8. NEW ELECTRIC ROLLER BLINDS. TWO PANELS PER WINDOW TO OPERATE AS ONE. STANDARD OF ACCEPTANCE HUNTER DOUGLAS RB 500 WITH SIDE CHANNELS, SHEER WEAR 7100 FABRIC IN WHITE, 0% TRANSPARENCY. MOUNTING BASED ON MANUFACTURER'S SUGGESTION TO MAXIMIZE BLACKOUT CONDITIONS. REFER TO ELECTRICAL FOR OPERATION & CONTROLS.
9. NEW 2.44m (8ft) STAGE LIGHTING PIPE WITH POWER SUPPLY (SEE ELECTRICAL)
10. EXG. RADIATORS
11. REPLACE EXG. WITH NEW RUBBER WALL BASE. STANDARD OF ACCEPTANCE, JOHNSONITE RUBBER BASE, BURNT UMBER 63. MATCH HEIGHTS TO EXISTING.
12. INFILL REMOVED OPERABLE PARTITION POCKET. MAKE ALLOWANCE FOR OUTLETS ETC, AS REQUIRED BY ELECTRICAL.

ALL UNITS ARE IN MILLIMETERS UNLESS SPECIFIED

REVISIONS & ISSUES			
03	05/07/22	ISSUED FOR TENDER	ST
02	02/06/22	ISSUED FOR 95% REVIEW	ST
01	04/05/22	ISSUED FOR 65% REVIEW	ST
NO.	dd/mm/yy	DESCRIPTION	BY
DRAWN	ST	SCALE	AS INDICATED
CHK'D	–		

Yukon
Highways and Public Works
Property Management Division


BLDG # 1259
MAIN ADMINISTRATION BUILDING

2071 SECOND AVENUE
WHITEHORSE, YT

2nd FLOOR PLAN:
MEETING/MEDIA ROOM
ELEVATIONS


Sheet: A5 OF 6

REV: 00

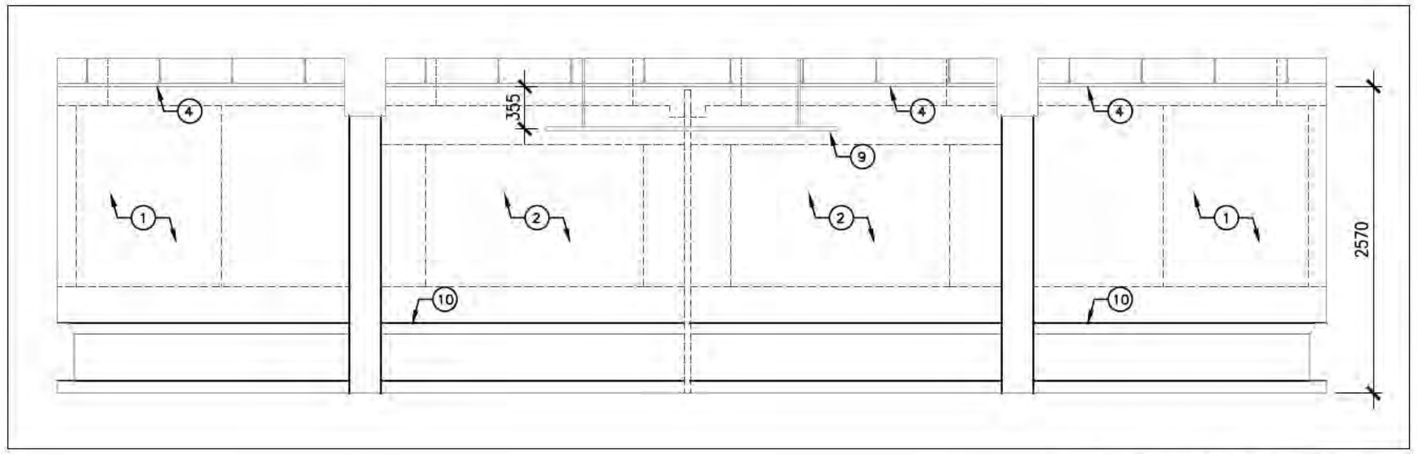

2
A6

EAST ELEVATION

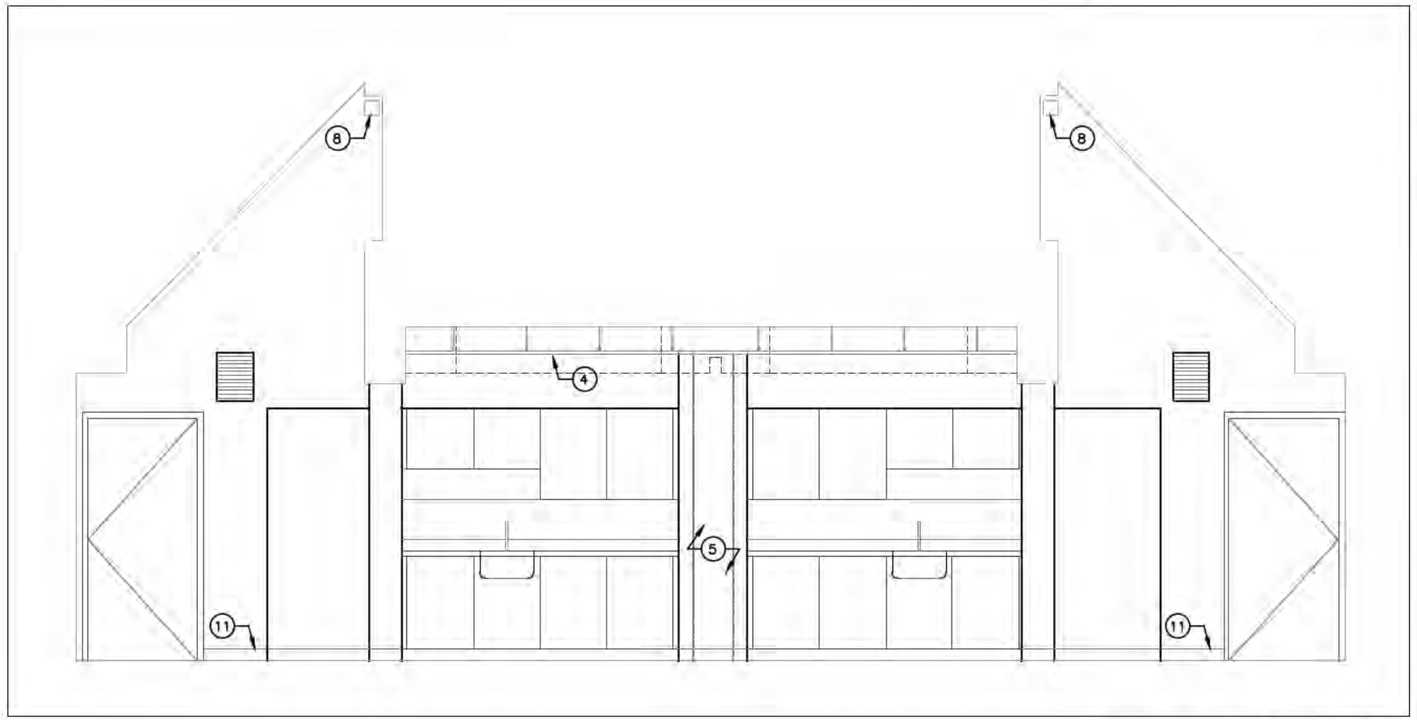

1
A6

WEST ELEVATION

GENERAL NOTES:
FRESH PAINT ON RADIATORS, CEILING & WALLS. STANDARD OF ACCEPTANCE BENJAMIN MOORE SIMPLY WHITE OC-117.

1. REMOVE ACOUSTIC WALL TREATMENT. MAKE GOOD, PATCH, & PAINT GWB.
2. REMOVE WHITEBOARD & PLYWOOD PANELLING. MAKE GOOD, PATCH, & PAINT GWB.
3. NEW 8FTx4FT DRY ERASE MAGNETIC PORCELAIN WHITEBOARD WITH ALUMINUM MARKER SHELF.
4. NEW ACOUSTIC CEILING TILE. STANDARD OF ACCEPTANCE- ARMSTRONG, OPTIMA TEGULAR, 24" x 48"
5. REMOVE EXISTING OPERABLE PARTITION & TRACK.
6. NEW 8'x4' MAGNETIC CERAMIC WHITEBOARD WITH ALUMINUM MARKER TRAY.
7. REMOVE & REMOUNT TV AFTER REMOVAL OF EXG. ACOUSTIC WALL COVERING & PATCH & PAINT OF WALL.
8. NEW ELECTRIC ROLLER BLINDS. TWO PANELS PER WINDOW TO OPERATE AS ONE. STANDARD OF ACCEPTANCE HUNTER DOUGLAS RB 500 WITH SIDE CHANNELS, SHEER WEAR 7100 FABRIC IN WHITE, 0% TRANSPARENCY. MOUNTING BASED ON MANUFACTURER'S SUGGESTION TO MAXIMIZE BLACKOUT CONDITIONS. REFER TO ELECTRICAL FOR OPERATION & CONTROLS.
9. NEW 2.44m (8ft) STAGE LIGHTING PIPE WITH POWER SUPPLY (SEE ELECTRICAL)
10. EXG. RADIATORS
11. REPLACE EXG. WITH NEW RUBBER WALL BASE. STANDARD OF ACCEPTANCE, JOHNSONITE RUBBER BASE, BURNT UMBER 63. MATCH HEIGHTS TO EXISTING.
12. INFILL REMOVED OPERABLE PARTITION POCKET. MAKE ALLOWANCE FOR OUTLETS ETC. AS REQUIRED BY ELECTRICAL.

ALL UNITS ARE IN MILLIMETERS UNLESS SPECIFIED

REVISIONS & ISSUES

NO.	dd/mm/yy	DESCRIPTION	BY
03	05/07/22	ISSUED FOR TENDER	ST
02	02/06/22	ISSUED FOR 95% REVIEW	ST
01	04/05/22	ISSUED FOR 65% REVIEW	ST

DRAWN ST
CHK'D –
SCALE AS INDICATED

Yukon
Highways and Public Works
Property Management Division


BLDG # 1259
MAIN ADMINISTRATION BUILDING

2071 SECOND AVENUE
WHITEHORSE, YT


2nd FLOOR PLAN:
MEETING/MEDIA ROOM
ELEVATIONS

Sheet A6 OF 6

REV: 00

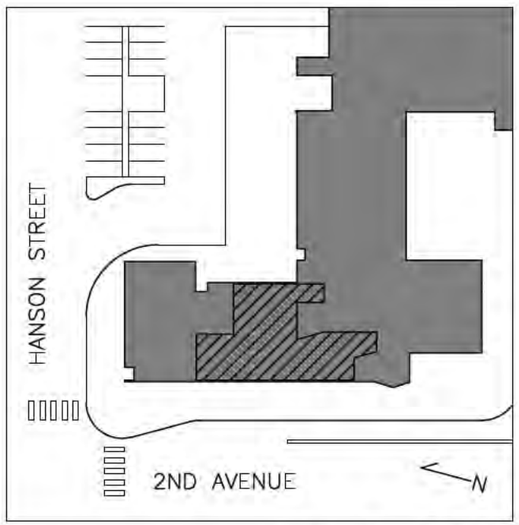

2/A1 **KEY PLAN**
NTS

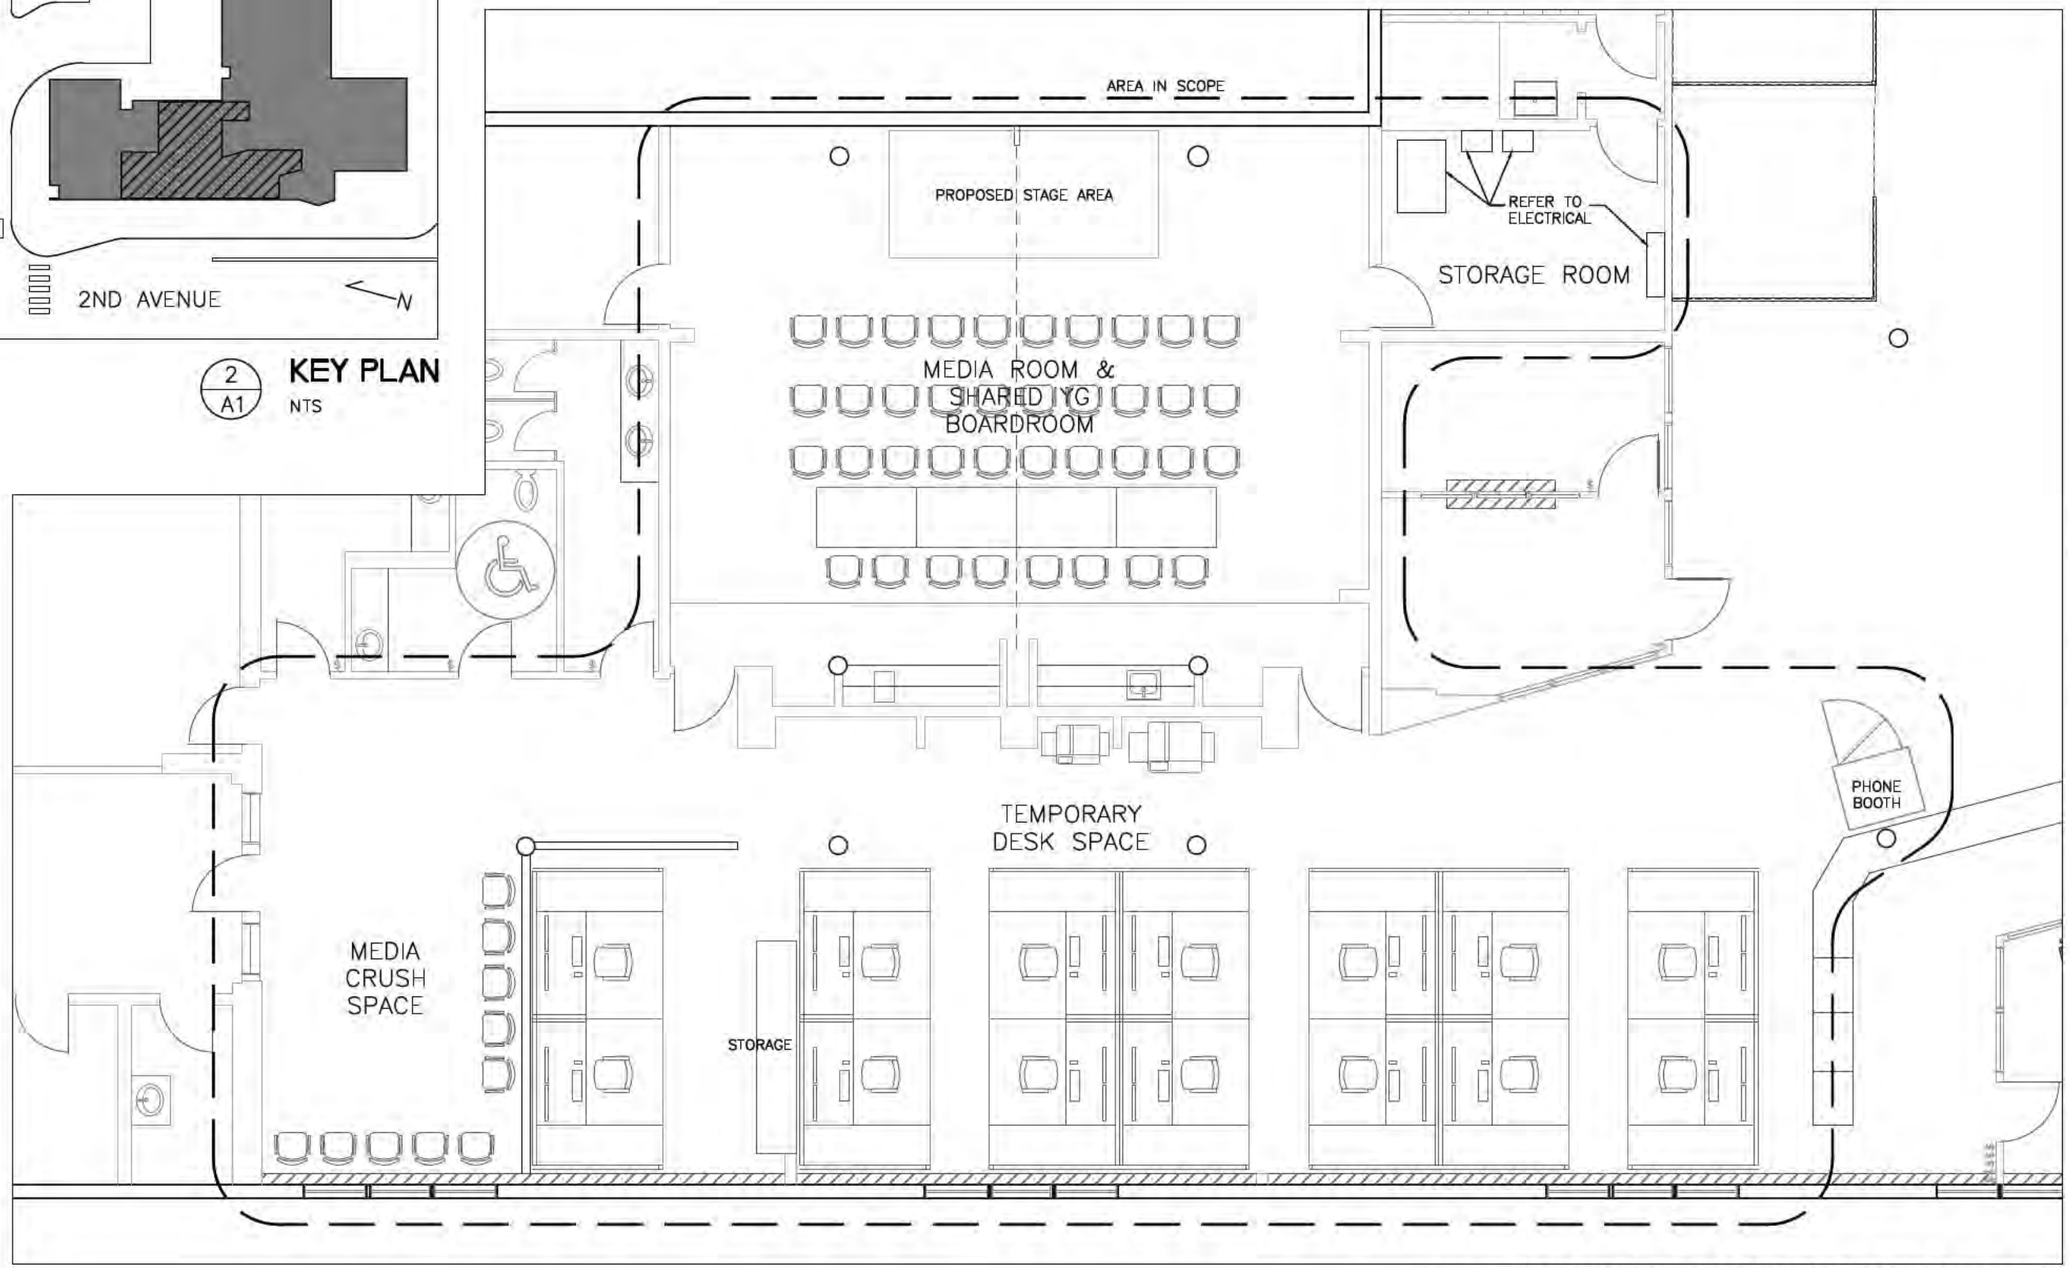

1/A1 **GROUND FLOOR RENOVATION AREA**
NTS

ALL UNITS ARE IN MILLIMETERS UNLESS SPECIFIED

REVISIONS & ISSUES		
NO.	dd/mm/yy	DESCRIPTION BY
00	--/--/--	- -
DRAWN	ST	SCALE AS INDICATED
CHK'D	-	

Yukon
Highways and Public Works
Property Management Division


BLDG # 1259
MAIN ADMINISTRATION BUILDING

2071 SECOND AVENUE
WHITEHORSE, YT

GROUND FLOOR
MEETING/MEDIA ROOM &
TEMPORARY DESK SPACE

Sheet: A1 OF 6

REV: 00

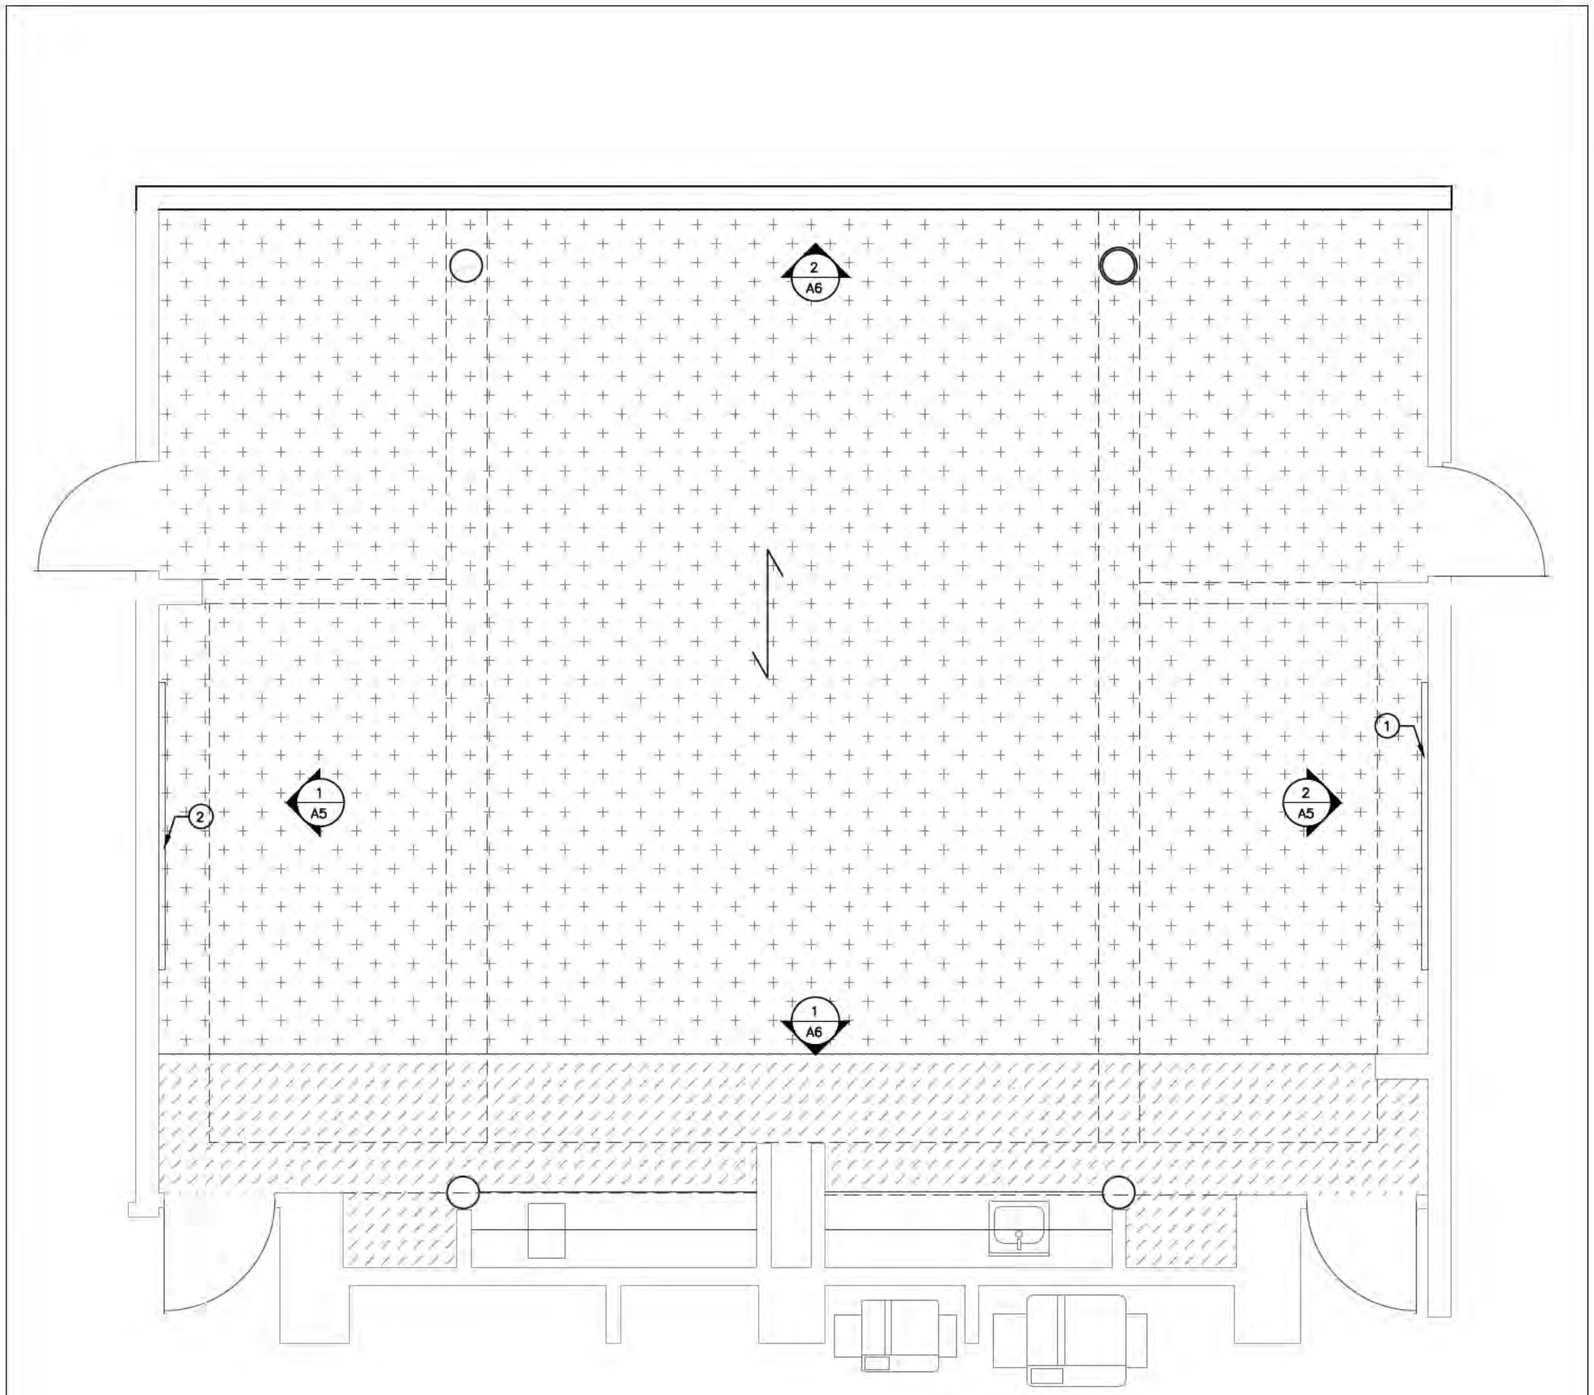

GENERAL NOTE:

EXISTING FLOOR MAKES NOISE WITH MOVEMENT FOR WHICH NON-STRUCTURAL REPAIR SHALL BE ADDRESSED DURING CARPET REPLACEMENT. TIGHTEN FASTENINGS TO UNDERLAYMENT, REPLACEMENT OF UNDERLYING MATERIAL ETC. AS REQUIRED.

REMOVE & REPLACE EXISTING CARPET WITH ASHLAR INSTALLATION CARPET TILE. STANDARD OF ACCEPTANCE- BEAULIEU, FASCINATION, 03 INCLINATION.

EXISTING RESILIENT FLOORING TO REMAIN.

NOTES:

1. EXISTING TV TO BE REMOUNTED. SEE ELECTRICAL FOR CONNECTIONS REQUIRED.
2. NEW 8'x4' MAGNETIC CERAMIC WHITEBOARD WITH ALUMINUM MARKER TRAY.

ALL UNITS ARE IN MILLIMETERS UNLESS SPECIFIED

REVISIONS & ISSUES			
00	--/--/--	-	-
NO.	dd/mm/yy	DESCRIPTION	BY
DRAWN	ST	SCALE	1:50
CHK'D	-		

Yukon
Highways and Public Works
Property Management Division


BLDG # 1259
MAIN ADMINISTRATION BUILDING

2071 SECOND AVENUE
WHITEHORSE, YT

FLOOR FINISH PLAN

Sheet A2 OF 6

REV. 00

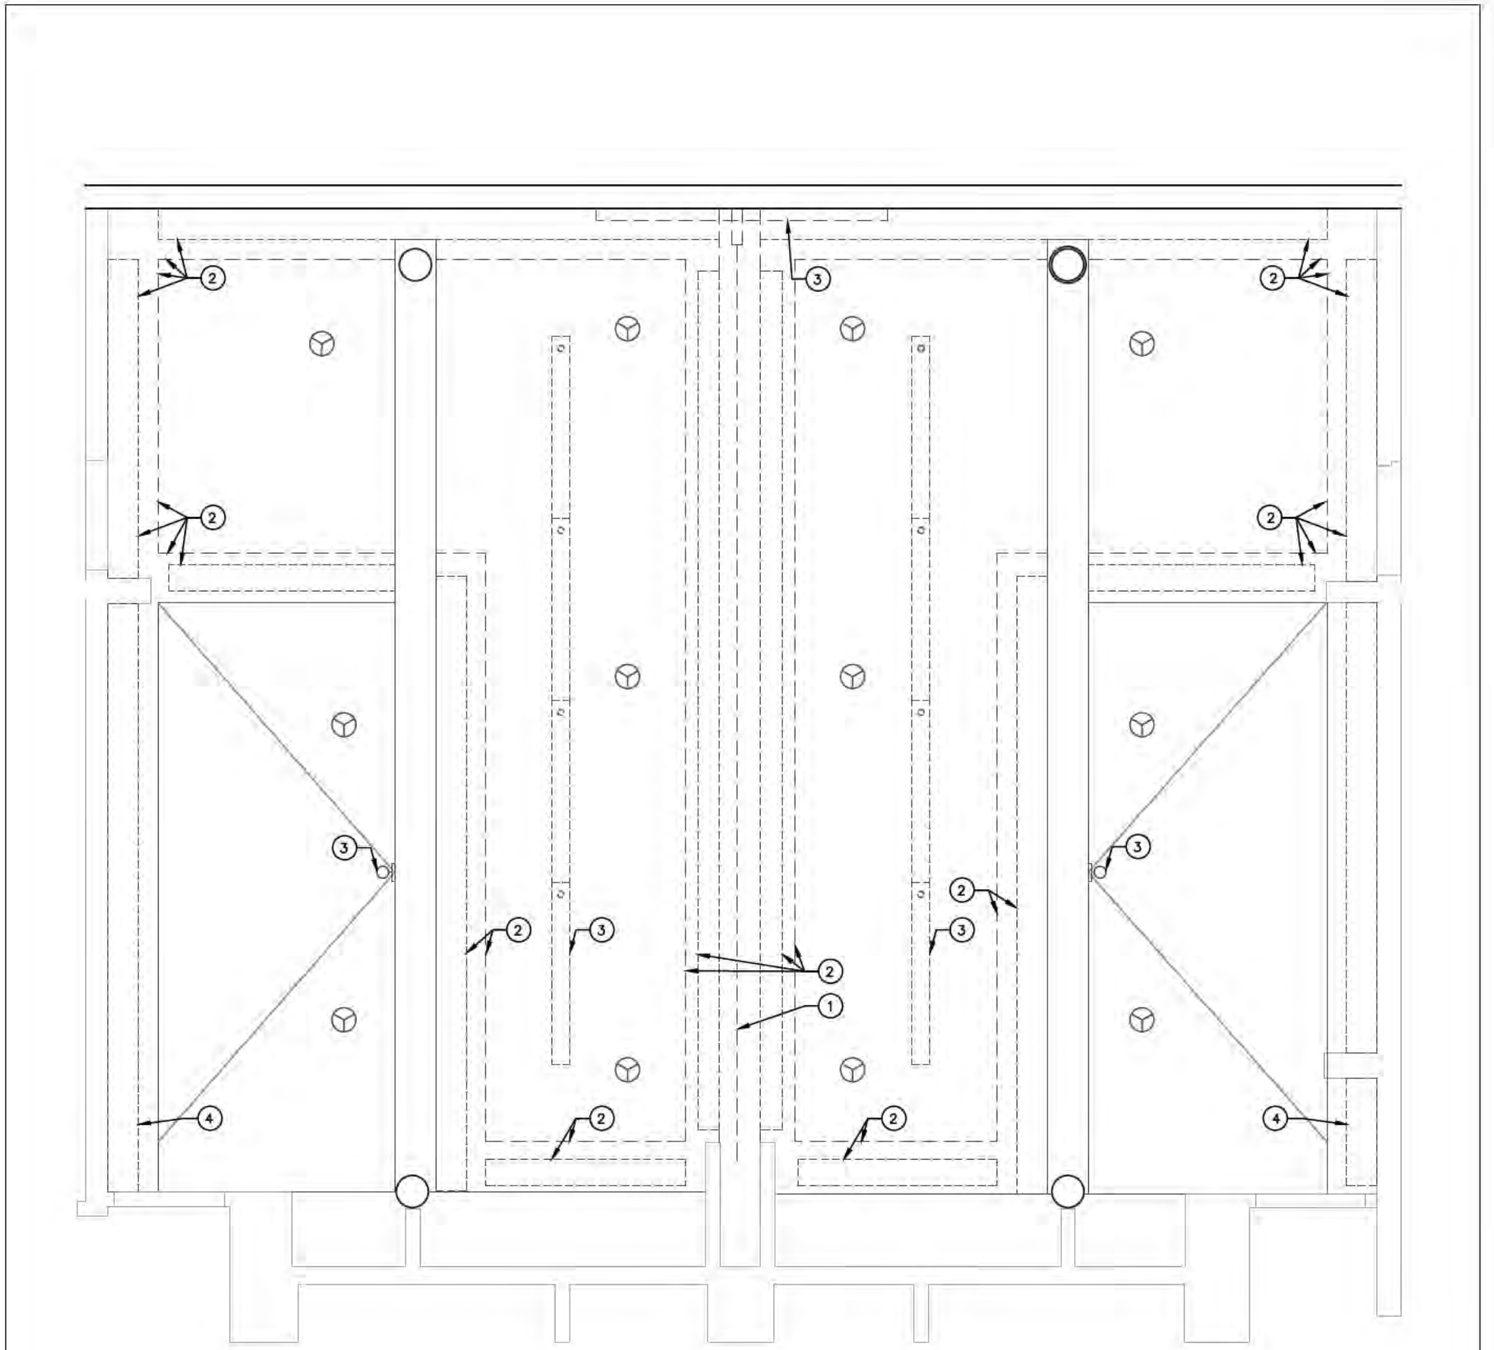

SPRINKLER HEAD

NOTES:

1. DEMO OPERABLE WALL & TRACK. VERIFY ANY EXISTING STRUCTURE ABOVE ON SITE.
2. DEMO BULKHEADS AS SHOWN INCLUDING ANY RECESSED LIGHTING.
3. REMOVE EXISTING LIGHT FIXTURES & TERMINATE– REFER TO ELECTRICAL.
4. REMOVE RECESSED LIGHTING FROM BULKHEAD THEN PATCH & PAINT GWB TO MATCH ADJACENT SURFACES.
5. REMOVE PROJECTOR SCREEN & HARDWARE. CLOSE OPENING TO MATCH ADJACENT SURFACES.
6. EXISTING SPRINKLER HEAD TO REMAIN

ALL UNITS ARE IN MILLIMETERS UNLESS SPECIFIED

REVISIONS & ISSUES			
00	--/--/--	–	–
NO.	dd/mm/yy	DESCRIPTION	BY
DRAWN	ST	SCALE	1:50
CHK'D	–		

Yukon
Highways and Public Works
Property Management Division


BLDG # 1259
MAIN ADMINISTRATION BUILDING

2071 SECOND AVENUE
WHITEHORSE, YT

RCP DEMO PLAN

Sheet A3 OF 6

REV. 00

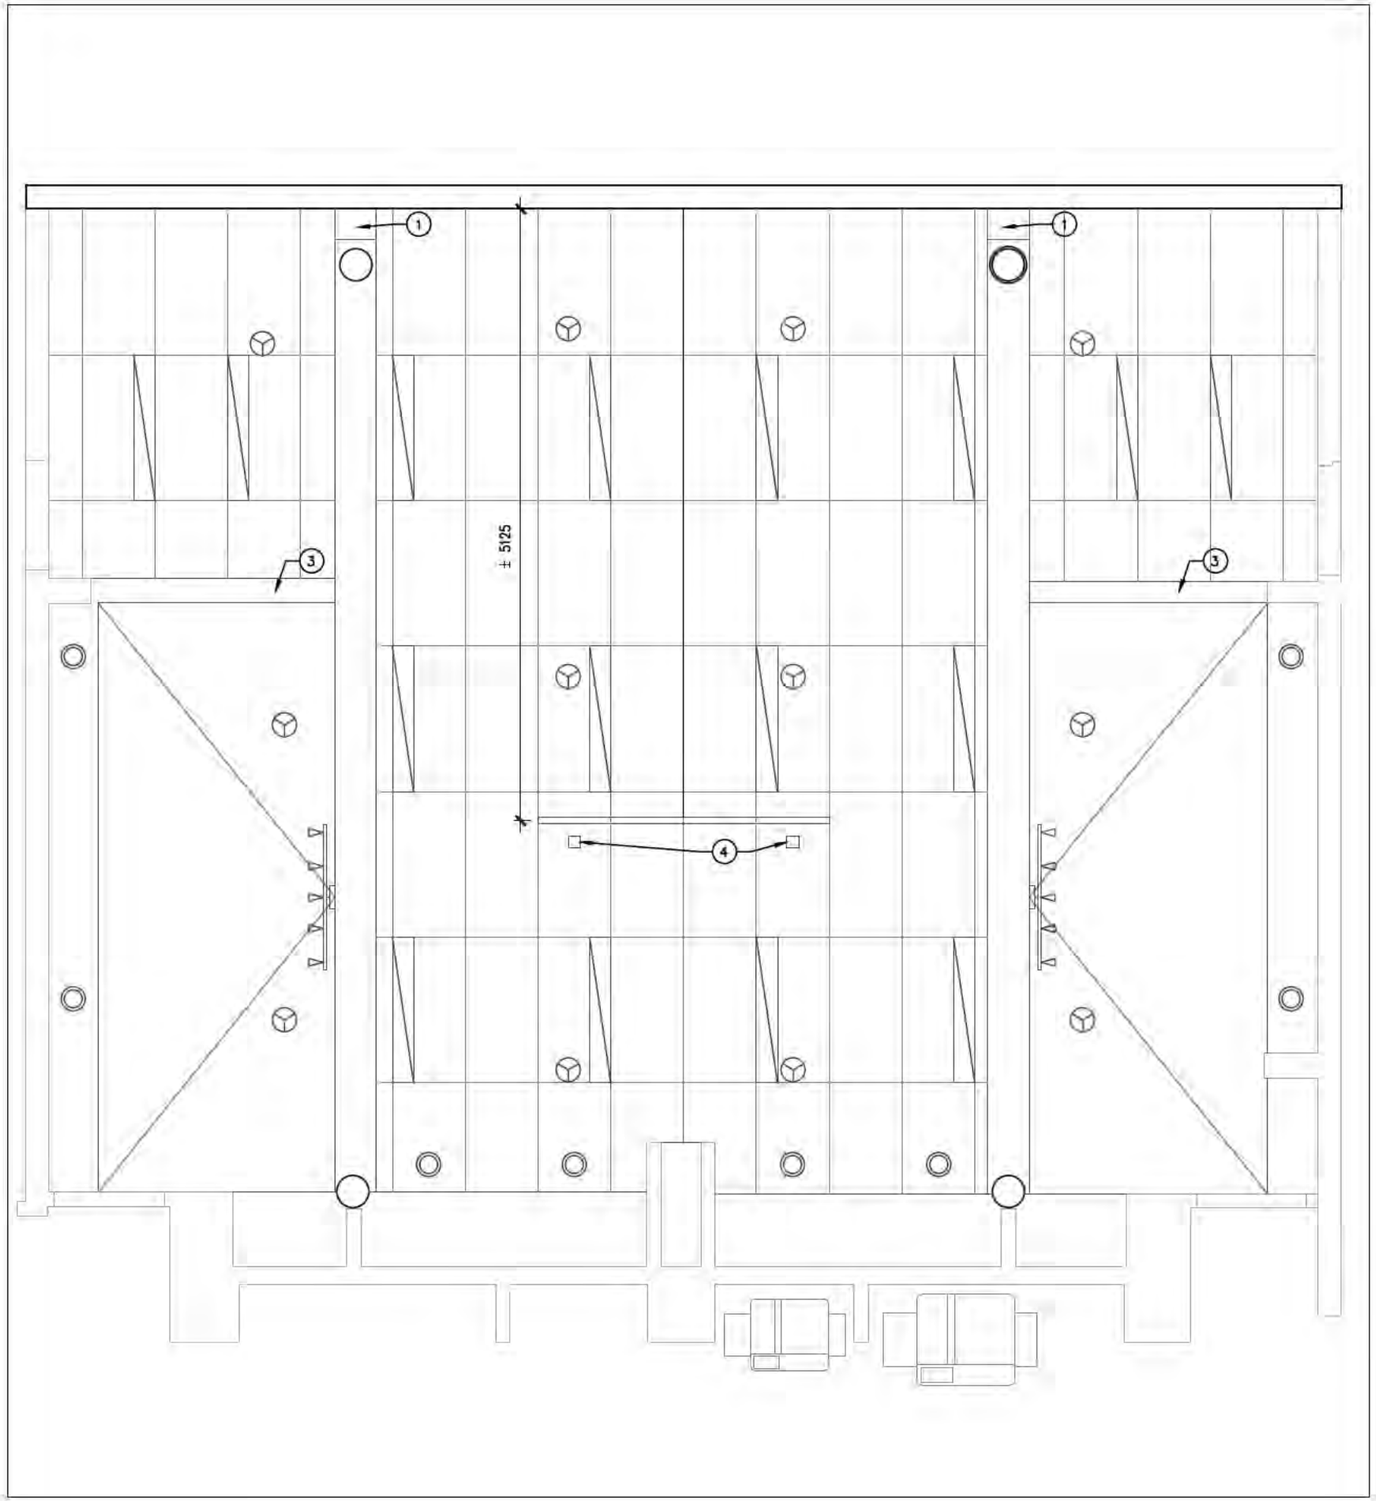

LEGEND:
REFER TO ELECTRICAL FOR SPECIFICATIONS

SPRINKLER HEADS TO BE EXTENDED AS REQUIRED TO NEW CEILING HEIGHT

POTLIGHT. REFER TO ELECTRICAL.

SURFACE MOUNTED TRACK LIGHT. REFER TO ELECTRICAL.

ACOUSTIC CEILING PANEL LIGHT. REFER TO ELECTRICAL.

NEW ACOUSTIC CEILING TILE STANDARD OF ACCEPTANCE– ARMSTRONG, OPTIMA TEGULAR, 24" x 48"

NOTES:

(1) EXTEND BEAM BOX TO WALL. MATCH FINISHES TO ADJACENT SURFACES.

(2) RESERVED

(3) RETAIN OR REBUILD PERIMITER WALL AT BOUNDARY OF SKYLIGHT LIGHT WELL. MATCH HEIGHT TO ADJACENT BULKHEADS.

(4) NEW 2.44m (8ft) STAGE LIGHTING PIPE WITH POWER SUPPLY (REFER TO ELECTRICAL)

ALL UNITS ARE IN MILLIMETERS UNLESS SPECIFIED

REVISIONS & ISSUES			
00	--/--/--	–	–
NO.	dd/mm/yy	DESCRIPTION	BY
DRAWN	ST	SCALE	1:50
CHK'D	–		

Yukon
Highways and Public Works
Property Management Division


BLDG # 1259
MAIN ADMINISTRATION BUILDING

2071 SECOND AVENUE
WHITEHORSE, YT


MEETING/MEDIA ROOM
RCP

Sheet A4 OF 6

REV. 00

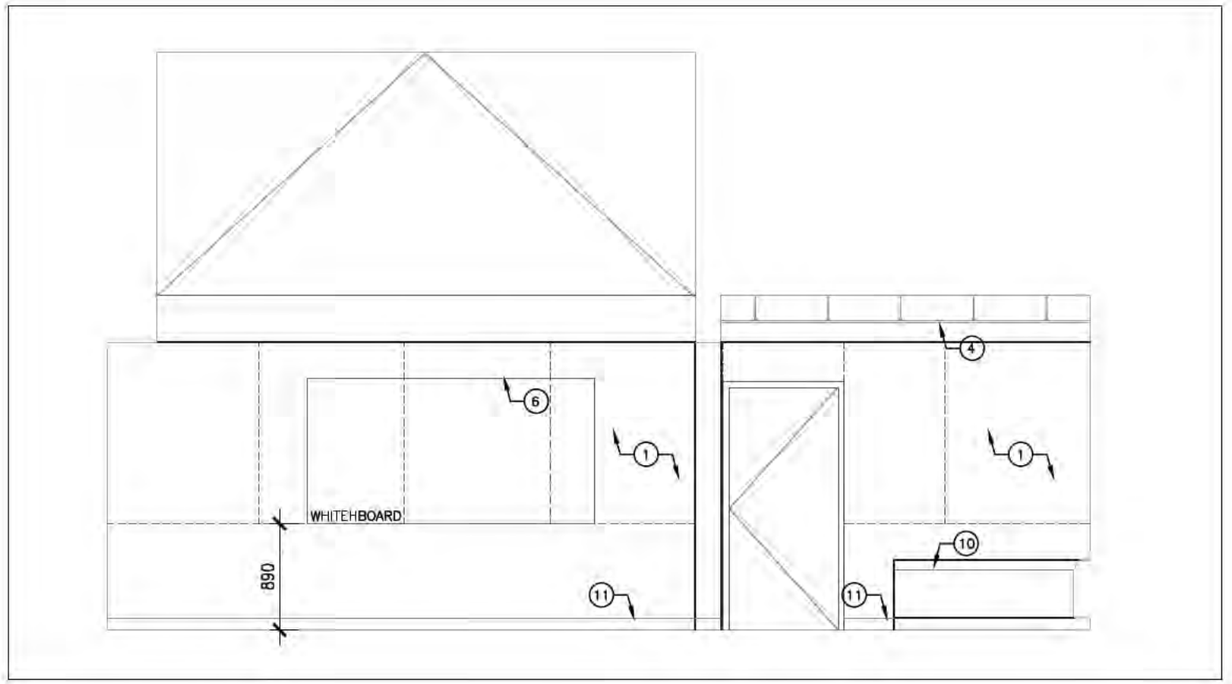

2 / A5 **SOUTH ELEVATION**

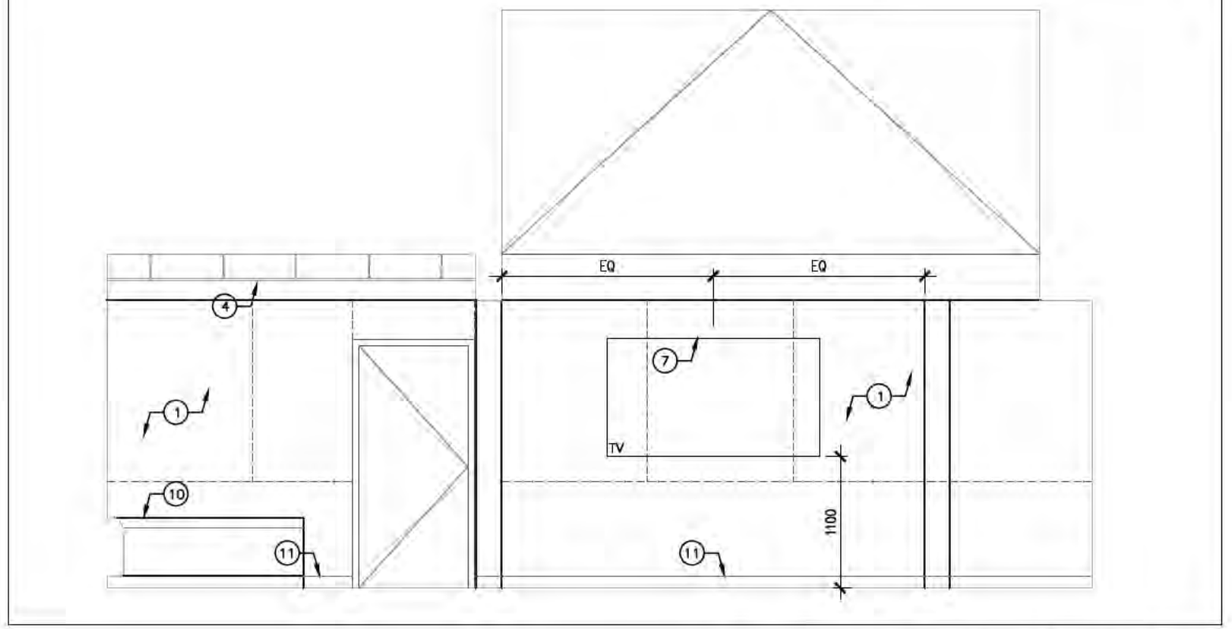

1 / A5 **NORTH ELEVATION**

GENERAL NOTES:
FRESH PAINT ON RADIATORS, CEILING & WALLS. STANDARD OF ACCEPTANCE BENJAMIN MOORE SIMPLY WHITE OC-117.

1. REMOVE ACOUSTIC WALL TREATMENT. MAKE GOOD, PATCH, & PAINT GWB.
2. REMOVE WHITEBOARD & PLYWOOD PANELLING. MAKE GOOD, PATCH, & PAINT GWB.
3. NEW 8FTx4FT DRY ERASE MAGNETIC PORCELAIN WHITEBOARD WITH ALUMINUM MARKER SHELF.
4. NEW ACOUSTIC CEILING TILE. STANDARD OF ACCEPTANCE- ARMSTRONG, OPTIMA TEGULAR, 24" x 48"
5. REMOVE EXISTING OPERABLE PARTITION & TRACK.
6. NEW 8'x4' MAGNETIC CERAMIC WHITEBOARD WITH ALUMINUM MARKER TRAY.
7. REMOVE & REMOUNT TV AFTER REMOVAL OF EXG. ACOUSTIC WALL COVERING & PATCH & PAINT OF WALL.
8. NEW ELECTRIC ROLLER BLINDS. TWO PANELS PER WINDOW TO OPERATE AS ONE. STANDARD OF ACCEPTANCE HUNTER DOUGLAS RB 500 WITH SIDE CHANNELS, SHEER WEAR 7100 FABRIC IN WHITE, 0% TRANSPARENCY. MOUNTING BASED ON MANUFACTURER'S SUGGESTION TO MAXIMIZE BLACKOUT CONDITIONS. REFER TO ELECTRICAL FOR OPERATION & CONTROLS.
9. NEW 2.44m (8ft) STAGE LIGHTING PIPE WITH POWER SUPPLY (SEE ELECTRICAL)
10. EXG. RADIATORS
11. REPLACE EXG. WITH NEW RUBBER WALL BASE. STANDARD OF ACCEPTANCE, JOHNSONITE RUBBER BASE, BURNT UMBER 63. MATCH HEIGHTS TO EXISTING.
12. INFILL REMOVED OPERABLE PARTITION POCKET. MAKE ALLOWANCE FOR OUTLETS ETC, AS REQUIRED BY ELECTRICAL.

ALL UNITS ARE IN MILLIMETERS UNLESS SPECIFIED

REVISIONS & ISSUE			
00	--/--/--	-	-
NO.	dd/mm/yy	DESCRIPTION	BY
DRAWN	ME	SCALE	AS INDICATED
CHK'D	-		

Yukon
Highways and Public Works
Property Management Division


BLDG # 1259
MAIN ADMINISTRATION BUILDING

2071 SECOND AVENUE
WHITEHORSE, YT


2nd FLOOR PLAN:
MEETING/MEDIA ROOM
ELEVATIONS

Sheet A5 OF 6

REV. 00

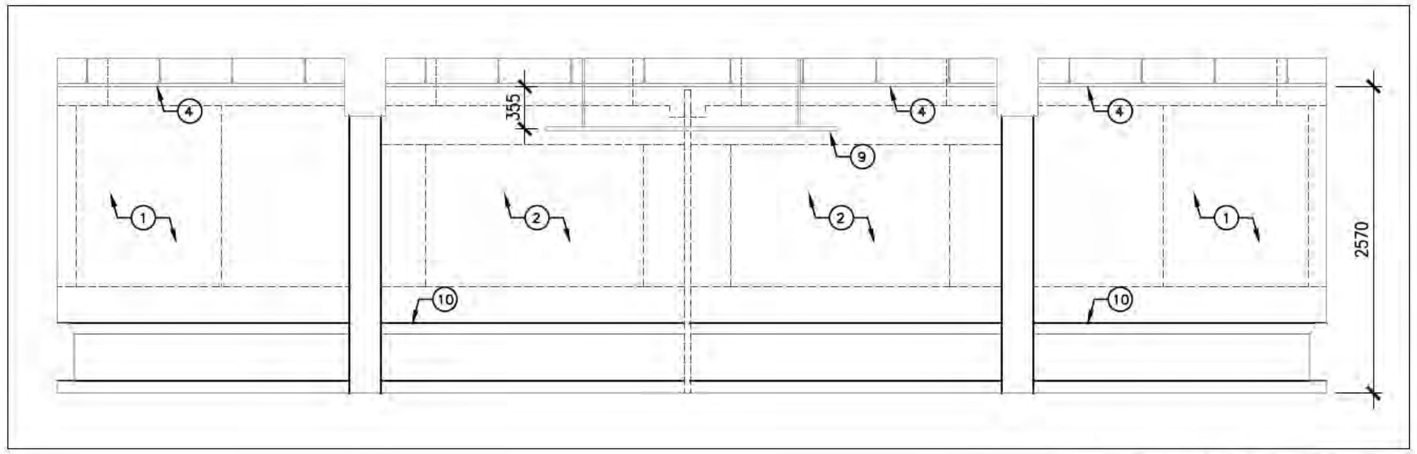

2 / A6 **EAST ELEVATION**

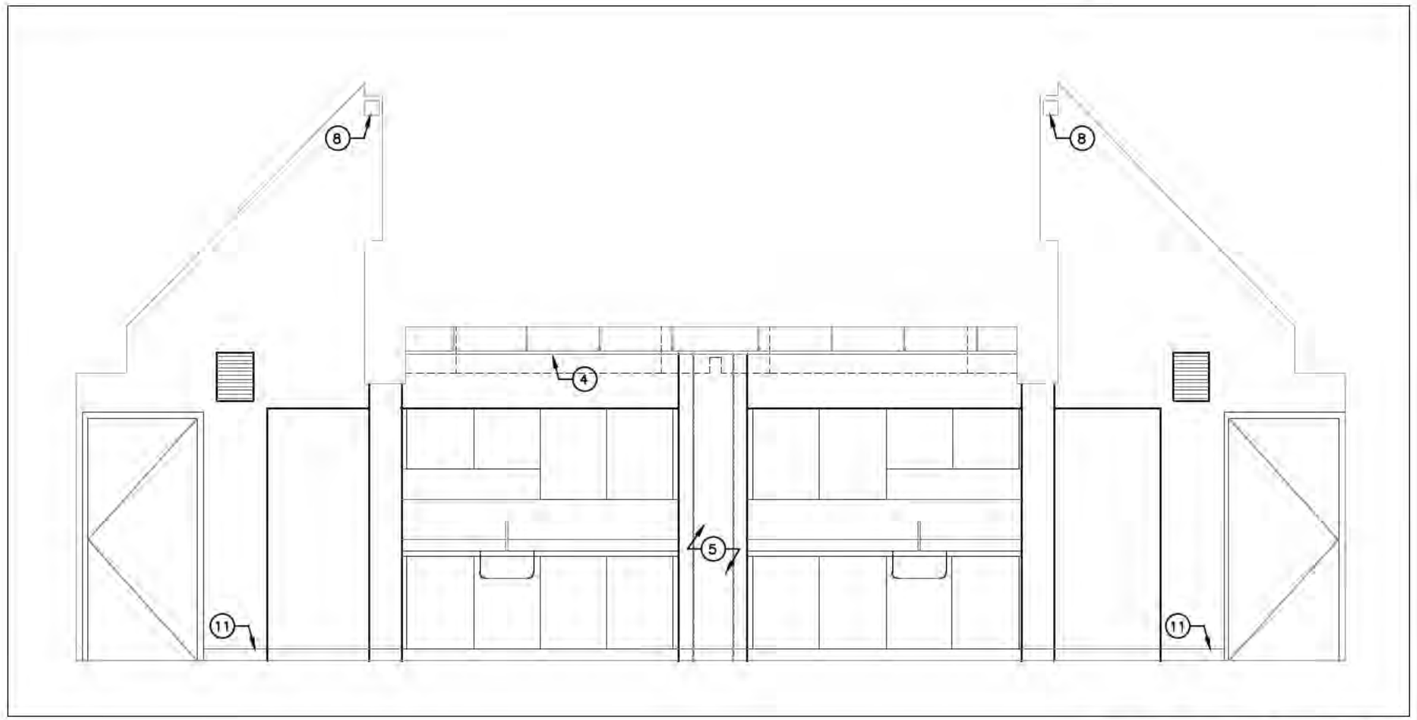

1 / A6 **WEST ELEVATION**

GENERAL NOTES:
FRESH PAINT ON RADIATORS, CEILING & WALLS. STANDARD OF ACCEPTANCE BENJAMIN MOORE SIMPLY WHITE OC-117.

1. REMOVE ACOUSTIC WALL TREATMENT. MAKE GOOD, PATCH, & PAINT GWB.
2. REMOVE WHITEBOARD & PLYWOOD PANELLING. MAKE GOOD, PATCH, & PAINT GWB.
3. NEW 8FTx4FT DRY ERASE MAGNETIC PORCELAIN WHITEBOARD WITH ALUMINUM MARKER SHELF.
4. NEW ACOUSTIC CEILING TILE. STANDARD OF ACCEPTANCE- ARMSTRONG, OPTIMA TEGULAR, 24" x 48"
5. REMOVE EXISTING OPERABLE PARTITION & TRACK.
6. NEW 8'x4' MAGNETIC CERAMIC WHITEBOARD WITH ALUMINUM MARKER TRAY.
7. REMOVE & REMOUNT TV AFTER REMOVAL OF EXG. ACOUSTIC WALL COVERING & PATCH & PAINT OF WALL.
8. NEW ELECTRIC ROLLER BLINDS. TWO PANELS PER WINDOW TO OPERATE AS ONE. STANDARD OF ACCEPTANCE HUNTER DOUGLAS RB 500 WITH SIDE CHANNELS, SHEER WEAR 7100 FABRIC IN WHITE, 0% TRANSPARENCY. MOUNTING BASED ON MANUFACTURER'S SUGGESTION TO MAXIMIZE BLACKOUT CONDITIONS. REFER TO ELECTRICAL FOR OPERATION & CONTROLS.
9. NEW 2.44m (8ft) STAGE LIGHTING PIPE WITH POWER SUPPLY (SEE ELECTRICAL)
10. EXG. RADIATORS
11. REPLACE EXG. WITH NEW RUBBER WALL BASE. STANDARD OF ACCEPTANCE, JOHNSONITE RUBBER BASE, BURNT UMBER 63. MATCH HEIGHTS TO EXISTING.
12. INFILL REMOVED OPERABLE PARTITION POCKET. MAKE ALLOWANCE FOR OUTLETS ETC. AS REQUIRED BY ELECTRICAL.

ALL UNITS ARE IN MILLIMETERS UNLESS SPECIFIED

REVISIONS & ISSUES			
00	--/--/--	-	-
NO.	dd/mm/yy	DESCRIPTION	BY
DRAWN	ST	SCALE	AS INDICATED
CHK'D	-		

Yukon
Highways and Public Works
Property Management Division

BLDG # 1259
MAIN ADMINISTRATION BUILDING

2071 SECOND AVENUE
WHITEHORSE, YT

2nd FLOOR PLAN:
MEETING/MEDIA ROOM
ELEVATIONS


Sheet A6 OF 6

REV: 00

DATE: _____

AUTHORIZED BY: _____

SIGNATURE: _____

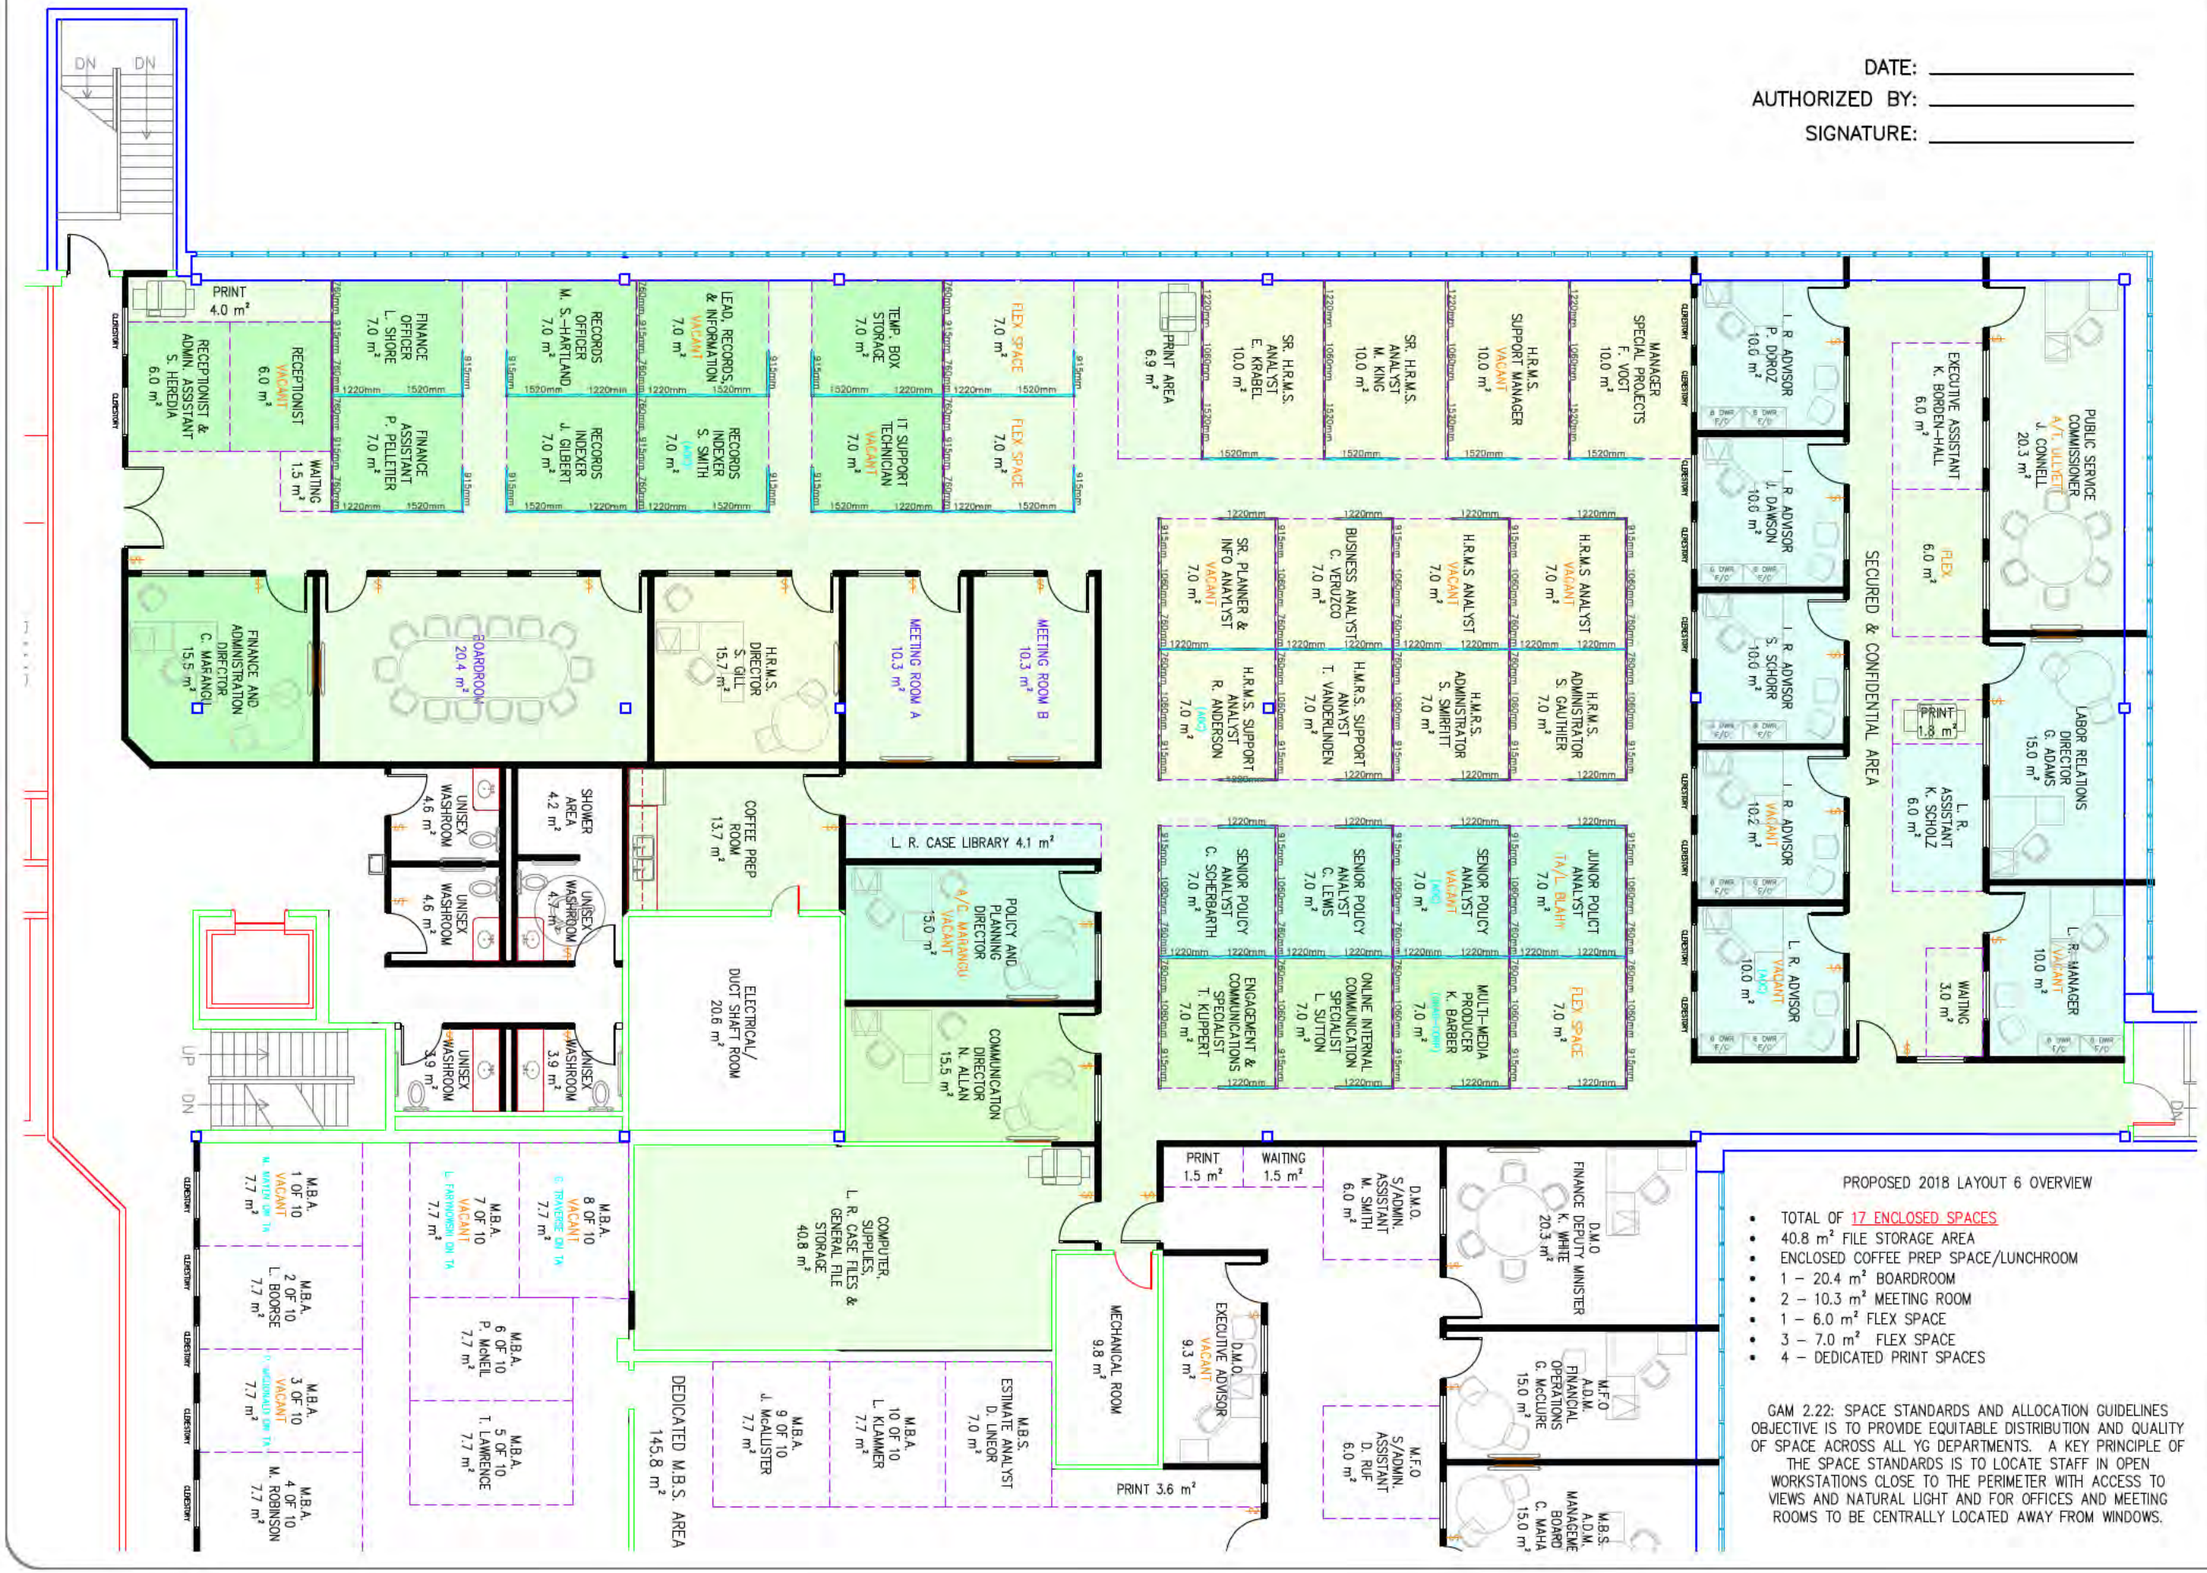

PROPOSED 2018 LAYOUT 6 OVERVIEW

- TOTAL OF 17 ENCLOSED SPACES
- 40.8 m² FILE STORAGE AREA
- ENCLOSED COFFEE PREP SPACE/LUNCHROOM
- 1 – 20.4 m² BOARDROOM
- 2 – 10.3 m² MEETING ROOM
- 1 – 6.0 m² FLEX SPACE
- 3 – 7.0 m² FLEX SPACE
- 4 – DEDICATED PRINT SPACES

GAM 2.22: SPACE STANDARDS AND ALLOCATION GUIDELINES OBJECTIVE IS TO PROVIDE EQUITABLE DISTRIBUTION AND QUALITY OF SPACE ACROSS ALL YG DEPARTMENTS. A KEY PRINCIPLE OF THE SPACE STANDARDS IS TO LOCATE STAFF IN OPEN WORKSTATIONS CLOSE TO THE PERIMETER WITH ACCESS TO VIEWS AND NATURAL LIGHT AND FOR OFFICES AND MEETING ROOMS TO BE CENTRALLY LOCATED AWAY FROM WINDOWS.

NOTES/REFERENCE DRAWINGS

0074

LEGEND

- EXISTING INTERIOR WALL
- EXISTING EXTERIOR WALL
- GLAZING
- WORKSTATION
- BULKHEAD
- ACOUSTIC INSULATION
- EXISTING DOOR
- CONNECTION (INCLUDES ELECTRICAL AND/OR VOICE–DATA)
- DEDICATED LIGHT SWITCH

- FINANCE AND ADMINISTRATION
- POLICY AND PLANNING
- COMMUNICATION
- LABOR RELATIONS
- H.R.M.S.

ALL UNITS ARE IN MILLIMETERS UNLESS SPECIFIED

REVISIONS & ISSUES

NO	yy/mm/dd	DESCRIPTION	BY
–	–	–	–
–	–	–	–
00	18/08/07	FOR REVIEW	ME

DRAWN: ME
CHK'D: –
SCALE: NTS

Yukon
Highways and Public Works
Property Management Division

BLDG # 1259
MAIN ADMINISTRATION BUILDING


2071 SECOND AVENUE
WHITEHORSE, YT

PSC

3rd FLOOR PLAN:
PROPOSED 2018 LAYOUT 8

Sheet 1 OF 1

REV. 00

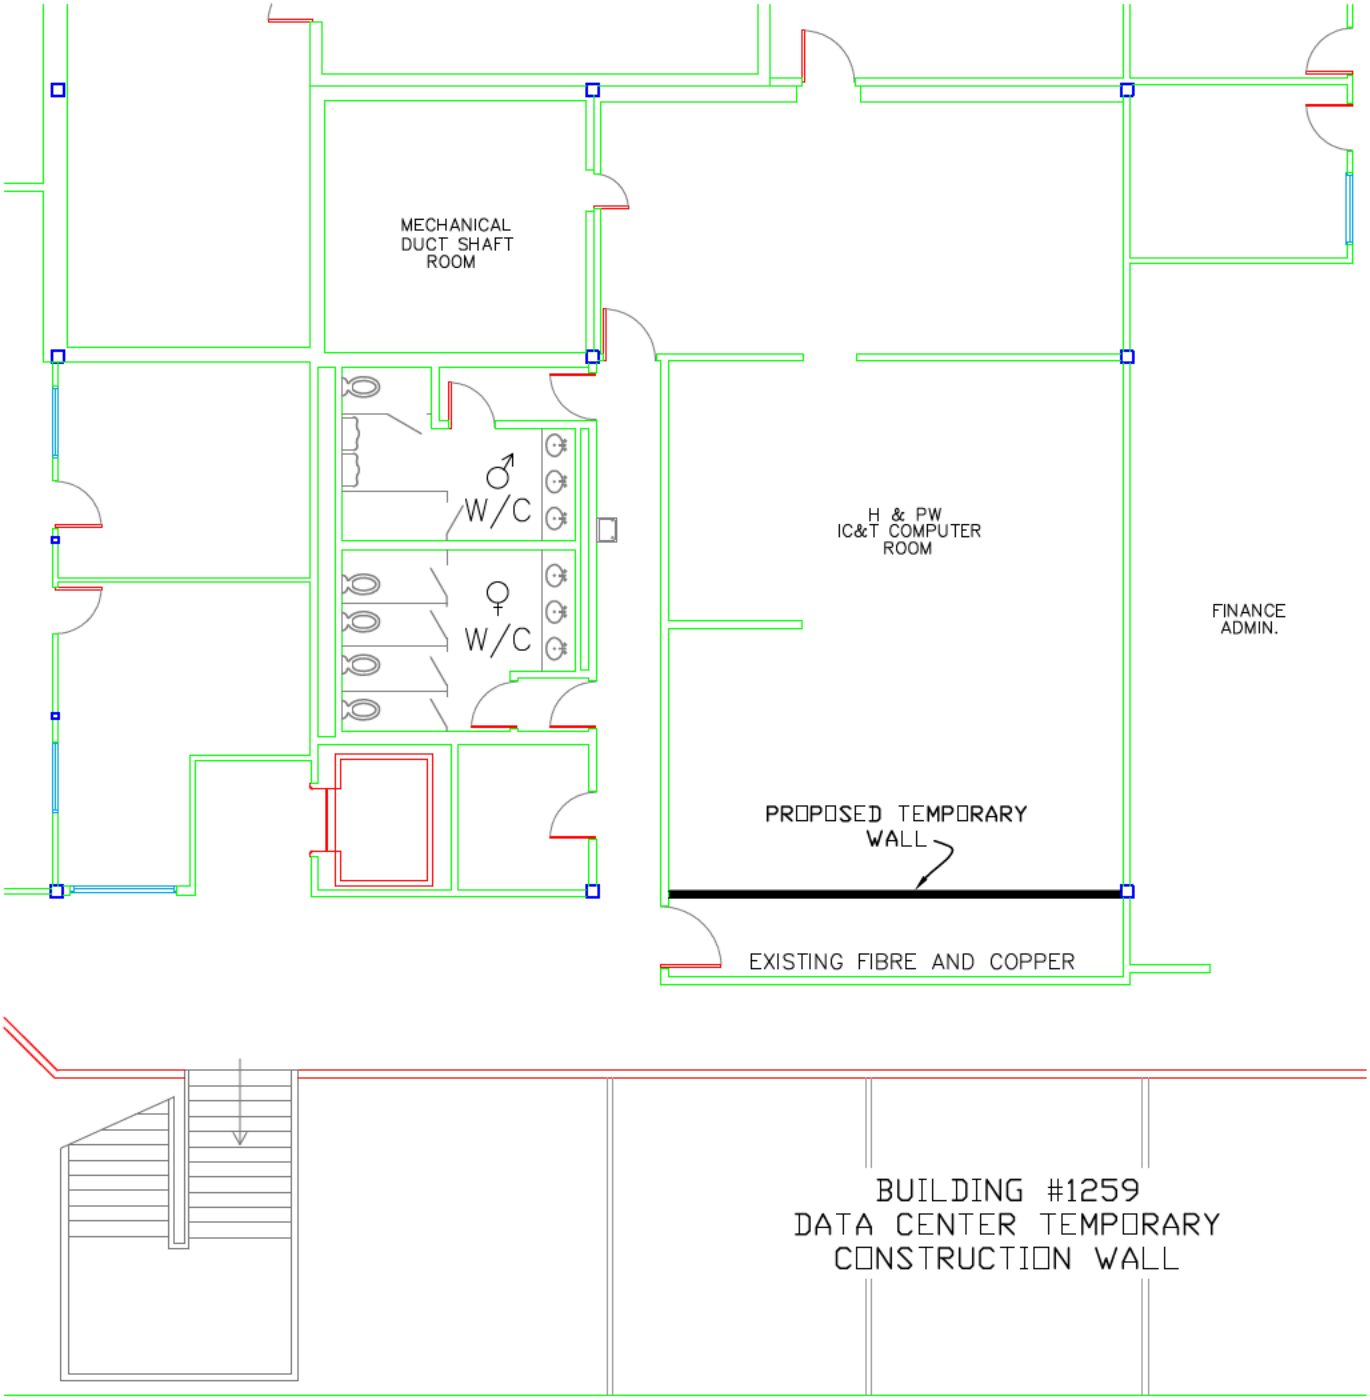
MECHANICAL
DUCT SHAFT
ROOM
♂
W/C
♀
W/C
H & PW
IC&T COMPUTER
ROOM
FINANCE
ADMIN.
PROPOSED TEMPORARY
WALL
EXISTING FIBRE AND COPPER
BUILDING #1259
DATA CENTER TEMPORARY
CONSTRUCTION WALL

OFFICE 15.6 m²
FINANCE
OFFICE 15.7 m²
FILE STORAGE 14.6 m²
OFFICE 14.7 m²
WORKSTATION 6.0 m²
WORKSTATION 6.0 m²
FILE STORAGE 18.9 m²
OFFICE 13.5 m²
WORKSTATION 6.2 m²
WORKSTATION 6.2 m²
ELECTRICAL ROOM 9.8 m²
BOARD ROOM 13.9 m²
FILE STORAGE 18.9 m²
BOARDROOM 24.4 m²
FILE STORAGE 13.9 m²
DN
WORK STATION 6.3 m²
PRINT STATION / SUPPLY / FILING CABINETS 20.7 m²
OFFICE – DIRECTOR HRMS 13.2 m²
WORK STATION – ADM ASSISTANT 10.3 m²
OFFICE – ADM 21.3 m²
ELECTRICAL DUCT & SHAFT ROOM 20.6m²
MEN'S WASHROOM 7.7 m²
WOMEN'S WASHROOM 9.0 m²
DN
UP
OFFICE – MANAGER LABOUR RELATIONS 11.1 m²
WORK STATION – LABOUR RELATIONS ASSISTANT 6.3 m²
OFFICE – LABOUR RELATIONS ADVISOR 13.3 m²
OFFICE – SRHRMS ANALYST 13.2 m²
OFFICE – LABOUR RELATIONS ADVISOR 11.1 m²
WORK STATION – RECORDS INDEXER 6.0 m²
WORK STATION – HRMS SUPPORT ANALYST 8.0 m²
WORK STATION – BUSINESS ANALYST 7.1 m²
WORK STATION 6.3 m²
OFFICE – HRMS SUPPORT MANAGER 13.2 m²
WORK STATION – LEAD RECORDS & ATIPP 10.5 m²
KITCHEN
WORK STATION 9.2 m²
PRINT STATION
WORK STATION 10.1 m²
WORK STATION – FINANCE ASSISTANT 6.3 m²
WORK STATION – FINANCE ASSISTANT 6.3 m²
OFFICE – LABOUR RELATIONS ADVISOR 11.1 m²
WORK STATION – EXECUTIVE ASSISTANT 6.3 m²
OFFICE 11.3 m²
STORAGE / FILING
PRINTERS
PUBLIC SERVICE COMMISSIONER'S OFFICE 25.6 m²
OFFICE – DIRECTOR LABOUR RELATIONS 16.8 m²
OFFICE – LABOUR RELATIONS ADVISOR 11.1 m²
OFFICE – 3 HRMS ADMINS 23.6 m²
WORK STATION – HRMS ANALYST 6.8 m²
WORK STATION – SRHRMS ANALYST 9.7 m²
OFFICE – DIRECTOR POLICY 13.9 m²
WORK STATION – SENIOR POLICY ANALYST 10.0 m²
WORK STATION – SENIOR POLICY ANALYST 10.0 m²
OFFICE 13.9 m²
WORK STATION – MANAGER FINANCE & SPACE 11.4 m²
OFFICE – DIRECTOR FINANCE & ADMIN. 13.9 m²
RAMP

NOTES/REFERENCE DRAWINGS

LEGEND

- EXISTING INTERIOR WALL
- EXISTING EXTERIOR WALL
- GLAZING
- WORKSTATION
- BULKHEAD
- ACOUSTIC INSULATION
- EXISTING DOOR
- EXISTING CONNECTION (INCLUDES ELECTRICAL AND/OR VOICE-DATA) V/D
- DEDICATED LIGHT SWITCH $
- PAC POLE

ALL UNITS ARE IN MILLIMETERS UNLESS SPECIFIED

REVISIONS & ISSUES

NO	dd/mm/yy	DESCRIPTION	BY
–	18/11/20	PSC UPDATE MASTER	JC
01	13/05/16	UPDATE MASTER	ME
00	--/08/09	REVISED	–

DRAWN: ME
CHK'D: –
SCALE: NTS

Yukon

BLDG # 1259
MAIN ADMINISTRATION BUILDING

2071 SECOND AVENUE
WHITEHORSE, YT

3rd FLOOR PLAN EAST SIDE:
PSC CURRENT

Sheet 1 OF 3

REV 00

OFFICE 15.6 m²
FINANCE
OFFICE 15.7 m²
FILE STORAGE 14.6 m²
OFFICE 14.7 m²
WORKSTATION 6.0 m²
WORKSTATION 6.0 m²
FILE STORAGE 18.9 m²
OFFICE 13.5 m²
WORKSTATION 6.2 m²
WORKSTATION 6.2 m²
ELECTRICAL ROOM 9.8 m²
WORK STATION – HRMS SR ANALYST 8.4 m²
WORK STATION – HRMS SR ANALYST 8.4 m²
WORK STATION HRMS BUSINESS ANALYST 7.4 m²
WORK STATION HRMS ANALYST 7.4 m²
WORK STATION HRMS ANALYST 7.4 m²
BOARD ROOM 13.9 m²
FILE STORAGE 18.9 m²
BOARDROOM 24.4 m²
FILE STORAGE 13.9 m²
DN
SUPPLY / FILING CABINETS 10.0 m²
WORK STATION 4.7 m²
WORK STATION 4.7 m²
WORK STATION – HRMS PROJECT MANAGER 8.4 m²
OFFICE – DIRECTOR HRMS 13.2 m²
WORK STATION – HRMS ADMIN 6.3 m²
WORK STATION – HRMS ADMIN 6.3 m²
KITCHEN 21.3 m²
ELECTRICAL DUCT & SHAFT ROOM 20.6m²
MEN'S WASHROOM 7.7 m²
WOMEN'S WASHROOM 9.0 m²
DN
UP
OFFICE – MANAGER LABOUR RELATIONS 11.1 m²
PRINT STATION
WORK STATION – LABOUR RELATIONS ASSISTANT 6.3 m²
OFFICE – LABOUR RELATIONS ADVISOR 13.3 m²
OFFICE – HRMS SUPPORT MANAGER 13.2 m²
WORK STATION – HRMS ADMIN 6.3 m²
OFFICE – LABOUR RELATIONS ADVISOR 11.1 m²
WORK STATION – 6.3 m²
OFFICE 11.3 m²
OFFICE – SMS 13.2 m²
WORK STATION – SMS 6.3 m²
OFFICE – LABOUR RELATIONS ADVISOR 11.1 m²
WORK STATION – EXECUTIVE ASSISTANT 6.3 m²
WORK STATION – SMS 6.3 m²
WORK STATION – SMS 8.4 m²
WORK STATION – SMS 8.4 m²
WORK STATION – LEAD RECORDS & ATIPP 8.4 m²
STORAGE / FILING
WORK STATION – RECORDS INDEXER 8.4 m²
PRINT STATION
PRINT STATION
WORK STATION – SMS 8.4 m²
WORK STATION – SMS 8.4 m²
WORK STATION – ADMO 8.4 m²
WORK STATION 8.4 m²
WORK STATION 8.4 m²
WORK STATION 8.4 m²
WORK STATION – FINANCE ASSISTANT 6.3 m²
WORK STATION – FINANCE ASSISTANT 6.3 m²
PUBLIC SERVICE COMMISSIONER'S OFFICE 25.6 m²
OFFICE – DIRECTOR LABOUR RELATIONS 16.8 m²
OFFICE – LABOUR RELATIONS ADVISOR 11.1 m²
BOARDROOM 23.6 m²
WORK STATION – SMS 6.8 m²
WORK STATION – SMS 9.7 m²
OFFICE – ADMO 13.9 m²
WORK STATION – SENIOR POLICY ANALYST 10.0 m²
WORK STATION – SENIOR POLICY ANALYST 10.0 m²
OFFICE – DIRECTOR POLICY 13.9 m²
WORK STATION – MANAGER FINANCE & SPACE 11.4 m²
OFFICE – DIRECTOR FINANCE & ADMIN. 13.9 m²

NOTES/REFERENCE DRAWINGS

LEGEND

- EXISTING INTERIOR WALL
- EXISTING EXTERIOR WALL
- GLAZING
- WORKSTATION
- BULKHEAD
- ACOUSTIC INSULATION
- EXISTING DOOR
- EXISTING CONNECTION (INCLUDES ELECTRICAL AND/OR VOICE-DATA) V/D
- DEDICATED LIGHT SWITCH $
- PAC POLE

ALL UNITS ARE IN MILLIMETERS UNLESS SPECIFIED

REVISIONS & ISSUES

NO	dd/mm/yy	DESCRIPTION	BY
–	18/11/20	PSC UPDATE MASTER	JC
01	13/05/16	UPDATE MASTER	ME
00	--/08/09	REVISED	–

DRAWN: ME
CHK'D: –
SCALE: NTS

Yukon

BLDG # 1259
MAIN ADMINISTRATION BUILDING

2071 SECOND AVENUE
WHITEHORSE, YT

3rd FLOOR PLAN EAST SIDE:
PSC PROPOSED
OPTION 1

Sheet: 2 OF 3

REV: 00

OFFICE 15.6 m²
FINANCE
OFFICE 15.7 m²
FILE STORAGE 14.6 m²
OFFICE 14.7 m²
WORKSTATION 6.0 m²
WORKSTATION 6.0 m²
WORKSTATION 6.2 m²
WORKSTATION 6.2 m²
OFFICE 13.5 m²
FILE STORAGE 18.9 m²
ELECTRICAL ROOM 9.8 m²
WORK STATION – HRMS SR ANALYST 8.4 m²
WORK STATION – HRMS SR ANALYST 8.4 m²
WORK STATION – HRMS BUSINESS ANALYST 7.4 m²
WORK STATION – HRMS ANALYST 7.4 m²
WORK STATION – HRMS ANALYST 7.4 m²
BOARD ROOM 13.9 m²
FILE STORAGE 18.9 m²
BOARDROOM 24.4 m²
FILE STORAGE 13.9 m²
DN
SUPPLY / FILING CABINETS 10.0 m²
WORK STATION 4.7 m²
WORK STATION 4.7 m²
WORK STATION – HRMS PROJECT MANAGER 8.4 m²
OFFICE – DIRECTOR HRMS 13.2 m²
KITCHEN
BOARDROOM 21.3 m²
ELECTRICAL DUCT & SHAFT ROOM 20.6m²
MEN'S WASHROOM 7.7 m²
WOMEN'S WASHROOM 9.0 m²
UP
DN
OFFICE – MANAGER LABOUR RELATIONS 11.1 m²
PRINT STATION
WORK STATION – LABOUR RELATIONS ASSISTANT 6.3 m²
WORK STATION – 6.3 m²
WORK STATION – EXECUTIVE ASSISTANT 6.3 m²
OFFICE – LABOUR RELATIONS ADVISOR 13.3 m²
OFFICE 11.3 m²
OFFICE – HRMS SUPPORT MANAGER 13.2 m²
OFFICE – SMS 13.2 m²
WORK STATION – SMS 7.8 m²
WORK STATION – HRMS 6.0 m²
WORK STATION – HRMS 6.0 m²
WORK STATION – SMS 8.0 m²
WORK STATION – SMS 8.0 m²
WORK STATION – SMS 7.1 m²
WORK STATION – SMS ADMIN
WORK STATION – RECORDS INDEXER 6.3 m²
STORAGE / FILING
WORK STATION – LEAD RECORDS & ATIPP 10.5 m²
WORK STATION 8.5 m²
WORK STATION 9.2 m²
WORK STATION 9.2 m²
WORK STATION 10.2 m²
PRINT STATION
WORK STATION 10.1 m²
WORK STATION – FINANCE ASSISTANT 6.3 m²
WORK STATION – FINANCE ASSISTANT 6.3 m²
OFFICE – LABOUR RELATIONS ADVISOR 11.1 m²
OFFICE – LABOUR RELATIONS ADVISOR 11.1 m²
PUBLIC SERVICE COMMISSIONER'S OFFICE 25.6 m²
OFFICE – DIRECTOR LABOUR RELATIONS 16.8 m²
OFFICE – LABOUR RELATIONS ADVISOR 11.1 m²
WORK STATION – SMS 7.8 m²
WORK STATION – SMS 7.8 m²
PRINTERS
WORK STATION – SMS 6.8 m²
WORK STATION – ADMO 9.7 m²
OFFICE – ADMO 13.9 m²
WORK STATION – SENIOR POLICY ANALYST 10.0 m²
WORK STATION – SENIOR POLICY ANALYST 10.0 m²
OFFICE – DIRECTOR POLICY 13.9 m²
WORK STATION – MANAGER FINANCE & SPACE 11.4 m²
OFFICE – DIRECTOR FINANCE & ADMIN. 13.9 m²
NO
NO

NOTES/REFERENCE DRAWINGS

LEGEND

- EXISTING INTERIOR WALL
- EXISTING EXTERIOR WALL
- GLAZING
- WORKSTATION
- BULKHEAD
- ACOUSTIC INSULATION
- EXISTING DOOR
- EXISTING CONNECTION (INCLUDES ELECTRICAL AND/OR VOICE-DATA) V/D
- DEDICATED LIGHT SWITCH $
- PAC POLE

ALL UNITS ARE IN MILLIMETERS UNLESS SPECIFIED

REVISIONS & ISSUES

NO	dd/mm/yy	DESCRIPTION	BY
–	18/11/20	PSC UPDATE MASTER	JC
01	13/05/16	UPDATE MASTER	ME
00	--/08/09	REVISED	–

DRAWN ME
CHK'D –
SCALE NTS

Yukon

BLDG # 1259
MAIN ADMINISTRATION BUILDING

2071 SECOND AVENUE
WHITEHORSE, YT

3rd FLOOR PLAN EAST SIDE:
PSC PROPOSED
OPTION 2

Sheet 3 OF 3
REV 00



NOTES/REFERENCE DRAWINGS

LEGEND

- EXISTING INTERIOR WALL
- EXISTING EXTERIOR WALL
- GLAZING
- WORKSTATION
- BULKHEAD
- ACOUSTIC INSULATION
- EXISTING DOOR
- EXISTING CONNECTION (INCLUDES ELECTRICAL AND/OR VOICE-DATA)
- DEDICATED LIGHT SWITCH

WASHROOMS

VERTICAL PENETRATION

ENTRYWAY

MECHANICAL

FINANCE

PUBLIC SERVICE COMMISSION

HIGHWAYS & PUBLIC WORKS

ALL UNITS ARE IN MILLIMETERS UNLESS SPECIFIED

REVISIONS & ISSUES

NO	dd/mm/yy	DESCRIPTION	BY
–	–	–	–
01	13/05/16	UPDATE MASTER	ME
00	--/08/09	REVISED	–

DRAWN ME | SCALE NTS

CHK'D –

Yukon
Highways and Public Works
Property Management Division

BLDG # 1259
MAIN ADMINISTRATION BUILDING


2071 SECOND AVENUE
WHITEHORSE, YT

3rd FLOOR PLAN EAST SIDE:

MASTER

Sheet 1 OF 1

REV 00

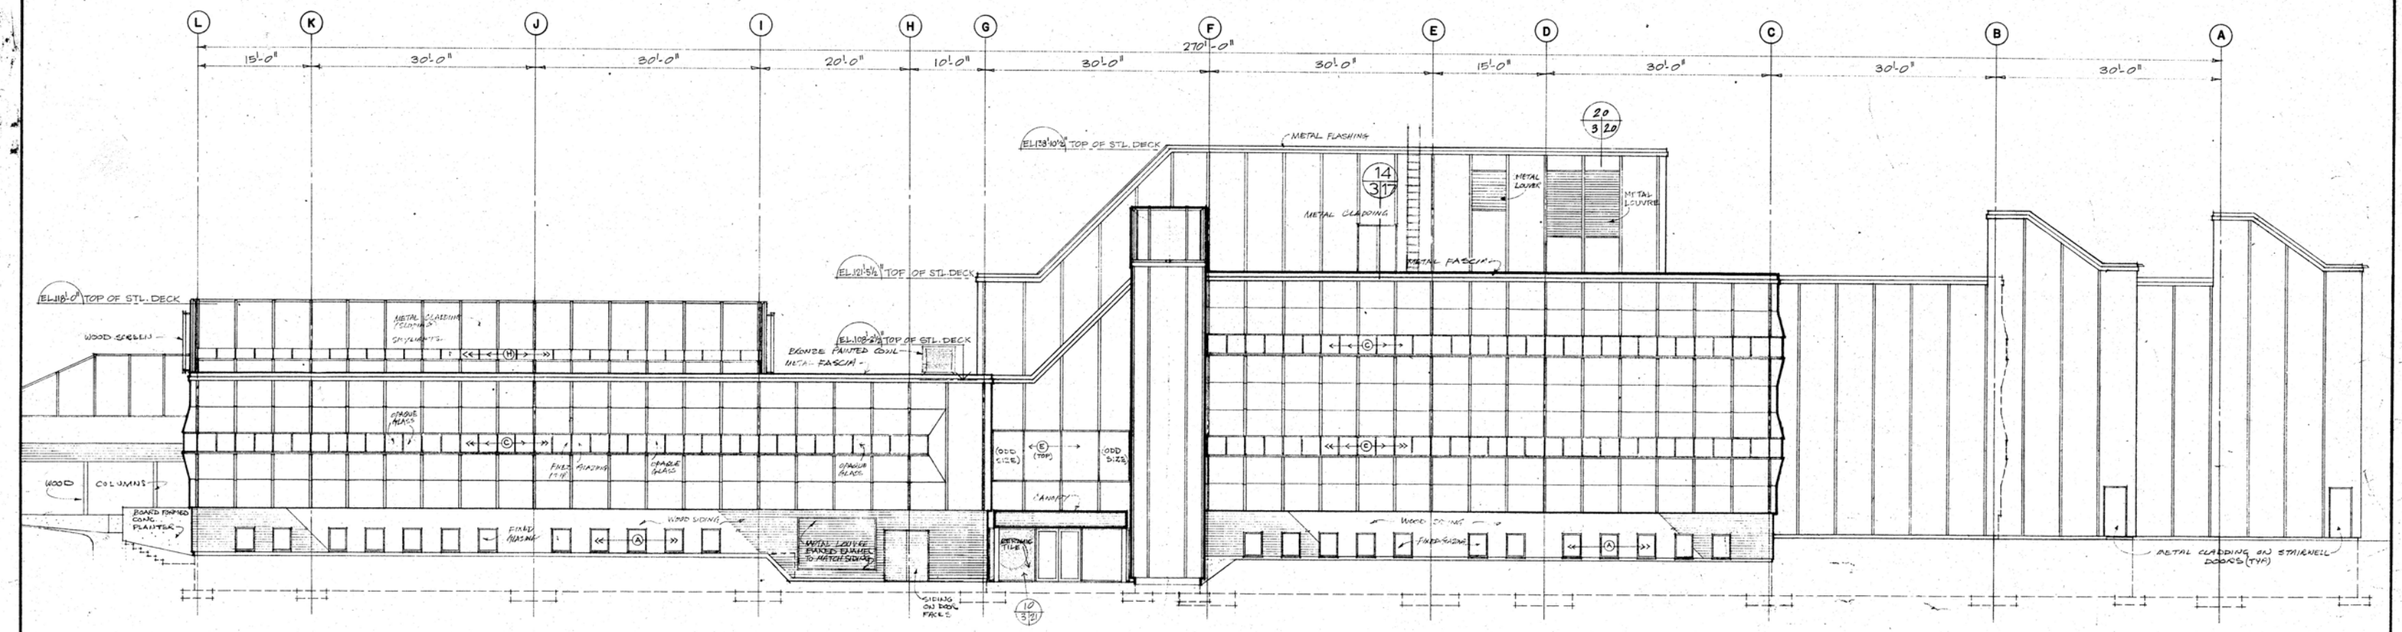

CHANGE ORDER 19

ADDITIONAL CONCRETE WORK RETAINING WALL, NORTH RAMP LOADING AREA

CHANGE ORDER 30
SUPPLY AND INSTALL ADDITIONAL STEEL HAND RAILS AT ENTRANCES - MODIFY DESIGN, TO SUIT LOCATIONS

SUPPLY AND INSTALL 3" HAND PICKED STONE TO CANOPIES

CHANGE ORDER 4
SUPPLY AND PLACE 6"x6" CONCRETE SLABS AT THE TOP OF ALL 40° ROOFS TO PREVENT THE MOVEMENT OF GRAVEL AND TO PROTECT INSULATION

CHANGE ORDER 8
ALUMINIUM DOOR. DELETE CLOSERS AND THRESHOLDS SPACE FOR CONCEALED CLOSERS

SEE MATERIAL / FINISH SCHEDULE ON DWG A2
SEE WINDOW - GLAZING SCHEDULE ON DWG A2

Public Works Travaux publics Canada Canada Pacific Region

REVISIONS NO.	DATE	DESCRIPTION
A	SEPT/74	EXTERIOR FINISH GRADE REVISED BETWEEN GRIDS A TO D NORTH ELEVATION.
B	01 OCT 74	CORRECT LOUVRE ELEVATION ON PENTHOUSE.


PROJECT NO. 89857
DATE APRIL 1/74
SCALE 1/8"=1'-0"
DRAWN R.S.
CHECK
APPROVED

GOVERNMENT OF THE YUKON TERRITORY

DRAWING TITLE
SOUTH & NORTH ELEVATIONS

PROJECT TITLE
TERRITORIAL ADMINISTRATION BUILDING WHITEHORSE, Y.T.

DRAWING NO. A 3 B

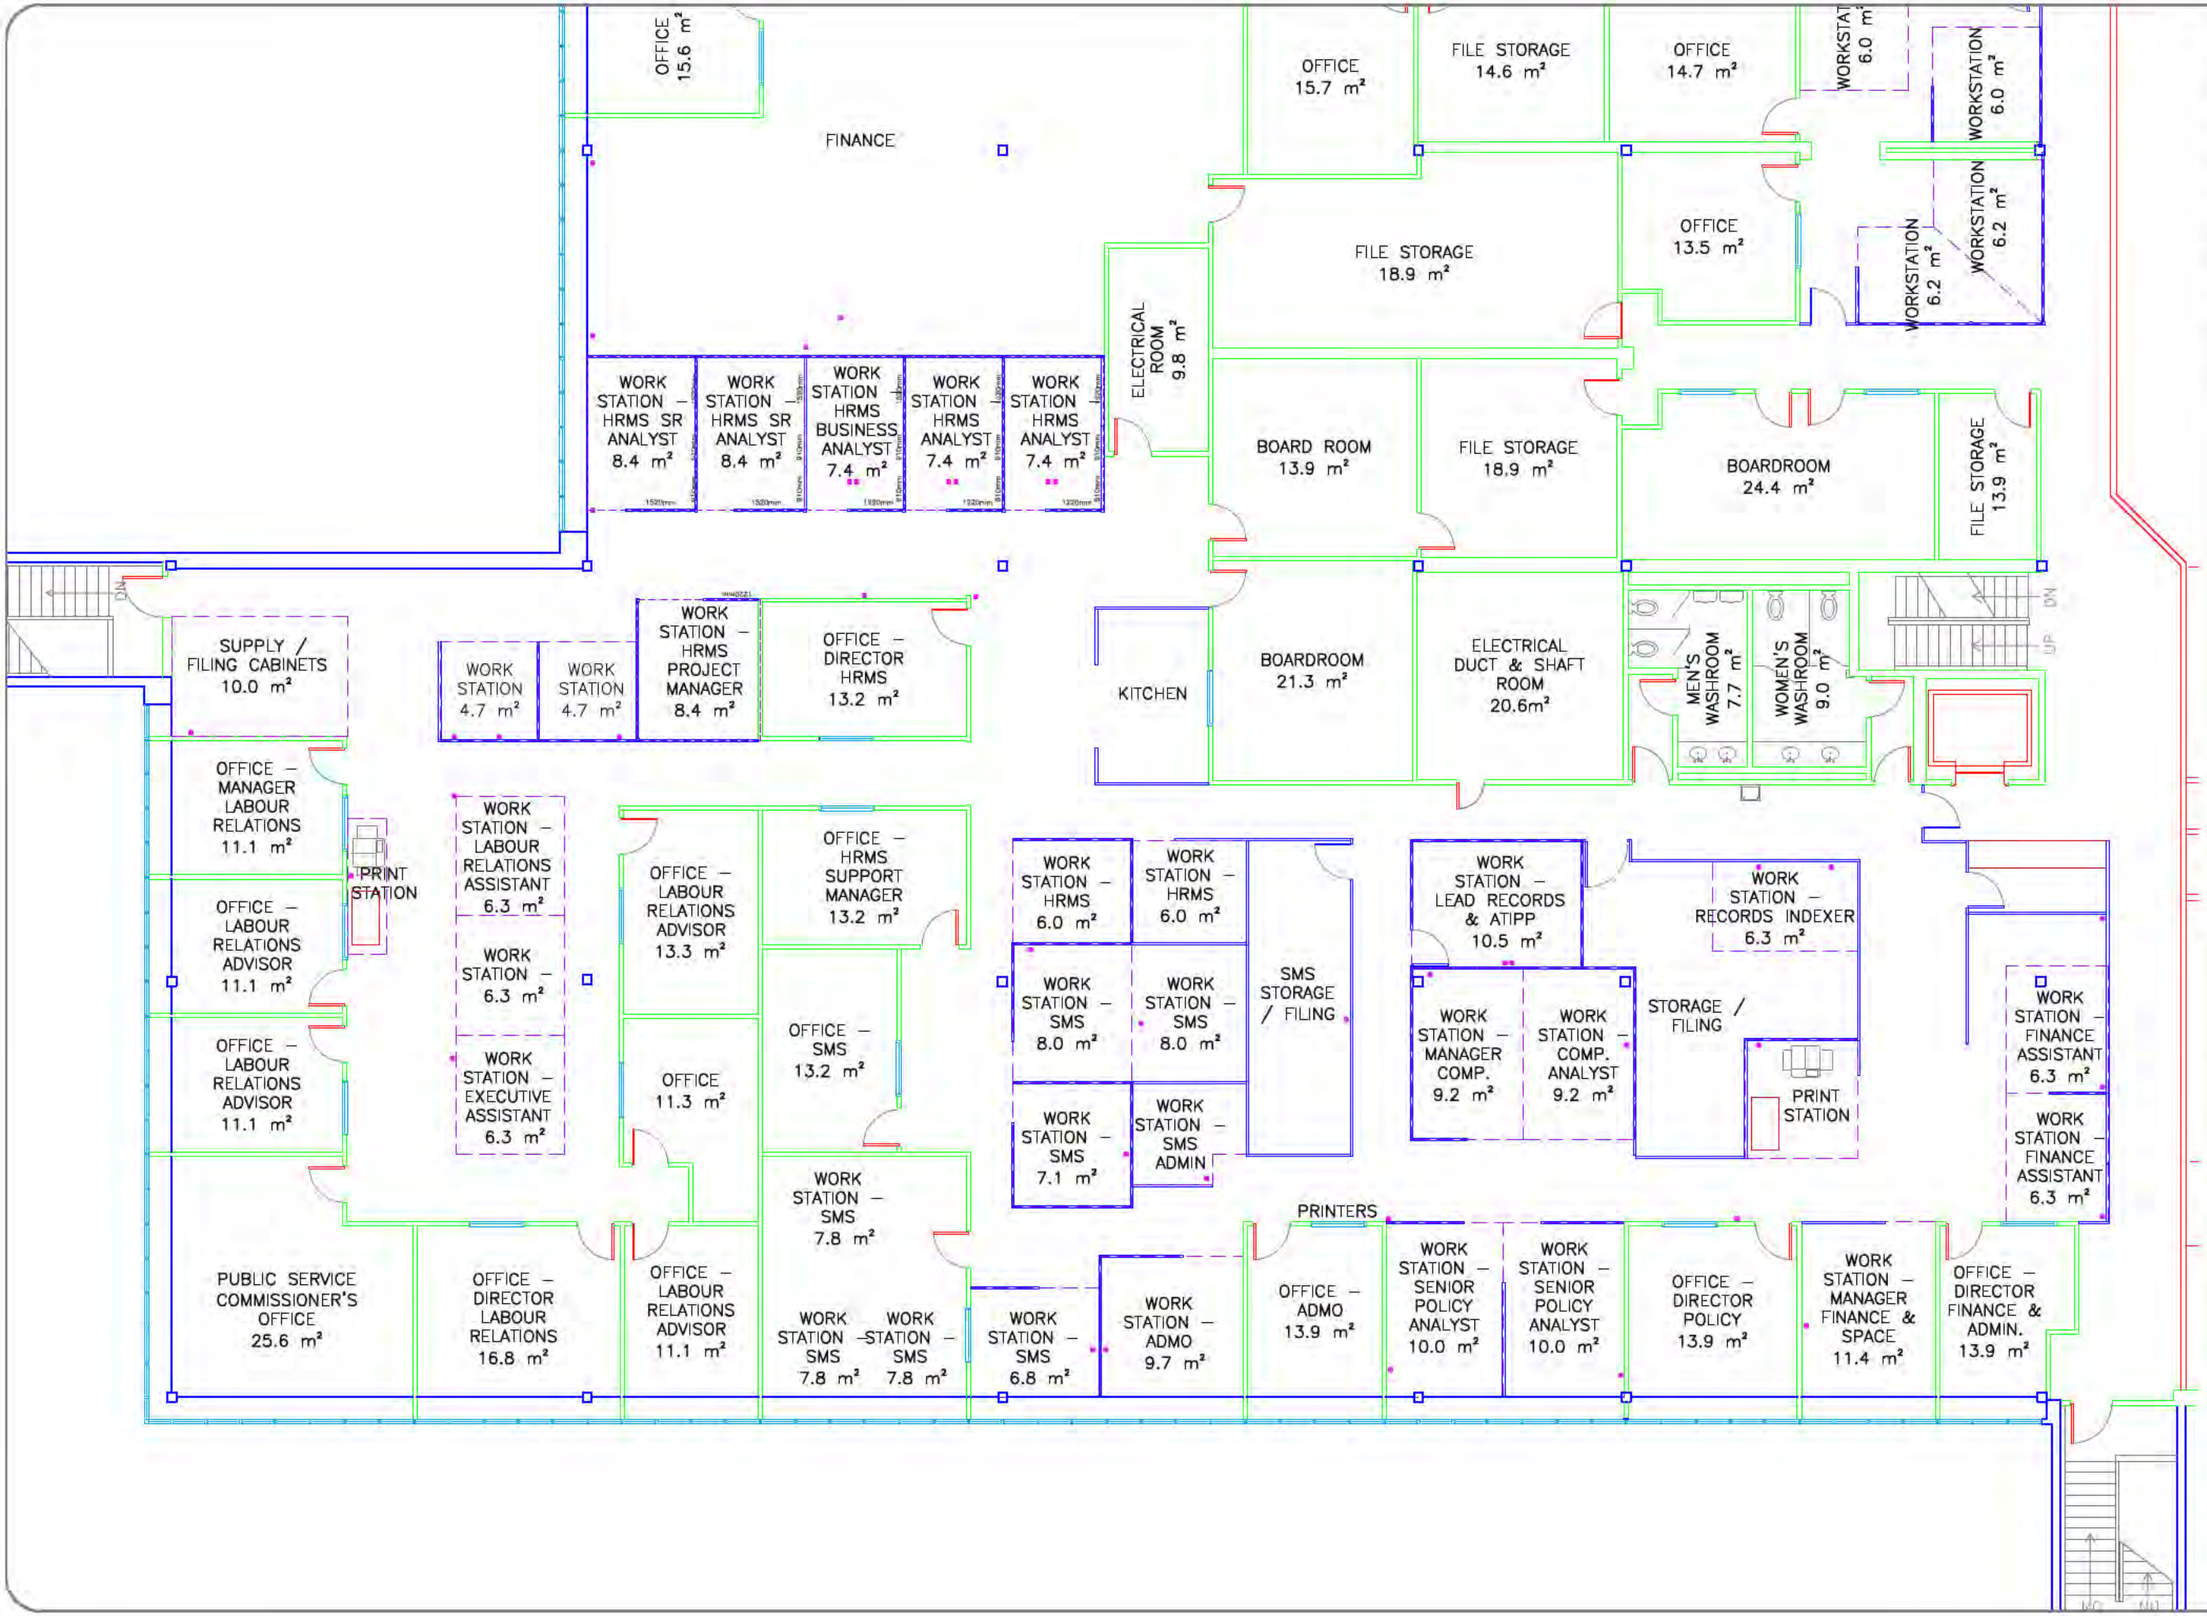

0081

NOTES/REFERENCE DRAWINGS

LEGEND

- EXISTING INTERIOR WALL
- EXISTING EXTERIOR WALL
- GLAZING
- WORKSTATION
- BULKHEAD
- ACOUSTIC INSULATION
- EXISTING DOOR
- EXISTING CONNECTION (INCLUDES ELECTRICAL AND/OR VOICE-DATA) V/D
- DEDICATED LIGHT SWITCH $
- PAC POLE

ALL UNITS ARE IN MILLIMETERS UNLESS SPECIFIED

REVISIONS & ISSUES

NO	dd/mm/yy	DESCRIPTION	BY
–	18/11/20	PSC UPDATE MASTER	JC
01	13/05/16	UPDATE MASTER	ME
00	--/08/09	REVISED	–

DRAWN ME | CHK'D – | SCALE NTS


Yukon

BLDG # 1259
MAIN ADMINISTRATION BUILDING


2071 SECOND AVENUE
WHITEHORSE, YT

3rd FLOOR PLAN EAST SIDE:
PSC PROPOSED
OPTION 2

Sheet 3 OF 3 | REV 00

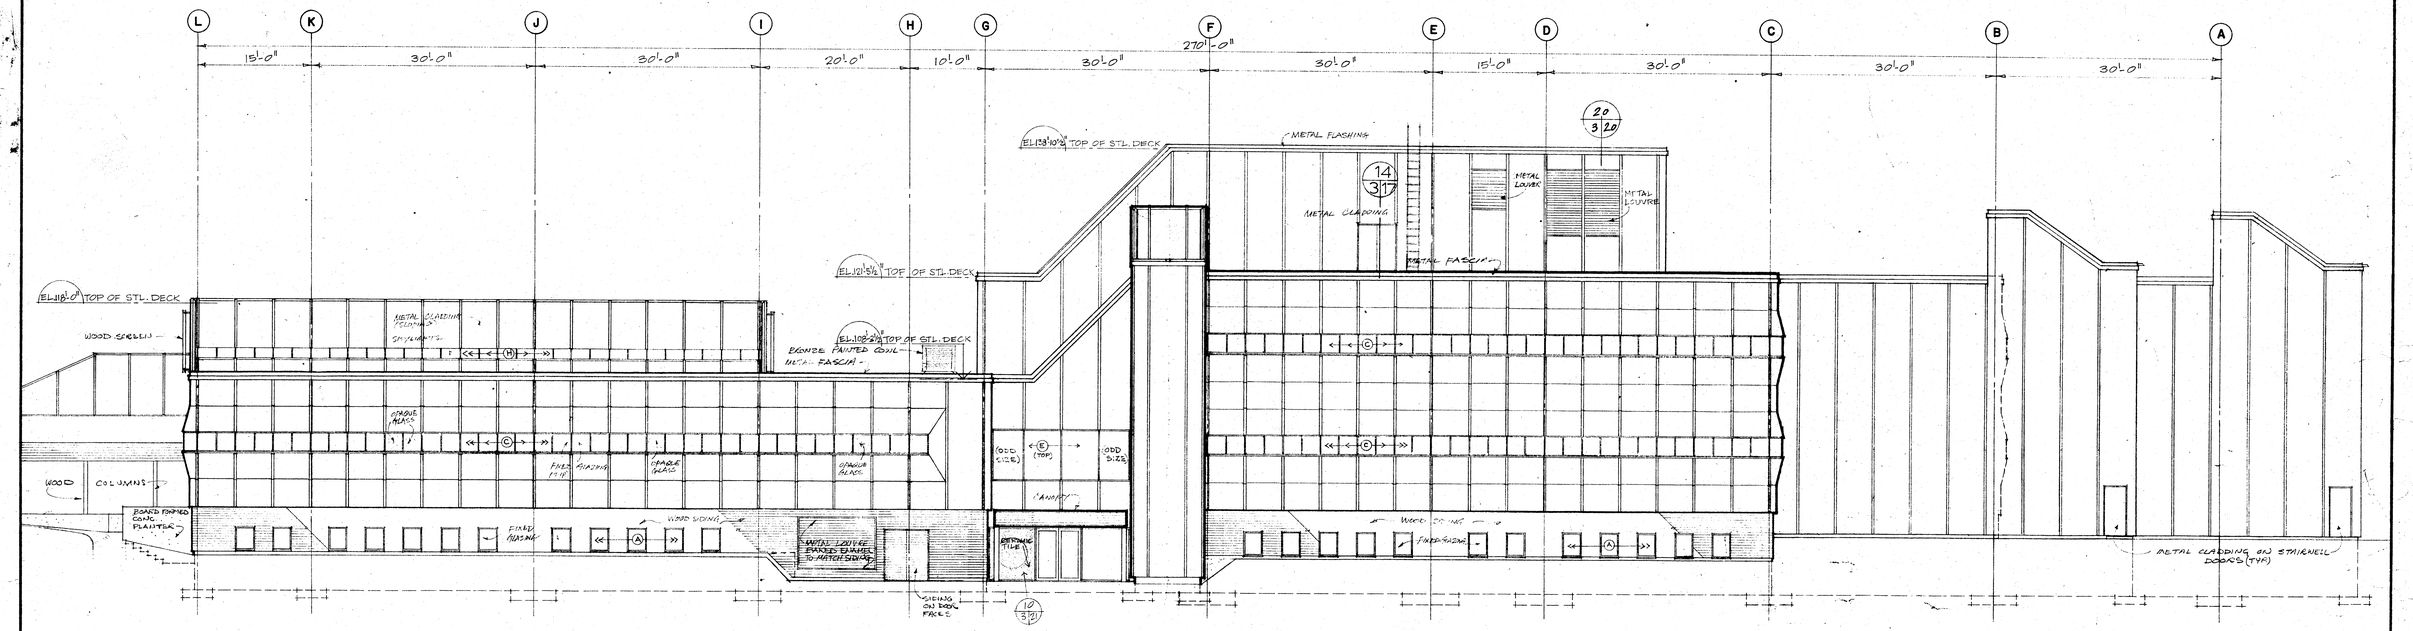

SOUTH ELEVATION

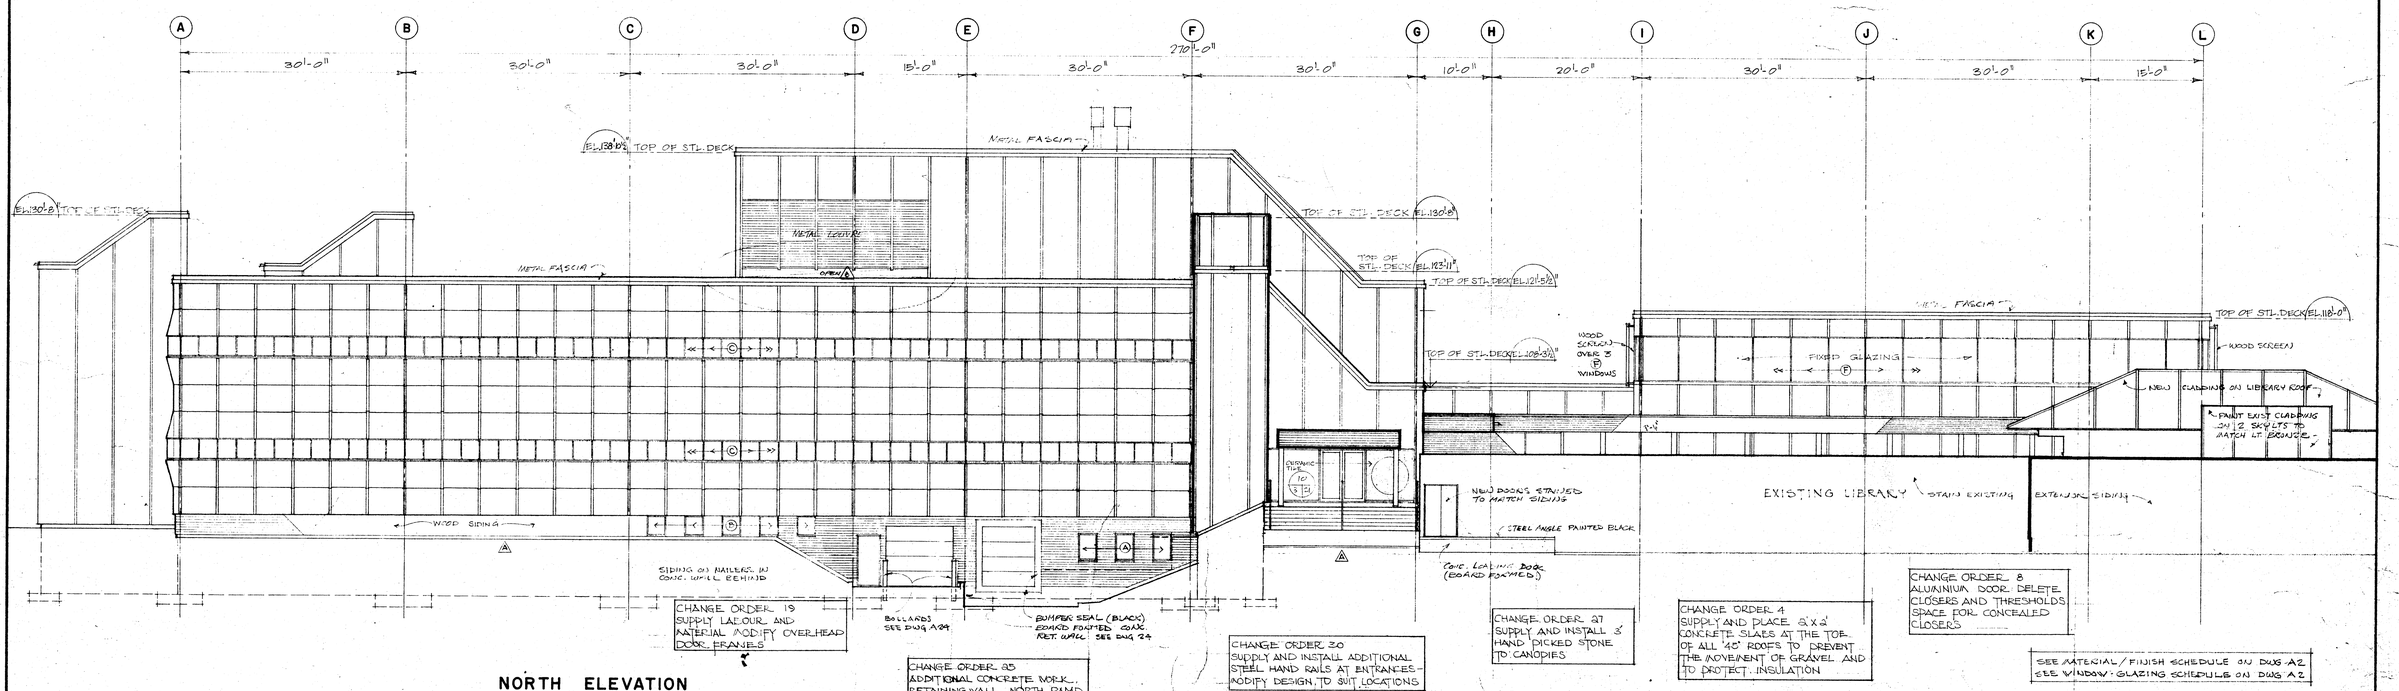

NORTH ELEVATION

CHANGE ORDER 19
SUPPLY LABOUR AND MATERIAL MODIFY OVERHEAD DOOR FRAMES

CHANGE ORDER 23
ADDITIONAL CONCRETE WORK. RETAINING WALL. NORTH RAMP LOADING AREA

CHANGE ORDER 30
SUPPLY AND INSTALL ADDITIONAL STEEL HAND RAILS AT ENTRANCES - MODIFY DESIGN TO SUIT LOCATIONS

CHANGE ORDER 27
SUPPLY AND INSTALL 3' HAND PICKED STONE TO CANOPIES

CHANGE ORDER 4
SUPPLY AND PLACE 6"x6" CONCRETE SLABS AT THE TOP OF ALL 45° ROOFS TO PREVENT THE MOVEMENT OF GRAVEL AND TO PROTECT INSULATION

CHANGE ORDER 8
ALUMINUM DOOR. DELETE CLOSERS AND THRESHOLDS SPACE FOR CONCEALED CLOSERS

SEE MATERIAL/FINISH SCHEDULE ON DWG A2.
SEE WINDOW: GLAZING SCHEDULE ON DWG A2.

Public Works Travaux publics Canada Canada Pacific Region

REVISIONS

NO.	DATE	DESCRIPTION
A	SEPT/74	EXTERIOR FINISH GRADE REVISED BETWEEN G & I. 5 A TO D NORTH ELEVATION. SEVEN RISERS DELETED
B	31 OCT 74	CORRECT LOUVRE ELEVATION ON PENTHOUSE.

PROJECT NO. 89857
DATE: APRIL 1/74
SCALE: 1/8"=1'-0"
DRAWN: R.S.
CHECK:
APPROVED

GOVERNMENT OF THE YUKON TERRITORY


DRAWING TITLE
SOUTH & NORTH ELEVATIONS


PROJECT TITLE
TERRITORIAL ADMINISTRATION BUILDING
WHITEHORSE, Y.T.

DRAWING NO.
A 3
B

MAIN ADMINISTRATION BUILDING
BLDG. # 1259
MEZZANINE FLOOR

GROSS USEABLE AREAS:
917.2sq.m.
9872.3sq.ft.

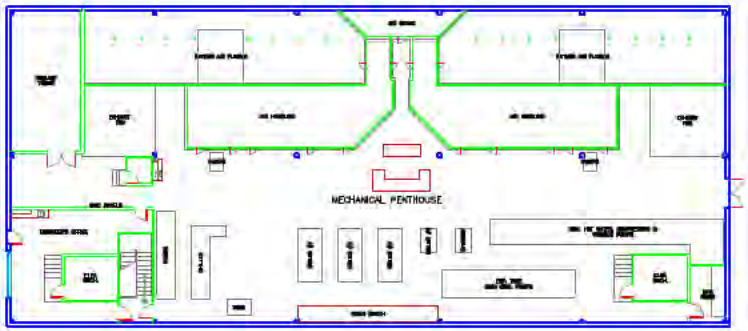


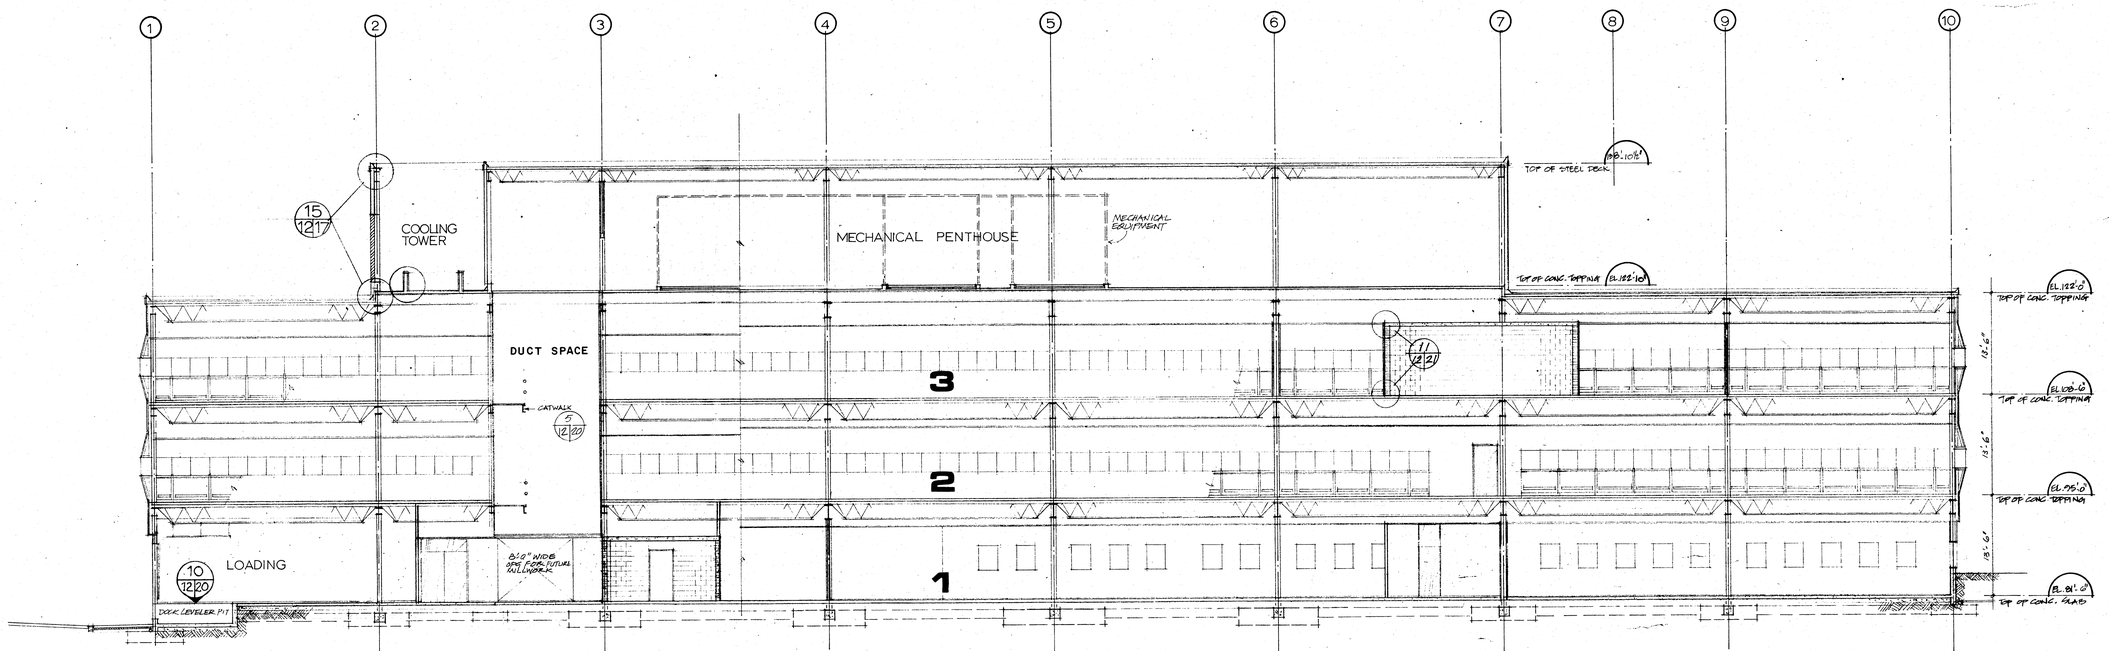

1/5/12 SECTION AT GRIDLINES C-D-E-F

CHANGE ORDER 9
SUPPLY 6mm TEMPERED GLASS TO ALL SKYLIGHTS IN LIEU OF GLASS SPECIFIED

CHANGE ORDER 4
INCREASE ROOF GRAVEL WEIGHT FROM 10 LBS PER SQ FT TO 15 LBS PER SQ FT.

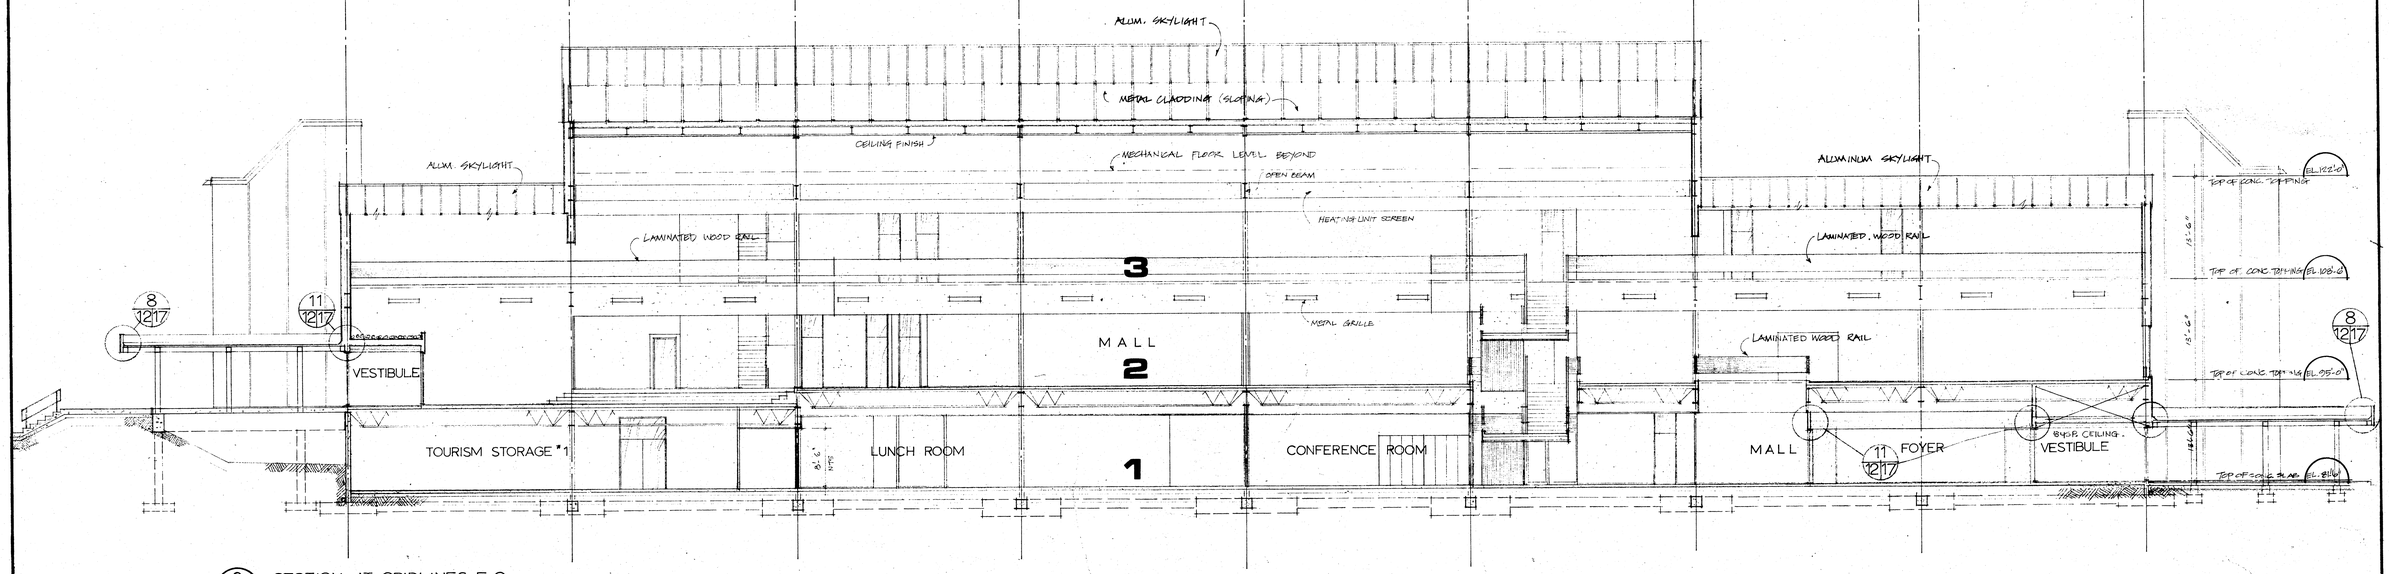

2/4/12 SECTION AT GRIDLINES F-G


NO.	DATE	REVISIONS DESCRIPTION
1	78/03/16	REVISED TO 'AS BUILT'


PROJECT NO. 8385.7
DATE APR. 1/74
SCALE 1/8" = 1'-0"
DRAWN KLC
CHECK
APPROVED

GOVERNMENT OF THE YUKON TERRITORY

DRAWING TITLE
BUILDING SECTIONS

PROJECT TITLE
TERRITORIAL ADMINISTRATION BUILDING
WHITEHORSE, Y.T.

DRAWING NO.
A12

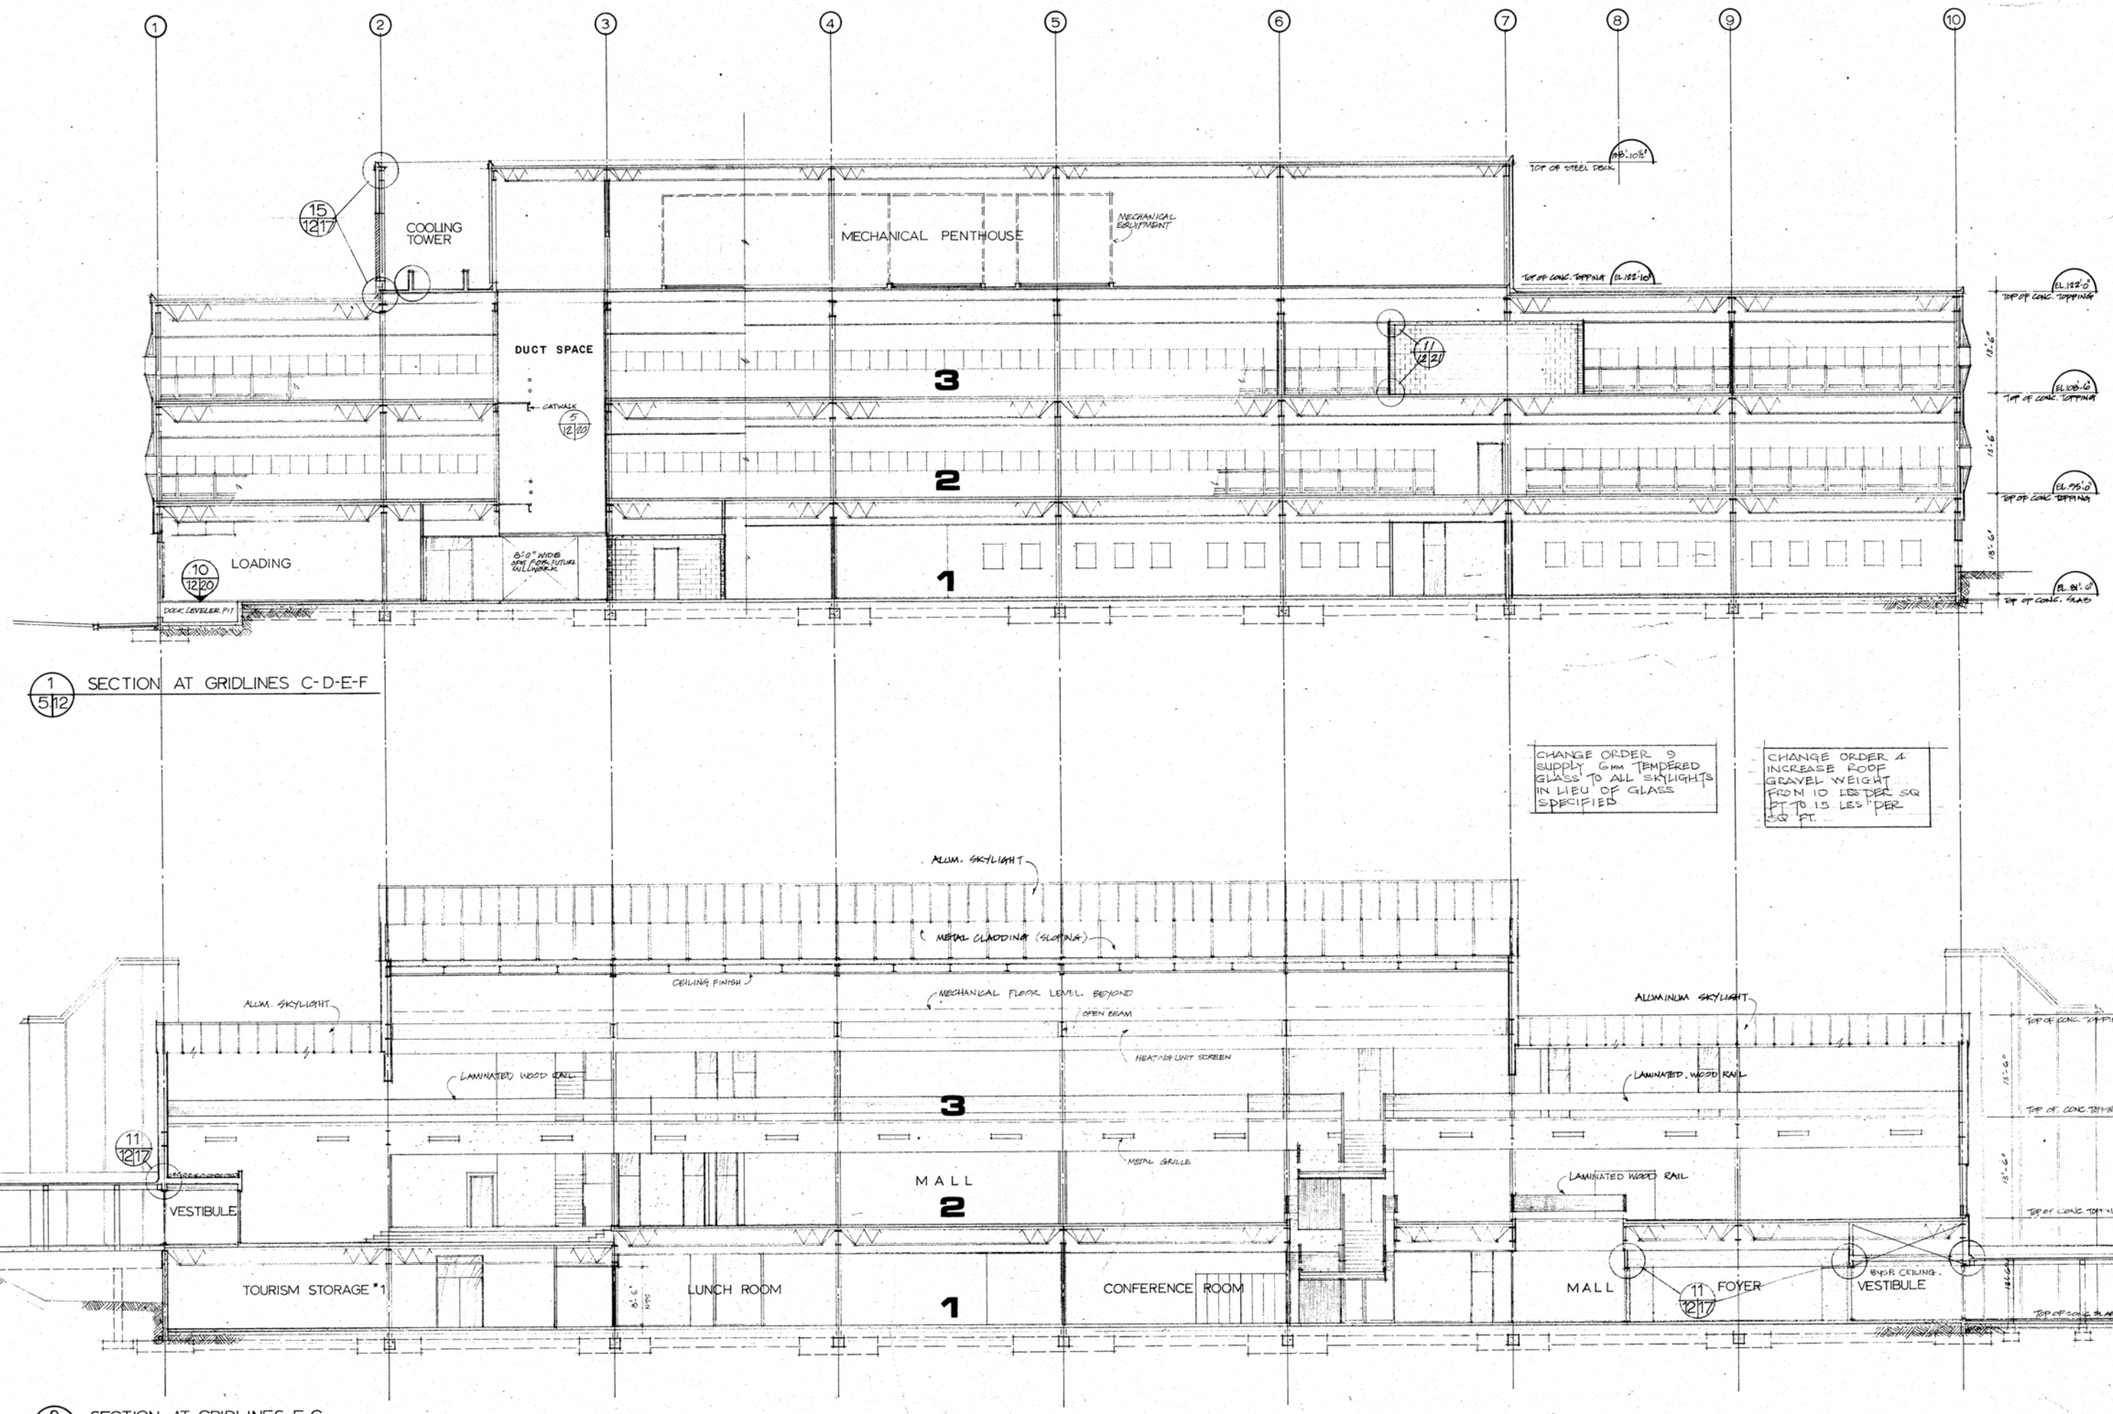

1/5/12 SECTION AT GRIDLINES C-D-E-F

2/4/12 SECTION AT GRIDLINES F-G

CHANGE ORDER 9
SUPPLY 6mm TEMPERED GLASS TO ALL SKYLIGHTS IN LIEU OF GLASS SPECIFIED

CHANGE ORDER 4
INCREASE ROOF GRAVEL WEIGHT FROM 10 LBS PER SQ FT TO 15 LBS PER SQ FT.

REVISIONS		
NO.	DATE	DESCRIPTION
A	78/05/26	REVISED TO 'AS BUILT'

PROJECT NO. 73857
DATE APR. 1/74
SCALE 1/8" = 1'-0"
DRAWN KLC
CHECK
APPROVED


PUBLIC WORKS, TRAVAUX PUBLICS
Yukon Region

GOVERNMENT OF THE YUKON TERRITORY


DRAWING TITLE
BUILDING SECTIONS

PROJECT TITLE
TERRITORIAL ADMINISTRATION BUILDING
WHITEHORSE, Y.T.

DRAWING NO.
A12

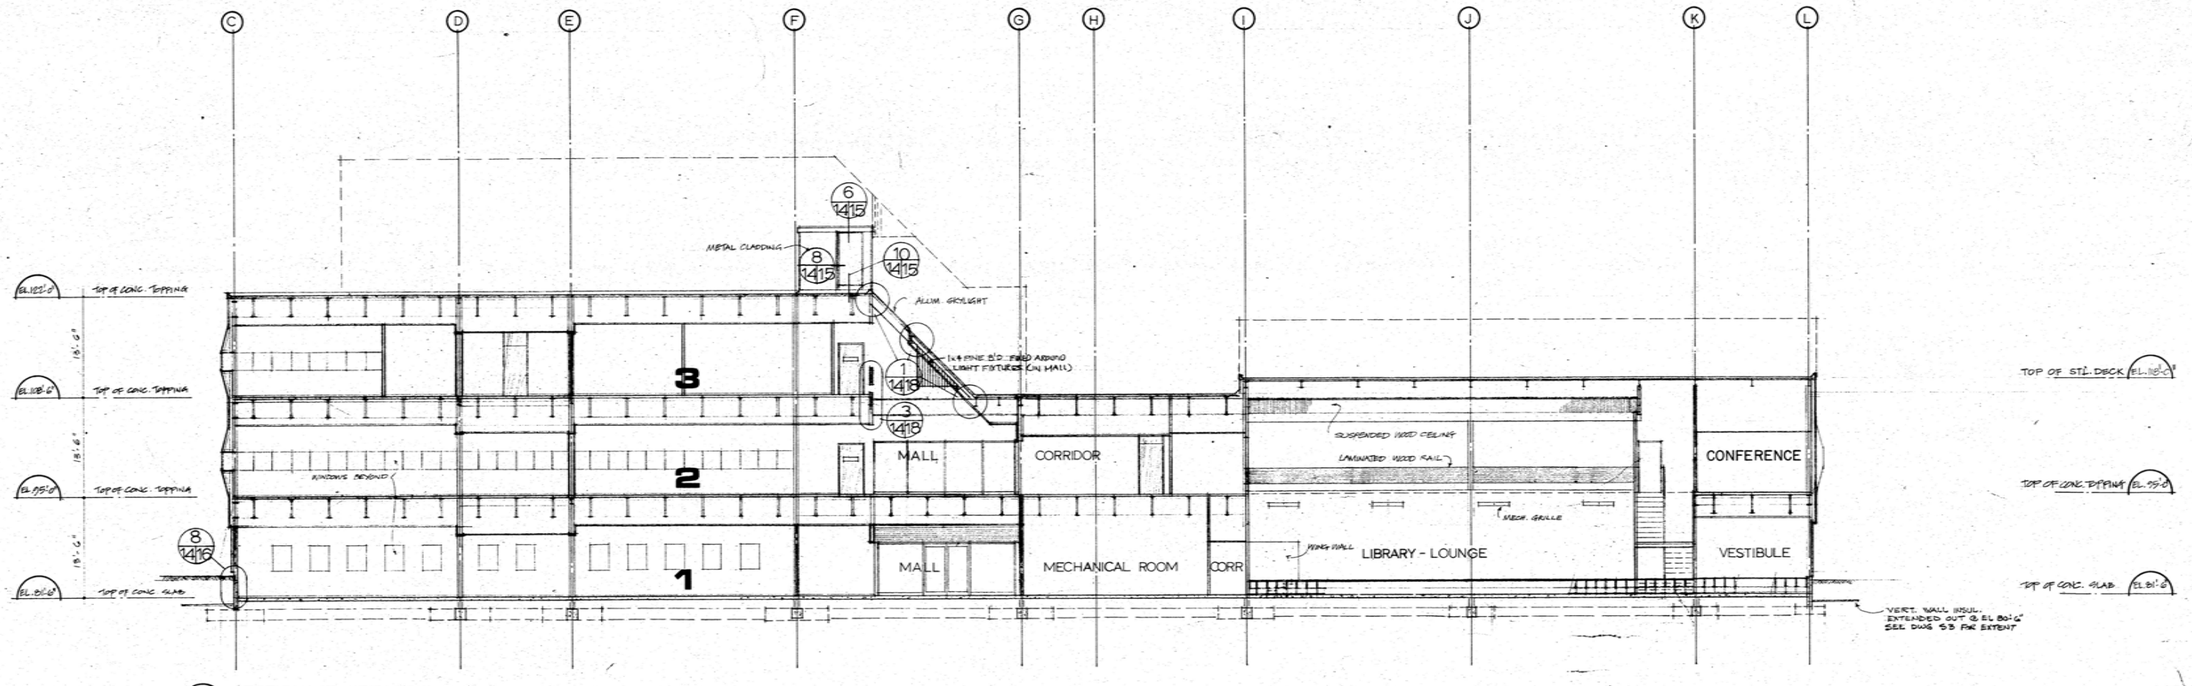

1/4/14 SECTION AT GRIDLINES 8-9

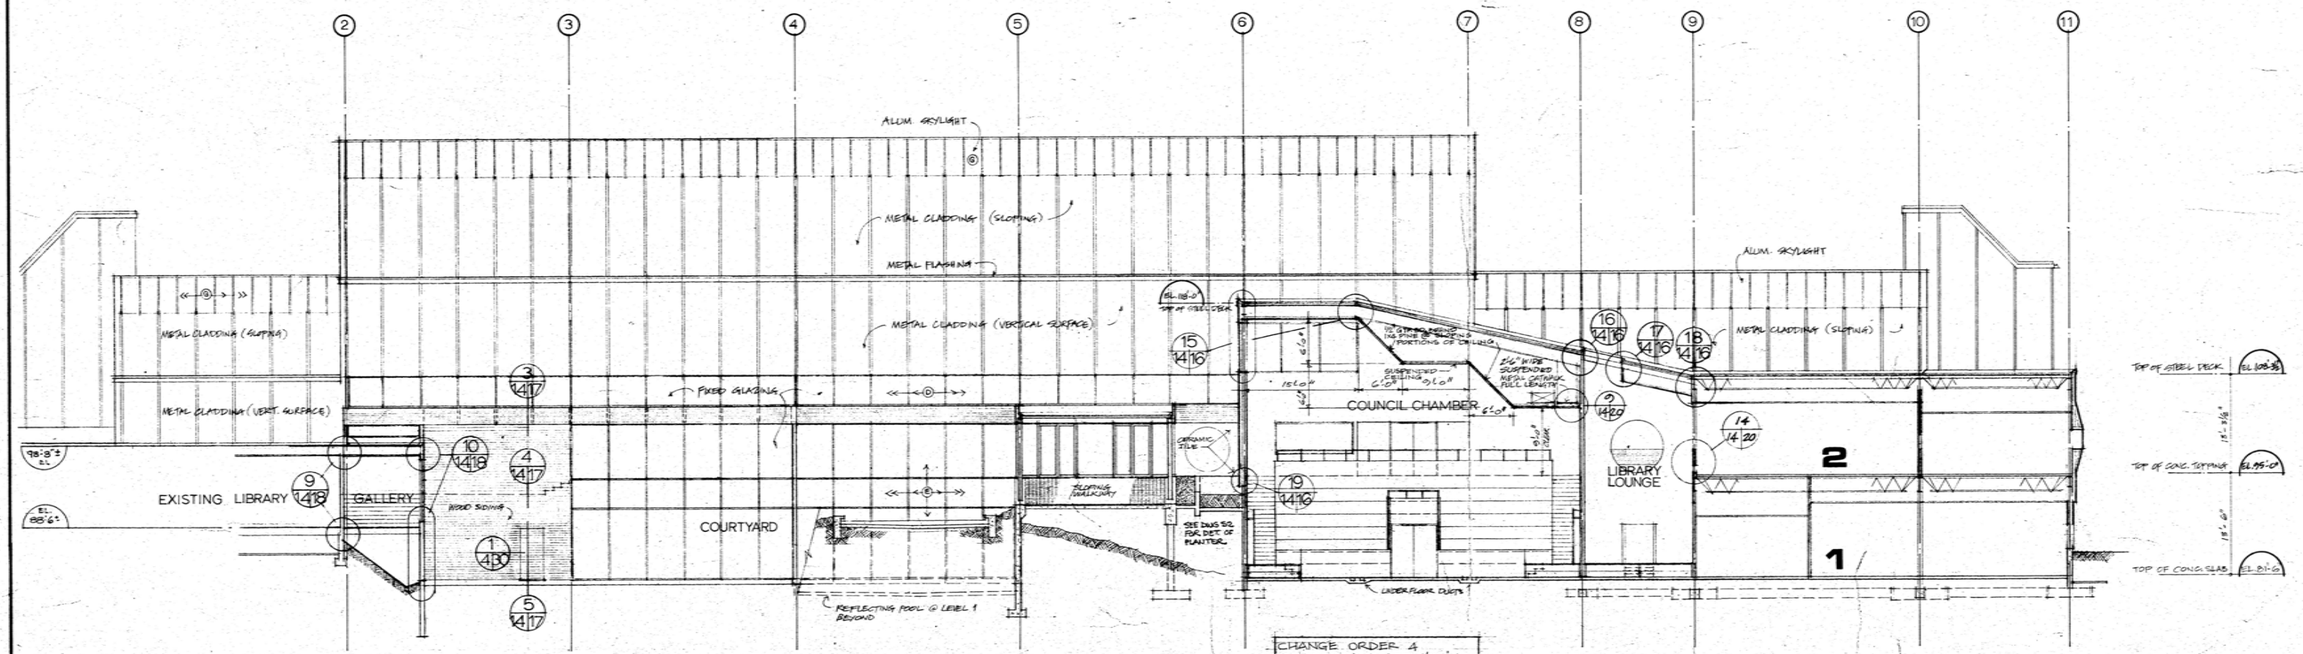


2/4/14 SECTION AT GRIDLINES J-K


CHANGE ORDER 4
SUPPLY AND PLACE 2'X 2' CONCRETE SLABS ALONG OUTSIDE PERIMETER OF COUNCIL CHAMBER LOWER ROOF TO PROTECT ROOF INSULATION

	REVISIONS		PROJECT NO.		DRAWING TITLE	DRAWING NO.
	NO.	DATE / DESCRIPTION	8085		BUILDING SECTIONS	A14
	A		DATE / SCALE		TERRITORIAL ADMINISTRATION BUILDING WHITEHORSE, Y.T.	
			DRAWN / CHECKED			
			APPROVED			


GOVERNMENT OF THE YUKON TERRITORY

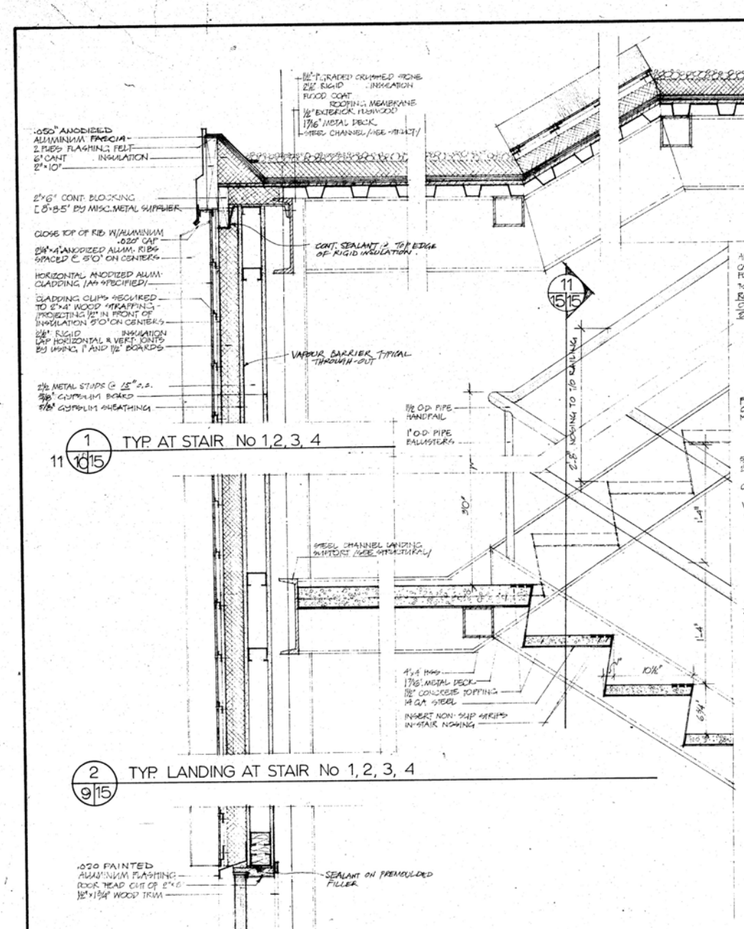

1 / 11 15/15 TYP. AT STAIR No 1,2, 3, 4

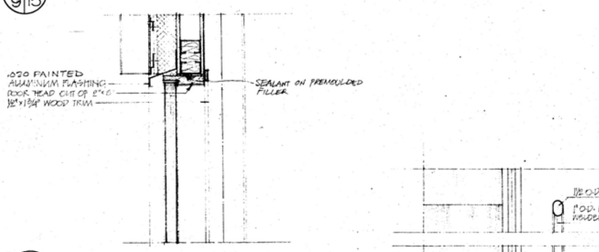


2 / 9/15 TYP. LANDING AT STAIR No 1, 2, 3, 4

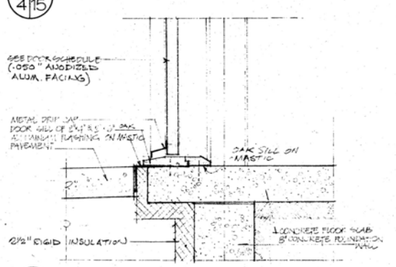


3 / 4/15 TYP. EXIT DOOR HEAD AT STAIR No 1, 2, 3, 4

4 / 4/15 TYP. EXIT DOOR SILL AT STAIR No 1, 2, 3, 4

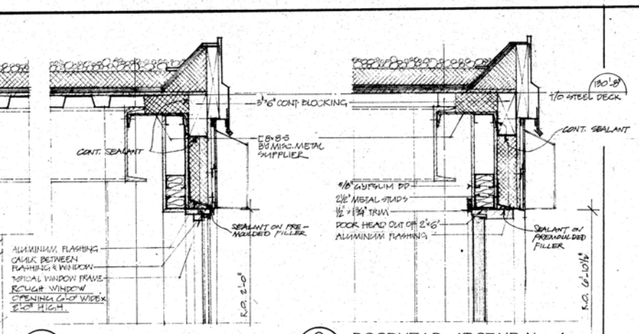

5 / 10/15 WINDOW HEAD AT STAIR No 1, 2, 3

6 / 10 & 14/15 DOORHEAD AT STAIR No 4

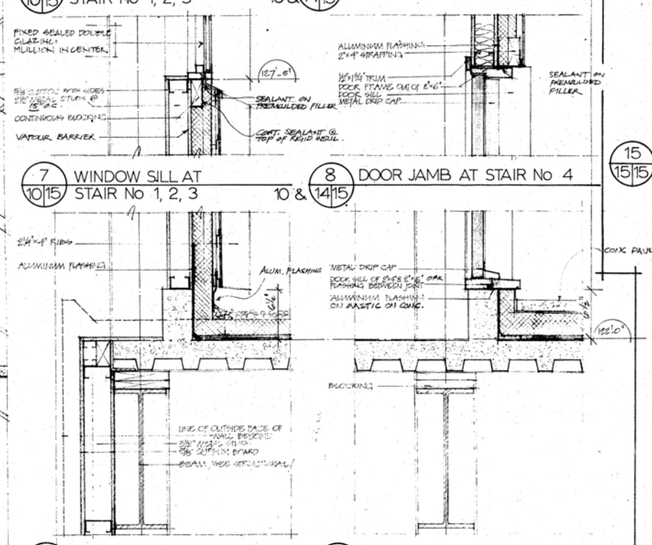


7 / 10/15 WINDOW SILL AT STAIR No 1, 2, 3


8 / 10 & 14/15 DOOR JAMB AT STAIR No 4

9 / 10/15 DETAIL AT LEVEL 3 ROOF STAIRWELL No 1, 2, 3


10 / 10 & 14/15 DOORSILL AT LEVEL 3 ROOF STAIRWELL No 4

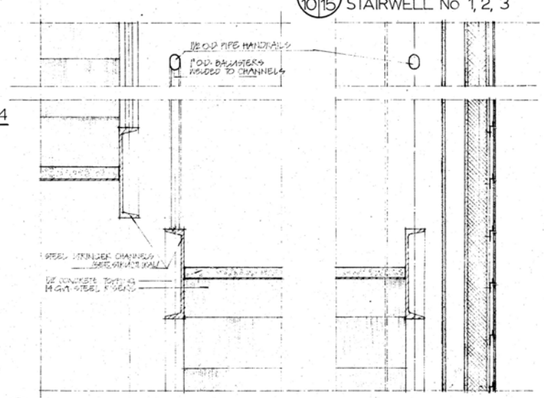

11 15/15 TYPICAL CROSS SECTION THRO' STAIR TREADS AND STRINGERS

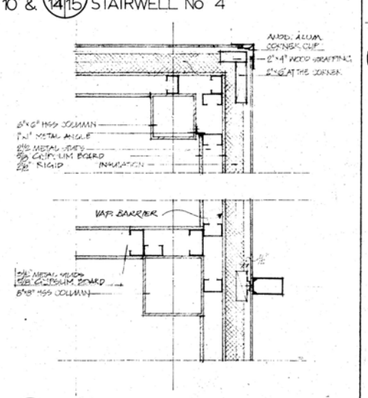


12 / 5/15 TYP. CORNERS AT STAIRWELL 1, 2, 3, 4

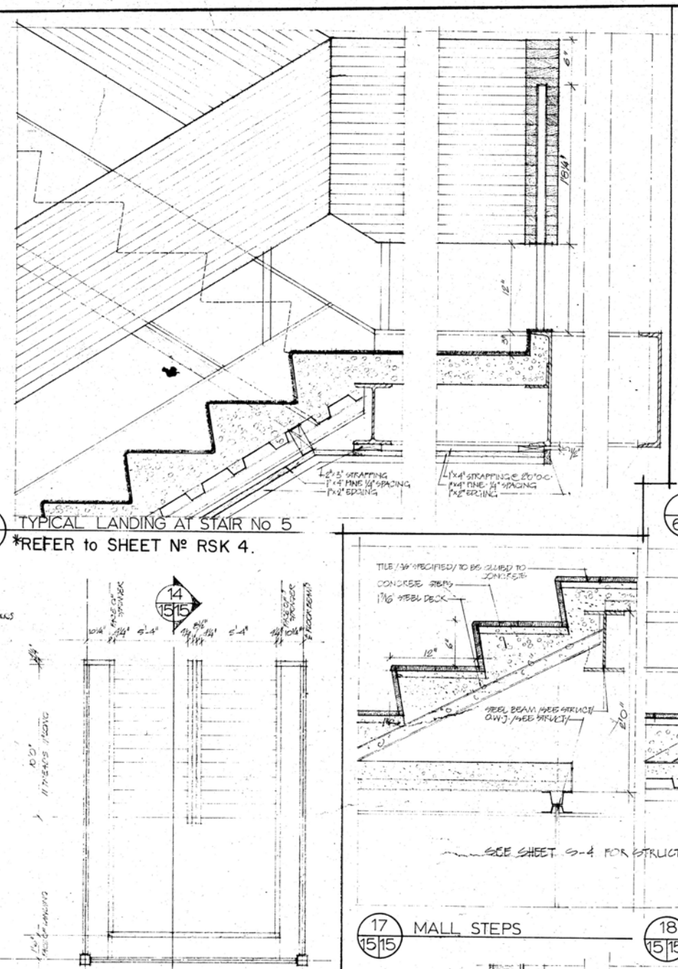

15 / 15/15 TYPICAL LANDING AT STAIR No 5


*REFER to SHEET № RSK 4.

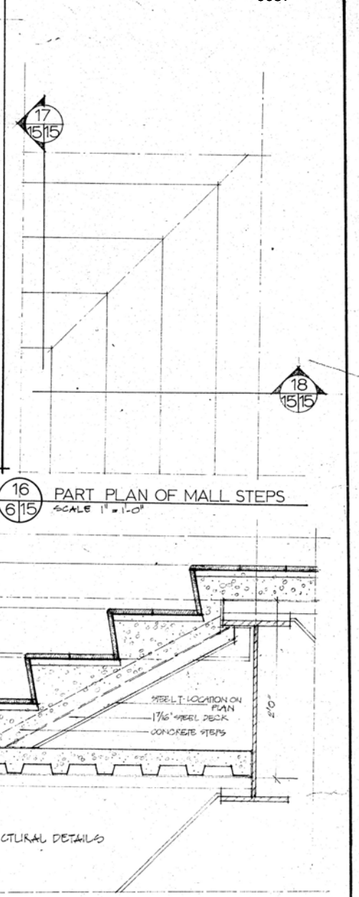

16 / 6/15 PART PLAN OF MALL STEPS
SCALE 1" = 1'-0"


13 / 6/15 TYP. PLAN OF STAIR No 5
1/4" = 1'-0"

*REFER to SHEET № RSK 4.

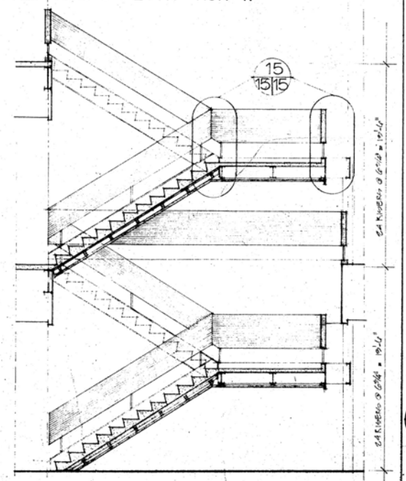


14 / 15/15 SECTION THRO' STAIR No 5

*REFER to SHEET № RSK 4.

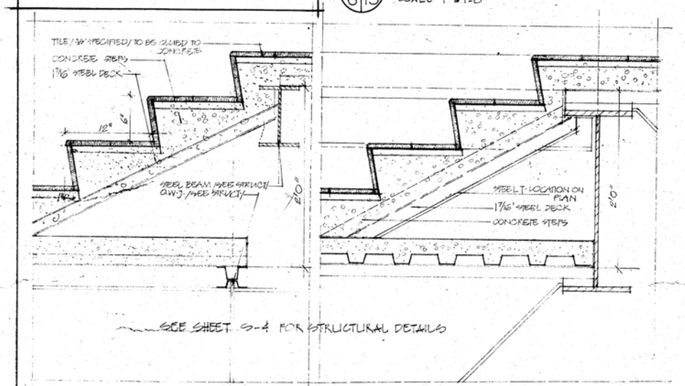

17 15/15 MALL STEPS

18 15/15 MALL STEPS

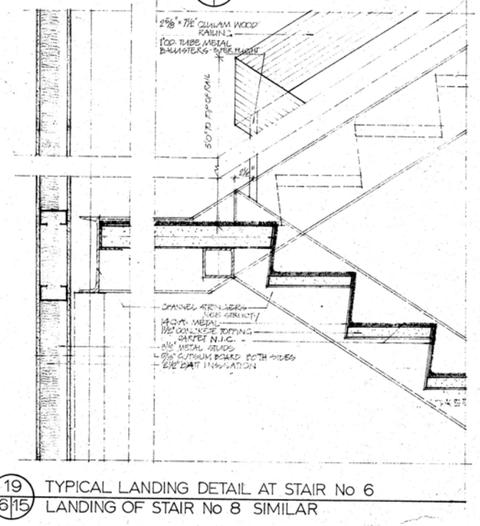

19 / 6/15 TYPICAL LANDING DETAIL AT STAIR No 6
LANDING OF STAIR No 8 SIMILAR

Public Works Canada / Travaux publics Canada
Pacific Region / Pacifique

REVISIONS


NO.	DATE	DESCRIPTION
1	May 30/84	REVISED TO 'AS BUILT'

PROJECT NO. 83857
DATE APRIL 1984 | SCALE 1/8 F.S.
DRAWN RMD/RHR | CHECK
APPROVED

GOVERNMENT OF THE YUKON TERRITORY


DRAWING TITLE
STAIR DETAILS
PROJECT TITLE
TERRITORIAL ADMINISTRATION BUILDING
WHITEHORSE, Y.T.

DRAWING NO.
A15

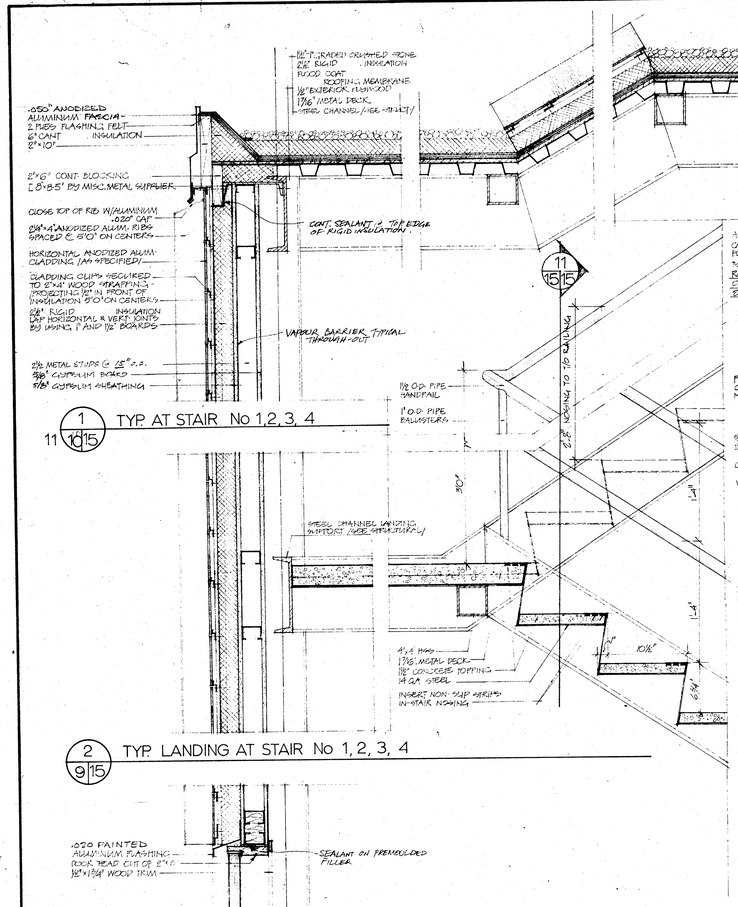


11 1 10/15 TYP. AT STAIR No 1,2, 3, 4


2 9/15 TYP. LANDING AT STAIR No 1, 2, 3, 4

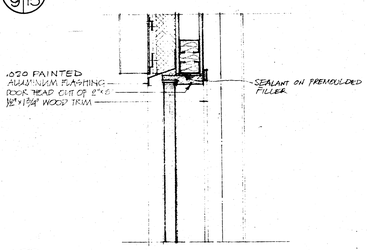

3 4/15 TYP. EXIT DOOR HEAD AT STAIR No 1, 2, 3, 4

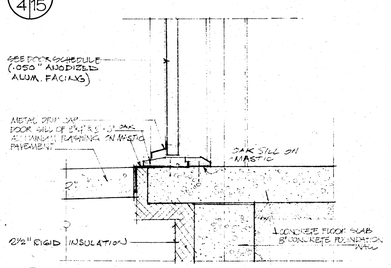


4 4/15 TYP. EXIT DOOR SILL AT STAIR No 1, 2, 3, 4

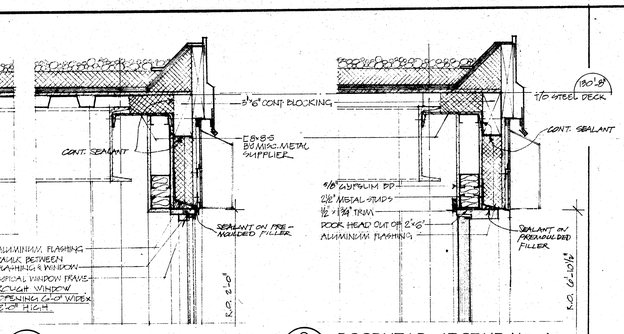


5 10/15 WINDOW HEAD AT STAIR No 1, 2, 3

6 10 & 14/15 DOORHEAD AT STAIR No 4

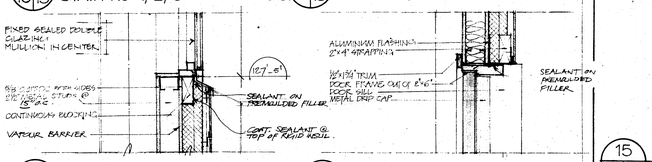


7 10/15 WINDOW SILL AT STAIR No 1, 2, 3

8 10 & 14/15 DOOR JAMB AT STAIR No 4

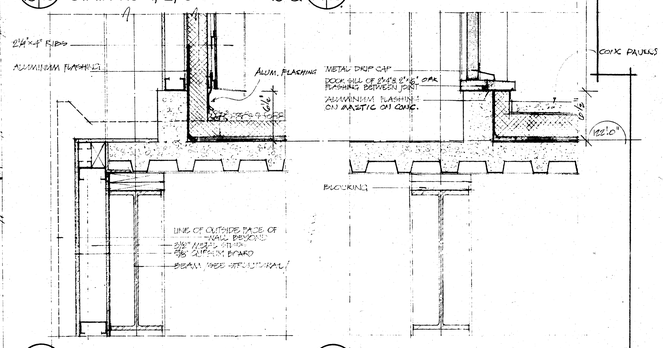


9 10/15 DETAIL AT LEVEL 3 ROOF STAIRWELL No 1, 2, 3


10 10 & 14/15 DOORSILL AT LEVEL 3 ROOF STAIRWELL No 4

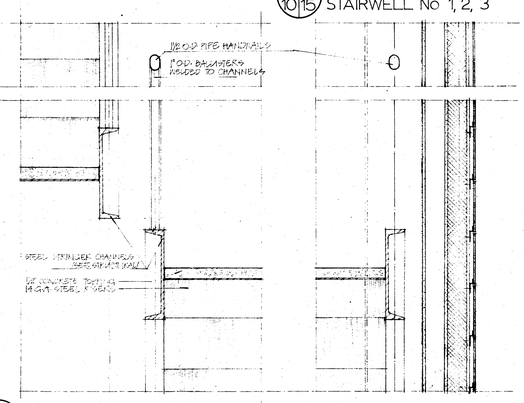

11 15/15 TYPICAL CROSS SECTION THRO' STAIR TREADS AND STRINGERS

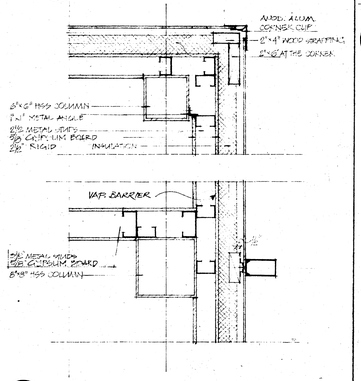

12 5/15 TYP. CORNERS AT STAIRWELL 1, 2, 3, 4

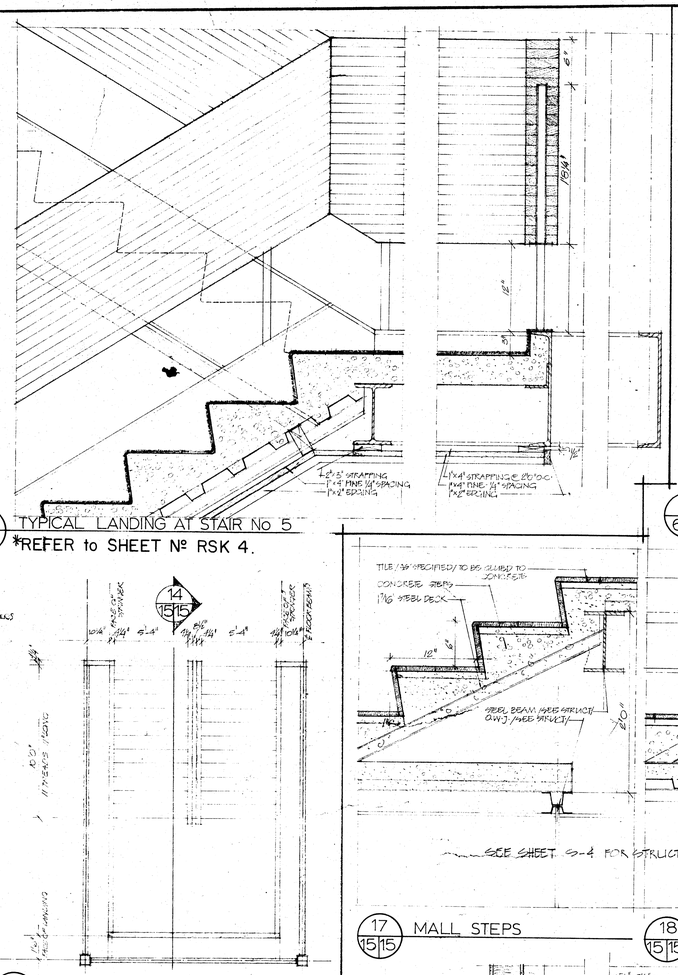


15 15/15 TYPICAL LANDING AT STAIR No 5

*REFER to SHEET № RSK 4.

13 6/15 TYP. PLAN OF STAIR No 5

1/4" = 1'-0"

*REFER to SHEET № RSK 4.

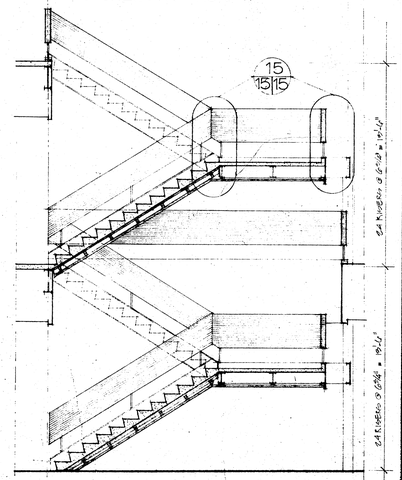


14 15/15 SECTION THRO' STAIR No 5

*REFER to SHEET № RSK 4.


16 6/15 PART PLAN OF MALL STEPS

SCALE 1" = 1'-0"

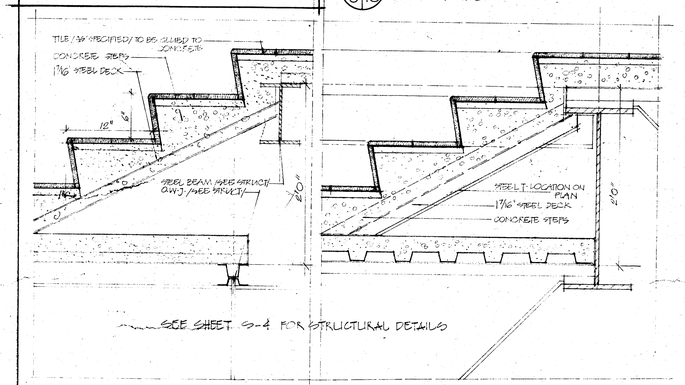

17 15/15 MALL STEPS

18 15/15 MALL STEPS

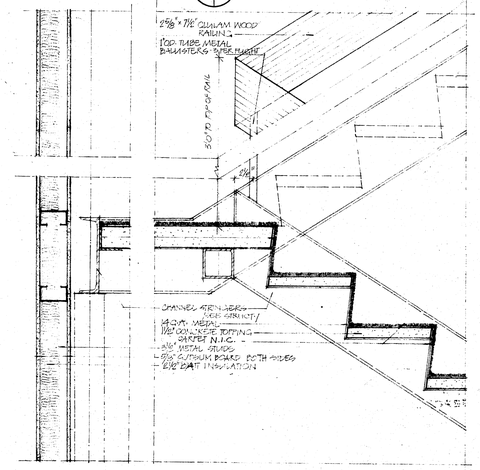

19 6/15 TYPICAL LANDING DETAIL AT STAIR No 6
LANDING OF STAIR No 8 SIMILAR

Public Works Canada / Travaux publics Canada
Pacific Region

REVISIONS

NO.	DATE	DESCRIPTION
1	[illegible]	REVISED TO 'AS BUILTS'

PROJECT NO. 8857

DATE APRIL 1974 | SCALE 1/8 F.G.

DRAWN HMO/RHR. | CHECK

APPROVED

GOVERNMENT OF THE YUKON TERRITORY

DRAWING TITLE
STAIR DETAILS

PROJECT TITLE
TERRITORIAL ADMINISTRATION BUILDING
WHITEHORSE, Y.T.

DRAWING NO.
A15

NOTE
ALL ALUM. FLASHING TO BE PAINTED TO MATCH BRONZE ANODIZED ALUM. CLADDING

1 — ROOF, CANT AND WALL AT MALL
11 & 13 | 17

2 — WINDOW HEAD
11 | 17

12 — TYPICAL EXTERIOR PENTHOUSE WALL
11 | 17

13 — PENTHOUSE FLOOR AT RAISED AREA
17

14 — EXTERIOR PENTHOUSE WALL AT DOUBLE DOORS
3 | 17

NOTE
ALL BEAMS PROTRUDING OUT OF PENTHOUSE WALLS TO BE WRAPPED IN 6" RIGID INSULATION OVER A LENGTH OF 40.0" MIN.

15 — MECH. GRILLE AT COOLING TOWER
12 | 17

3 — WINDOW SILL, FASCIA AND TRELLIS WORK
14 | 17

4 — LEVEL 2 FLOOR AT RAMP
14 | 17

5 — LEVEL 1 DOORS TO COURTYARD
14 & 4 | 17

6 — FASCIA AT MALL GLAZING
11 | 17

7 — CURTAINWALL GLAZING AT MALL
11 | 17

8 — MAIN ENTRANCE AT VESTIBULE AND CANOPY
12 & 11 | 17

9 — TYPICAL FASCIA OF LOW CANOPY
11 | 17

10 — SIDE FASCIA SECTION OF MAIN CANOPY AND END OF LOW CANOPY
11 | 17

11 — FASCIA AND HEAD DETAILS AND CANOPY CONNECTION AT NORTH-AND SOUTH ENTRANCES
12 | 17

Public Works Canada / Travaux publics Canada
Pacific Region / Pacifique

REVISIONS		
NO.	DATE	DESCRIPTION
A	SEPT-16-74	ASBESTOS CEMENT BOARD DELETED AT DETAIL 7. ALUM. SILL FLASHING EXTENDED
B	74/10/06	Revised to 'As Built'

PROJECT NO. 80857
DATE: 1 APRIL 1974 | SCALE: 1/8"=1'0"
DRAWN: R.M.K. | CHECK:
APPROVED

GOVERNMENT OF THE YUKON TERRITORY


DRAWING TITLE
WALL SECTIONS AND DETAILS

PROJECT TITLE
TERRITORIAL ADMINISTRATION BUILDING
WHITEHORSE, Y.T.


DRAWING NO.
A 17 (A)

NOTE
ALL ALUM. FLASHING TO BE PAINTED TO MATCH BRONZE ANODIZED ALUM. CLADDING


1 / 11&13|17 ROOF, CANT AND WALL AT MALL

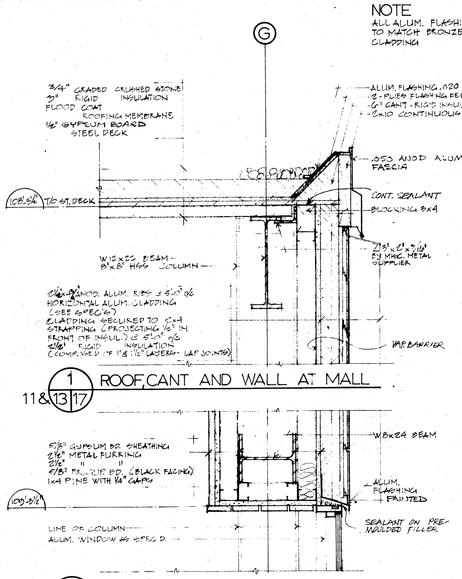


2 / 11|17 WINDOW HEAD

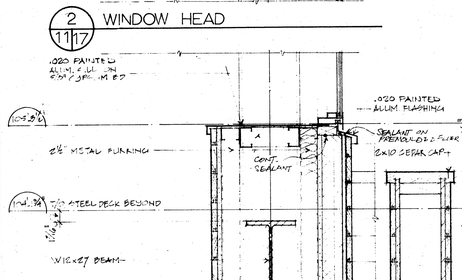


12 / 11|17 TYPICAL EXTERIOR PENTHOUSE WALL

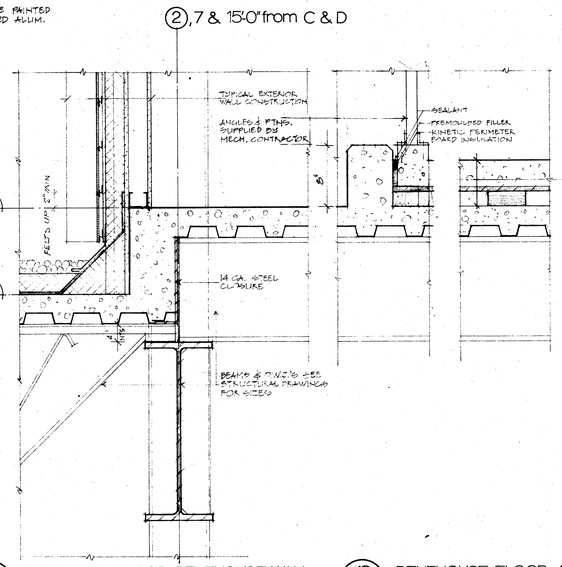


13 / 17 PENTHOUSE FLOOR AT RAISED AREA

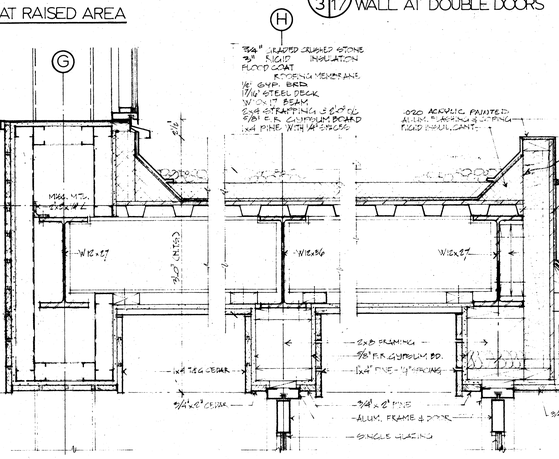


14 / 3|17 EXTERIOR PENTHOUSE WALL AT DOUBLE DOORS

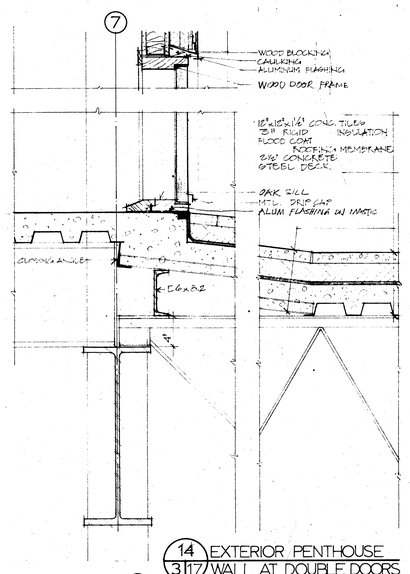


2

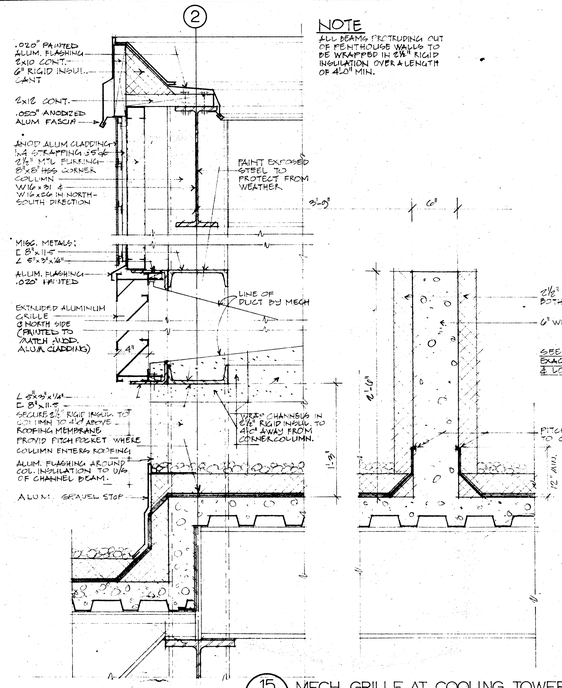


15 / 12|17 MECH. GRILLE AT COOLING TOWER

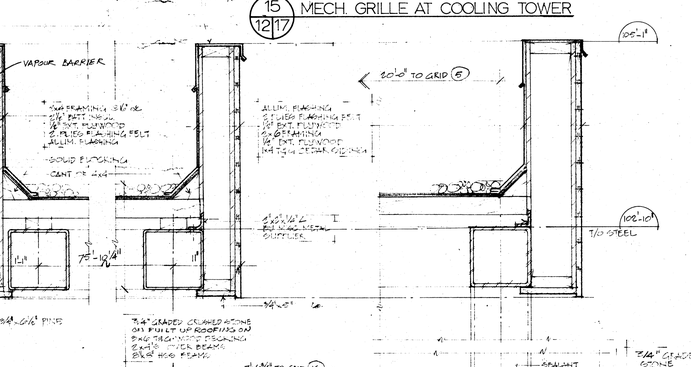

3 / 14|17 WINDOW SILL, FASCIA AND TRELLIS WORK

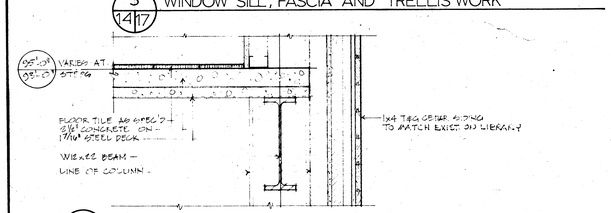


4 / 14|17 LEVEL 2 FLOOR AT RAMP

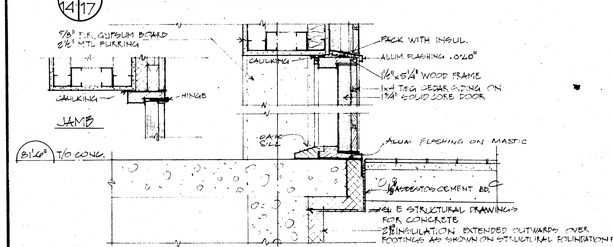


5 / 14 & 4|17 LEVEL 1 DOORS TO COURTYARD


6 / 11|17 FASCIA AT MALL GLAZING

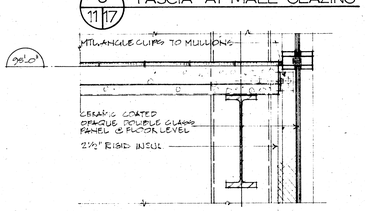


7 / 11|17 CURTAINWALL GLAZING AT MALL

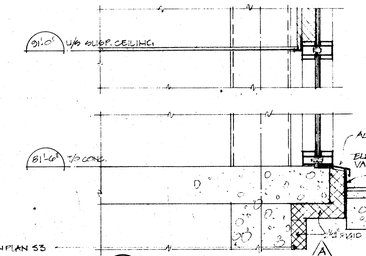

8 / 12 & 11|17 MAIN ENTRANCE AT VESTIBULE AND CANOPY

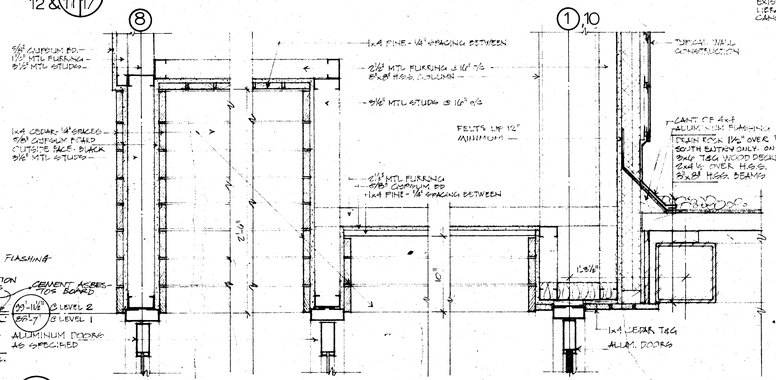

11 / 12|17 FASCIA AND HEAD DETAILS AND CANOPY CONNECTION AT NORTH-AND SOUTH ENTRANCES

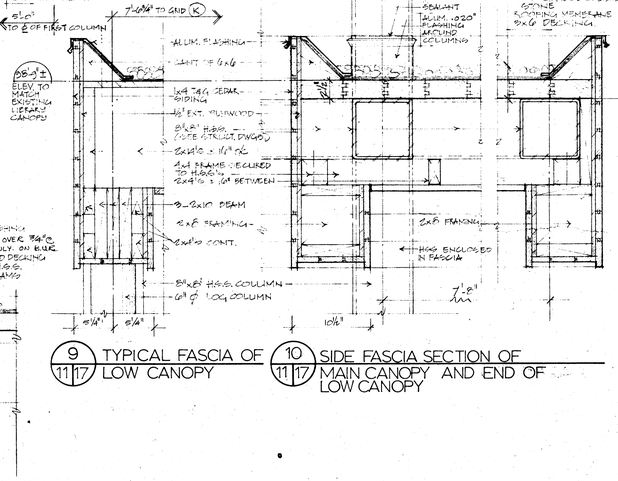

9 / 11|17 TYPICAL FASCIA OF LOW CANOPY

10 / 11|17 SIDE FASCIA SECTION OF MAIN CANOPY AND END OF LOW CANOPY

Public Works Travaux publics Canada Canada Pacific Region

REVISIONS		
NO.	DATE	DESCRIPTION
A	SEPT 16/76	ASBESTOS CEMENT BOARD DELETED AT DETAIL 7. ALUM. SILL FLASHING EXTENDED.
B	78/10/06	Revised to 'As Built'


PROJECT NO. 80857
DATE 1 APRIL 1974
SCALE 1/8" = 1'-0"
DRAWN R.H.K.
CHECK
APPROVED

GOVERNMENT OF THE YUKON TERRITORY


DRAWING TITLE
WALL SECTIONS AND DETAILS

PROJECT TITLE
TERRITORIAL ADMINISTRATION BUILDING
WHITEHORSE, Y.T.

DRAWING NO.
A 17 A

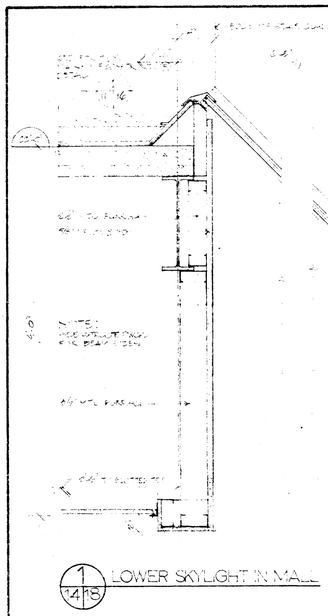


1 / 14|18 LOWER SKYLIGHT IN MALL

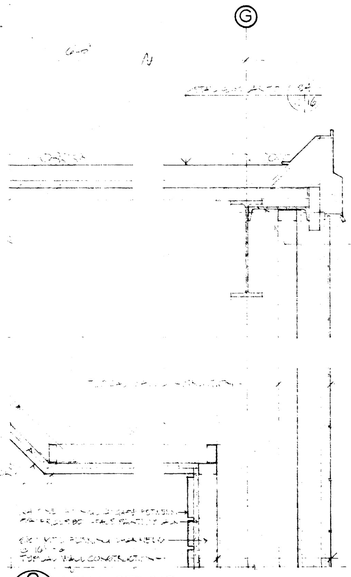


2 / 13|18 MALL CEILING




3 / 14|18 EDGE OF LEVEL 3

 


4 / 13|18 LEVEL 1 FLOOR AND LIBRARY FOUNDATION

 

5 / 13|18 LEVEL 2 AND LIBRARY CONNECTION

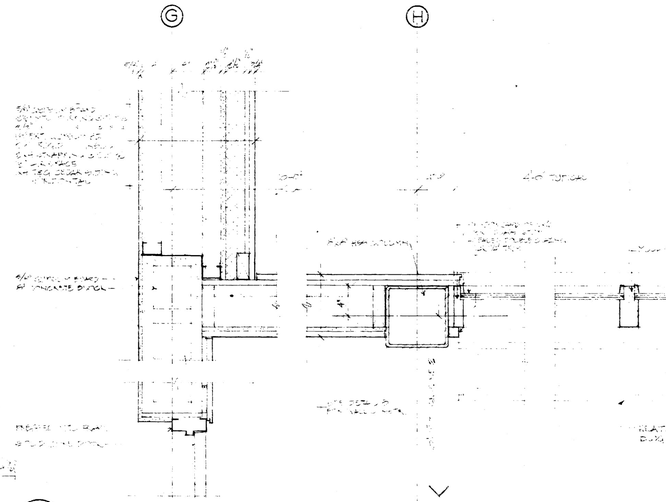


11 / 6&11|18 TYPICAL PLAN DETAILS AT CORRIDOR- GRIDLINE G TO EXISTING LIBRARY

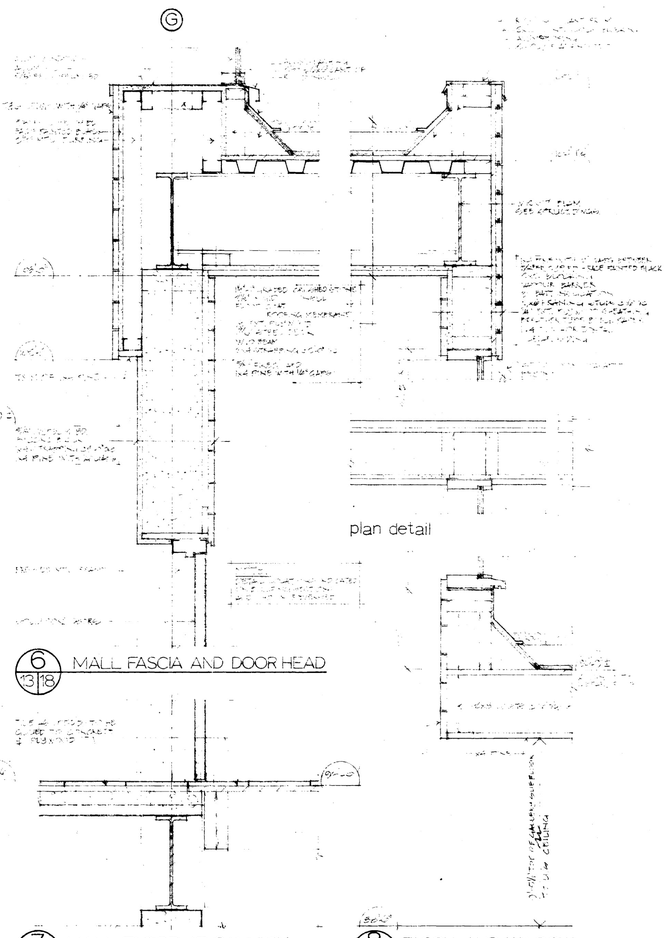

6 / 13|18 MALL FASCIA AND DOOR HEAD

7 / 13|18 MALL FLOOR AT GALLERY

8 / 13|18 FASCIA AND WINDOW AT GALLERY

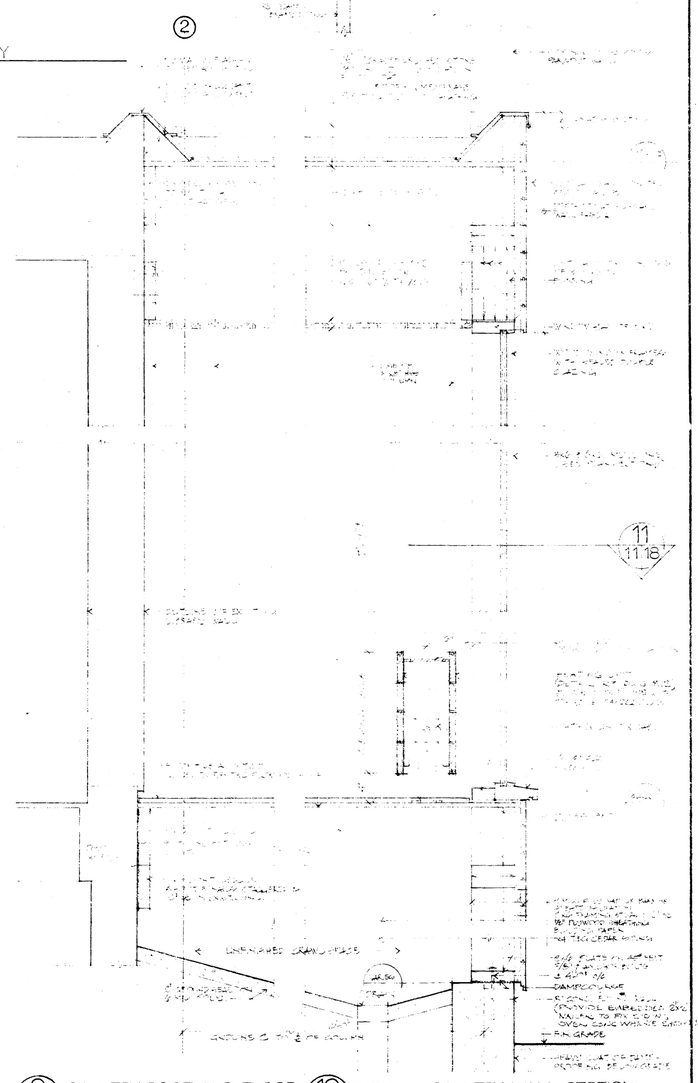

9 / 14|18 GALLERY ROOF AND FLOOR TO LIBRARY

10 / 14|18 TYPICAL GALLERY WALL SECTION

Public Works Canada / Travaux publics Canada
Pacific Region

REVISIONS		
NO.	DATE	DESCRIPTION
A.	96/10/02	Revised to 'As Builts'

PROJECT NO. 92027
DATE APR 1994 | SCALE 1/4"=1'-0"
DRAWN S.H.R. | CHECK
APPROVED


GOVERNMENT OF THE YUKON TERRITORY

DRAWING TITLE
WALL SECTIONS AND DETAILS


PROJECT TITLE
TERRITORIAL ADMINISTRATION BUILDING
WHITEHORSE, Y.T.

DRAWING NO.
A 18

NOTE
SEE SHEET A-16 FOR TYPICAL WALL CONSTRUCTION

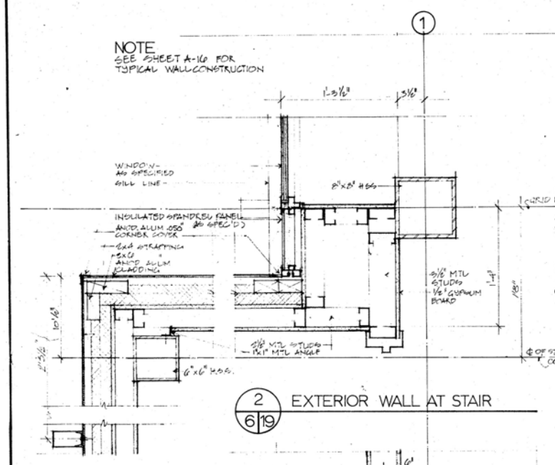


2 6/19 EXTERIOR WALL AT STAIR

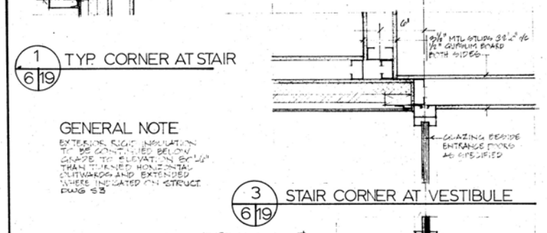


1 6/19 TYP. CORNER AT STAIR

GENERAL NOTE
EXTERIOR EDGE INSULATION TO BE CONTINUED BELOW GRADE TO ELEVATION 50" LESS THAN TO LEVEL HORIZONTAL CUTAWAYS AND EXTENDED WHERE INDICATED ON STRUCT. DWGS 6.3


3 6/19 STAIR CORNER AT VESTIBULE

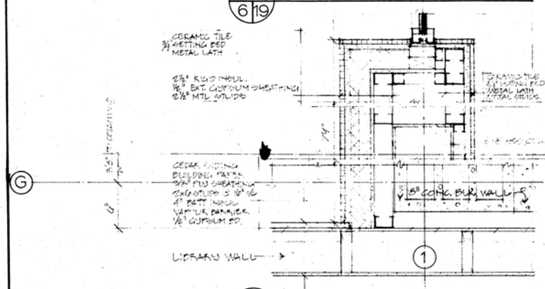


13 6/19 VESTIBULE WALL AT LIBRARY CONNECTION

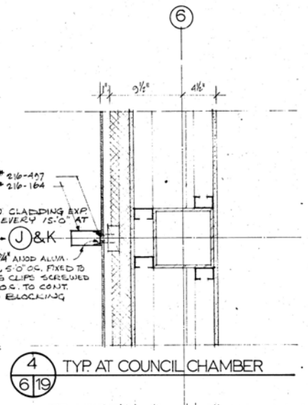


4 6/19 TYP. AT COUNCIL CHAMBER

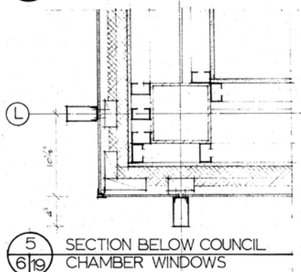

5 6/19 SECTION BELOW COUNCIL CHAMBER WINDOWS

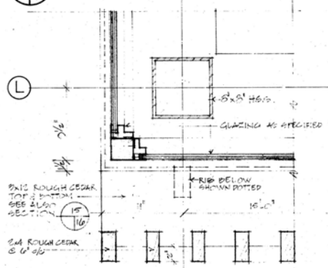


6 8/19 NORTH AND WEST WINDOWS IN COUNCIL CHAMBER

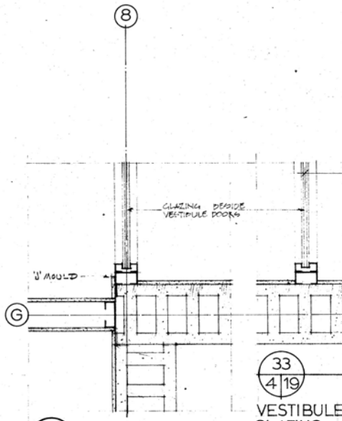

33 4/19 VESTIBULE GLAZING


11 4/19 EXIT WALL

10 4/19 VEST. GLAZING AND MECH. ROOM WALL

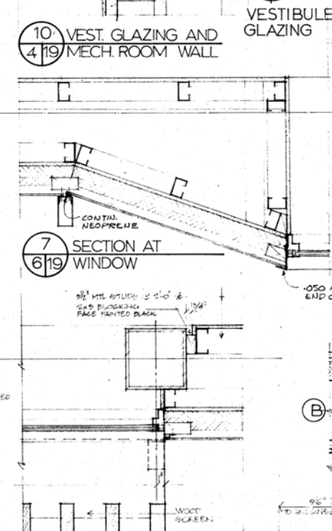


7 6/19 SECTION AT WINDOW

8 8/19 WINDOWS AND SCREEN

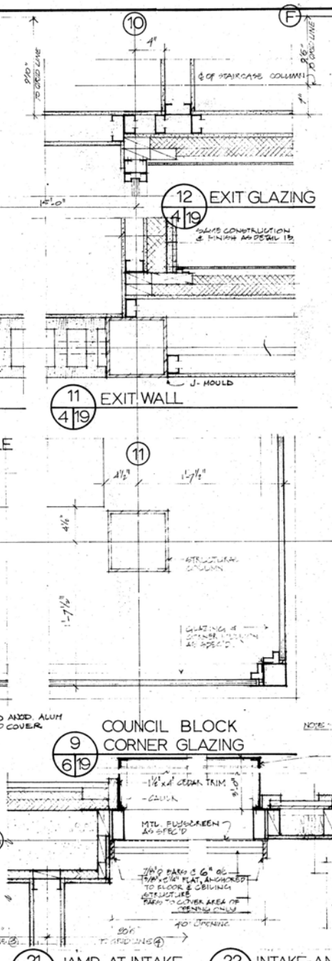

12 4/19 EXIT GLAZING

11 4/19

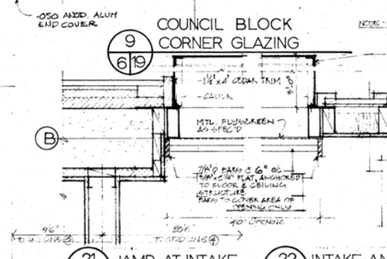


7 6/19

COUNCIL BLOCK CORNER GLAZING


9 6/19

21 5/19 JAMB AT INTAKE DUCT

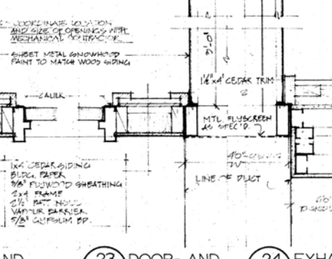


22 5/19 INTAKE- AND DOOR JAMB

23 5/19 DOOR- AND EXH. JAMB

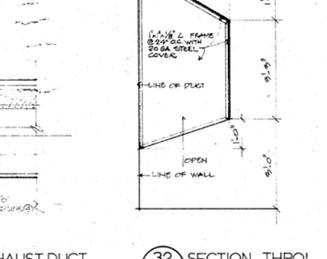

24 5/19 EXHAUST DUCT JAMB


32 4/19 SECTION THRO' SNOWHOOD

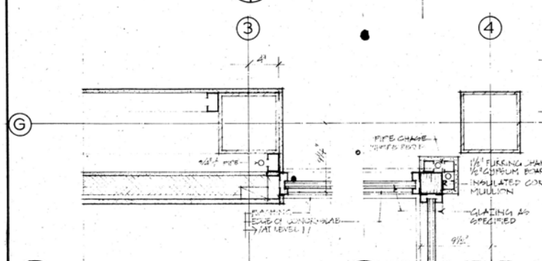

18 6/19 SOUTH WALL GLAZING BETWEEN F & G LEVEL 2


14 6/19 EXTERIOR WALL AT MALL

15 6/19 GLAZING AT MALL

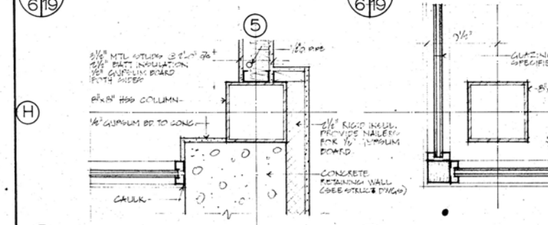


17 4/19 RETAINING WALL AND GLAZING LEVEL 1


16 6/19 CORNER GLAZING IN MALL

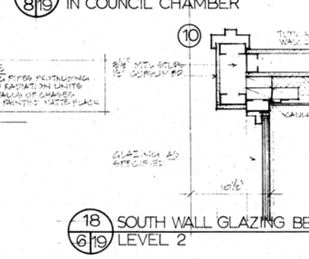

19 6/19 SOUTH WALL GLAZING AT MECH. SHAFT

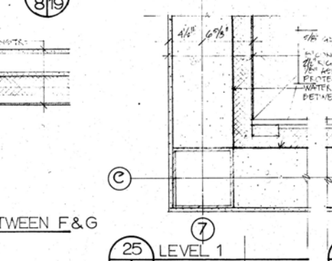


20 6/19 SOUTH-EAST CORNER COUNCIL BLOCK

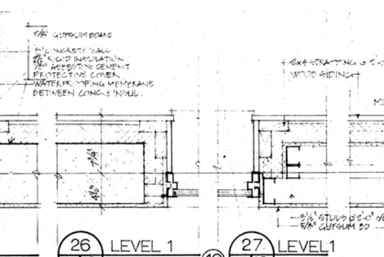

7 25 5/19 LEVEL 1

26 5/19 LEVEL 1


27 5/19 LEVEL 1 TYPICAL

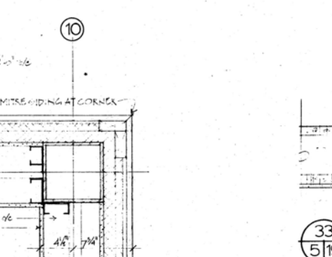


28 5/19 LEVEL 1

29 5/19 LEVEL 1 AT ROUND WALL

30 5/19 FOUNDATION WALL

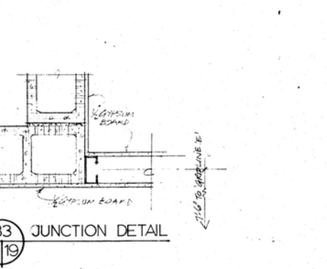

33 5/19 JUNCTION DETAIL

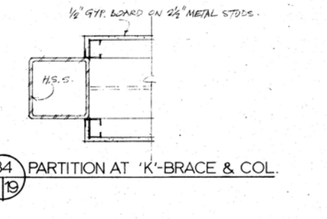

34 5/19 PARTITION AT 'K'-BRACE & COL.

Public Works Travaux publics Canada Canada Pacific Region

REVISIONS		
NO.	DATE	DESCRIPTION
A.	78/10/06	Revised to 'As Built'


PROJECT NO. 30867
DATE 1 APRIL 1974
SCALE 1/8"=1'-0"
DRAWN H.M.G./R.H.A.
CHECK
APPROVED

GOVERNMENT OF THE YUKON TERRITORY


DRAWING TITLE
PLAN DETAILS
PROJECT TITLE
TERRITORIAL ADMINISTRATION BUILDING
WHITEHORSE, Y.T.

DRAWING NO.
A19

NOTE
SEE SHEET A-16 FOR TYPICAL WALL CONSTRUCTION

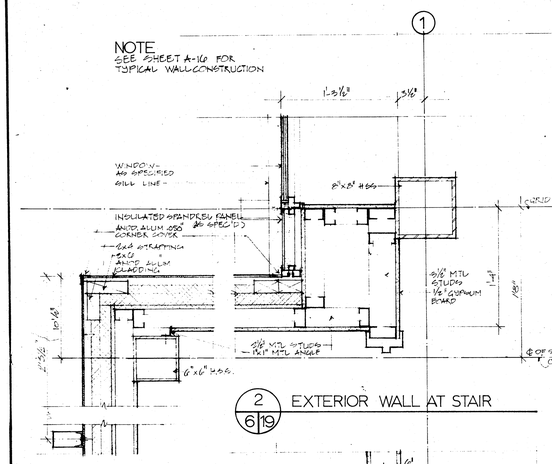


2 6/19 EXTERIOR WALL AT STAIR

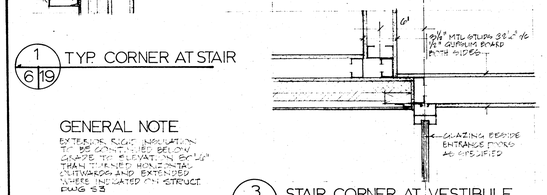


1 6/19 TYP. CORNER AT STAIR

GENERAL NOTE
EXTERIOR SIDE INSULATION TO BE CONTINUOUS BELOW GRADE TO ELEVATION LOWER THAN LOWEST HORIZONTAL CRAWLSPACES AND EXPOSED WHERE INDICATED ON STRUCT. DWG 'S'

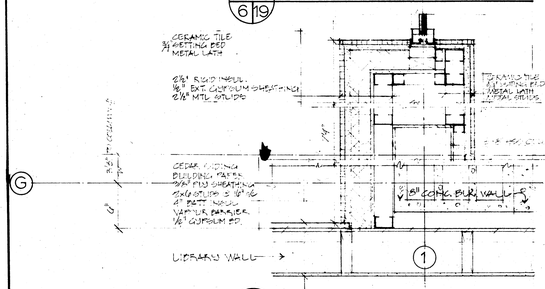


13 6/19 VESTIBULE WALL AT LIBRARY CONNECTION


3 6/19 STAIR CORNER AT VESTIBULE

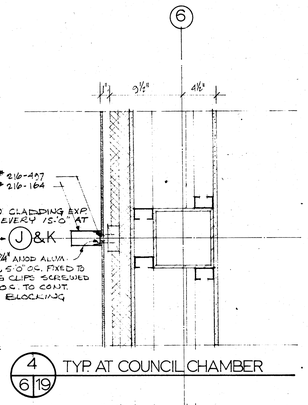


4 6/19 TYP. AT COUNCIL CHAMBER

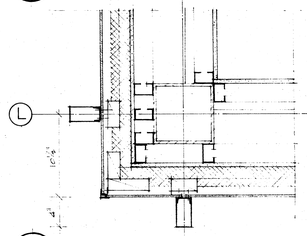

5 6/19 SECTION BELOW COUNCIL CHAMBER WINDOWS

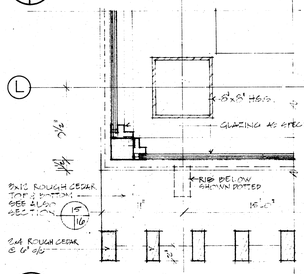


6 8/19 NORTH AND WEST WINDOWS IN COUNCIL CHAMBER

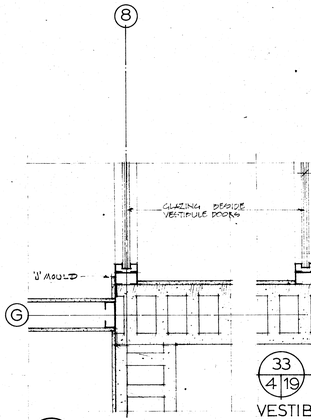


10 4/19 VEST. GLAZING AND MECH. ROOM WALL


33 4/19 VESTIBULE GLAZING

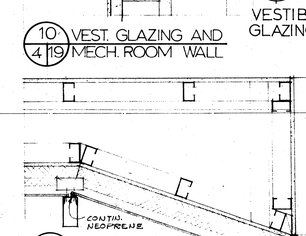

7 6/19 SECTION AT WINDOW

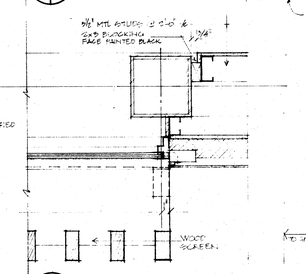


8 8/19 WINDOWS AND SCREEN

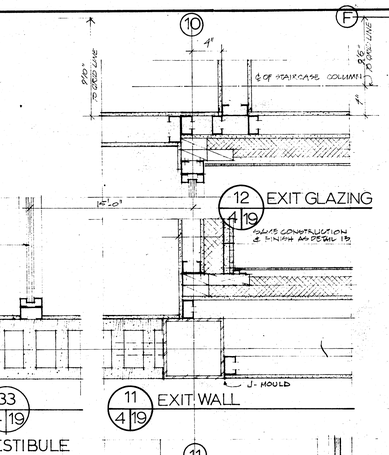


12 4/19 EXIT GLAZING


11 4/19 EXIT WALL

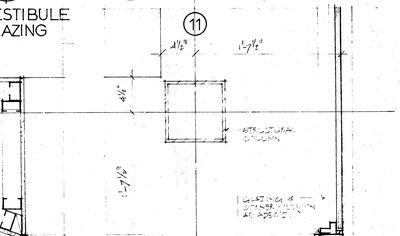


9 6/19 COUNCIL BLOCK CORNER GLAZING

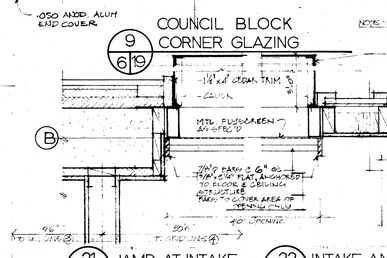


21 5/19 JAMB AT INTAKE DUCT

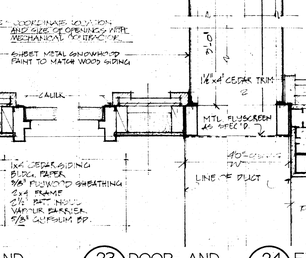

22 5/19 INTAKE- AND DOOR JAMB

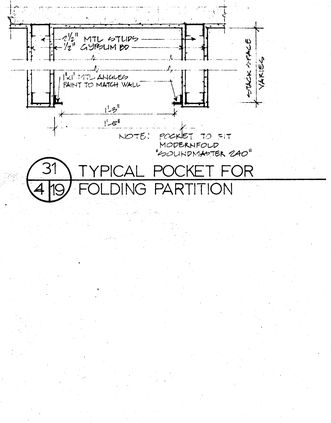


31 4/19 TYPICAL POCKET FOR FOLDING PARTITION

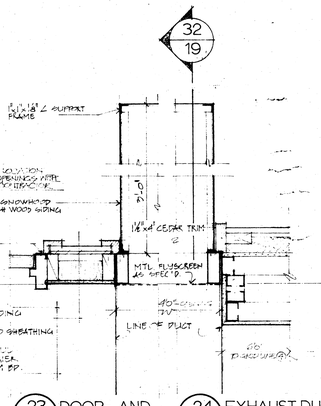


23 5/19 DOOR- AND EXH. JAMB

24 5/19 EXHAUST DUCT JAMB

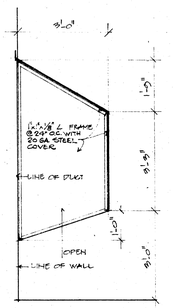


32 4/19 SECTION THRO' SNOWHOOD

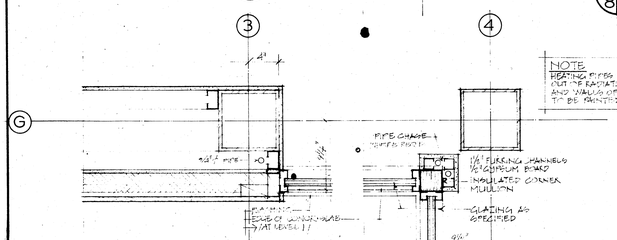


14 6/19 EXTERIOR WALL AT MALL

15 6/19 GLAZING AT MALL

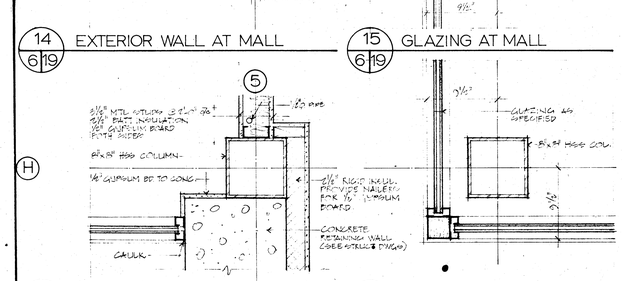


17 4/19 RETAINING WALL AND GLAZING LEVEL 1


16 6/19 CORNER GLAZING IN MALL

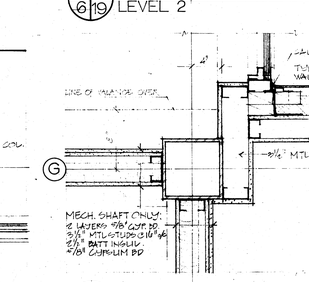

19 6/19 SOUTH WALL GLAZING AT MECH. SHAFT

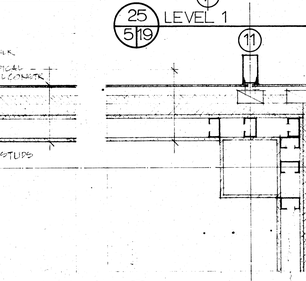


20 6/19 SOUTH-EAST CORNER COUNCIL BLOCK

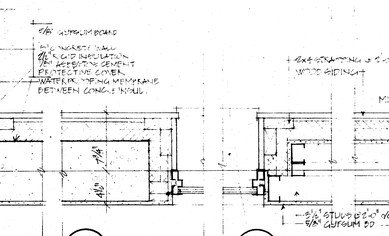


25 5/19 LEVEL 1

26 5/19 LEVEL 1

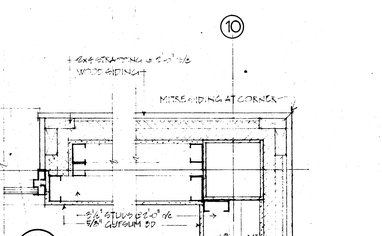


27 5/19 LEVEL 1 TYPICAL

28 5/19 LEVEL 1

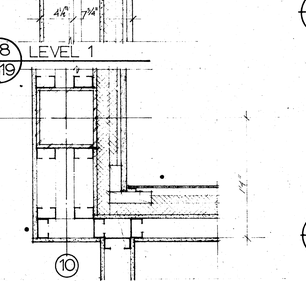


29 5/19 LEVEL 1 AT ROUND WALL

30 5/19 LEVEL 1 ABOVE FOUNDATION WALL

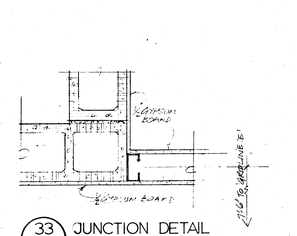

33 5/19 JUNCTION DETAIL

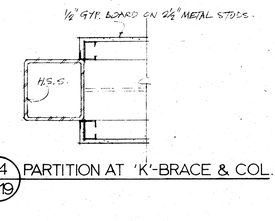

34 5/19 PARTITION AT 'K'-BRACE & COL.

Public Works Canada / Travaux publics Canada
Pacific Region


REVISIONS		
NO.	DATE	DESCRIPTION
A.	78/10/06	Revised to 'As Built'

PROJECT NO. 80857
DATE April 1974 | SCALE 1/8"=1'-0"
DRAWN H.M.G./R.H.A. | CHECK
APPROVED


GOVERNMENT OF THE YUKON TERRITORY

DRAWING TITLE
PLAN DETAILS
PROJECT TITLE
TERRITORIAL ADMINISTRATION BUILDING
WHITEHORSE, Y.T.


DRAWING NO.
A19

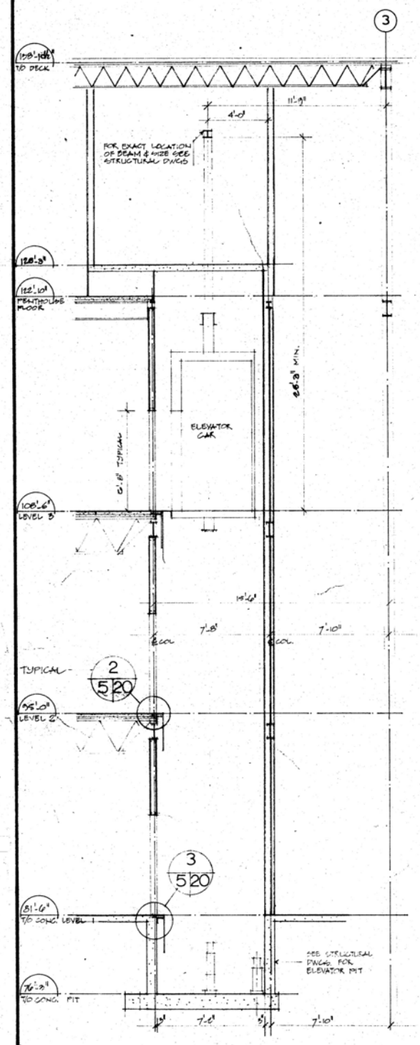


1 5/20 SECTION THRO' ELEVATOR SHAFT
1/4" = 1'-0"

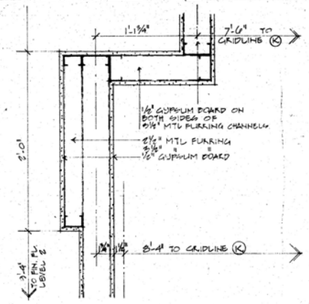


4 6/20 WALL TRANSITION AT EAST SIDE OF STAIR No. 8

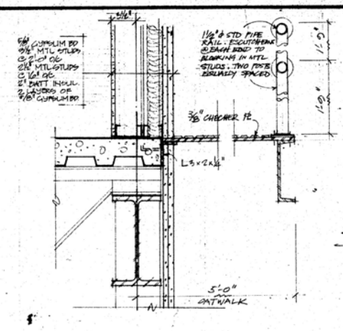


5 12/20 TYPICAL MECHANICAL SHAFT AT FLOOR LEVEL

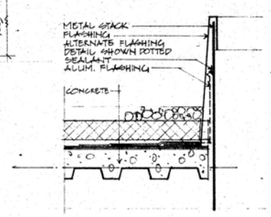


6 20 PIPE FLASHING

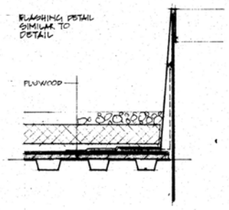


7 20 PIPE FLASHING

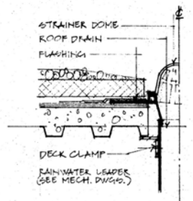


8 8/20 ROOF DRAIN
ROOF WITHOUT CONCRETE SIMILAR

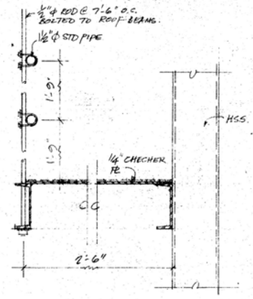


9 14/20 CAT WALK — COUNCIL CHAMBER

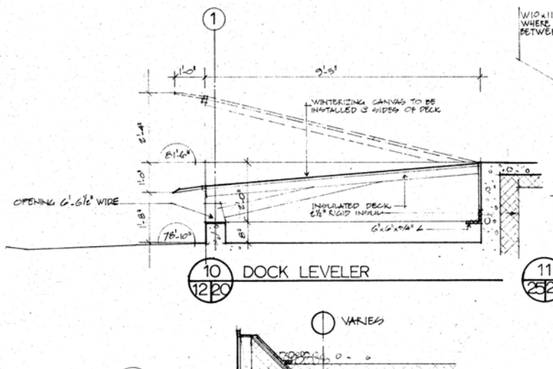


10 12/20 DOCK LEVELER

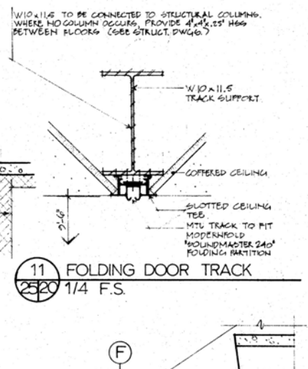


11 25/20 FOLDING DOOR TRACK
1/4 F.S.

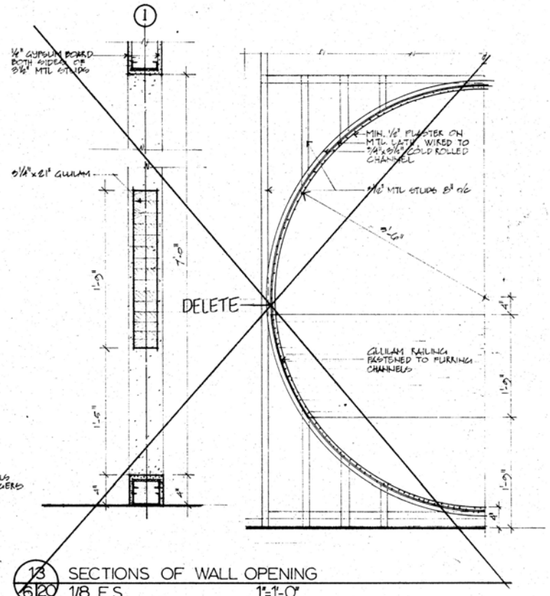


13 6/20 SECTIONS OF WALL OPENING
1/8 F.S. 1"=1'-0"

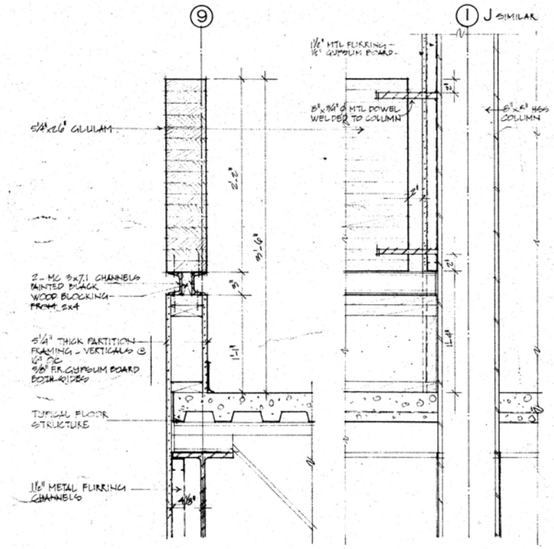


14 14/20 RAILING AT LIBRARY / LOUNGE

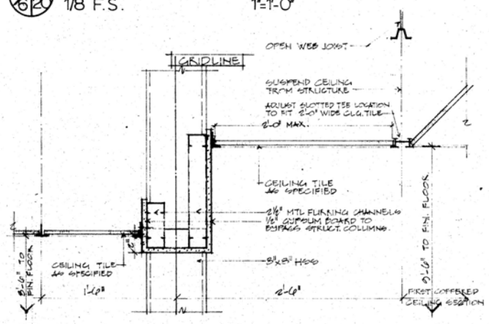


15 11/20 TYPICAL CEILING TRANSITION

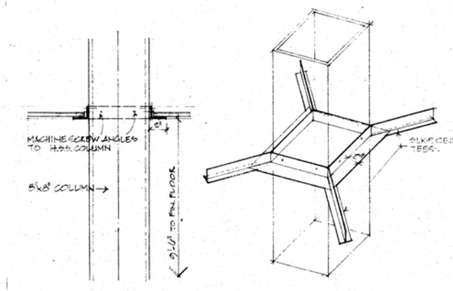


16 25/20 SECTION AND ISOMETRIC OF CEILING CONNECTION TO TYPICAL COLUMN

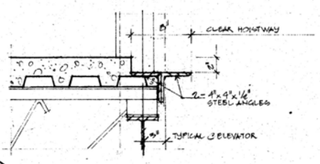


2 5/20 TYPICAL SILL DETAIL

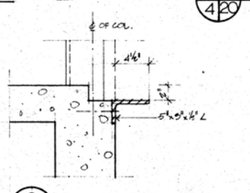


3 5/20 SILL AT LEVEL 1 FLOOR

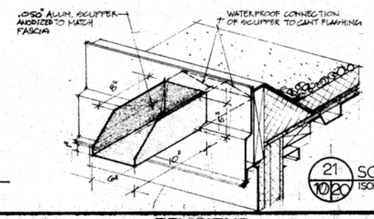


21 10/20 SCUPPER ISOMETRIC

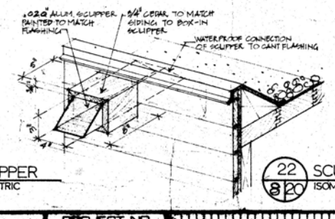


22 8/20 SCUPPER AT CANOPY ISOMETRIC

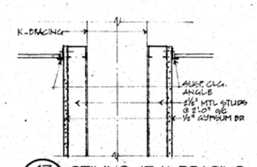

17 26/20 CEILING AT K-BRACING

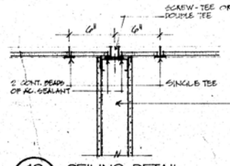

18 26/20 CEILING DETAIL

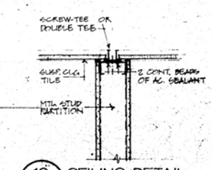


19 25/20 CEILING DETAIL

REVISIONS
DESCRIPTION


PROJECT NO.

DRAWING TITLE


DRAWING NO.

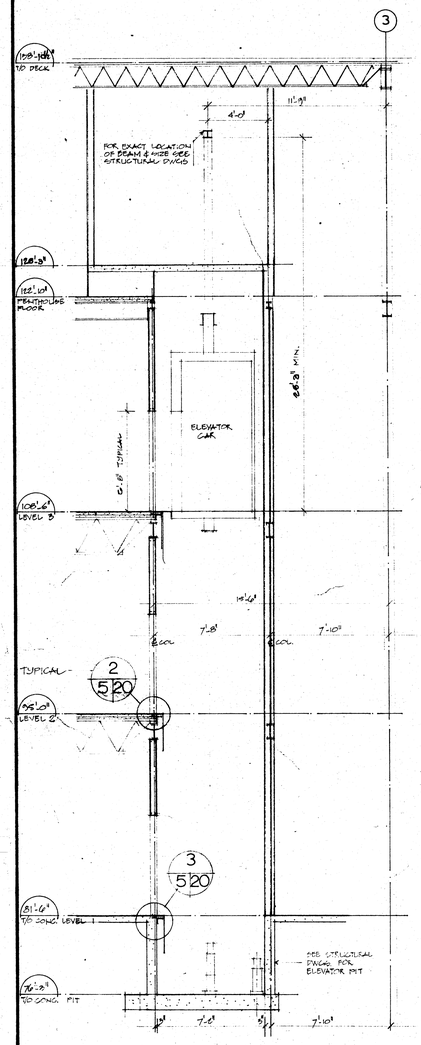


1 SECTION THRO' ELEVATOR SHAFT
5 20
1/4" = 1'-0"

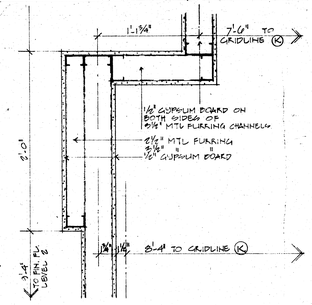


4 WALL TRANSITION AT EAST SIDE
6 20 OF STAIR No. 8

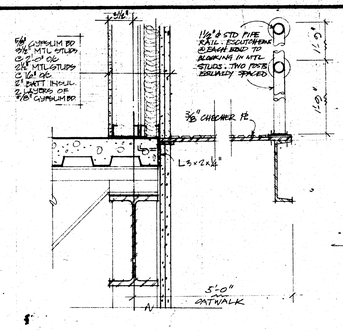


5 TYPICAL MECHANICAL SHAFT
12 20 AT FLOOR LEVEL

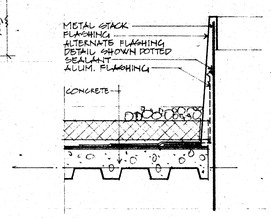


6 PIPE FLASHING
20

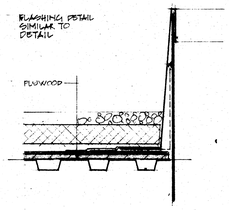


7 PIPE FLASHING
20

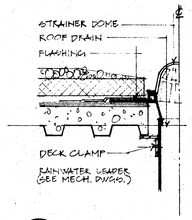


8 ROOF DRAIN
8 20 ROOF WITHOUT CONCRETE SIMILAR

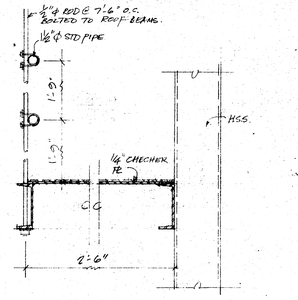


9 CAT WALK — COUNCIL CHAMBER
14 20

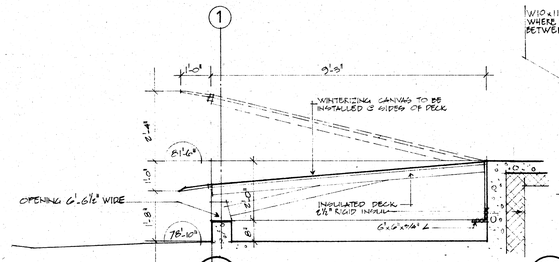


10 DOCK LEVELER
12 20

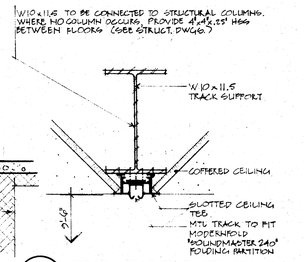


11 FOLDING DOOR TRACK
25 20 1/4 F.S.

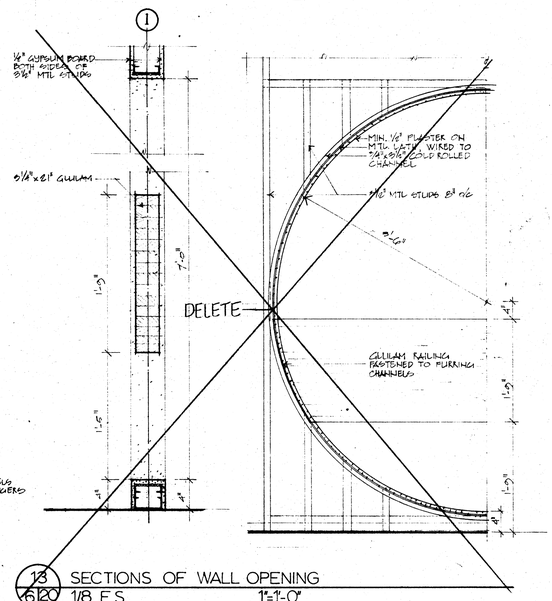


13 SECTIONS OF WALL OPENING
6 20 1/8 F.S. 1" = 1'-0"

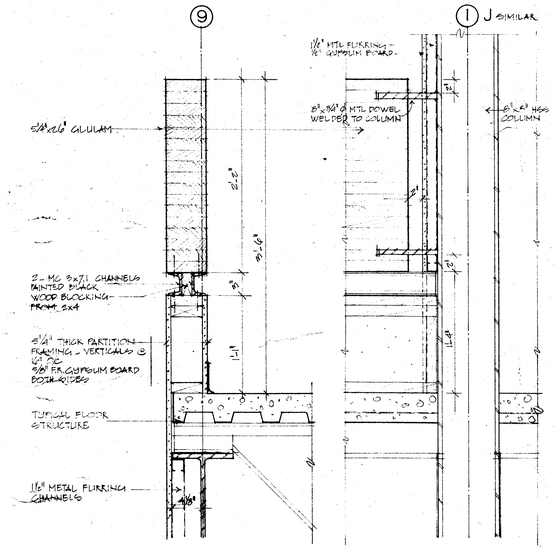


14 RAILING AT LIBRARY / LOUNGE
14 20

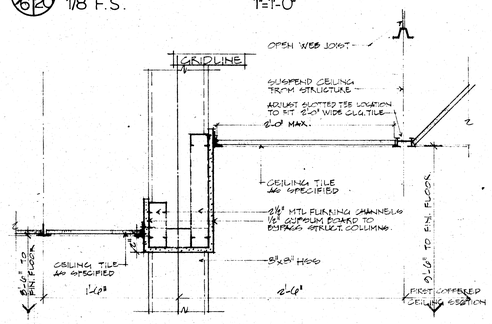


15 TYPICAL CEILING TRANSITION
11 20

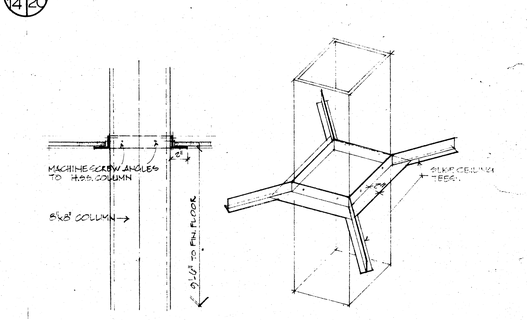


16 SECTION AND ISOMETRIC OF CEILING CONNECTION TO TYPICAL COLUMN
25 20

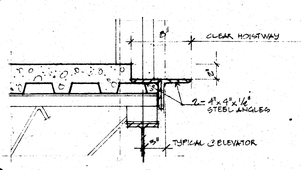


2 TYPICAL SILL DETAIL
5 20

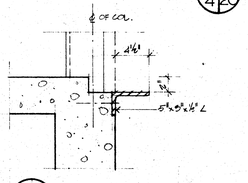


3 SILL AT LEVEL 1 FLOOR
5 20

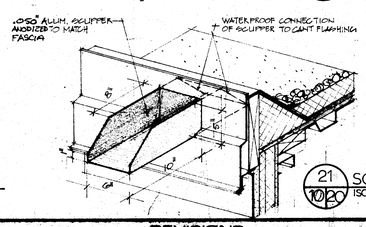


21 SCUPPER
10 20 ISOMETRIC

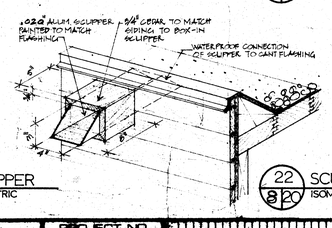


22 SCUPPER AT CANOPY
8 20 ISOMETRIC

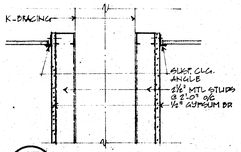

17 CEILING AT K-BRACING
28 20

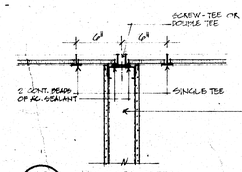

18 CEILING DETAIL
28 20

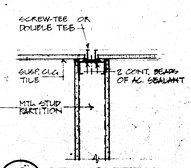


19 CEILING DETAIL
25 20

REVISIONS
NO. DESCRIPTION


PROJECT NO.

DRAWING TITLE


DRAWING NO.

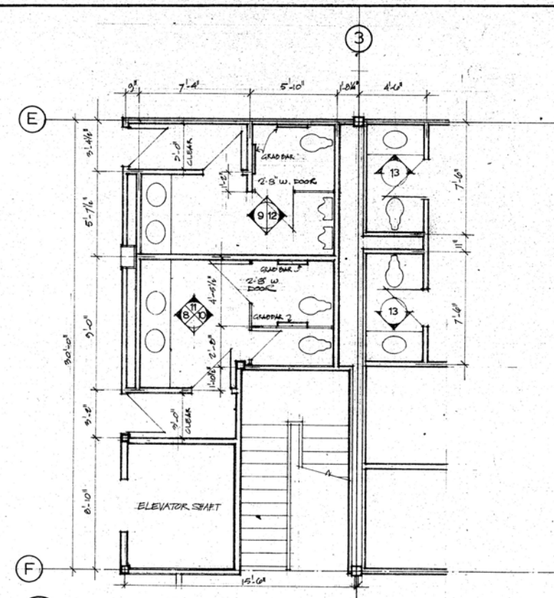


1/5/23 PUBLIC WASHROOMS AND STAFF WASHROOMS - LEVEL 1
9, 5/23 PUBLIC WASHROOMS - LEVEL 3

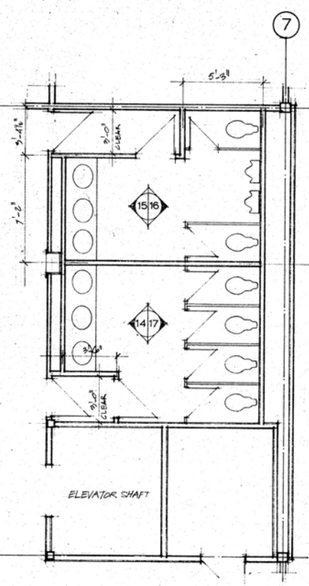


3/5/23 PUBLIC WASHROOMS - LEVEL 1

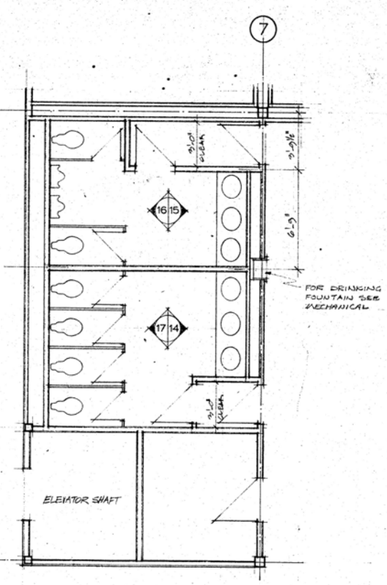


4/9, 7/23 PUBLIC WASHROOMS - LEVEL 2 AND 3

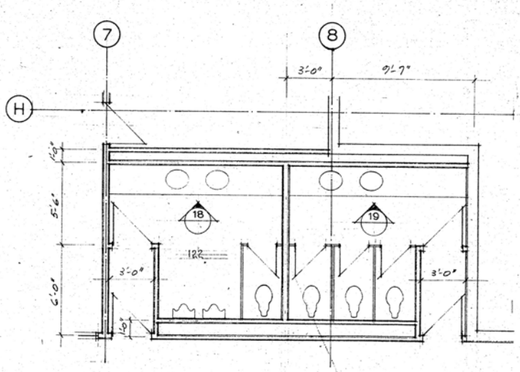


5/5/23 WASHROOMS IN COUNCIL BLOCK - LEVEL 1

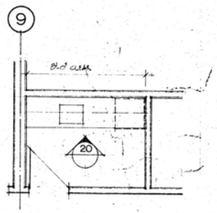


6/4/23 KITCHEN - ROOM No 135

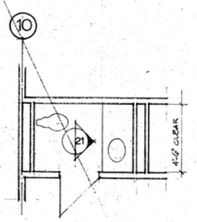

7/6/23 WASHROOM No 223

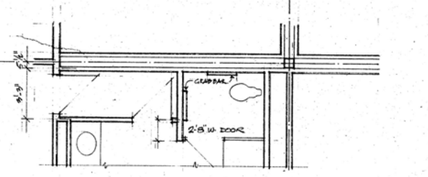


2/7/23 EAST PART MENS' WASHR'M - LEVEL 2
REMAINDER OF WASHROOMS SIMILAR TO PLAN No 1

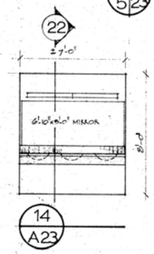


14/A23




15/A23

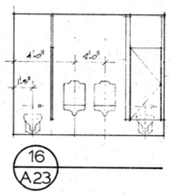


16/A23

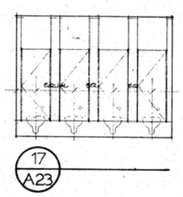


17/A23

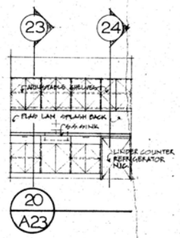


20/A23

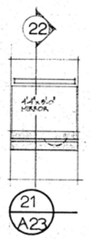


21/A23

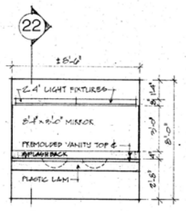


8/A23

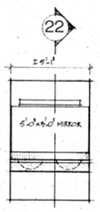


9/A23

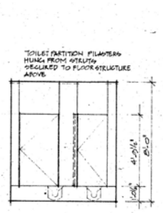


10/A23

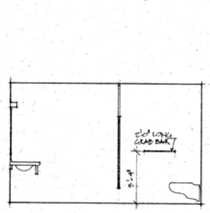


11/A23

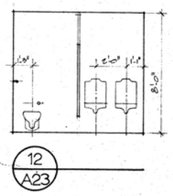


12/A23

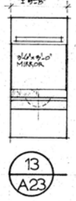


13/A23

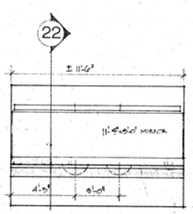

18/A23

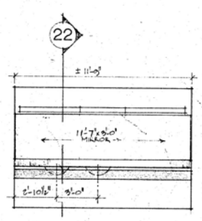


19/A23

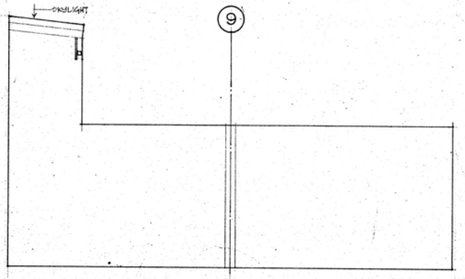


25/6/23 EAST WALL CONFERENCE ROOM No 221


NOTE : MIRRORS SHOWN MAY BE BROKEN INTO SMALLER WIDTHS OF EQUAL SIZE ~ ALL BUTTED TIGHTLY TOGETHER. MOUNT WITH SETH-CANCEALED CLIPS AND DOUBLE SIDED TAPE

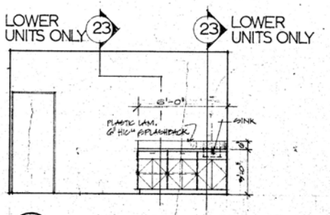


26/7/23 FIRST AID ROOM No 238

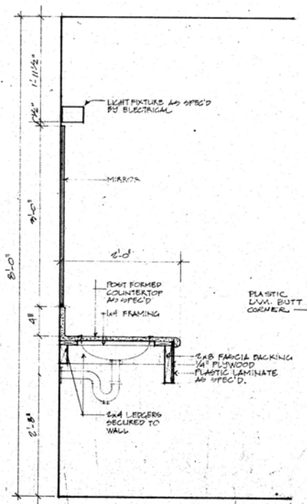

22/A23 TYPICAL VANITY
SCALE 1" = 1'-0"

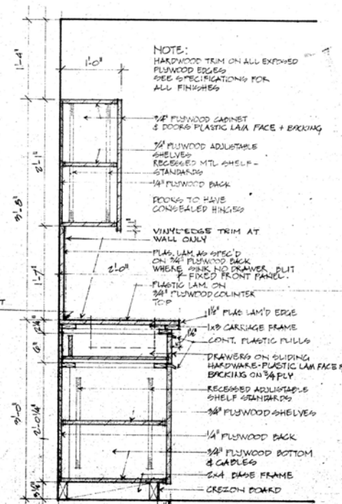

23/A23 SECTION OF KITCHEN UNIT
SCALE 1" = 1'-0"

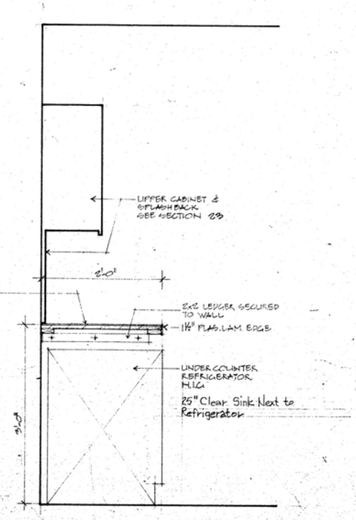

24/A23 KITCHEN COUNTER
SCALE 1" = 1'-0"


REVISIONS		
NO.	DATE	DESCRIPTION
A	7/10/84	Revised to 'As Builts'

PROJECT NO. 84-867
DATE
SCALE
DRAWN CHECK R.H.F.
APPROVED


GOVERNMENT OF THE YUKON TERRITORY

DRAWING TITLE
TERRITORIAL ADMINISTRATION BUILDING
WHITEHORSE, Y. T.


DRAWING NO. A 23

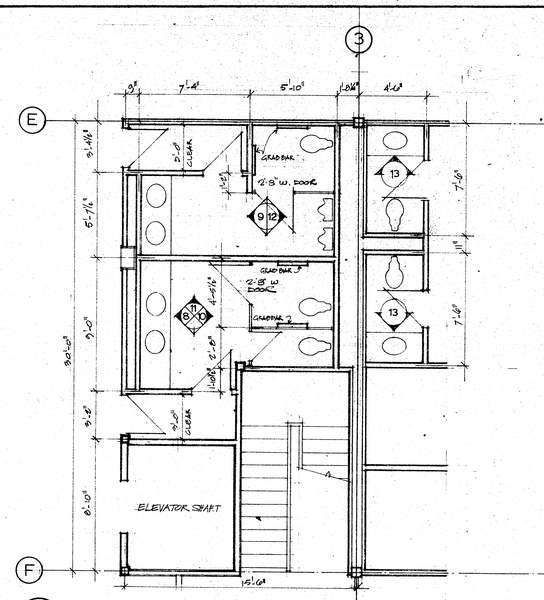


1 / 9,5,23 PUBLIC WASHROOMS AND STAFF WASHROOMS - LEVEL 1
PUBLIC WASHROOMS - LEVEL 3

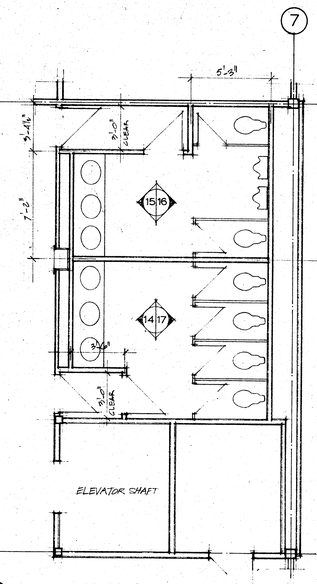


3 / 5,23 PUBLIC WASHROOMS - LEVEL 1

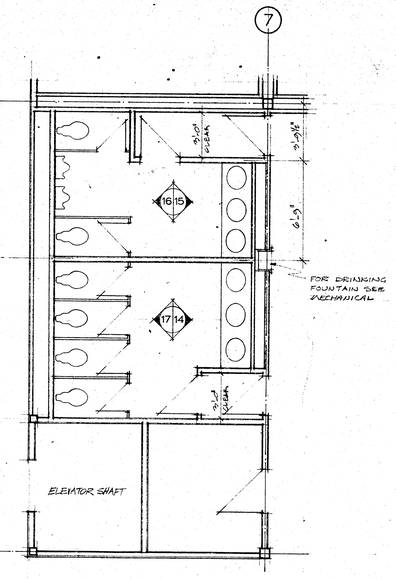

4 / 9,7,23 PUBLIC WASHROOMS - LEVEL 2 AND 3

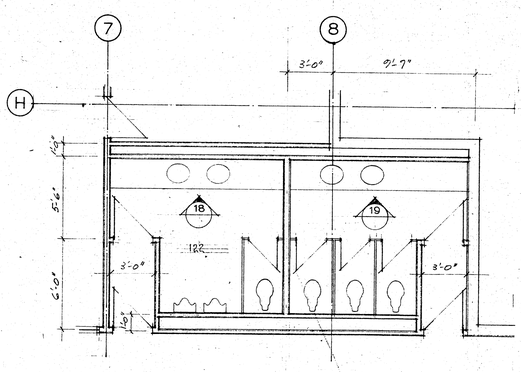

5 / 5,23 WASHROOMS IN COUNCIL BLOCK - LEVEL 1

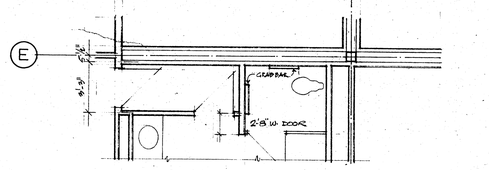


2 / 7,23 EAST PART MENS' WASHR'M - LEVEL 2
REMAINDER OF WASHROOMS SIMILAR TO PLAN No 1




14 / A23




15 / A23

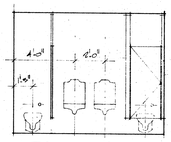


16 / A23

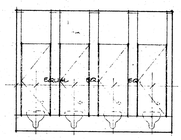


17 / A23

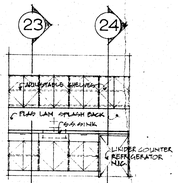


20 / A23

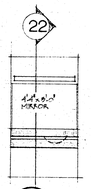


21 / A23

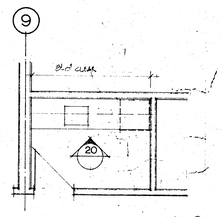

6 / 4,23 KITCHEN - ROOM No 135

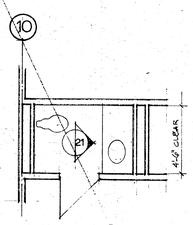


7 / 6,23 WASHROOM No 223

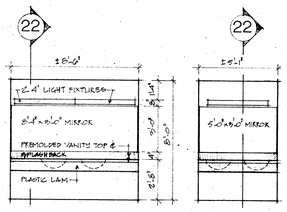


8 / A23


9 / A23

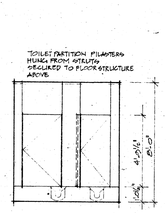


10 / A23

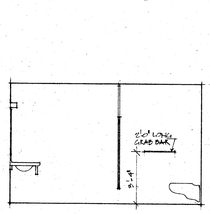


11 / A23

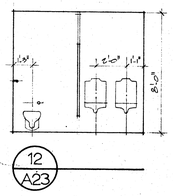


12 / A23

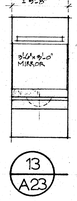


13 / A23

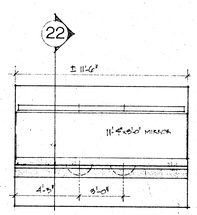

18 / A23

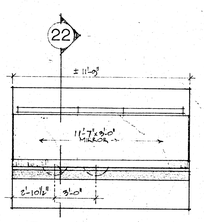


19 / A23

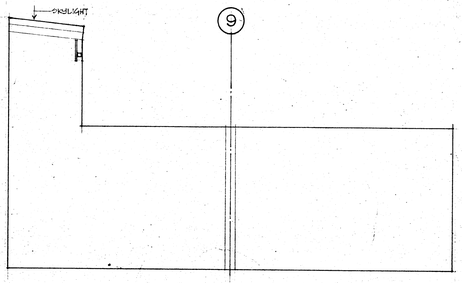


25 / 6,23 EAST WALL CONFERENCE ROOM No 221


NOTE : MIRRORS SHOWN MAY BE BROKEN INTO SMALLER WIDTHS OF EQUAL SIZE ~ ALL BUTTED TIGHTLY TOGETHER
MOUNT WITH SEMI - CONCEALED CLIPS AND DOUBLE SIDED TAPE

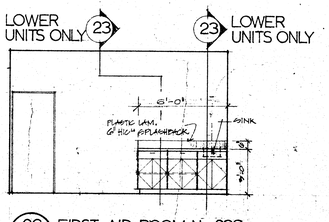


26 / 7,23 FIRST AID ROOM No 238

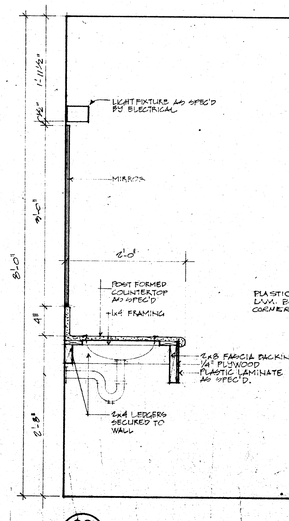

22 / A23 TYPICAL VANITY
SCALE 1" = 1'-0"

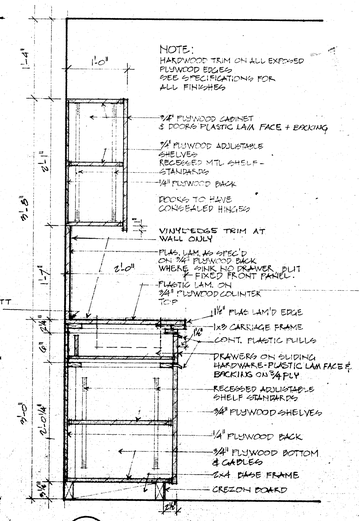

23 / A23 SECTION OF KITCHEN UNIT
SCALE 1" = 1'-0"

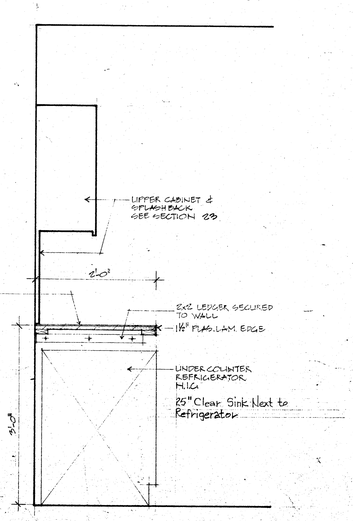

24 / A23 KITCHEN COUNTER
SCALE 1" = 1'-0"

REVISIONS		
NO.	DATE	DESCRIPTION
A	1991/10/02	Revised to "As Builts"

PROJECT NO. 89-867
DATE
SCALE 1/4" = 1'-0"
DRAWN CHECK R.H.F.
APPROVED

GOVERNMENT OF THE YUKON TERRITORY

DRAWING TITLE
TERRITORIAL ADMINISTRATION BUILDING
WHITEHORSE, Y.T.

DRAWING NO. A-10

0098

1 2 3 4 5 6 7 8 9 10

30'-0" 30'-0" 30'-0" 30'-0" 240'-0" 30'-0" 30'-0" 15'-0" 15'-0" 30'-0"

A B C D E F

150'-0" 30'-0" 30'-0" 30'-0" 30'-0"

STL. DECK

CONCRETE

GYPSUM BOARD

GYPROC

SUSP. CEILING SYSTEM

17
26/20

A B

FOR CONTINUATION SEE DWG. A-25

NOTE: REFER TO DWG. A-25 FOR LEGEND

N

KEY PLAN

Public Works Canada Travaux publics Canada
Pacific Region

REVISIONS

NO.	DATE	DESCRIPTION
A	SEPT/74	SHADED AREAS (R10 INSULATION) ABOVE CEILING DELETED.
B	MAY/75	CHANGE OF CEILING DUE TO PARTITION RELOCATIONS
C	98/10/06	Revised to 'As Builts'

PROJECT NO. 80857

DATE APRIL 1974 | SCALE 1/8"=1'-0"

DRAWN R/S. | CHECK

APPROVED

GOVERNMENT OF THE YUKON TERRITORY

DRAWING TITLE
REFLECTED CEILING PLAN LEVEL 1 EAST

PROJECT TITLE
TERRITORIAL ADMINISTRATION BUILDING
WHITEHORSE, Y.T.

DRAWING NO.
A 26
A

ROOM No.	ROOM NAME	FLOOR	NORTH WALL MAT.	NORTH WALL FIN.	EAST WALL MAT.	EAST WALL FIN.	SOUTH WALL MAT.	SOUTH WALL FIN.	WEST WALL MAT.	WEST WALL FIN.	CEILING MAT.	CEILING FIN.	CEILING HT.	REMARKS
101	CORRIDOR	R.F.	G.B.	P.	G.B.	P.	G.B.	P.	G.B.	P.	AC.T.	—	8'6"	
102	VESTIBULE	R.F.	G.B.	P.	G.B.	P.	G.B.	P.	G.B.	P.	AC.T.	—	8'-6"	
103	TOURISM STOR.#1	R.F.	CONC.	—	G.B.	—	G.B.	—	G.B. CONC.	—	EXPOSED ST. JOISTS + DECK	P.	—	
104	VESTIBULE	R.F.	G.B.	P.	G.B.	P.	G.B.	P.	G.B.	P.	G.B.	P.	8'6"	
105	LUNCH RM.	R.F.	G.B.	P.	G.B.	P.	G.B.	P.	GLAZING	—	AC.T.	—	9'6"	
106	CORRDOR	R.F.	OPEN	-	G.B.	P.	G.B.	P.	G.B.	P.	ACT.	—	9'6"	
107	CONFERENCE	R.F.	G.B.	P	G.B.	P.	G.B.	P.	G.B.	P.	AC.T.	—	9'6"	CHANGE ORDER 30. SUPPLY AND INSTALL CARPET IN LIEU OF VINYL ASBESTO TILE.
108	MALL	Q.T.	G.B.	P.	G.B.	P.	G.B. GLAZING	P —	G.B.	P.	WD.	C.W.S.	9'6"	WOOD FASCIA ON SOUTH WALL - C.W.S.
109	FOYER	Q.T.	G.B.	P	G.B.	P.	G.B. GLAZING	P. —	G.B.	P.	WD.	C.W.S.	9'6"	CONT. WOOD FASCIA - C.W.S.
110	EXHIBIT	R.F.	G.B.	P.	G.B.	P.	G.B.	P.	G.B.	P.	AC. T.	-	9'6"	
111	VESTIBULE	[illegible] R.F.	GLAZING	-	G.B.	P.	GLAZING	—	G.B.	P.	WD	C.W.S.	7'11"	CONT. WOOD FASCIA - C.W.S. CHANGE ORDER 17, QUARRY TILING TO FLOOR
112	VHF	CPT.	G.B.	P.	G.B.	P.	G.B.	P.	G.B.	P.	AC.T.	—	8'-0"	
113	TYPING	CPT	G.B.	P.	G.B.	P.	G.B.	P.	G.B.	P.	AC.T.	—	8'-0"	
114	TYPING	CPT.	G.B.	P.	G.B.	P.	G.B.	P.	G.B.	P.	ACT.	—	8'-0"	
115	TYPING	CPT.	G.B.	P.	G.B.	P.	G.B.	P.	G.B.	P.	AC.T.	-	8'-0"	
116	TYPING	CPT.	G.B.	P.	G.B.	P.	G.B.	P	G.B	P.	AC.T.	—	8'-0"	
117	CORRIDOR	CPT	G.B.	P.	G.B.	P.	G.B.	P.	OPEN	—	AC.T.	—	8'-0"	
118	TRANSCRIBING	CPT.	G.B.	P.	G.B.	P.	G.B.	P.	G.B.	P	AC.T.	—	8'-0"	
119	FOYER	CPT.	G.B.	P.	GLAZING	—	G.B.	P.	G.B.	P.	WD.	C.W.S.	7'0"	CHANGE ORDER 17, QUARRY TILING TO FLOOR
120	ANTEROOM	CPT	G.B.	P.	G.B.	P.	G.B.	P.	G.B.	P.	AC.T.	—	8'-0"	
121	VESTIBULE	C.T.	G.B.	P.	G.B.	P.	G.B.	P.	G.B.	P.	G.B.	P.	8'-0"	
122	MEN'S WASHRM.	C.T.	C.T.	-	C.T.	—	C.T.	—	C.T.	—	G.B.	P.	8'-0"	
123	WOMENS W.R.	C.T.	C.T.	—	C.T.	—	C.T.	—	C.T.	—	G.B.	P.	8'-0"	
124	VESTIBULE	C.T.	G.B.	P.	G.B.	P.	G.B.	P.	G.B.	P.	G.B.	P.	8'0"	
125	CORRIDOR	CPT.	OPEN	—	G.B.	P.	OPEN	—	G.B.	P.	AC.T.	—	7'0"	
126	MECHANICAL	CONC. ST.	CONC. B.	-	CONC. B.	—	CONC. B.	—	CONC. B.	—	EXPOSED S. JOISTS + DECK	P.	—	
127	STORAGE	CON. ST.	CONC.	—	G.B.	P.	G.B.	P.	EXPOSED STRUCT.	—	EXPOSED WD. JOISTS	—	VARIES	
128	STORAGE	CONC. S.T.	G.B.	P	G.B.	P.	G.B.	P.	EXPOSED STRUCT.	—	EXPOSED WD. JOISTS	—	VARIES	
129	CORRIDOR	CPT.	CPT.	—	WOOD DOOR	S.	CPT.	—	OPEN	—	WD.	S.	7'0"	
130	COUNCIL CHAMBER	CPT.	G.B. CPT.	P. —	CPT.	—	G.B. CPT.	P —	G.B. CPT.	P. —	WD.	C.W.S.	VARIES	CPT. FLOOR EXTEND OVER BUILT-IN DESKS - SEE DETAILS SHEET A-22 LAMINATED WOOD RAIL - STAINED
131	LOUNGE	CPT.	G.B.	P.	G.B.	P.	G.B.	P.	G.B.	P.	WD.	C.W.S.	VARIES	
132	CAUCUS	CPT.	G.B.	P.	G.B.	P.	G.B.	P.	G.B.	P.	AC.T.	-	8'-0"	
133	OPP. LEADER	CPT.	G.B.	P.	G.B.	P.	G.B.	P.	G.B.	P.	AC. T.	—	8'-0"	
134	SPEAKER	CPT.	G.B.	P.	G.B.	P.	G.B.	P.	G.B.	P.	AC.T	—	8'-0"	
135	KITCHENETTE	R.F.	G.B.	P.	G.B.	P.	G.B.	P.	G.B.	P.	G.B.	P.	8'-0"	
136	STORAGE	R.F.	G.B.	P.	G.B.	P.	G.B.	P.	G.B.	P.	G.B.	P.	8'-0"	
137	JANITOR	CONC. S.T.	G.B.	P	G.B.	P.	G.B.	P.	G.B.	P.	G.B.	P.	7'-6"	
138	VESTIBULE	CPT.	G.B	P.	G.B.	P.	G.B.	P.	G.B.	P.	AC.T.	—	7'-6"	
139	CAUCUS	CPT.	G.B.	P.	G.B.	P.	G.B.	P.	G.B.	P.	AC.T.	—	8'-0"	
140	OFFICE AREA	CPT.	OPEN	—	G.B.	P.	G.B.	P.	G.B.	P.	AC. T.	—	9'-6"	
	STAIR # 8	CPT.	G.B.	P.	G.B.	P.	G.B.	P.	G.B.	P	G.B.	P.	9'-6"	STAIR SOFFIT : G.B. - P. @ 7'-6"
141	RECORDS	R.F.	G.B.	P.	G.B.	P.	G.B.	P.	G.B.	P.	EXPOSED S. JOISTS + DECK	P.	—	
142	GENERATOR	CONC. S.T.	G.B.	P.	G.B.	P.	G.B.	P.	G.B.	P	EXPOSED S. JOISTS + DECK	P.	—	
143	SPRINKLER	CONC. S.T.	G.B.	P.	G.B.	P	G.B.	P.	G.B.	P	EXPOSED S. JOISTS + DECK	P.	—	
144	ELECTRICAL	CONC. S.T.	G.B.	P.	G.B.	P	G.B.	P.	G.B.	P.	EXPOSED S. JOISTS + DECK	P.	—	
145	VESTIBULE	CONC. ST.	G.B.	P.	G.B.	P.	G.B.	P	G.B.	P.	G.B.	P.	8'-0"	
146	VAULT	R.F.	CONC. B	-	CONC. B.	—	CONC. B.	—	CONC. B.	—	CONC.	P.	8'-3"	
147	TELEPHONE	CONC. ST.	G.B.	P.	G.B.	P.	G.B.	P.	G.B.	P.	EXPOSED S. JOISTS + DECK	P.	—	
148	PURCHASING	CPT.	G.B.	P.	G.B.	P	OPEN	—	G.B.	P.	AC.T.	—	9'6"	CEILING HT. BETWEEN GRIDLINES 'D' & 'E' : 8'-6"
149	LOADING BAY	CONC. S.T.	G.B.	P.	G.B.	P.	G.B.	P.	G.B.	P.	EXPOSED* JOISTS + DECK	P.	—	*INSULATION?
150	MAIL	R.F.	G.B.	P.	G.B.	P.	G.B.	P.	G.B.	P.	AC.T.	—	9'-6"	
152	ELEVATOR LOBBY	R.F.	G.B.	P.	OPEN	-	G.B.	P.	OPEN	-	AC.T.	—	8'-6"	
153	FOYER	R.F.	G.B.	P.	G.B.	P.	G.B.	P.	G.B.	P.	AC.T.	-	8'-6"	
154	CORRIDOR	R.F.	OPEN	-	G.B.	P.	OPEN	—	G.B.	P.	AC.T.	-	8'-6"	
155	VESTIBULE	C.T.	G.B.	P.	G.B.	P.	G.B.	P.	G.B.	P.	G.B.	P.	8'-0"	
156	MEN'S WASHRM.	C.T.	C.T.	—	C.T.	—	C.T.	—	C.T.	—	G.B.	P.	8'-0"	
157	WOMEN'S WASHRM.	C.T.	C.T.	—.	C.T.	—	C.T.	—	C.T.	—.	G.B.	P.	8'-0"	
158	VESTIBULE	C.T.	G.B.	P.	G.B.	P.	G.B.	P.	G.B.	P	G.B.	P.	8'-0"	
159	M. STAFF WASHRM.	R.F.	C.T.	—	C.T.	—	C.T.	—	C.T.	—	G.B.	P.	8'-0"	
160	STAFF ROOM	R.F.	G.B.	P.	G.B.	P.	G.B.	P.	G.B.	P.	AC.T.	—	9'-6"	
161	W. STAFF WASHRM.	R.F	C.T.	—	C.T.	—	C.T.	—	C.T.	—	G.B.	P.	8'-0"	
162	COLD STORAGE	C.T.	G.B.	P.	G.B.	P.	G.B.	P.	G.B.	P.	G.B.	P.	8'-0"	
168	DRY STORAGE	CONC. S.T.	G.B.	P.	G.B.	P.	G.B.	P.	G.B	P.	G.B.	P.	8'-0"	
164	TOURISM STOR. #2	CONC. S.T.	G.B.	P.	G.B.	P.	G.B.	P	G.B.	P.	EXPOSED S. JOISTS + DECK	P.	—	
165	KITCHEN	R.F.	G.B.	P.	G.B.	P.	G.B.	P.	G.B.	P.	G.B.	P.	9'6"	CHANGE ORDER 17. CERAMIC TILES TO EAST AND SOUTH WALL
166	QUEEN'S PRINTER	CONC. S.T.	G.B.	P.	G.B.	P.	G.B.	P.	G.B.	P	AC.T.	—	9'-6"	CHANGE ORDER 28 ADDITIONAL RESILIENT FLOOR TILING IN QUEEN'S PRINTER ROOM, JANITOR, BOTTOM, SECOND AND THIRD FLOOR, PENTHOUSE AND C.N.T. T.M.
167	CORRECTIONS	CPT.	OPEN	—	G.B.	P.	G.B.	P.	G.B.	P.	AC.T.	—	9'-6"	CEILING HT. BETWEEN GRIDLINES 'D' & 'E' : 8'-6"
168	DARK ROOM	C.T.	G.B.	P	G.B.	P.	G.B.	P.	G.B.	P.	AC.T.	—	9'6"	
169	RECORDS	CPT.	G.B.	P.	G.B.	P.	G.B.	P.	G.B	P.	AC.T.	—	8'-6"	
170	VESTIBULE	C.T.	G.B.	P.	G.B.	P.	G.B.	P.	G.B.	P.	G.B.	P	8'-0"	
171	MEN'S WASHRM.	C.T.	C.T.	—	C.T.	—	C.T.	—	C.T.	—	G.B.	P.	8'-0"	
172	WOMEN'S WASHRM.	C.T.	C.T.	—	C.T	—	C.T.	—	C.T.	—	G.B.	P.	8'-0"	

LEGEND

AC.T — ACOUSTIC TILE
C.T. — CERAMIC TILE
CONC. — CONCRETE
CONC. B. — CONCRETE BLOCK
CONC. S.T. — CONCRETE STEEL TROWELLED (WITH HARDE
CPT. — CARPET (N.I.C.)
C.W.S. — STAIN & FIRE RETARDANT
G.B. — GYPSUM BOARD
P. — PAINT
Q.T — QUARRY TILE
R.F — RESILIENT FLOORING
S. — STEEL
WD. — WOOD

NO. DATE REVISIONS DESCRIPTION
A 12/11/76 Revised to 'As Builts'

DATE DRAWN CHECK APPROVED
SCALE
PROJECT NO.

GOVERNMENT OF THE YUKON TERRITORY

FINISH SCHEDULE

PROJECT TITLE
TERRITORIAL ADMINISTRATION BUILDING
WHITEHORSE, Y.T.

DRAWING TITLE

DRAWING NO. A31

ROOM			NORTH WALL		EAST WALL		SOUTH WALL		WEST WALL		CEILING			
No.	NAME	FLOOR	MAT.	FIN.	MAT.	FIN.	MAT.	FIN.	MAT.	FIN.	MAT.	FIN.	HT.	REMARKS
101	CORRIDOR	R.F.	G.B.	P.	G.B.	P.	G.B.	P.	G.B.	P.	AC.T.	—	8'-6"	
102	VESTIBULE	R.F.	G.B.	P.	G.B.	P.	G.B.	P.	G.B.	P.	AC.T.	—	8'-6"	
103	TOURISM STOR.#1	R.F.	CONC	—	G.B.	—	G.B.	—	G.B. CONC.	—	EXPOSED ST. JOISTS + DECK	P.	—	
104	VESTIBULE	R.F.	G.B.	P.	G.B.	P.	G.B.	P.	G.B.	P.	G.B.	P.	8'-6"	
105	LUNCH RM.	R.F.	G.B.	P.	G.B.	P.	G.B.	P.	GLAZING	—	AC.T.	—	9'-6"	
106	CORRIDOR	R.F.	OPEN	—	G.B.	P.	G.B.	P.	G.B.	P.	ACT.	—	9'-6"	
107	CONFERENCE	R.F.	G.B.	P.	G.B.	P.	G.B.	P.	G.B.	P.	AC.T.	—	9'6"	CHANGE ORDER 30 SUPPLY AND INSTALL CARPET IN LIEU OF VINYL ASBESTO TILE.
108	MALL	Q.T.	G.B.	P.	G.B.	P.	G.B. GLAZING	P —	G.B.	P.	WD.	C.W.S.	9'-6"	WOOD FASCIA ON SOUTH WALL - C.W.S.
109	FOYER	Q.T.	G.B.	P.	G.B.	P.	G.B. GLAZING	P. —	G.B.	P.	WD.	C.W.S.	9'-6"	CONT. WOOD FASCIA - C.W.S.
110	EXHIBIT	R.F.	G.B.	P.	G.B.	P.	G.B.	P.	G.B.	P.	AC.T.	-	9'-6"	
111	VESTIBULE	CONC. S.T.	GLAZING	-	G.B.	P.	GLAZING	—	G.B.	P.	WD	C.W.S.	7'-11"	CONT. WOOD FASCIA - C.W.S. CHANGE ORDER 17, QUARRY TILING TO FLOOR
112	VHF	CPT.	G.B.	P.	G.B.	P.	G.B.	P.	G.B.	P.	AC.T.	—	8'-0"	
113	TYPING	CPT	G.B.	P.	G.B.	P.	G.B.	P.	G.B.	P.	AC.T.	—	8'-0"	
114	TYPING	CPT.	G.B.	P.	G.B.	P.	G.B.	P.	G.B.	P.	ACT.	—	8'-0"	
115	TYPING	CPT.	G.B.	P.	G.B.	P.	G.B.	P.	G.B.	P.	AC.T.	-	8'-0"	
116	TYPING	CPT.	G.B.	P.	G.B.	P.	G.B.	P	G.B.	P.	AC.T.	—	8'-0"	
117	CORRIDOR	CPT	G.B.	P.	G.B.	P.	G.B.	P.	OPEN	—	AC.T.	—	8'-0"	
118	TRANSCRIBING	CPT.	G.B.	P.	G.B.	P.	G.B.	P.	G.B.	P	AC.T.	—	8'-0"	
119	FOYER	CPT.	G.B.	P.	GLAZING	—	G.B.	P.	G.B.	P.	WD.	C.W.S.	7'0"	CHANGE ORDER 17, QUARRY TILING TO FLOOR
120	ANTEROOM	CPT	G.B.	P.	G.B.	P.	G.B.	P.	G.B.	P.	AC.T.	—	8'-0"	
121	VESTIBULE	C.T.	G.B.	P.	G.B.	P.	G.B.	P.	G.B.	P.	G.B.	P.	8'-0"	
122	MEN'S WASHRM	C.T.	C.T.	-	C.T.	—	C.T.	—	C.T.	—	G.B.	P.	8'-0"	
123	WOMENS W.R.	C.T.	C.T.	—	C.T.	—	C.T.	—	C.T.	—	G.B.	P.	8'-0"	
124	VESTIBULE	C.T.	G.B.	P.	G.B.	P.	G.B.	P.	G.B.	P.	G.B.	P.	8'-0"	
125	CORRIDOR	CPT.	OPEN	—	G.B.	P.	OPEN	—	G.B.	P.	AC.T.	—	7'-0"	
126	MECHANICAL	CONC. ST	CONC. B.	—	CONC. B.	—	CONC. B.	—	CONC. B.	—	EXPOSED S. JOISTS + DECK	P.	—	
127	STORAGE	CON. ST.	CONC.	—	G.B.	P.	G.B.	P.	EXPOSED STRUCT.	—	EXPOSED W.JOISTS	—	VARIES	
128	STORAGE	CONC. S.T.	G.B.	P	G.B.	P.	G.B.	P.	EXPOSED STRUCT.	—	EXPOSED W.JOISTS	—	VARIES	
129	CORRIDOR	CPT.	CPT.	—	WOOD DOOR	S.	CPT.	—	OPEN	—	WD.	S.	7'0"	
130	COUNCIL CHAMBER	CPT.	G.B. CPT.	P. —	CPT.	—	G.B. CPT.	P —	G.B. CPT.	P. —	WD.	C.W.S.	VARIES	CPT. FLOOR EXTEND OVER BUILT-IN DESKS - SEE DETAILS SHEET A-22 LAMINATED WOOD RAIL - STAINED
131	LOUNGE	CPT.	G.B.	P.	G.B.	P.	G.B.	P.	G.B.	P.	WD.	C.W.S.	VARIES	
132	CAUCUS	CPT.	G.B.	P.	G.B.	P.	G.B.	P.	G.B.	P.	AC.T.	-	8'-0"	
133	OPP. LEADER	CPT.	G.B.	P.	G.B.	P.	G.B.	P.	G.B.	P.	AC.T.	—	8'-0"	
134	SPEAKER	CPT.	G.B.	P.	G.B.	P.	G.B.	P.	G.B.	P.	AC.T	—	8'-0"	
135	KITCHENETTE	R.F.	G.B.	P.	G.B.	P.	G.B.	P.	G.B.	P.	G.B.	P.	8'-0"	
136	STORAGE	R.F.	G.B.	P.	G.B.	P.	G.B.	P.	G.B.	P.	G.B.	P.	8'-0"	
137	JANITOR	CONC. S.T.	G.B.	P	G.B.	P.	G.B.	P.	G.B.	P.	G.B.	P.	7'-6"	
138	VESTIBULE	CPT.	G.B	P.	G.B.	P.	G.B.	P.	G.B.	P.	AC.T.	—	7'-6"	
139	CAUCUS	CPT.	G.B.	P.	G.B.	P.	G.B.	P.	G.B.	P.	AC.T.	—	8'-0"	
140	OFFICE AREA	CPT.	OPEN	—	G.B.	P.	G.B.	P.	G.B.	P.	AC.T.	—	9'-6"	
	SINK #8	CPT.	G.B.	P.	G.B.	P.	G.B.	P.	G.B.	P	G.B.	P.	9'-6"	STAIR SOFFIT : G.B. - P. @ 7'-6"
141	RECORDS	R.F.	G.B.	P.	G.B.	P.	G.B.	P.	G.B.	P.	EXPOSED S. JOISTS + DECK	P.	—	
142	GENERATOR	CONC. S.T.	G.B.	P	G.B.	P.	G.B.	P.	G.B.	P	EXPOSED S. JOISTS + DECK	P.	—	
143	SPRINKLER	CONC. S.T.	G.B.	P.	G.B.	P	G.B.	P.	G.B.	P	EXPOSED S. JOISTS + DECK	P.	—	
144	ELECTRICAL	CONC. S.T.	G.B.	P	G.B.	P	G.B.	P.	G.B.	P.	EXPOSED S. JOISTS + DECK	P.	—	
145	VESTIBULE	CONC. ST	G.B.	P.	G.B.	P.	G.B.	P	G.B.	P.	G.B.	P.	8'-0"	
146	VAULT	R.F.	CONC. B	—	CONC. B.	—	CONC. B.	—	CONC. B.	—	CONC.	P.	8'-3"	
147	TELEPHONE	CONC. ST.	G.B.	P.	G.B.	P.	G.B.	P.	G.B.	P.	EXPOSED S. JOISTS + DECK	P.	—	
148	PURCHASING	CPT.	G.B.	P.	G.B.	P.	OPEN	—	G.B.	P.	AC.T.	—	9'6"	CEILING HT. BETWEEN GRIDLINES 'D' 'E' : 8'-6"
149	LOADING BAY	CONC. S.T.	G.B.	P.	G.B.	P.	G.B.	P.	G.B.	P.	EXPOSED* S. JOISTS + DECK	P.	—	*INSULATION?
150	MAIL	R.F.	G.B.	P.	G.B.	P.	G.B.	P.	G.B.	P.	AC.T.	—	9'-6"	
152	ELEVATOR LOBBY	R.F.	G.B.	P.	OPEN	—	G.B.	P.	OPEN	—	AC.T.	—	8'-6"	
153	FOYER	R.F.	G.B.	P.	G.B.	P.	G.B.	P.	G.B.	P.	AC.T.	—	8'-6"	
154	CORRIDOR	R.F.	OPEN	—	G.B.	P.	OPEN	—	G.B.	P.	AC.T.	—	8'-6"	
155	VESTIBULE	C.T.	G.B.	P.	G.B.	P.	G.B.	P.	G.B.	P.	G.B.	P.	8'-0"	
156	MEN'S WASHRM.	C.T.	C.T.	—	C.T.	—	C.T.	—	C.T.	—	G.B.	P.	8'-0"	
157	WOMEN'S WASHRM.	C.T.	C.T.	—.	C.T.	—	C.T.	—	C.T.	—.	G.B.	P.	8'-0"	
158	VESTIBULE	C.T.	G.B.	P.	G.B.	P.	G.B.	P.	G.B.	P	G.B.	P.	8'-0"	
159	M. STAFF WASHRM.	R.F.	C.T.	—	C.T.	—	C.T.	—	C.T.	—	GB.	P.	8'-0"	
160	STAFF ROOM	R.F.	G.B.	P.	G.B.	P.	G.B.	P.	G.B.	P.	AC.T.	—	9'-6"	
161	W. STAFF WASHRM.	R.F	C.T.	—	C.T.	—	C.T.	—	C.T.	—	G.B.	P.	8'-0"	
162	COLD STORAGE	C.T.	G.B.	P.	G.B.	P.	G.B.	P.	G.B.	P.	G.B.	P.	8'-0"	
168	DRY STORAGE	CONC. S.T.	G.B.	P.	G.B.	P.	G.B.	P.	G.B.	P.	G.B.	P.	8'-0"	
164	TOURISM STOR. #2	CONC. S.T.	G.B.	P.	G.B.	P.	G.B.	P	G.B.	P.	EXPOSED S. JOISTS + DECK	P.	—	
165	KITCHEN	R.F.	G.B.	P.	G.B.	P.	G.B.	P.	G.B.	P.	G.B.	P.	9'6"	CHANGE ORDER 17. CERAMIC TILES TO EAST AND SOUTH WALL
166	QUEEN'S PRINTER	CONC. S.T.	G.B.	P.	G.B.	P.	G.B.	P.	G.B.	P	AC.T.	—	9'-6"	CHANGE ORDER 28 ADDITIONAL RESILIENT FLOOR TILING IN QUEEN'S PRINTER ROOM, JANITOR, BOTTOM, SECOND AND THIRD FLOOR, PENTHOUSE AND C.N.T. RM.
167	CORRECTIONS	CPT.	OPEN	—	G.B.	P.	G.B.	P.	G.B.	P.	AC.T.	—	9'6"	CEILING HT. BETWEEN GRIDLINES 'D' 'E' : 8'-6"
168	DARK ROOM	C.T.	G.B.	P	G.B.	P.	G.B.	P.	G.B.	P.	AC.T.	—	9'6"	
169	RECORDS	CPT.	G.B.	P.	G.B.	P.	G.B.	P.	G.B.	P.	AC.T.	—	8'-6"	
170	VESTIBULE	C.T.	G.B.	P.	G.B.	P.	G.B.	P.	G.B.	P	G.B.	P	8'-0"	
171	MEN'S WASHRM.	C.T.	C.T.	—	C.T.	—	C.T.	—	C.T.	—	G.B.	P.	8'-0"	
172	WOMEN'S WASHRM.	C.T.	C.T.	—	C.T	—	C.T.	—	C.T.	—	G.B.	P.	8'-0"	

LEGEND

AC.T — ACOUSTIC TILE
C.T. — CERAMIC TILE
CONC. — CONCRETE
CONC. B. — CONCRETE BLOCK
CONC. S.T. — CONCRETE STEEL TROWELLED (WITH HARDE)
CPT. — CARPET (N.I.C.)
C.W.S. — STAIN & FIRE RETARDANT
G.B. — GYPSUM BOARD
P. — PAINT
Q.T. — QUARRY TILE
R.F — RESILIENT FLOORING
S. — STEEL
WD. — WOOD

REVISIONS

NO.	DATE	DESCRIPTION
A	11/1/96	Revised to Pro Edits

GOVERNMENT OF THE YUKON TERRITORY

PROJECT TITLE
TERRITORIAL ADMINISTRATION BUILDING
WHITEHORSE, Y.T.

DRAWING TITLE
FINISH SCHEDULE

PROJECT NO.
SCALE
DATE
DRAWN
CHECK
APPROVED

DRAWING NO.
A31

ROOM NO.	ROOM NAME	FLOOR	NORTH WALL MAT.	NORTH WALL FIN.	EAST WALL MAT.	EAST WALL FIN.	SOUTH WALL MAT.	SOUTH WALL FIN.	WEST WALL MAT.	WEST WALL FIN.	CEILING MAT.	CEILING FIN.	HT.	REMARKS
173	VESTIBULE	C.T.	G.B.	P.	G.B.	P.	G.B.	P.	G.B.	P.	G.B.	P.	8'-0"	
174	ELEVATOR LOBBY	Q.T.	G.B.	P.	GLAZING	—	G.B.	P.	OPEN	—	AC.T.	—	9'-6"	
175	JANITOR	CONC. S.T.	G.B.	P.	G.B.	P.	G.B.	P.	G.B.	P.	G.B.	P.	9'-6"	
176	TOURISM/GAMES	CPT.	G.B.	P.	G.B.	P.	G.B.	P.	G.B.	P.	AC.T.	P.	8'-6	WALL @ GRIDLINES 'E' - '9-10' : G.B. BOTH SIDES, P.
	STAIRS "1,"2,"3,"4,"6	CONC. S.T.	G.B.	P.	G.B.	P.	G.B.	P.	G.B.	P.	EXPOSED STEEL	P.	VARIES	FINISHES TYPICAL @ ALL LEVELS, EXCEPT STAIR "6 (G.B. - P. ON UNDERSIDE OF STAIR FLIGHTS & CPT. ON FLOOR, TREADS + RISERS.)
	STAIR "5	CPT.												LAMINATED WOOD RAIL, — STAINED UNDERSIDE OF STAIR FLIGHTS: - WOOD - C.W.S.
201	VESTIBULE	CONC. S.T.	GLAZING	—	G.B.	P.	GLAZING	—	G.B.	P.	WD.	C.W.S.	7'-11"	CONT. WOOD FASCIA - C.W.S., CHANGE ORDER 17, QUARRY TILING IN VESTIBULE 201 AND 204
202	MALL	Q.T.	GLAZING	—	G.B.	P.	GLAZING	—	G.B. GLAZING	P. —	WD.	C.W.S.	7'-11" VARIES	CONT. WOOD FASCIA - C.W.S., EXPOSED STEEL BEAM - P.
203	GALLERY	Q.T.	EXISTING WD.,	RE-STAIN	WD	MATCH EXISTING	WD GLAZING	MATCH EXISTING	EXISTING WD.	RE-STAIN	WD.	C.W.S.	9'-5½"	
204	VESTIBULE	CONC. S.T.	WD. GLAZING	C.W.S. —	WD GLAZING	C.W.S. —	WD. G.B.	C.W.S. P.	WD. GLAZING	C.W.S. —	WD.	C.W.S.	7'-11"	SEE CHANGE ORDER 17 ABOVE
205	PRESS RM.	CPT.	G.B.	P.	G.B.	P.	G.B.	P.	G.B.	P.	AC.T.	—	9'-6"	
206	FOYER	CPT.	G.B.	P.	G.B.	P.	G.B.	P.	G.B.	P.	WD.	C.W.S.	7'-0"	
207	MEN'S WASHRM.	C.T.	C.T.	—	C.T.	—	C.T.	—	C.T.	—	G.B.	P.	8'-0"	
208	WOMEN'S WASRM.	C.T.	C.T.	—	C.T.	—	C.T.	—	C.T.	—	G.B.	P.	8'-0"	
209	V.I.P.	CPT.	G.B.	P.	G.B.	P.	G.B.	P.	G.B.	P.	AC.T.	—	8'-0"	
210	PUBLIC GALLERY	CPT.	G.B.	P.	G.B.	P.	G.B.	P.	OPEN	—	WD	C.W.S.	VARIES	CPT. FLOOR EXTEND OVER BUILT-IN SEATING - SEE DETAIL SHEET A-22. LAMINATED WOOD RAIL - STAINED
211	STATISTICIAN	CPT	G.B.	P.	G.B.	P.	G.B.	P.	G.B.	P.	AC.T	—	8'-0"	
212	FINANCIAL ADVISOR	CPT.	G.B.	P.	G.B.	P.	G.B.	P.	G.B.	P.	AC.T.	—	8'-0"	
213	LEGAL ADVISOR	CPT.	G.B.	P.	G.B.	P.	G.B.	P.	G.B.	P	AC.T.	—	8'-0"	
214	STORAGE	R.F.	G.B.	P	G.B	P.	G.B.	P.	G.B.	P.	G.B.	P.	8'-0"	
215	COUNCILLOR 1	CPT.	G.B.	P.	G.B.	P.	G.B. GLAZING	P. —	G.B.	P.	AC.T.	—	8'-0"	PREFAB. HEATING UNIT COVERS — P.
216	COUNCILLOR 2	CPT.	G.B.	P.	G.B.	P.	G.B. GLAZING	P. —	G.B.	P.	AC.T.	—	8'-0"	DITTO
217	COUNCILLOR 3	CPT.	G.B.	P.	G.B.	P.	G.B. GLAZING	P. —	G.B.	P.	AC.T.	—	8'-0"	DITTO
218	COUNCILLOR 4	CPT.	G.B.	P.	G.B.	P.	G.B. GLAZING	P. —	G.B.	P.	AC.T.	—	8'-0"	DITTO
219	COUNCILLOR 5	CPT.	G.B.	P.	G.B.	P.	G.B. GLAZING	P. —	G.B.	P.	AC.T.	—	8'-0"	DITTO
220	OFFICE AREA	CPT.	OPEN		G.B.	P.	G.B.	P.	G.B.	P.	AC.T.	—	9'-6"	
221	CONFERENCE	CPT.	G.B.	P.	G.B.	P.	G.B.	P.	G.B.	P.	AC.T.	—	8'-0"	PREFAB. HEATING UNIT COVERS - P.
222	EX. COM. SECRETARY	CPT.	G.B.	P.	G.B.	P.	G.B.	P.	G.B.	P.	AC.T.	—	8'-0"	DITTO
223	WASHROOM	C.T.	C.T.	—	C.T.	—	C.T.	—	C.T.	—	G.B.	P.	8'-0"	
224	STORAGE	R.F.	G.B.	P.	G.B.	P.	G.B.	P.	G.B.	P.	G.B.	P.	8'-0"	
225	STORAGE	R.F.	G.B.	P.	G.B.	P.	G.B.	P.	G.B.	P.	G.B.	P.	8'-0"	PREFAB. HEATING UNIT COVERS — P.
226	COMMISSIONER	CPT.	G.B.	P.	G.B.	P.	G.B. GLAZING	P. —	G.B.	P.	AC.T.	—	8'-0"	DITTO
227	WELFARE	CPT.	G.B. GLAZING	P —	G.B. GLAZING	P. —	G.B. GLAZING	P. —	G.B.	P.	AC.T.	—	9'-6"	WALL @ GRIDLINES '2' - 'E' - G.B. BOTH SIDES - P. / PREFAB. HEATING UNIT COVERS - P. 8'-6" CEILING BETWEEN D & E
228	VAULT	R.F.	G.B.	P	G.B.	P	G.B.	P	G.B.	P	AC.T.	—	9'-6"	
229	VESTIBULE	C.T.	G.B.	P.	G.B.	P.	G.B.	P.	G.B.	P.	G.B.	P.	8'-0"	
230	MEN'S WASHROOM	C.T.	C.T.	—	C.T.	—	C.T.	—	C.T.	—	G.B.	P.	8'-0"	
231	WOMEN'S WASHRM.	C.T.	C.T.	—	C.T.	—	C.T.	—	C.T.	—	G.B.	P.	8'-0"	
232	VESTIBULE	C.T.	G.B.	P.	G.B.	P.	G.B.	P.	G.B.	P.	G.B.	P.	8'-0'	
233	HEALTH	CPT.	OPEN.	—	G.B. GLAZING	P. —	OPEN	—	G.B.	P.	AC.T.	—	9'-6"	WALL @ GRIDLINES '5' - 'E-F' - G.B. BOTH SIDES - P. / PREFAB. HEATING UNIT COVERS - P. *DITTO.
234	CONFERENCE	CPT.	G.B.	P.	G.B.	P.	G.B.	P.	G.B.	P.	AC.T.	—	9'-6"	
235	MEN'S WASHRM.	C.T.	C.T.	—	C.T.	—	C.T.	—	C.T.	—	G.B.	P.	8'-0"	
236	WOMEN'S WASHRM.	C.T.	C.T.	—	C.T.	—	C.T.	—	C.T.	—	G.B.	P.	8'-0"	
237	CORRIDOR	CPT.	G.B.	P.	G.B.	P.	G.B.	P.	OPEN	—	AST.	—	9'-6"	
238	FIRST AID	CPT.	G.B.	P.	G.B.	P.	G.B.	P.	G.B.	P.	AC.T.	—	9'-6"	
239	EDUCATION	CPT.	OPEN	—	G.B. GLAZING	P. —	G.B.	P.	G.B.	P.	AC.T.	—	9'-6"	PREFAB. HEATING UNIT COVERS — P. *DITTO.
240	VAULT	R.F.	G.B.	P.	G.B.	P.	G.B.	P.	G.B.	P.	AC.T.	—	8'-6"	
241	VESTIBULE	C.T.	G.B.	P.	G.B.	P.	G.B.	P.	G.B.	P.	G.B.	P.	8'-0"	
242	MEN'S WASHRM.	C.T.	C.T.	—	C.T.	—	C.T.	—	C.T.	—	G.B.	P.	8'-0"	
243	WOMEN'S WASHRM.	C.T.	C.T.	—	C.T.	—	C.T.	—	C.T.	—	G.B.	P.	8'-0"	
244	VESTIBULE	C.T.	G.B.	P.	G.B.	P.	G.B.	P.	G.B.	P.	G.B.	P.	8'-0"	
245	JANITOR	CONC. S.T.	G.B.	P	G.B.	P.	G.B.	P.	G.B.	P.	G.B.	P.	8'-0"	
246	TERR. SECRETARY	CPT.	G.B.	P.	G.B. GLAZING	P. —	G.B. GLAZING	P. —	OPEN	—	AC.T.	—	9'-6"	PREFAB. HEATING UNIT COVERS — P. *DITTO.

NO. DATE REVISIONS DESCRIPTION

A. 89/06/16 Revised to 'As Builts'

DATE SCALE

DRAWN CHECK

APPROVED

PROJECT NO

GOVERNMENT OF THE YUKON TERRITORY

Public Works Travaux publics Canada

FINISH SCHEDULE

PROJECT TITLE

TERRITORIAL ADMINISTRATION BUILDING WHITEHORSE, Y.T.

DRAWING TITLE

DRAWING NO. A 32

ROOM NO	ROOM NAME	FLOOR	NORTH WALL MAT.	NORTH WALL FIN.	WEST WALL MAT.	WEST WALL FIN.	SOUTH WALL MAT.	SOUTH WALL FIN.	EAST WALL MAT.	EAST WALL FIN.	CEILING MAT.	CEILING FIN.	HT.	REMARKS
301	LOCAL GOVERNMENT	CPT.	G.B. GLAZING	P. —	OPEN	—	G.B.	P.	G.B.	P.	A.T.	—	9'-6"	PREFAB. HEATING UNIT COVERS - P. CONT. LAMINATED HOOD RAIL - STAINED * CEILING HT. BETWEEN D&E = 8'-6" * DART LOW.
302	VESTIBULE	C.T.	G.B.	P.	G.B.	P.	G.B.	P.	G.B.	P.	G.B.	P.	8'-0"	
303	MEN'S WASHROOM	C.T.	C.T.	—	C.T.	—	C.T.	—	C.T.	—	G.B.	P.	8'-0"	
304	WOMEN'S WASHRM.	C.T.	C.T.	—	C.T.	—	C.T.	—	C.T.	—	G.B.	P.	8'-0"	
305	VESTIBULE	G.B.	G.B.	—	G.B.	—	G.B.	—	G.B.	—	G.B.	P.	8'-0"	
306	HWY/PUBLIC WORKS	CPT.	G.B. GLAZING	P. —	G.B. GLAZING	P. —	G.B.	P.	G.B.	P.	A.T.	—	9'-6"	PREFAB. HEATING UNIT COVERS - P. * DITTO
307	PERSONNEL	CPT.	G.B.	P.	OPEN	—	G.B.	P.	G.B.	P.	A.T.	—	9'-6"	
308	TREASURY	CPT.	G.B.	P.	G.B. GLAZING	P. —	G.B. GLAZING	P. —	G.B.	P.	A.T.	—	9'-6"	PREFAB. HEATING UNIT COVERS - P * DART LOW. * DITTO.
309	RECORDS	CPT.	G.B.	P.	OPEN	—	G.B.	P.	G.B.	P.	A.T.	—	9'-6"	& DITTO.
310	VAULT	R.F.	CONC. B.	—	CONC. B.	—	CONC. B.	—	CONC. B.	—	CONC.	P.	8'-3"	
311	SUPERVISOR	CPT.	G.B.	P.	G.B.	P.	G.B.	P.	G.B.	P.	A.T.	—	8'-6"	
312	KEYPUNCH	CPT.	G.B.	P.	G.B.	P.	G.B.	P.	G.B.	P.	A.T.	—	9'-6"	
313	VESTIBULE	C.T.	G.B.	P.	G.B.	P.	G.B.	P.	G.B.	P.	G.B.	P.	8'-0"	
314	MEN'S WASHRM.	C.T.	C.T.	—	C.T.	—	C.T.	—	C.T.	—	C.T.	—	8'-0"	
315	WOMEN'S WASHRM.	C.T.	C.T.	—	C.T.	—	C.T.	—	C.T.	—	C.T.	—	8'-0"	
316	VESTIBULE	C.T.	G.B.	P.	G.B.	P.	G.B.	P.	G.B.	P.	G.B.	P.	8'-0"	
317	JANITOR	CONC. S.T.	G.B.	P.	G.B.	P.	G.B.	P.	G.B.	P.	G.B.	P.	8'-0"	
318	CORRIDOR	CPT.	G.B.	P.	G.B.	P.	G.B.	P.	OPEN	—	A.C.T.	—	9'-6"	
319	COMPUTER	CPT.	G.B.	P.	G.B.	P.	G.B.	P.	G.B.	P.	A.C.T.	—	9'-6"	
320	CONFERENCE	CPT.	G.B.	P.	G.B.	P.	G.B.	P.	G.B.	P.	A.C.T.	—	9'-6"	
P-01	CORRIDOR	CONC. ST.	G.B.	P.	G.B.	P.	OPEN	—	G.B.	P.	EXPOSED S. JOISTS + DECK	P.	—	
P-02	STAFF RM.	CONC. S.T.	G.B.	P.	G.B.	P.	G.B.	P.	G.B.	P.	EXPOSED S. JOISTS + DECK	P.	—	
P-03	ELEV. MACHINE #1	CONC. S.T.	G.B.	P.	G.B.	P.	G.B.	P.	G.B.	P.	EXPOSED S. JOISTS + DECK	P.	—	
P-04	CORRIDOR	CONC. S.T.	OPEN	—	G.B.	P.	G.B.	P.	G.B.	P.	EXPOSED S. JOISTS + DECK	P.	—	
P-05	MECHANICAL	CONC. S.T.	G.B.	P.	G.B.	P.	G.B.	P.	G.B.	P.	EXPOSED S. JOISTS + DECK	P.	—	
P-06	ELEV. MACHINE #2	CONC. S.T.	G.B.	P.	G.B.	P.	G.B.	P.	G.B.	P.	EXPOSED S. JOISTS + DECK	P.	—	

Public Works Services Building Design

NO. DATE A 1979/06/06 — Revised to 'As Built's'

REVISIONS DESCRIPTION

DATE SCALE DRAWN CHECK APPROVED

PROJECT NO.

GOVERNMENT OF THE YUKON TERRITORY


DRAWING TITLE

FINISH SCHEDULE

PROJECT TITLE

TERRITORIAL ADMINISTRATION BUILDING WHITEHORSE, Y.T.

DRAWING NO.

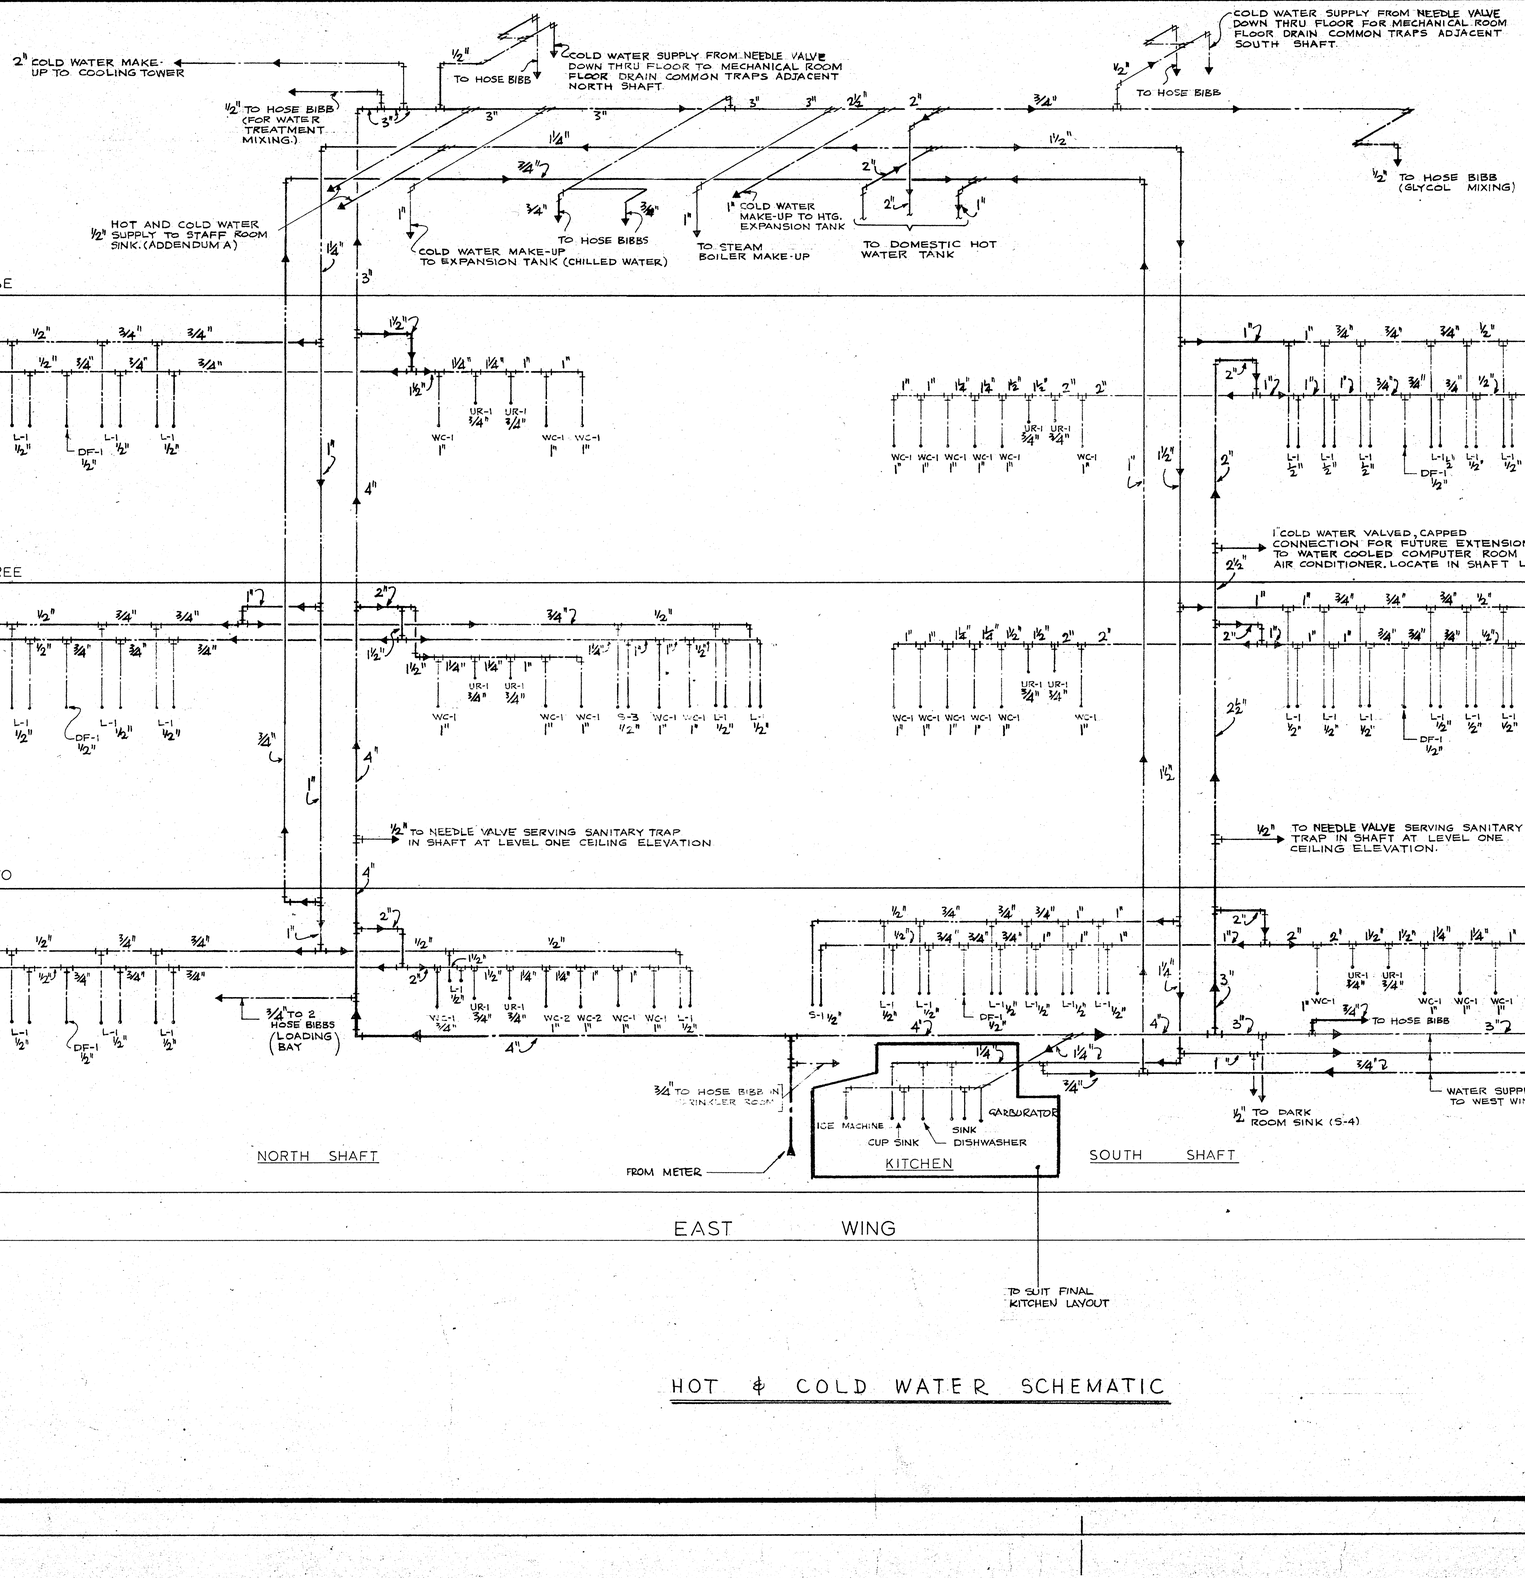

HOT & COLD WATER SCHEMATIC

NOTES

1. ISSUED FOR CLARIFICATION ONLY
2. ALL ACCESSORIES, VALVES, SHOCKTROLS, METERS PUMPS, GAUGES ETC. TO BE AS ORIGINAL DOCUMENTS
3. NEEDLE VALVES MAY BE USED TO BLEED WATER TO MAINTAIN TRAP SEALS IF APPROVED BY LOCAL PLUMBING INSPECTOR

GOVERNMENT OF THE YUKON TERRITORY


[redacted]

A detail no. / détail no.
B location drawing no. / sur dessin no.
C drawing no. / dessin no.
revisions / date

project title / titre du projet: TERRITORIAL ADMINISTRATION BUILDING WHITEHORSE Y.T.

drawing title / titre du dessin: HOT & COLD WATER SUPPLY PIPING CLARIFICATION

designed by / conçu par: [redacted] date: 21 NOV 74
drawn by / dessiné par: [redacted] date: 21 NOV 74
reviewed by / examiné par: date
approved by / approuvé par: date
Tender / Soumission
Project Manager / Administrateur de projets M.T.P.
project number / no. du projet: 89857
drawing no. / dessin no.: PLUMBING - CL-1

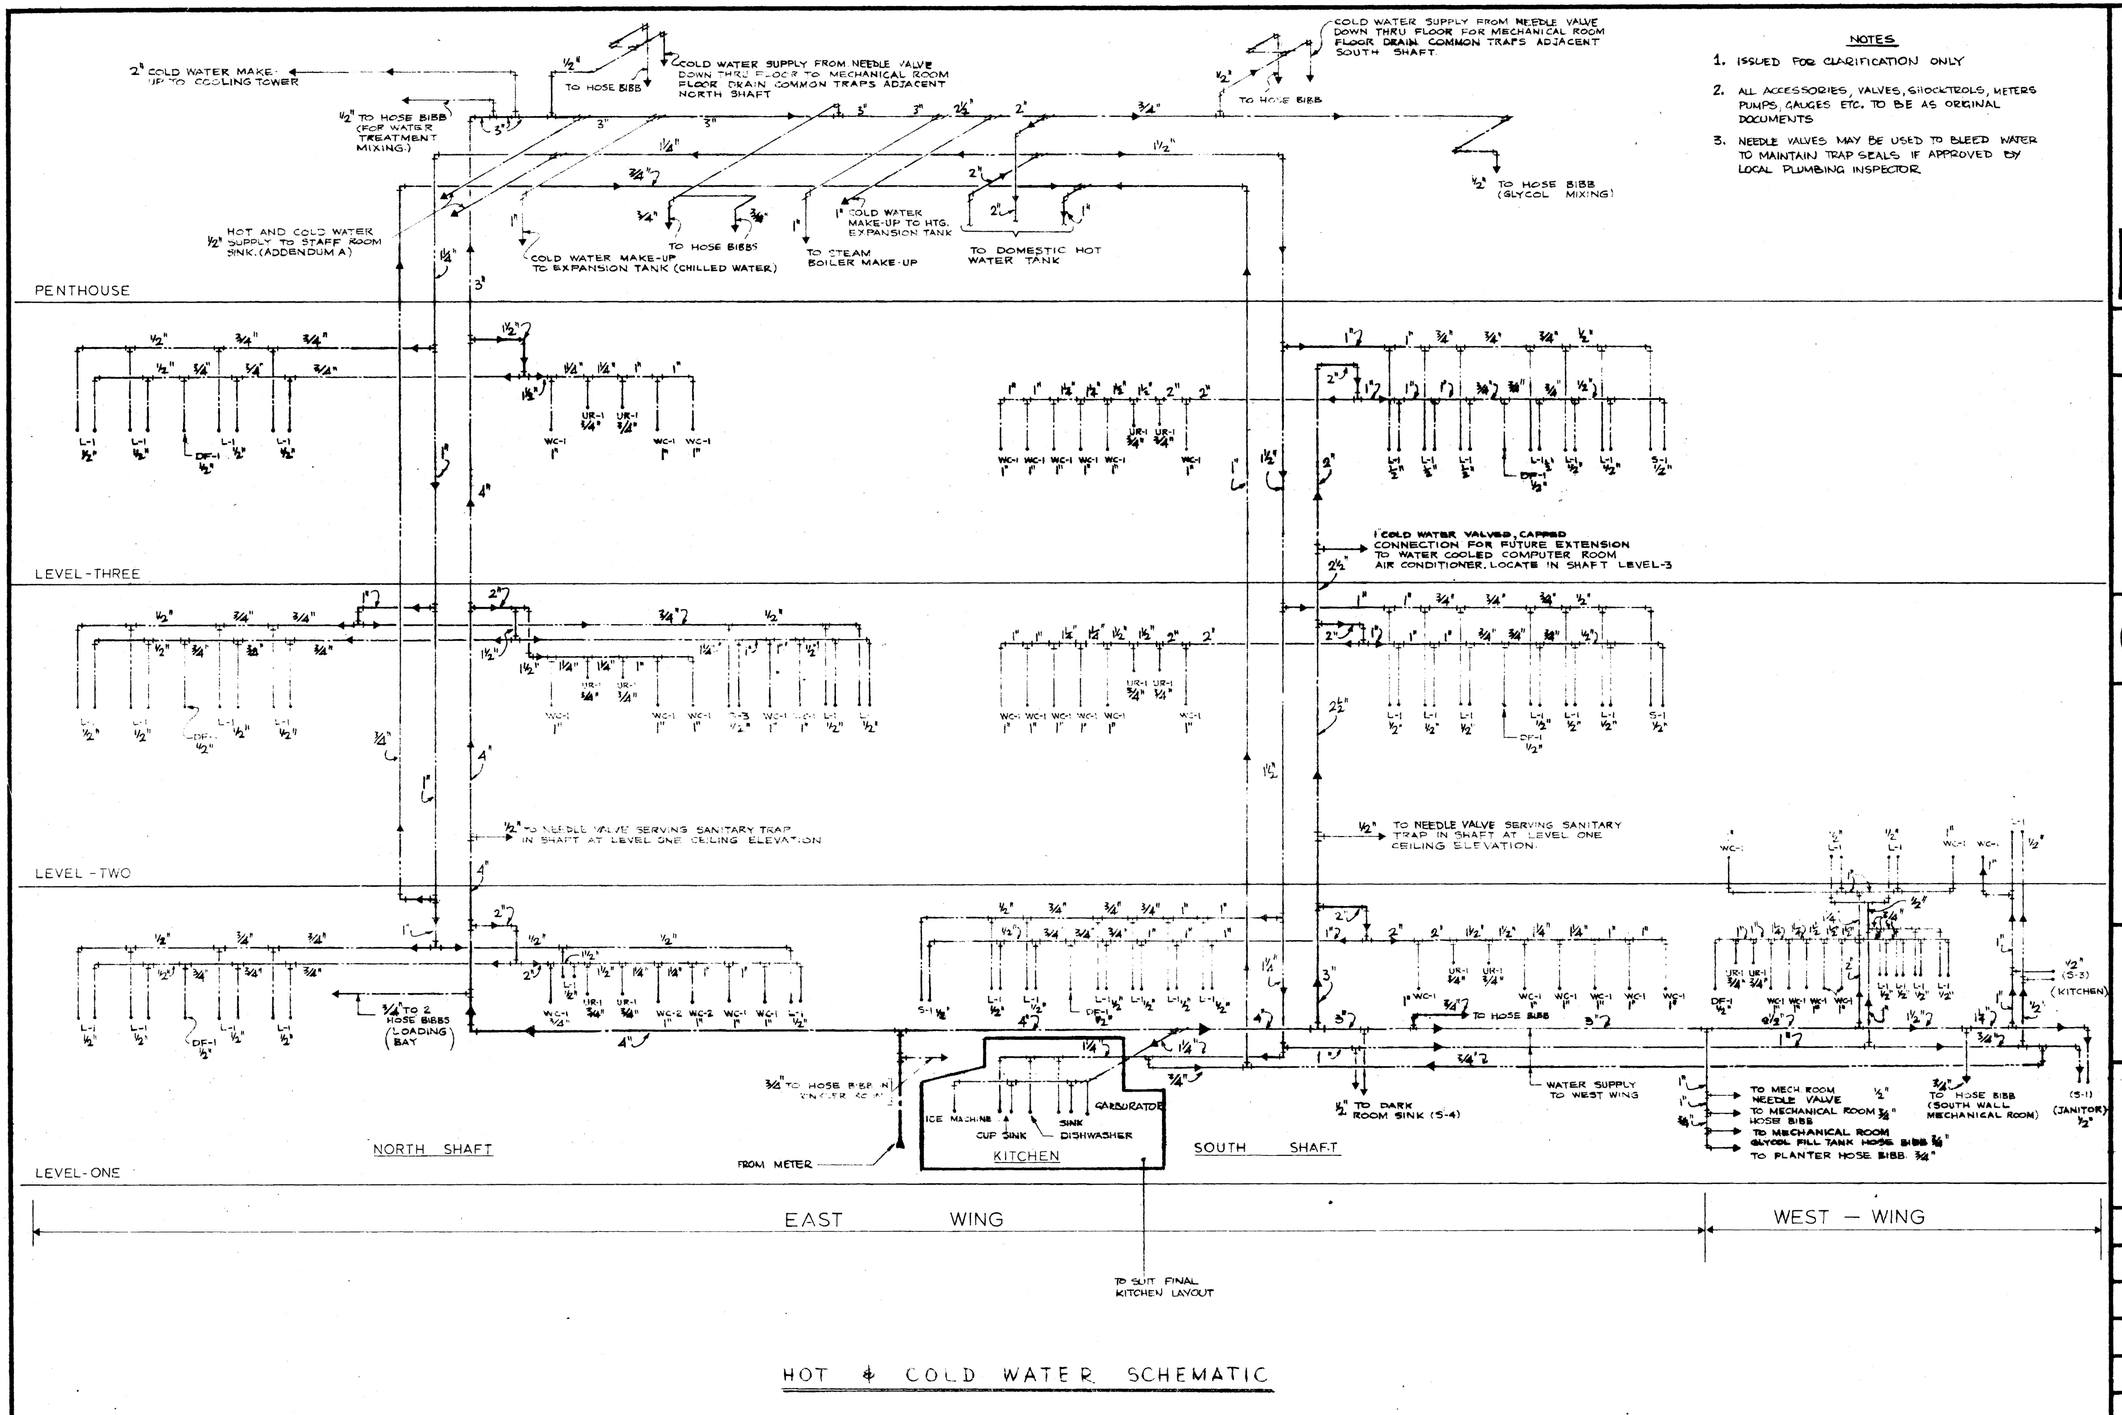

HOT & COLD WATER SCHEMATIC

NOTES

1. ISSUED FOR CLARIFICATION ONLY
2. ALL ACCESSORIES, VALVES, SHOCKTROLS, METERS PUMPS, GAUGES ETC. TO BE AS ORIGINAL DOCUMENTS
3. NEEDLE VALVES MAY BE USED TO BLEED WATER TO MAINTAIN TRAP SEALS IF APPROVED BY LOCAL PLUMBING INSPECTOR

GOVERNMENT OF THE YUKON TERRITORY

[redacted]

A detail no. / détail no.
B location drawing no. / our dessin no.
C drawing no. / dessin no.
revisions / date

project title / titre du projet
TERRITORIAL ADMINISTRATION BUILDING
WHITEHORSE YT


drawing title / titre du dessin
HOT & COLD WATER SUPPLY PIPING CLARIFICATION

designed by / conçu par
date 21 NOV 74
drawn by / dessiné par
date 21 NOV 74
reviewed by / examiné par
date
approved by / approuvé par
date
Tender / Soumission
Project Manager / Administrateur de projets T.A.P.

project number / no. du projet
69857

drawing no. / dessin no.
PLUMBING - CL-1

DPW 7080

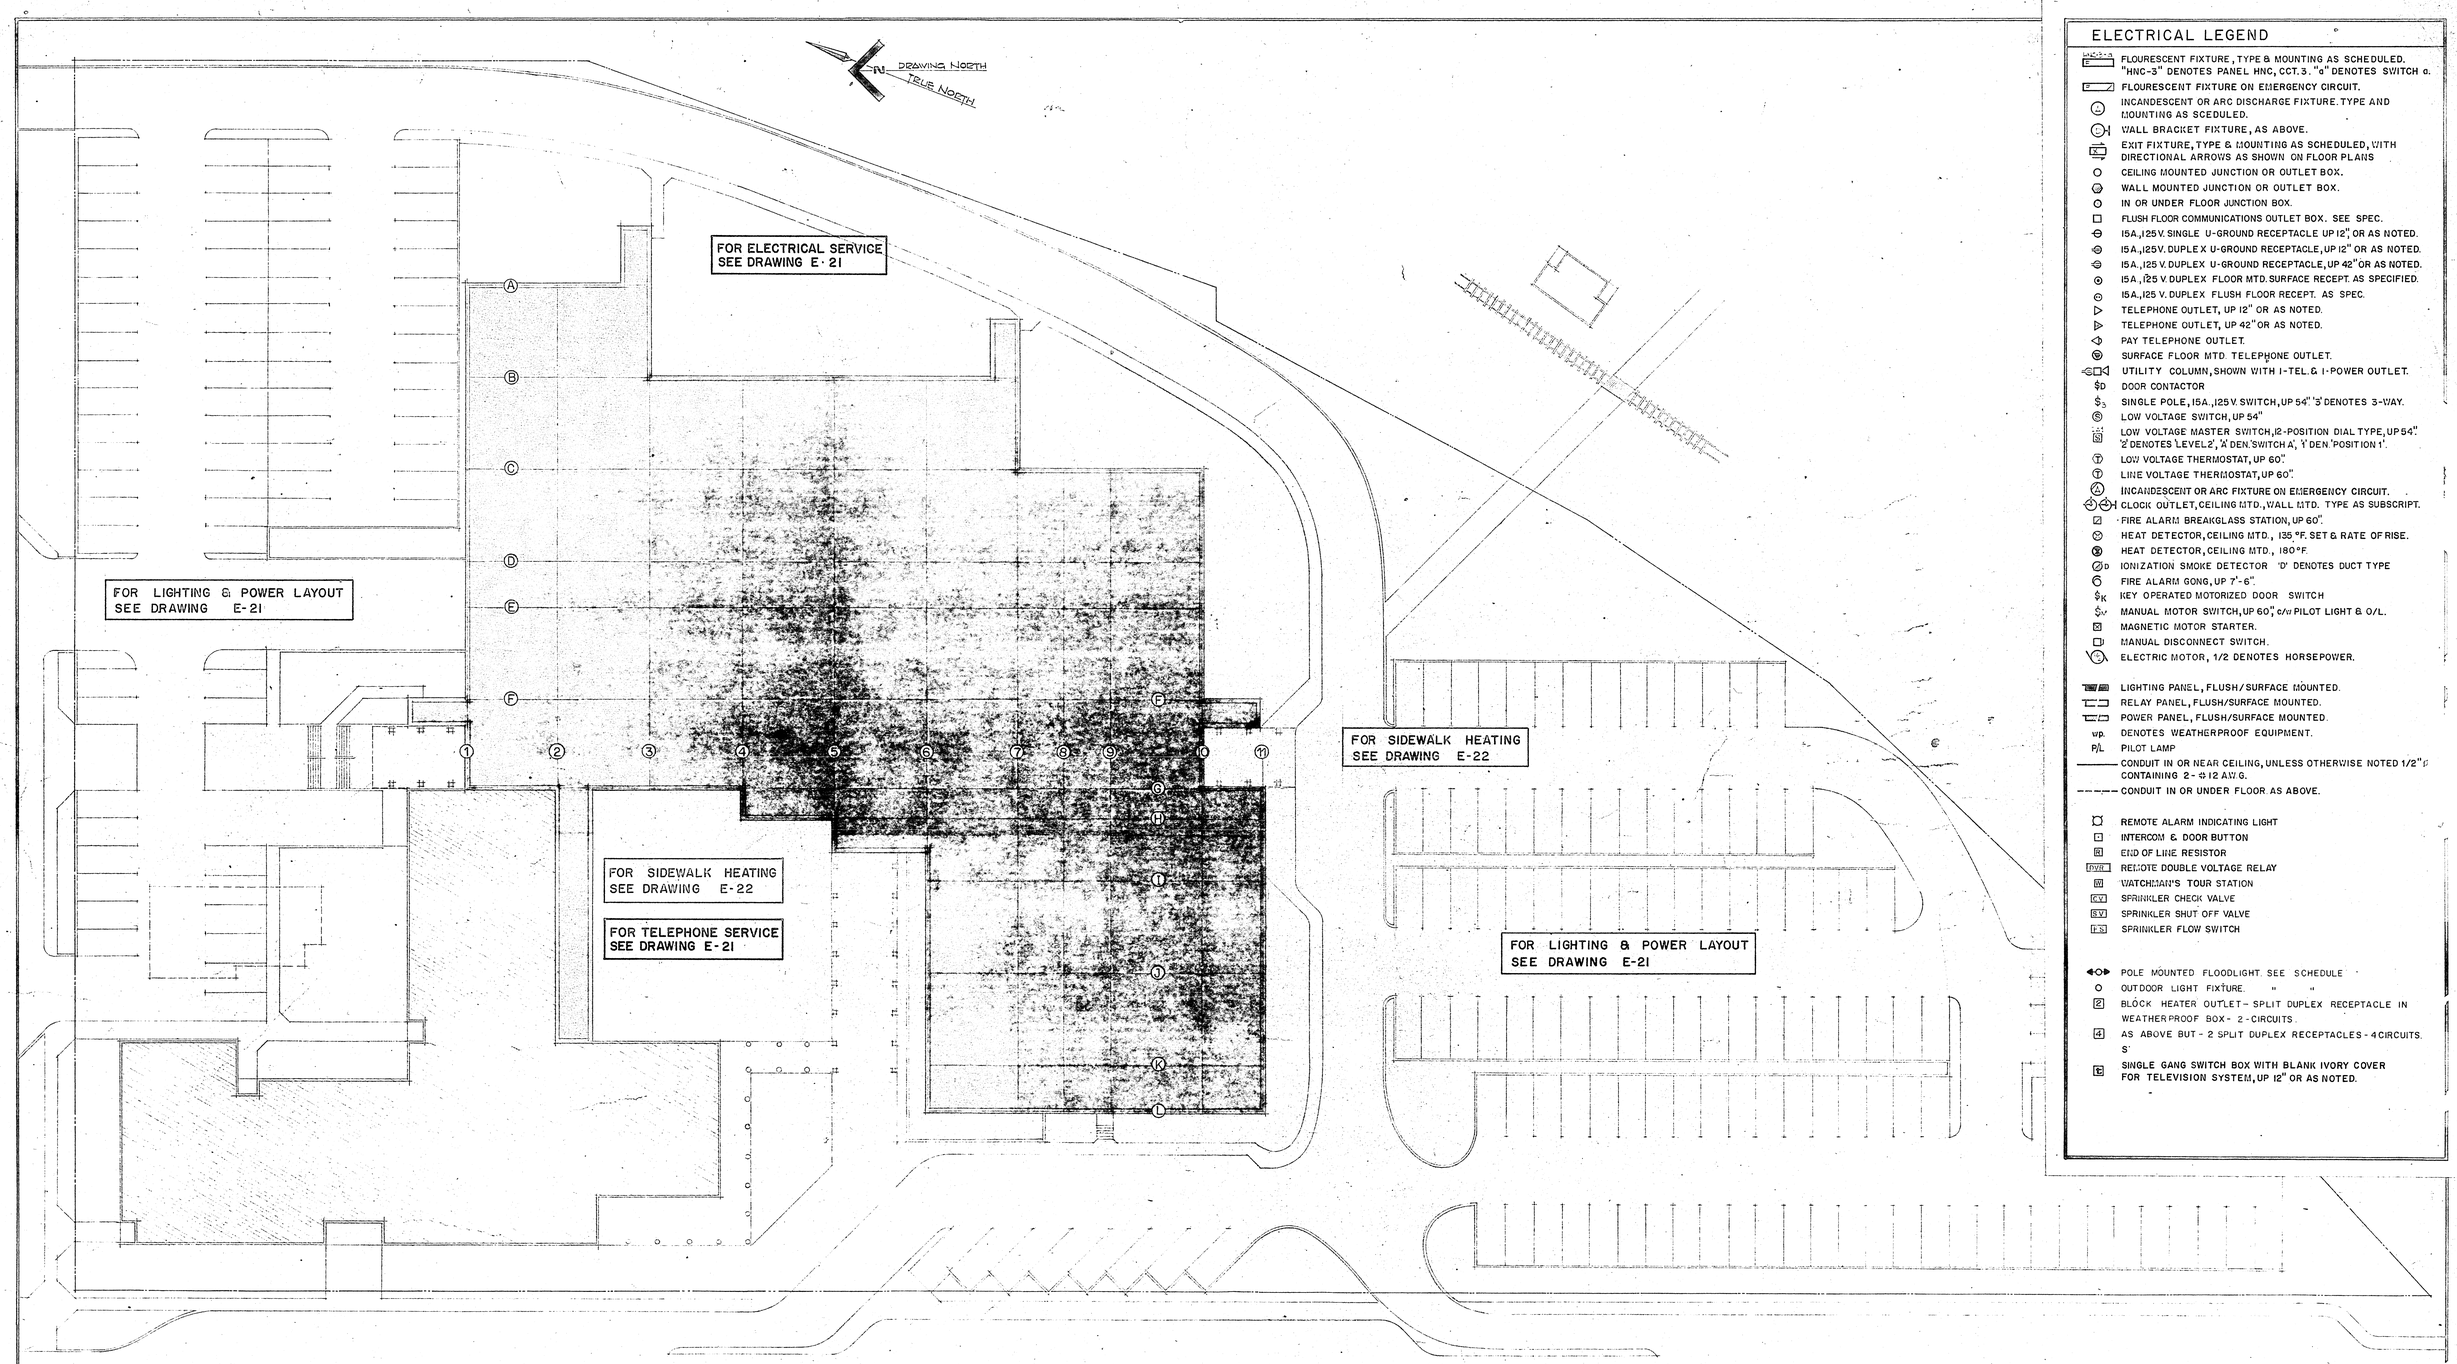

ELECTRICAL LEGEND

- FLOURESCENT FIXTURE, TYPE & MOUNTING AS SCHEDULED. "HNC-3" DENOTES PANEL HNC, CCT. 3. "a" DENOTES SWITCH a.
- FLOURESCENT FIXTURE ON EMERGENCY CIRCUIT.
- INCANDESCENT OR ARC DISCHARGE FIXTURE. TYPE AND MOUNTING AS SCEDULED.
- WALL BRACKET FIXTURE, AS ABOVE.
- EXIT FIXTURE, TYPE & MOUNTING AS SCHEDULED, WITH DIRECTIONAL ARROWS AS SHOWN ON FLOOR PLANS
- CEILING MOUNTED JUNCTION OR OUTLET BOX.
- WALL MOUNTED JUNCTION OR OUTLET BOX.
- IN OR UNDER FLOOR JUNCTION BOX.
- FLUSH FLOOR COMMUNICATIONS OUTLET BOX. SEE SPEC.
- 15A., 125 V. SINGLE U-GROUND RECEPTACLE UP 12" OR AS NOTED.
- 15A., 125 V. DUPLEX U-GROUND RECEPTACLE, UP 12" OR AS NOTED.
- 15A., 125 V. DUPLEX U-GROUND RECEPTACLE, UP 42" OR AS NOTED.
- 15A., 125 V. DUPLEX FLOOR MTD. SURFACE RECEPT. AS SPECIFIED.
- 15A., 125 V. DUPLEX FLUSH FLOOR RECEPT. AS SPEC.
- TELEPHONE OUTLET, UP 12" OR AS NOTED.
- TELEPHONE OUTLET, UP 42" OR AS NOTED.
- PAY TELEPHONE OUTLET.
- SURFACE FLOOR MTD. TELEPHONE OUTLET.
- UTILITY COLUMN, SHOWN WITH 1-TEL. & 1-POWER OUTLET.
- $D DOOR CONTACTOR
- $3 SINGLE POLE, 15A., 125 V. SWITCH, UP 54" '3' DENOTES 3-WAY.
- LOW VOLTAGE SWITCH, UP 54"
- LOW VOLTAGE MASTER SWITCH, 12-POSITION DIAL TYPE, UP 54". '2' DENOTES 'LEVEL 2', 'A' DEN. SWITCH 'A', '1' DEN 'POSITION 1'.
- LOW VOLTAGE THERMOSTAT, UP 60".
- LINE VOLTAGE THERMOSTAT, UP 60".
- INCANDESCENT OR ARC FIXTURE ON EMERGENCY CIRCUIT.
- CLOCK OUTLET, CEILING MTD., WALL MTD. TYPE AS SUBSCRIPT.
- FIRE ALARM BREAKGLASS STATION, UP 60".
- HEAT DETECTOR, CEILING MTD., 135 °F. SET & RATE OF RISE.
- HEAT DETECTOR, CEILING MTD., 180 °F.
- D IONIZATION SMOKE DETECTOR 'D' DENOTES DUCT TYPE
- FIRE ALARM GONG, UP 7'-6".
- $K KEY OPERATED MOTORIZED DOOR SWITCH
- $M MANUAL MOTOR SWITCH, UP 60", c/w PILOT LIGHT & O/L.
- MAGNETIC MOTOR STARTER.
- MANUAL DISCONNECT SWITCH.
- ELECTRIC MOTOR, 1/2 DENOTES HORSEPOWER.

- LIGHTING PANEL, FLUSH/SURFACE MOUNTED.
- RELAY PANEL, FLUSH/SURFACE MOUNTED.
- POWER PANEL, FLUSH/SURFACE MOUNTED.
- WP. DENOTES WEATHERPROOF EQUIPMENT.
- P/L PILOT LAMP
- CONDUIT IN OR NEAR CEILING, UNLESS OTHERWISE NOTED 1/2" ø CONTAINING 2 - #12 A.W.G.
- CONDUIT IN OR UNDER FLOOR AS ABOVE.

- REMOTE ALARM INDICATING LIGHT
- INTERCOM & DOOR BUTTON
- R END OF LINE RESISTOR
- RVR REMOTE DOUBLE VOLTAGE RELAY
- W WATCHMAN'S TOUR STATION
- C.V. SPRINKLER CHECK VALVE
- S.V. SPRINKLER SHUT OFF VALVE
- F.S. SPRINKLER FLOW SWITCH

- POLE MOUNTED FLOODLIGHT. SEE SCHEDULE
- OUTDOOR LIGHT FIXTURE. " "
- BLOCK HEATER OUTLET - SPLIT DUPLEX RECEPTACLE IN WEATHERPROOF BOX - 2-CIRCUITS.
- AS ABOVE BUT - 2 SPLIT DUPLEX RECEPTACLES - 4 CIRCUITS.
- SINGLE GANG SWITCH BOX WITH BLANK IVORY COVER FOR TELEVISION SYSTEM, UP 12" OR AS NOTED.

R. HOBNER ELECTRICAL ENGINEER

AS BUILT DRAWINGS

Public Works Canada / Travaux publics Canada
Pacific Region

REVISIONS		
NO.	DATE	DESCRIPTION
1	1/10/74	T.V. SYSTEM OUTLET ADDED TO LEGEND

PROJECT NO. 89857
DATE APRIL-1-74
SCALE 1" = 20'-0"
DRAWN
CHECK
APPROVED

GOVERNMENT OF THE YUKON TERRITORY

DRAWING TITLE
ELECTRICAL - SITE PLAN & LEGEND

PROJECT TITLE
TERRITORIAL ADMINISTRATION BUILDING
WHITEHORSE, Y.T.

DRAWING NO.
E1
1



ELECTRICAL LEGEND

- FLOURESCENT FIXTURE, TYPE & MOUNTING AS SCHEDULED. "HNC-3" DENOTES PANEL HNC, CCT. 3. "a" DENOTES SWITCH a.
- FLOURESCENT FIXTURE ON EMERGENCY CIRCUIT.
- INCANDESCENT OR ARC DISCHARGE FIXTURE. TYPE AND MOUNTING AS SCEDULED.
- WALL BRACKET FIXTURE, AS ABOVE.
- EXIT FIXTURE, TYPE & MOUNTING AS SCHEDULED, WITH DIRECTIONAL ARROWS AS SHOWN ON FLOOR PLANS
- CEILING MOUNTED JUNCTION OR OUTLET BOX.
- WALL MOUNTED JUNCTION OR OUTLET BOX.
- IN OR UNDER FLOOR JUNCTION BOX.
- FLUSH FLOOR COMMUNICATIONS OUTLET BOX. SEE SPEC.
- 15A., 125 V. SINGLE U-GROUND RECEPTACLE UP 12" OR AS NOTED.
- 15A., 125 V. DUPLEX U-GROUND RECEPTACLE, UP 12" OR AS NOTED.
- 15A., 125 V. DUPLEX U-GROUND RECEPTACLE, UP 42" OR AS NOTED.
- 15A., 125 V. DUPLEX FLOOR MTD. SURFACE RECEPT. AS SPECIFIED.
- 15A., 125 V. DUPLEX FLUSH FLOOR RECEPT. AS SPEC.
- TELEPHONE OUTLET, UP 12" OR AS NOTED.
- TELEPHONE OUTLET, UP 42" OR AS NOTED.
- PAY TELEPHONE OUTLET.
- SURFACE FLOOR MTD. TELEPHONE OUTLET.
- UTILITY COLUMN, SHOWN WITH 1-TEL. & 1-POWER OUTLET.
- $D DOOR CONTACTOR
- $3 SINGLE POLE, 15A., 125 V. SWITCH, UP 54" '3' DENOTES 3-WAY.
- LOW VOLTAGE SWITCH, UP 54"
- LOW VOLTAGE MASTER SWITCH, 12-POSITION DIAL TYPE, UP 54". '2' DENOTES 'LEVEL 2', 'A' DEN. SWITCH A', 'Y' DEN 'POSITION 1'.
- LOW VOLTAGE THERMOSTAT, UP 60".
- LINE VOLTAGE THERMOSTAT, UP 60".
- INCANDESCENT OR ARC FIXTURE ON EMERGENCY CIRCUIT.
- CLOCK OUTLET, CEILING MTD., WALL MTD. TYPE AS SUBSCRIPT.
- FIRE ALARM BREAKGLASS STATION, UP 60".
- HEAT DETECTOR, CEILING MTD., 135 °F. SET & RATE OF RISE.
- HEAT DETECTOR, CEILING MTD., 180 °F.
- D IONIZATION SMOKE DETECTOR 'D' DENOTES DUCT TYPE
- FIRE ALARM GONG, UP 7'-6".
- $K KEY OPERATED MOTORIZED DOOR SWITCH
- $M MANUAL MOTOR SWITCH, UP 60", c/w PILOT LIGHT & O/L.
- MAGNETIC MOTOR STARTER.
- MANUAL DISCONNECT SWITCH.
- ELECTRIC MOTOR, 1/2 DENOTES HORSEPOWER.

- LIGHTING PANEL, FLUSH/SURFACE MOUNTED.
- RELAY PANEL, FLUSH/SURFACE MOUNTED.
- POWER PANEL, FLUSH/SURFACE MOUNTED.
- wp. DENOTES WEATHERPROOF EQUIPMENT.
- P/L PILOT LAMP
- CONDUIT IN OR NEAR CEILING, UNLESS OTHERWISE NOTED 1/2" ø CONTAINING 2 - #12 AWG.
- CONDUIT IN OR UNDER FLOOR AS ABOVE.

- REMOTE ALARM INDICATING LIGHT
- INTERCOM & DOOR BUTTON
- EOL END OF LINE RESISTOR
- RDVR REMOTE DOUBLE VOLTAGE RELAY
- WATCHMAN'S TOUR STATION
- CV SPRINKLER CHECK VALVE
- SV SPRINKLER SHUT OFF VALVE
- FS SPRINKLER FLOW SWITCH

- POLE MOUNTED FLOODLIGHT. SEE SCHEDULE
- OUTDOOR LIGHT FIXTURE. " "
- 2 BLOCK HEATER OUTLET - SPLIT DUPLEX RECEPTACLE IN WEATHERPROOF BOX - 2-CIRCUITS.
- 4 AS ABOVE BUT - 2 SPLIT DUPLEX RECEPTACLES - 4 CIRCUITS.
- S SINGLE GANG SWITCH BOX WITH BLANK IVORY COVER FOR TELEVISION SYSTEM, UP 12" OR AS NOTED.

R. HOBNER ELECTRICAL ENGINEER

AS BUILT DRAWINGS

Public Works Canada / Travaux publics Canada
Pacific Region

REVISIONS		
NO.	DATE	DESCRIPTION
1	1/10/74	T.V. SYSTEM OUTLET ADDED TO LEGEND


PROJECT NO. 89857
DATE APRIL-1-74
SCALE 1" = 20'-0"
CHECK
APPROVED


GOVERNMENT OF THE YUKON TERRITORY

DRAWING TITLE
ELECTRICAL - SITE PLAN & LEGEND

PROJECT TITLE
TERRITORIAL ADMINISTRATION BUILDING
WHITEHORSE, Y.T.

DRAWING NO.
E1
1

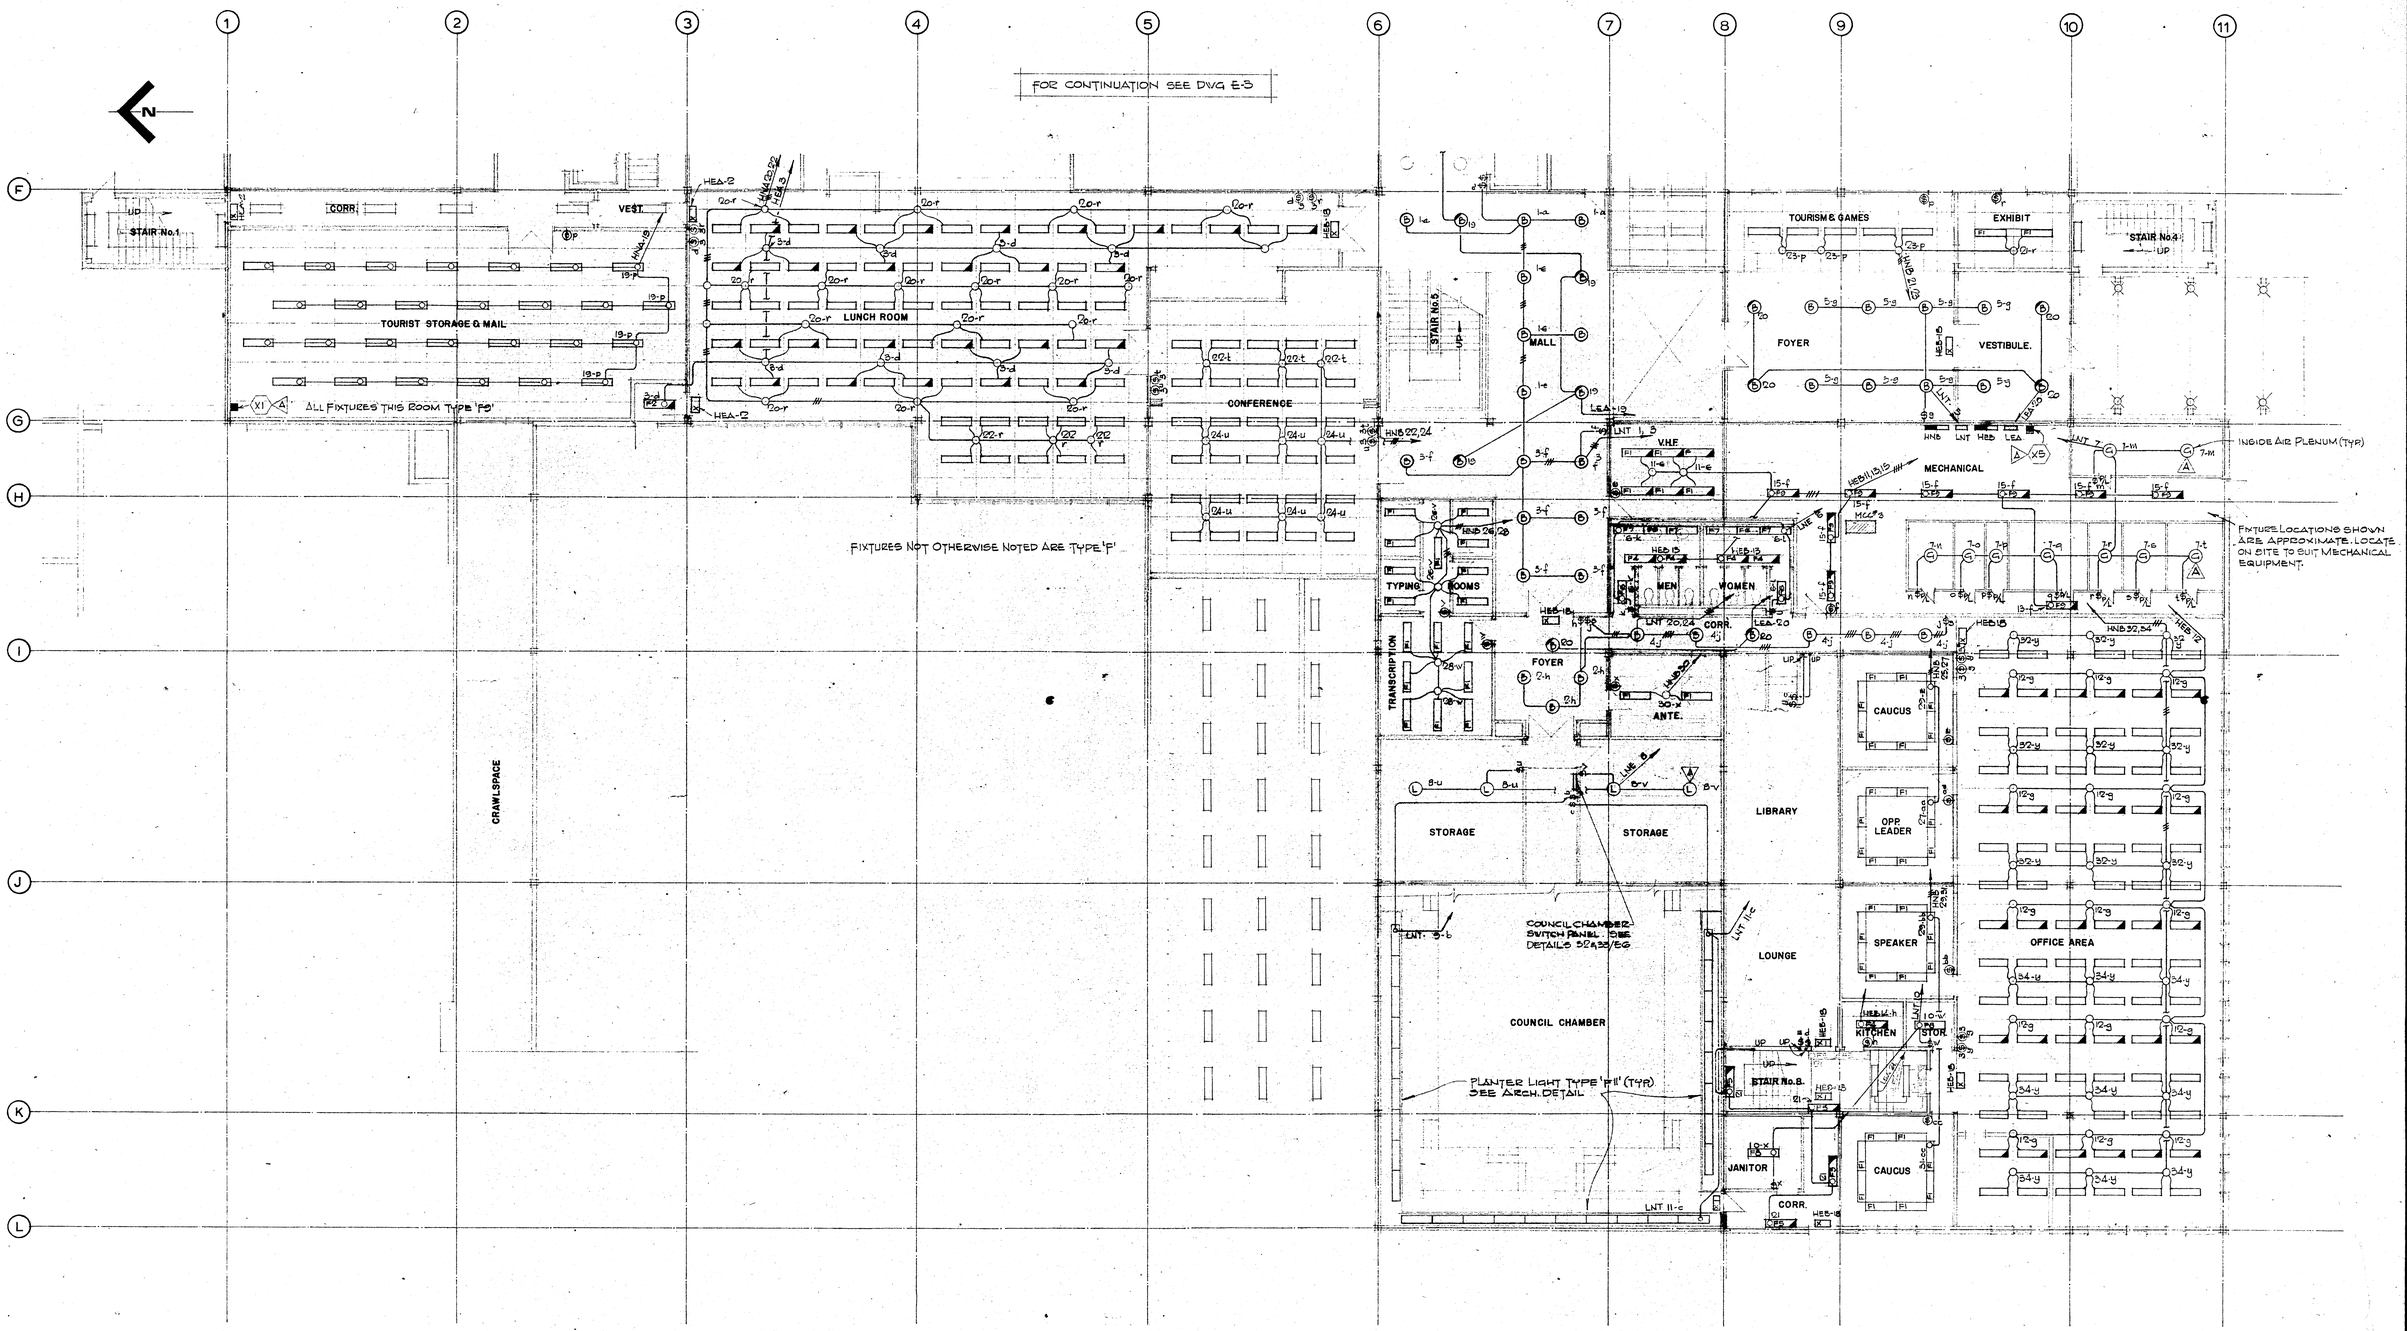

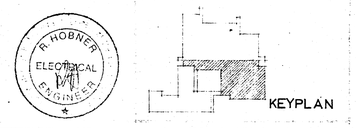

R. HOBNER ELECTRICAL ENGINEER

AS BUILT DRAWINGS

Public Works Canada / Travaux publics Canada
Pacific Region

REVISIONS		
NO.	DATE	DESCRIPTION
A	24/9/74	TYPE 'P' FIXTURES IN STORAGE SPACES CHANGED TYPE 'L'. TYPE 'P'.
		FIXTURES IN MECHANICAL ROOM CHANGED TO TYPE 'L'. TRANSFOR.
		MEBS X5 & X1 LOCATED.

PROJECT NO. 8365?

DATE 1 APR. '74 | SCALE 1/8" = 1'-0"

DRAWN [illegible] | CHECK

APPROVED [illegible]

GOVERNMENT OF THE YUKON TERRITORY

DRAWING TITLE
ELECTRICAL-LEVEL ONE WEST-LIGHTING

PROJECT TITLE
TERRITORIAL ADMINISTRATION BUILDING
WHITEHORSE, Y.T.

DRAWING NO.
E2

FOR CONTINUATION SEE DWG E-3

FIXTURES NOT OTHERWISE NOTED ARE TYPE 'F'

ALL FIXTURES THIS ROOM TYPE 'F9'

FIXTURES LOCATIONS SHOWN ARE APPROXIMATE. LOCATE ON SITE TO SUIT MECHANICAL EQUIPMENT.

PLANTER LIGHT TYPE 'F11' (TYP) SEE ARCH. DETAIL


CRAWLSPACE

KEYPLAN

R. HOBNER ELECTRICAL ENGINEER

AS BUILT DRAWINGS

Public Works Canada / Travaux publics Canada
Pacific Region

NO.	DATE	REVISIONS DESCRIPTION
A	24/9/74	TYPE 'P' FIXTURES IN STORAGE SPACES CHANGED TYPE 'L'. TYPE 'P' FIXTURES IN MECHANICAL ROOM CHANGED TO TYPE 'L' TRANSFOR. MERS X5 & X1 LOCATED.


PROJECT NO. 89857
DATE 1 APR. '74
SCALE 1/8" = 1'-0"
DRAWN L. Eschweiler
CHECK
APPROVED

GOVERNMENT OF THE YUKON TERRITORY

DRAWING TITLE
ELECTRICAL - LEVEL ONE WEST - LIGHTING

PROJECT TITLE
TERRITORIAL ADMINISTRATION BUILDING
WHITEHORSE, Y.T.

DRAWING NO.
E2

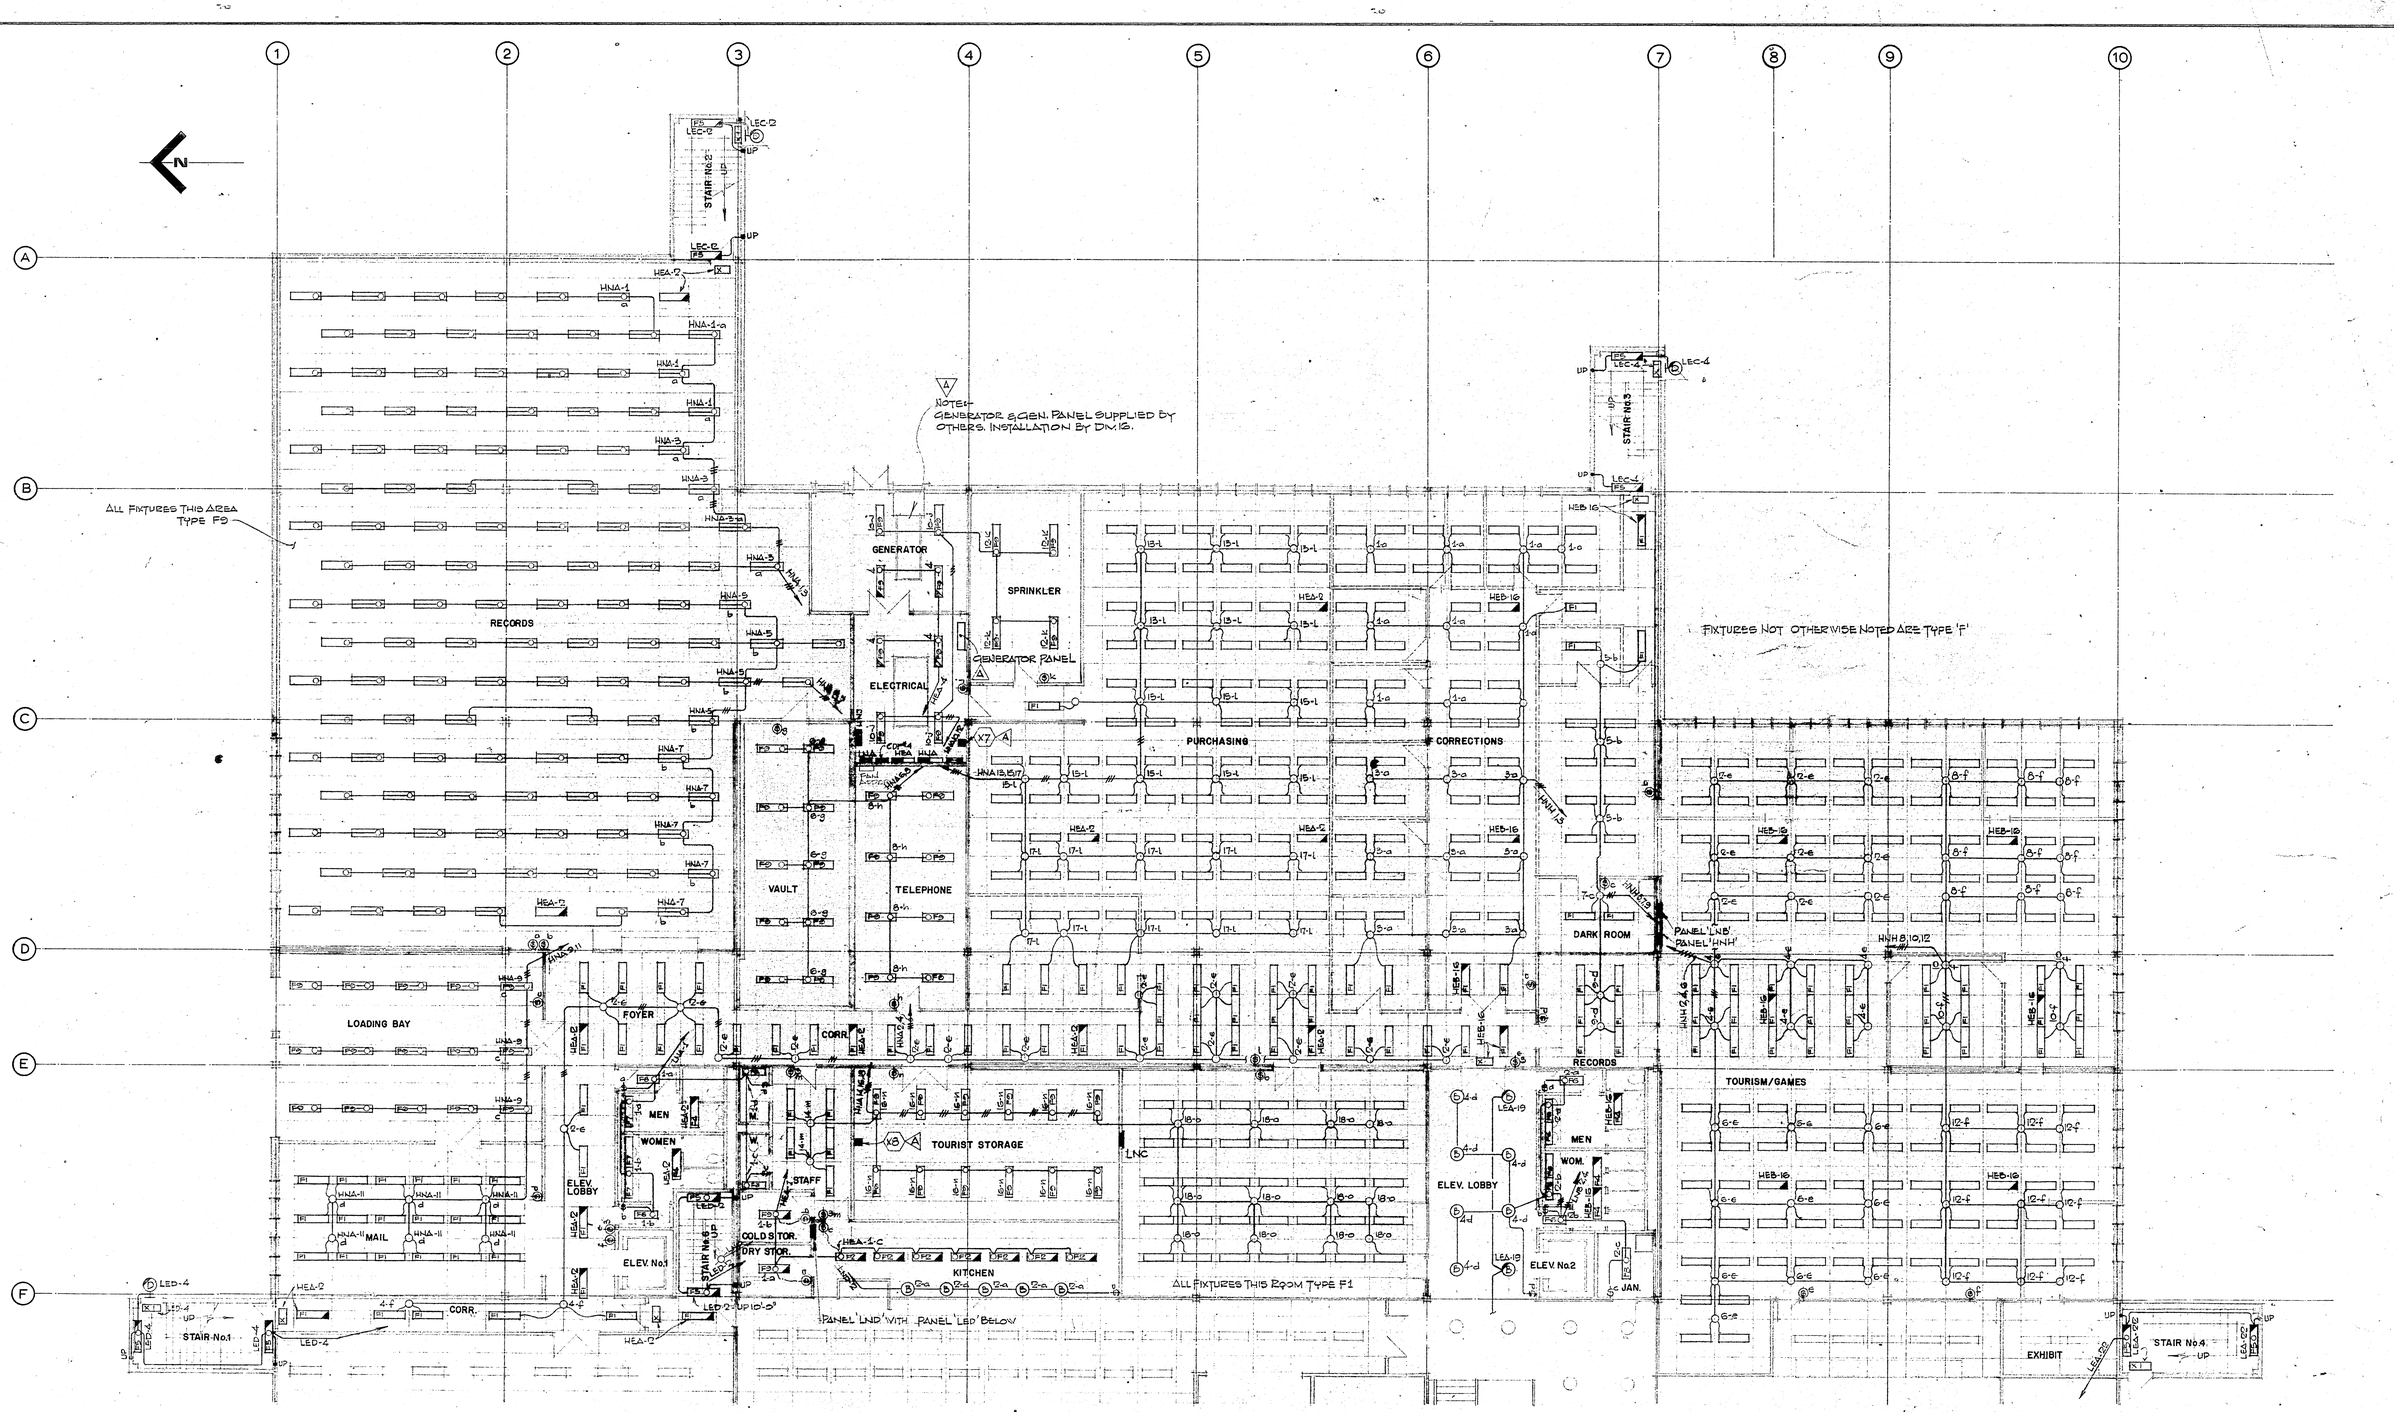

R. HOBNER ELECTRICAL ENGINEER

KEY PLAN

AS BUILT DRAWINGS

Public Works Canada Travaux publics Canada Pacific Region

REVISIONS		
NO.	DATE	DESCRIPTION
A	12/5/74	GENERATOR PANEL & NOTE 2 & GENERATOR ADDED. TRANSFORMERS X7 & X8 LOCATED.


PROJECT NO. 69857
DATE 1 APR. '74
SCALE 1/8"=1'-0"
DRAWN Ledwidge
CHECK
APPROVED R. Hobner

GOVERNMENT OF THE YUKON TERRITORY

DRAWING TITLE
ELECTRICAL-LEVEL ONE EAST - LIGHTING

PROJECT TITLE
TERRITORIAL ADMINISTRATION BUILDING
WHITEHORSE, Y.T.

DRAWING NO.
E3
A

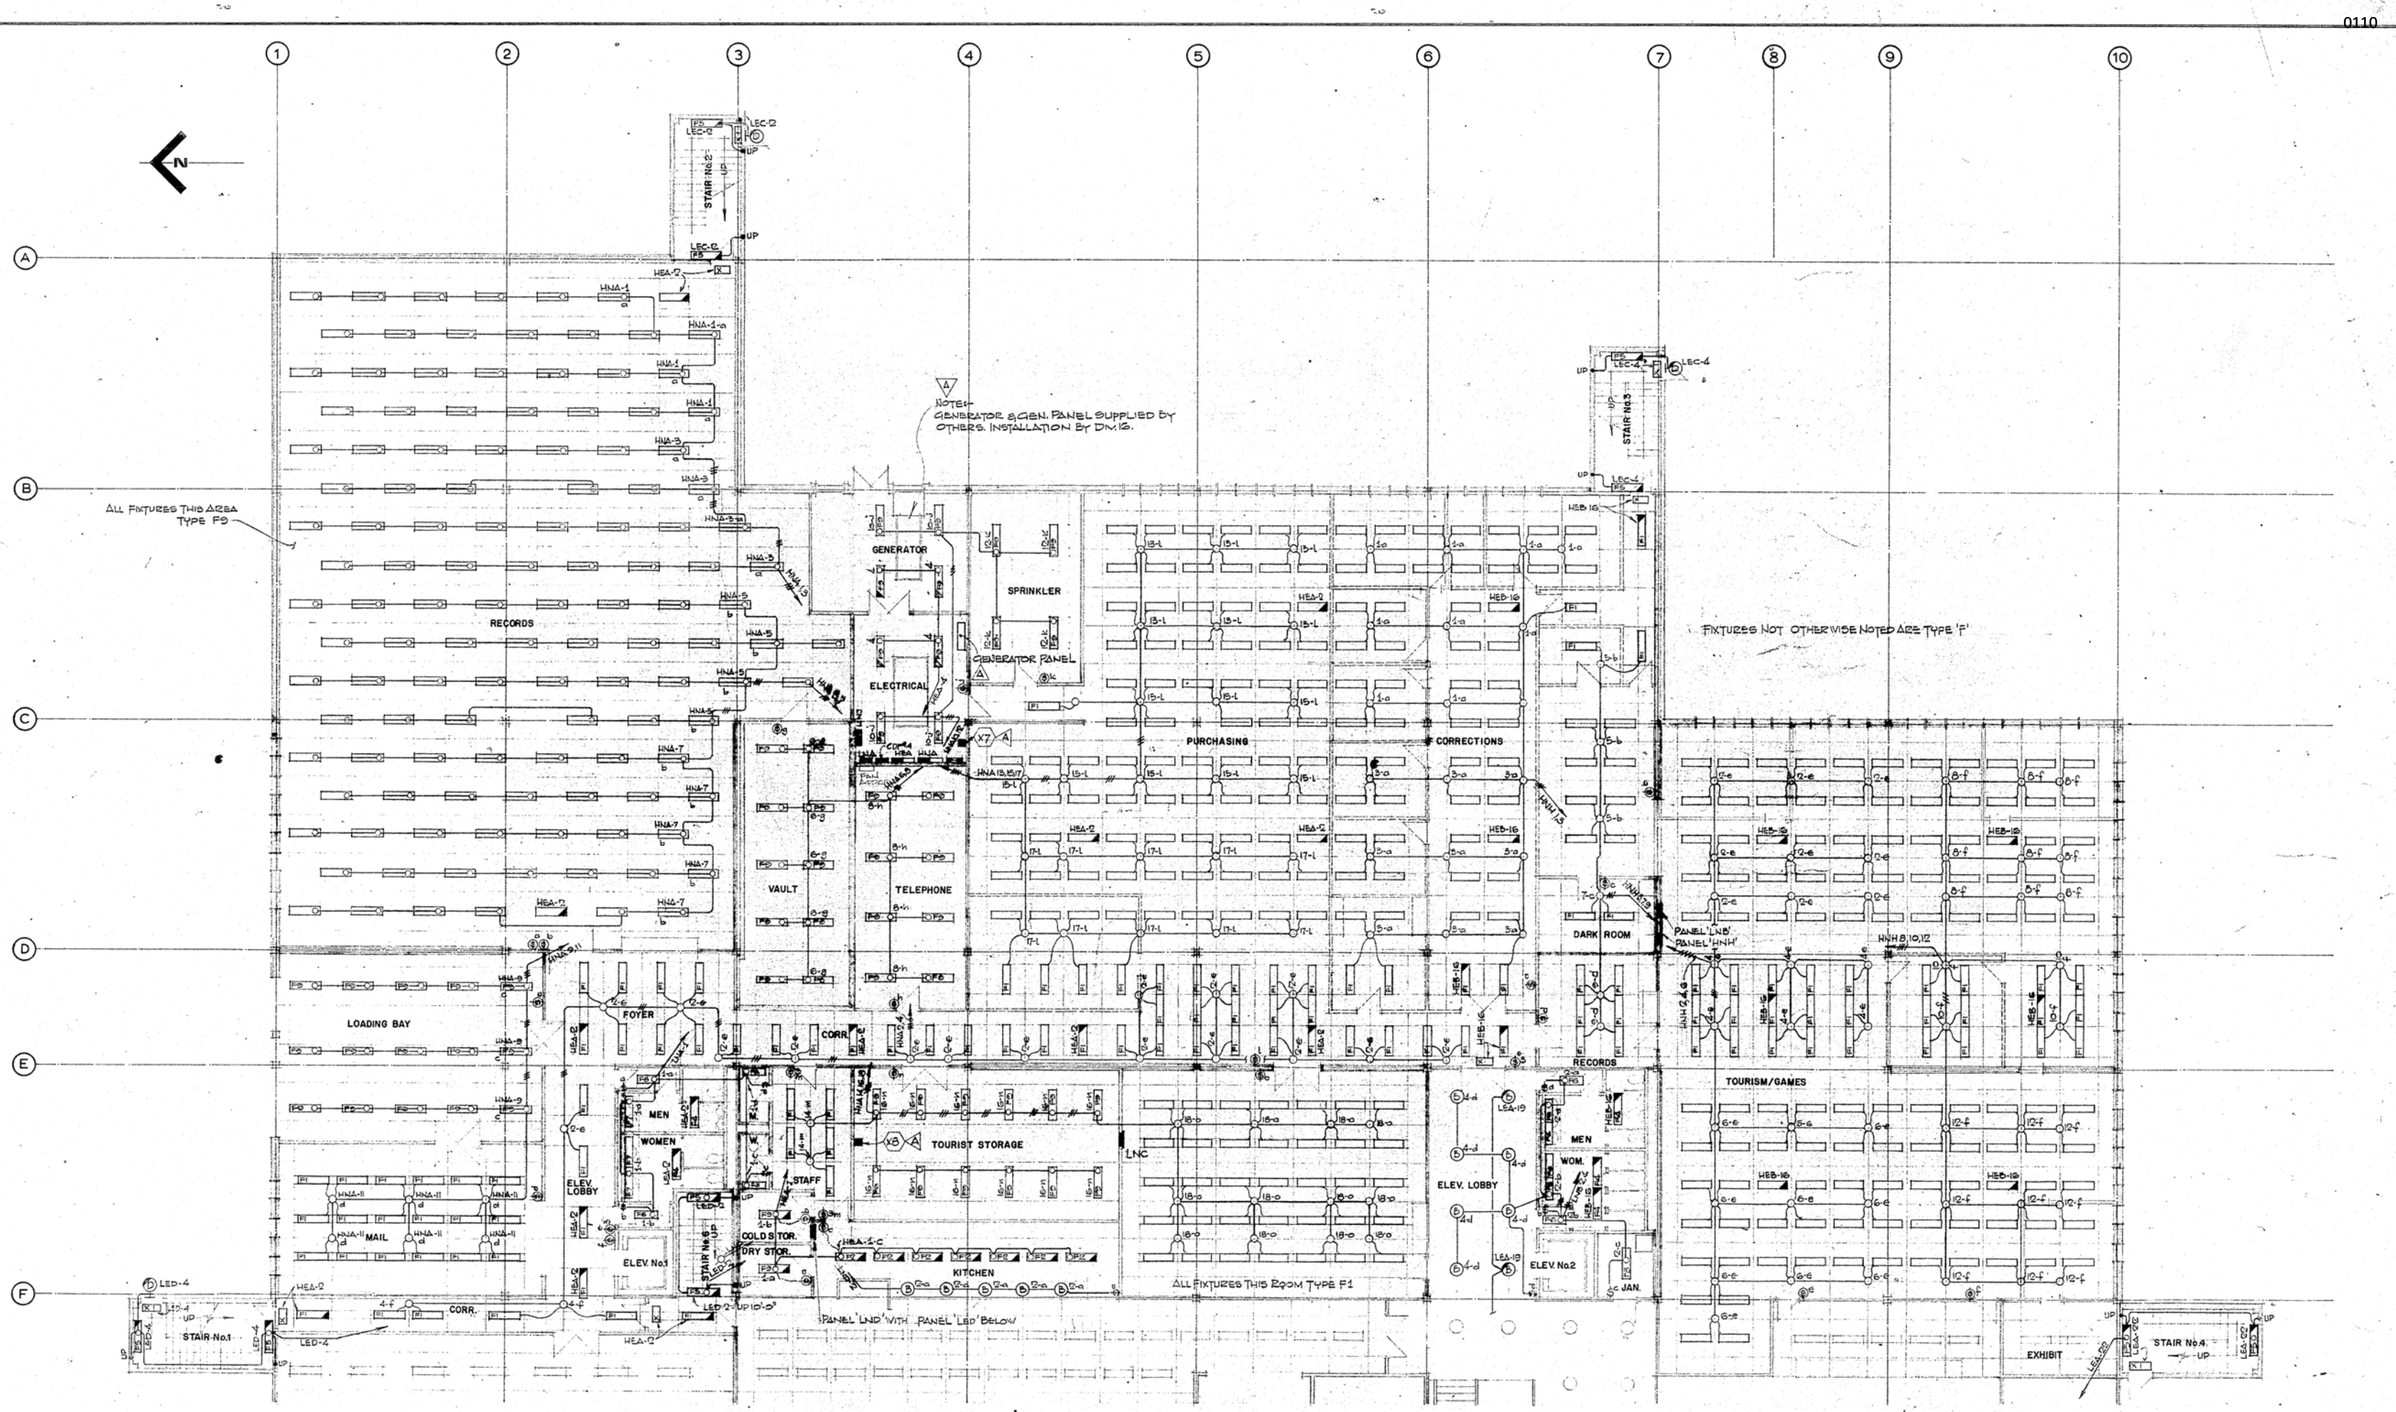

R. HOBNER ELECTRICAL ENGINEER

KEY PLAN

AS BUILT DRAWINGS

Public Works Canada Travaux publics Canada Pacific Region

NO.	DATE	REVISIONS DESCRIPTION
A	21/5/74	GENERATOR PANEL & NOTE RE GENERATOR ADDED. TRANSFORMERS X7 & X8 LOCATED.

PROJECT NO. 69857

DATE 1 APR. 74 | SCALE 1/8"=1'-0"

DRAWN [illegible] | CHECK

APPROVED

GOVERNMENT OF THE YUKON TERRITORY

DRAWING TITLE

ELECTRICAL-LEVEL ONE EAST - LIGHTING

PROJECT TITLE

TERRITORIAL ADMINISTRATION BUILDING
WHITEHORSE, Y.T.

DRAWING NO.

E3

A

FOR CONTINUATION SEE DWG E5

CORRIDOR
STAIR N°1
VEST.
TOURIST STORAGE & MAIL
KITCHEN
LUNCH ROOM
CONFERENCE
STAIR N°5
MALL
TOURISM & GAMES
EXHIBIT
STAIR N°4
FOYER
VESTIBULE
VHF
COUNCIL BLOCK MECHANICAL RM.
COUNCIL BLOCK AIR SYSTEM
TYPING
MEN
WOMEN
TRANSCRIPTION
FOYER
CAUCUS
OPPOSITION LEADER
STORAGE
STORAGE
LIBRARY
SPEAKER
KITCHEN
STOR.
STAIR N°2
JANITOR
CORRIDOR
CAUCUS
COUNCIL CHAMBER
/SEE PART PLAN THIS SHEET/
UNIT HEATER
TELEPHONE FIBRE GLOBE

4-4" TYPE II P.V.C. DUCTS TO TELEPHONE EQUIPMENT ROOM. IN CEILING SPACE OF THIS FLOOR.

SELECTOR SWITCH FOR PUMP K2. SEE E24
SPECIAL PUMP CONTROL PANEL FOR P6, P8, P10 & P13 SEE E24

24"x24"x4" TELEVISION TERMINAL CABINET

3/4" E.C. TO TV TERM. CAB.

3/4" E.C. TO TV TERM. CABINET

3/4" E.C. TERMINATE IN CEILING SPACE. OFFICE AREA

3/4" E.C. IN CEILING

3/4" E.C. TO TV TERM. CABINET

REMOVE EXISTING FORCE FLOW IN EXISTING LIBRARY

CONSOLE 2 HP FLOW

INCOMING UNDERGROUND TELEPHONE SERVICE. 2-4" RIGID P.V.C. DUCTS. TERMINATE IN STORAGE SPACE UNDER MAIN ENTRY RAMP, AS LOCATED ON SITE BY C.N. TELEPHONE

2-4" TYPE II P.V.C. FOR CABLE TV. SEE DWG E21

NOTE 1- FOR WALL MTD. TELEPHONE OUTLETS RUN 1" EMPTY CONDUIT TO CEILING SPACE, TYPICAL FOR DWGS E1, E3, E5, E7, & E11.
- AUDIO TERMINAL BOX #1 (A.T.B.#1) - 10"W x 8"H x 4" DEEP BOX FLUSH IN FLOOR, 4 1/2" OUT FROM WALL. PROVIDE #4 GROUND CONDUCTOR TO BUILDING GROUND, LEAVE 5' EXCESS IN A.T.B.#1. AUDIO CABINET RACK (SHOWN DOTTED) NOT IN THIS CONTRACT.

PART PLAN LOWER COUNCIL CHAMBER — OBSOLETE - TO BE REVISED WHEN PRICE APPROVED 4 Nov. '74
SCALE 1/4"=1'-0"

R. HOBNER ELECTRICAL ENGINEER

FIRE ALARM ZONE 5
KEY PLAN

AS BUILT DRAWINGS

Public Works Canada / Travaux publics Canada
Pacific Region

NO.	DATE	REVISIONS DESCRIPTION
A	24/5/74	SELECTOR SWITCHES & CONTROL PANEL ADDED IN MECH. RM., TELEPHONE
		SERVICE & CABLE TRAY ADDED, TRANSFORMERS X1 & X5 LOCATED
1	4/10/74	TV OUTLET BOXES & CONDUIT SYSTEM ADDED.
2	4/5/75	TELEPHONE SERVICE CHANGED

PROJECT NO. 39957
DATE APRIL 1974
SCALE 1/8" = 1'-0"
DRAWN C.S./MMD
CHECK
APPROVED

GOVERNMENT OF THE YUKON TERRITORY

DRAWING TITLE
ELECTRICAL - LEVEL ONE WEST - POWER

PROJECT TITLE
TERRITORIAL ADMINISTRATION BUILDING
WHITEHORSE, Y.T.

DRAWING NO.
E4
LATEST REVISION 2
ADDENDUM A

FOR CONTINUATION SEE DWG E5

4-4" TYPE II P.V.C. DUCTS TO TELEPHONE EQUIPMENT ROOM IN CEILING SPACE OF THIS FLOOR.

CORRIDOR
STAIR N°1
VEST.
TOURIST STORAGE & MAIL
KITCHEN
LUNCH ROOM
CONFERENCE
STAIR N°5
MALL
TOURISM & GAMES
EXHIBIT
STAIR N°4
FOYER
VESTIBULE
VHF
COUNCIL BLOCK MECHANICAL RM.
TYPING
MEN
WOMEN
TRANSCRIPTION
FOYER
STORAGE
STORAGE
LIBRARY
CAUCUS
OPPOSITION LEADER
SPEAKER
KITCHEN
STOR.
STAIR N°8
JANITOR
CORRIDOR
CAUCUS
COUNCIL CHAMBER
/SEE PART PLAN THIS SHEET/

3/4" E.C. IN CEILING
CONSOLE 2ND FLOOR
3/4" E.C. TO TV TERM. CABINET
REMOVE EXISTING FENCE FLOW IN EXISTING LIBRARY
UNIT HEATER
TELEPHONE FIBRE GLOBE
24"x 24"x 4" TELEVISION TERMINAL CABINET
3/4" E.C. TO TV TERM. CAB.
3/4" E.C. TERMINATE IN CEILING SPACE. OFFICE AREA
3/4" E.C.
SELECTOR SWITCH FOR PUMP K2. SEE SPECIAL PUMP CONTROL PANEL FOR P8, P9, P10 & P11 SEE
COUNCIL BLOCK AIR SYSTEM
SPRINKLER BELL
INCOMING UNDERGROUND TELEPHONE SERVICE, 4-4" RIGID P.V.C. DUCTS, TERMINATE IN STORAGE SPACE UNDER MAIN ENTRY RAMP, AS LOCATED ON SITE BY C.N. TELEPHONE
2" TYPE II P.V.C. FOR CABLE TV. SEE DWG E21

NOTE 1 - FOR WALL MTD. TELEPHONE OUTLETS RUN 1" EMPTY CONDUIT TO CEILING SPACE, TYPICAL FOR DWGS E1, E3, E8, E9, & E11.
- AUDIO TERMINAL BOX #1 (A.T.B.#1) - 12" x 8" x 4" DEEP BOX FLUSH IN FLOOR, 4 1/2" OUT FROM WALL. PROVIDE #4 GROUND CONDUCTOR TO BUILDING GROUND, LEAVE 5' EXCESS IN A.T.B.#1. AUDIO CABINET RACK (SHOWN DOTTED) NOT IN THIS CONTRACT.

PART PLAN LOWER COUNCIL CHAMBER — OBSOLETE - TO BE REVISED WHEN PRICE APPROVED 4 Nov. '74
SCALE 1/4"=1'-0"

R. HOBNER ELECTRICAL ENGINEER

FIRE ALARM ZONE 5
KEY PLAN

AS BUILT DRAWINGS

Public Works Canada / Travaux publics Canada
Pacific Region

REVISIONS			
NO.	DATE	DESCRIPTION	
A	24/5/74	SELECTOR SWITCHES & CONTROL PANEL ADDED IN MECH. RM., TELEPHONE SERVICE & CABLE TRAY ADDED, TRANSFORMERS X1 & X5 LOCATED	
1	4/10/74	TV OUTLET BOXES & CONDUIT SYSTEM ADDED.	
2	4/5/75	TELEPHONE SERVICE CHANGED	

PROJECT NO. 32957
DATE: APRIL 1974
SCALE: 1/8" = 1'-0"
DRAWN: C.S./MMD
CHECK:
APPROVED:

GOVERNMENT OF THE YUKON TERRITORY

DRAWING TITLE
ELECTRICAL - LEVEL ONE WEST - POWER

PROJECT TITLE
TERRITORIAL ADMINISTRATION BUILDING
WHITEHORSE, Y.T.

DRAWING NO.
E4
LATEST REVISION 2
ADDENDUM A

1 2 3 4 5 6 7 8 9 10

A B C D E F

N

STAIR No 2

GENERATOR & GENERATOR PANEL PROVIDED BY OTHERS. INSTALLATION BY DIV. 16

GENERATOR

SPRINKLER

GENERATOR PANEL

RECORDS

SPEED SWITCH FROM BU MECH. DIV.

ELECTRICAL

PANEL 'LEE' (FED FROM X11) LOCATE IN TELEPHONE ROOM AS DIRECTED ON SITE BY CN TELEPHONE.

1" E.C. FOR GROUND CONDUCTOR FROM MAIN WATER VALVE TO TELEPHONE EQUIPMENT ROOM.

UNDERFLOOR TELEPHONE DUCT 10" C TO CEILING AT GRIDLINE 9

UNDERFLOOR POWER DUCT

VAULT

TELEPHONE EQUIPMENT

PURCHASING

CORRECTIONS

SEE SK E29

6-4" TYPE II PVC. TO NORTH DUCT SHAFT

6-4" TYPE II PVC. TO SOUTH DUCT SHAFT

DARK ROOM

RECORDS

SHREDDER

LEVEL 1 NORTH ZONE 30

FOYER

LOADING BAY

GARBAGE COMPACTOR

MEN

WOMEN

STAFF

TOURISM STORAGE

PANEL 'LNC'

QUEENS PRINTER

EQUIPMENT TO BE LOCATED AT SITE. SEE SCHEDULE BELOW.

MEN

WOMEN

TOURISM / GAMES

MAIL

COLD STOR.

DRY STOR.

PANEL 'LND' PANEL 'LED' BELOW

KITCHEN

SEE SCHEDULE BELOW

OBSOLETE - SEE SK-E26

ELEV. 1

ELEV. 2

STAIR No 3

CORRIDOR

STAIR No 1

STAIR No 4

EXHIBIT

6-4" TYPE II PVC. DUCTS FOR INCOMING TELEPHONE CABLES IN CEILING SPACE OF THIS FLOOR

1½" E.C. FROM TELEPHONE EQUIPMENT ROOM TO TEL. ROOM IN EXIST. REGIONAL LIBRARY

KITCHEN EQUIPMENT SCHEDULE

NOTE: EQUIPMENT CONNECTION N.I.C. PANEL & CIRCUIT NOS SHOWN & NOTED

NO	ITEM	SUPPLY	LOAD	CIRCUIT	CONDUCTOR/CONDUIT
1	REFRIGERATOR	208V-1Φ	0.7 KW	LED 9	2#12 R90 - ½"C
2	FREEZER	" "	0.9 KW	LED 11	
3	TOASTER	" "		UP 4[illegible]	2#10 R90 - ¾"C
4	DEEP FRY BASKET	208V-3Φ	KW	UP 10[illegible]	3#8 R90 - 1"C
5	GRIDDLE	"	6.0 KW	UP 12[illegible]	3#10 R90 - ¾"C
6	SOUP HOLDER	"	1.5 KW	UP 4[illegible] LED 8	2#10 R90 - ¾"C
7	DHW BOOSTER	208V-3Φ	12.0 KW	UP 12[illegible] LNP [illegible]	4#8 R90 - 1"C
8	DISHWASHER	115V-1Φ	¼ HP	UP 12[illegible] LND 15	2#12 R90 - ½"C
9	DISPOSAL	115V-1Φ	1/2 KW	UP 12[illegible] LND 16	2#12 R90 - ½"C
10	GARBAGE [illegible]	208V-1Φ	1½ HP	UP 12[illegible] LND 8, 10	2#8 R90 - ¾"C
11	ICE [illegible]	208V-1Φ	1.0 KW	UP 12[illegible] LND 11/13	" "
12	[illegible]	115V-1Φ	—	— LND 13	" "
13	[illegible] COOLER	115V-1Φ	—	— LND 14	" "
[illegible]	[illegible]	208V-1Φ	5.0 KW	— LND 10[illegible]	2#8 R90 - ¾"C

QUEEN'S PRINTER EQUIPMENT SCHEDULE

PROVIDE OVERHEAD CONNECTIONS TO FOLLOWING EQUIPMENT:-

ITEM	SUPPLY	LOAD	CIRCUIT	CONDUCTOR/CONDUIT
PADDING MACHINE	115V-1Φ	.750 KV	LNC - 7	2#12 R90 - ½"C
2 ETCHERS	" "		9&11	2#12 R90 - ½"C EA
SHREDDER	" "	½ HP	13	2#12 R90 - ½"C
JOGGER	" "		15	" "
GESTETNER	" "		17	" "
2 BINDERS	" "	2.5 5A	19 & 21	2#12 R250 - ½"C EA.
PAPER CUTTER	" "	7 AMP	23	2#12 R250 - ½"C
ELECTRIC STAPLER	" "		25	" "
SAVIN 220	" "	14 AMP	10	2-#10 R90 - ¾"C
SAVIN 750	" "	14 AMP	12	" "
2 TTR ROTO OFFSETS	" "	3 A EA.	14 & 16	2-#12 R90 - ½"C EA
ROTO PLANOCOP	" "		18	" "
COLLATOR	" "	10 AMP	20	" "
XEROX 7000	208V-3Φ	25 AMP	22 & 24	4-#10 R90 - ¾"C

FOR CONTINUATION SEE DWG. E-4

R. HOBNER ELECTRICAL ENGINEER

FIRE ALARM ZONE 1 — FIRE ALARM ZONE 2

KEY PLAN

AS BUILT DRAWINGS

[redacted]

REVISIONS

NO.	DATE	DESCRIPTION
A	24/5/74	Y7 & HIGH WATER ALARM DELETED, GEN. PANEL & NOTES ADDED, STARTERS FOR P20 & P21 IN SPRINKLER RM CHANGED, CONDUCTORS IN QUEENS PRINTER SCHEDULE CHANGED, 2 RECEPT ADDED IN TEL. RM., TRANSFORMERS X7 & X8 LOCATED, TELEPHONE CABLE TRAY ADDED
1	4/5/75	INCOMING TEL. CHANGED FROM TRAY TO DUCT, TEL DUCTS ADDED, KITCHEN LAYOUT DELETED.

PROJECT NO. 89887

DATE 1 APRIL 1974 — SCALE 1/8" = 1'-0"

DRAWN C.R. — CHECK K.H.

APPROVED K.H.

GOVERNMENT OF THE YUKON TERRITORY

DRAWING TITLE

ELECTRICAL - LEVEL ONE EAST - POWER

REVISED TEL. & RECEPT. LAYOUT 2/12/75

PROJECT TITLE

TERRITORIAL ADMINISTRATION BUILDING WHITEHORSE, Y.T.

DRAWING NO. SK E5 R

LATEST REVISION A

ADDENDUM A